CHALFONT COURT
GROUND FLOOR PLAN

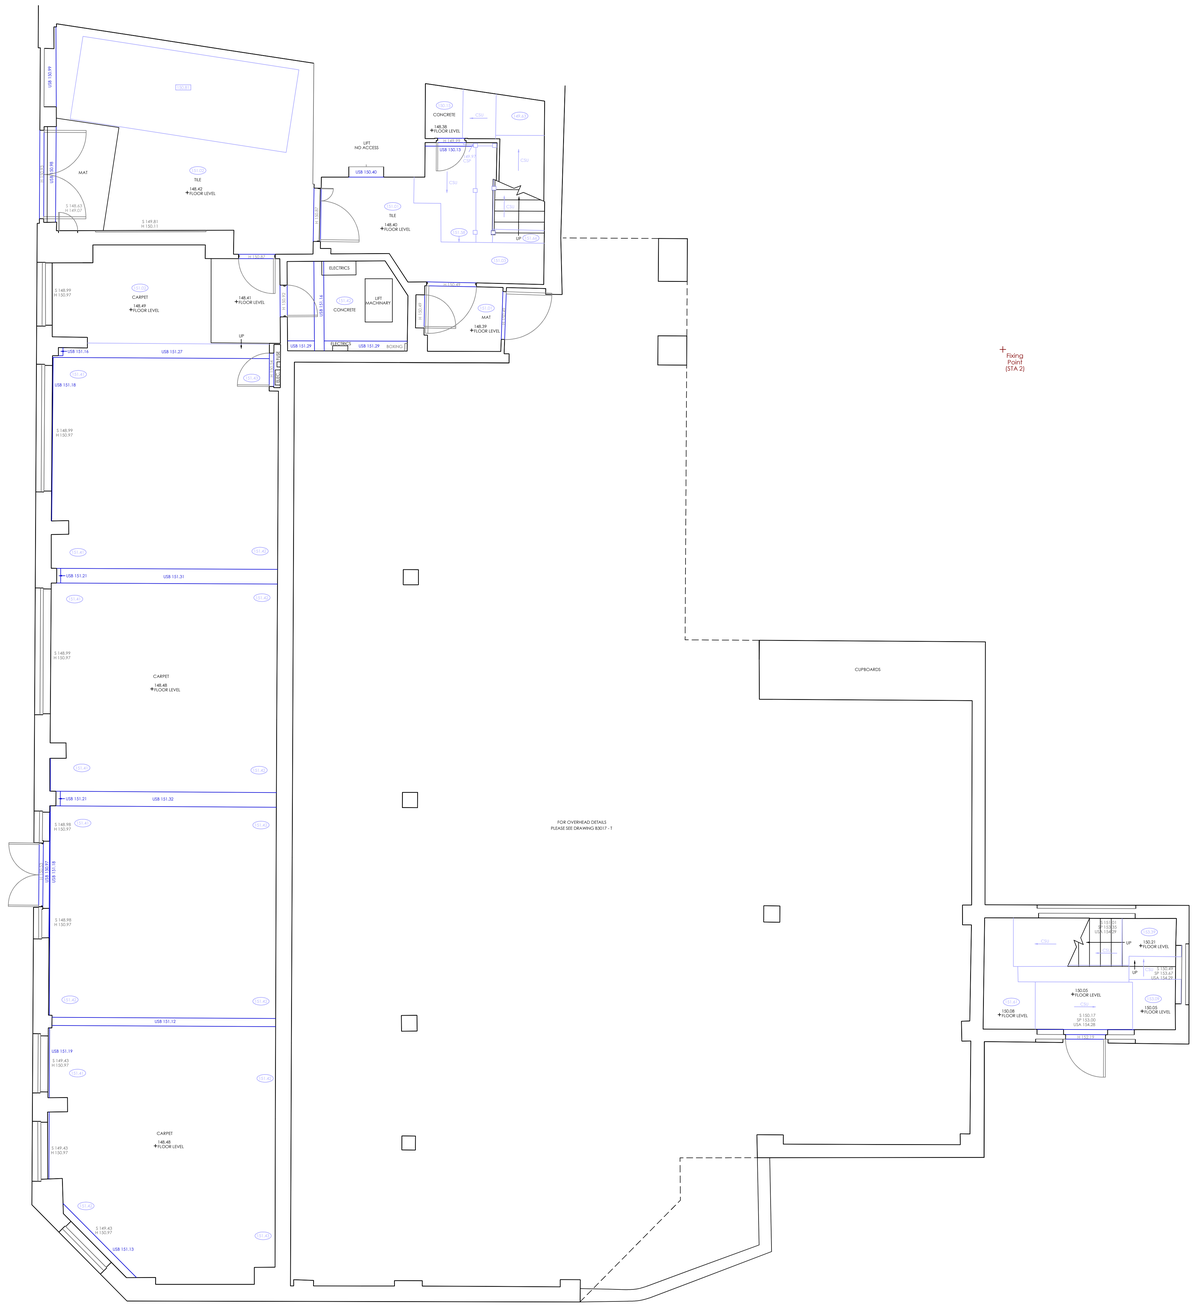

NOTES

1 LEVELS ARE RELATED TO ORDNANCE SURVEY BY GPS OBSERVATION.

2 SURVEY HAS BEEN CARRIED OUT TO AN ACCURACY COMMENSURATE WITH A 1:50 SCALE DRAWING.

ABBREVIATION LIST

AC	AIR CONDITIONING VENTS OR EQUIPMENT
BSP	BEAM SPRING LEVEL
BSU	BEAM SLOPES UP
CSP	CEILING SPRING LEVEL
CSU	CEILING SLOPES UP
DP	DOUBLE PLUG
ELS	EMERGENCY LIGHT SWITCH
EP	ELECTRIC POINT
ESM	ELECTRIC SWITCH MACHINE
FA	FIRE ALARM
FL	FLOOR LEVEL
FS	FUSED ELECTRIC SWITCH
JB	JUNCTION BOX
L	LIGHT
LCB	LIFT CALL BUTTON
LS	LIGHT SWITCH
SP	SINGLE PLUG
TOB	TOP OF BOXING
TOW	TOP OF WALL
WL	WALL LIGHT
s 1.00	SILL LEVEL
h 1.00	HEAD LEVEL
uab 1.00	LEVEL OF UNDERSIDE OF ARCH
ubb 1.00	LEVEL OF UNDERSIDE OF BEAM
ucd 1.00	LEVEL OF UNDERSIDE OF DUCTING
uvp 1.00	LEVEL OF UNDERSIDE OF PIPE
us 1.00	UNDERSIDE LEVEL
	SOLID CEILING LEVEL
	FALSE CEILING LEVEL

NO.	DATE	DETAILS

REVISIONS

KND SURVEYS LTD
74 WATCHET LANE
HOLMER GREEN
HIGH WYCOMBE
BUCKINGHAMSHIRE
HP15 6UG
Tel: 01494 718453
Fax: 01494 717576
e-mail: enquiry@kndsurveys.com

CLIENT

MERRITTS PROPERTIES LTD
MERRITT HOUSE
HILL AVENUE
AMERSHAM
HP6 5BQ

JOB TITLE

CHALFONT COURT
AMERSHAM

DRAWING TITLE

GROUND FLOOR PLAN

SCALE BAR

0m 5m

DRAWING No.	DRAWN BY	DATE
B3017 - G	JJF	27 FEB 2017
SURVEYED BY		**SCALE**
JJF		1:50