


THIS DRAWING IS PROTECTED UNDER COPYRIGHT.
THIS DRAWING IS NOT TO BE REPRODUCED IN WHOLE OR PART UNLESS AUTHORISED BY
area
© COPYRIGHT
THIS DRAWING IS NOT TO BE SCALED
THE GENERAL CONTRACTOR IS TO CHECK ALL DIMENSIONS AND NOTIFY THE DESIGNERS OF ANY DISCREPANCIES OR OMISSIONS.

DRAWING TO BE READ IN CONJUNCTION WITH SCOPE OF WORKS

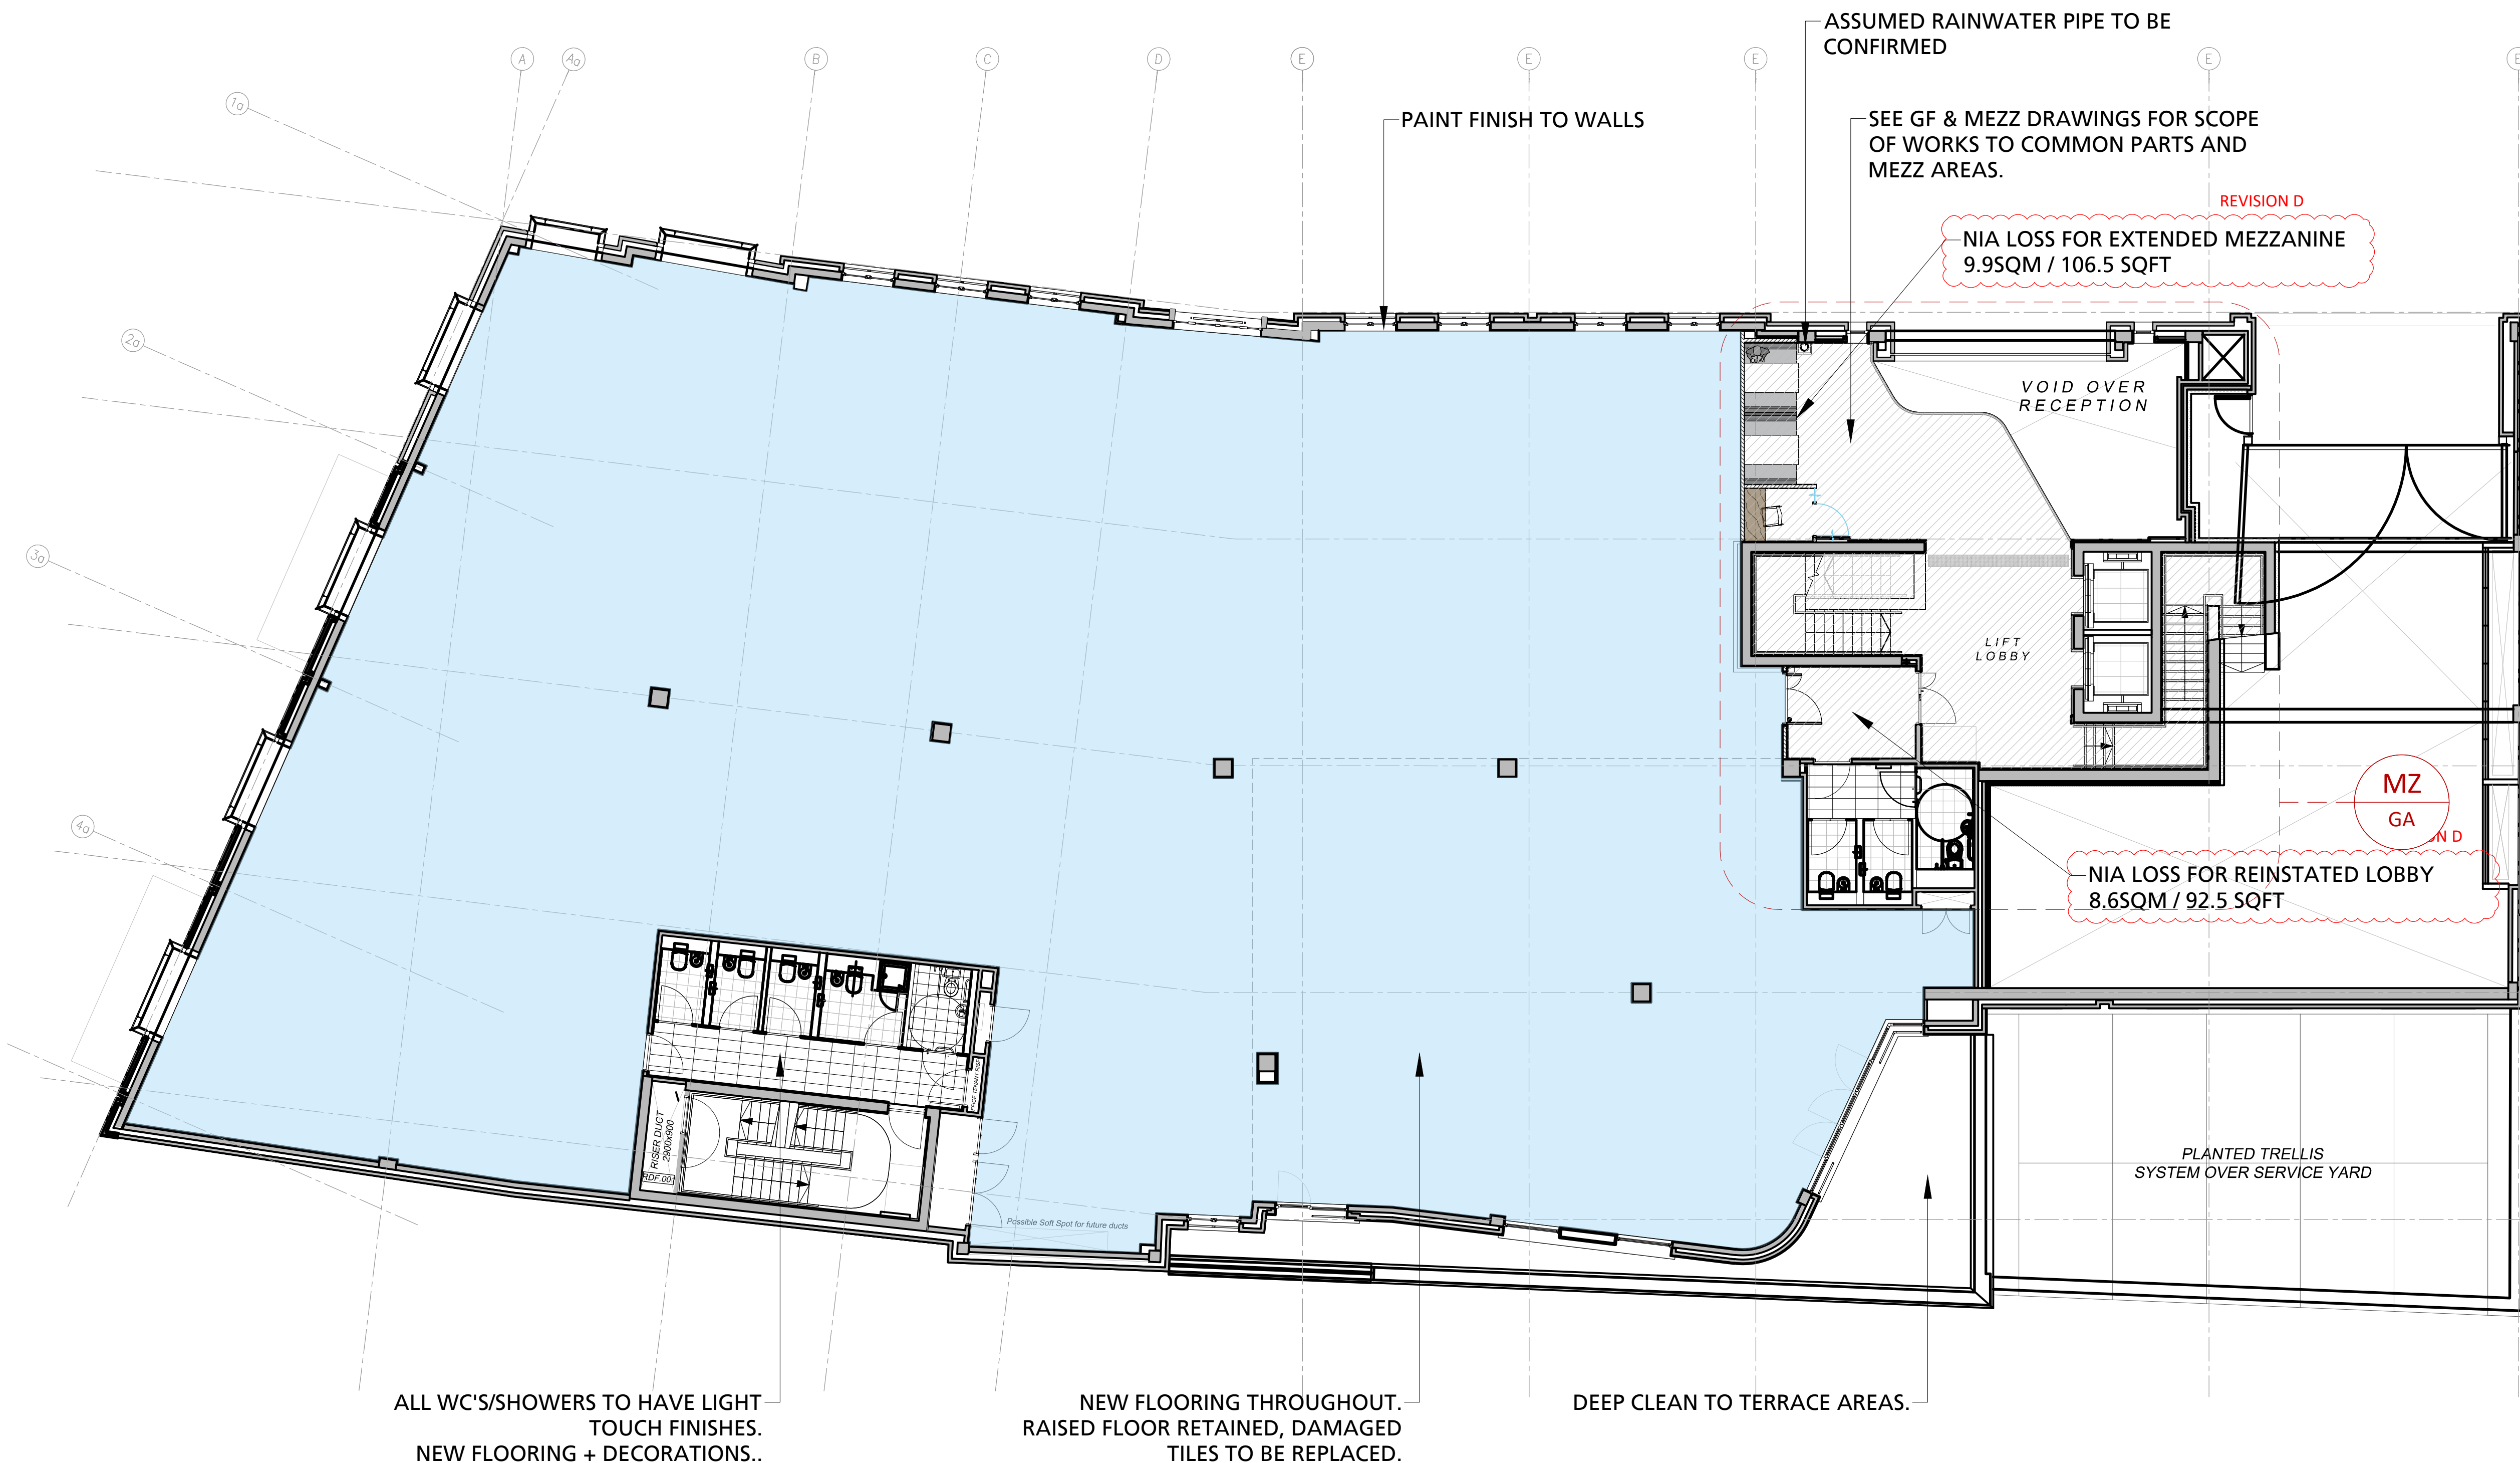

DATE	REV	REVISIONS	SIGN	CHKD
24.05.23	D	UPDATED NOTES	DP	DP
04.05.23	C	ISSUED FOR CONSTRUCTION. UPDATE AFTER SURVEY	MW	MW
22.01.23	B	ISSUED FOR CONTRACT	MW	MW
12.01.23	A	UPDATED MEZZ	MW	MW



Windsor Two
Arthur Road
Windsor
Berkshire SL4 1RS
T. 01784 274000
info@area.co.uk

Third Floor
Chapter House
18 Crucifix Lane
London SE1 3JW
T. 020 3805 8855
www.area.co.uk

DRAWING STATUS
CONSTRUCTION

CLIENT
EUROPA CAPITAL

PROJECT
**1 ETON STREET
RICHMOND
TW9 1AG**

TITLE
**FIRST FLOOR
PROPOSED GA**

SCALE
1:100 @ A1

DATE	APR '22	DRAWN	MW	CHECKED	ADD
------	---------	-------	----	---------	-----

PROJECT NO	BLDG.	FLOOR	DETAIL	REV.
Ar31626	1	01	GA	D

01 **FIRST FLOOR**
Scale 1:100 @ A1

PROPOSED APPROX AREA: 882 sqm / 9494 sqft