


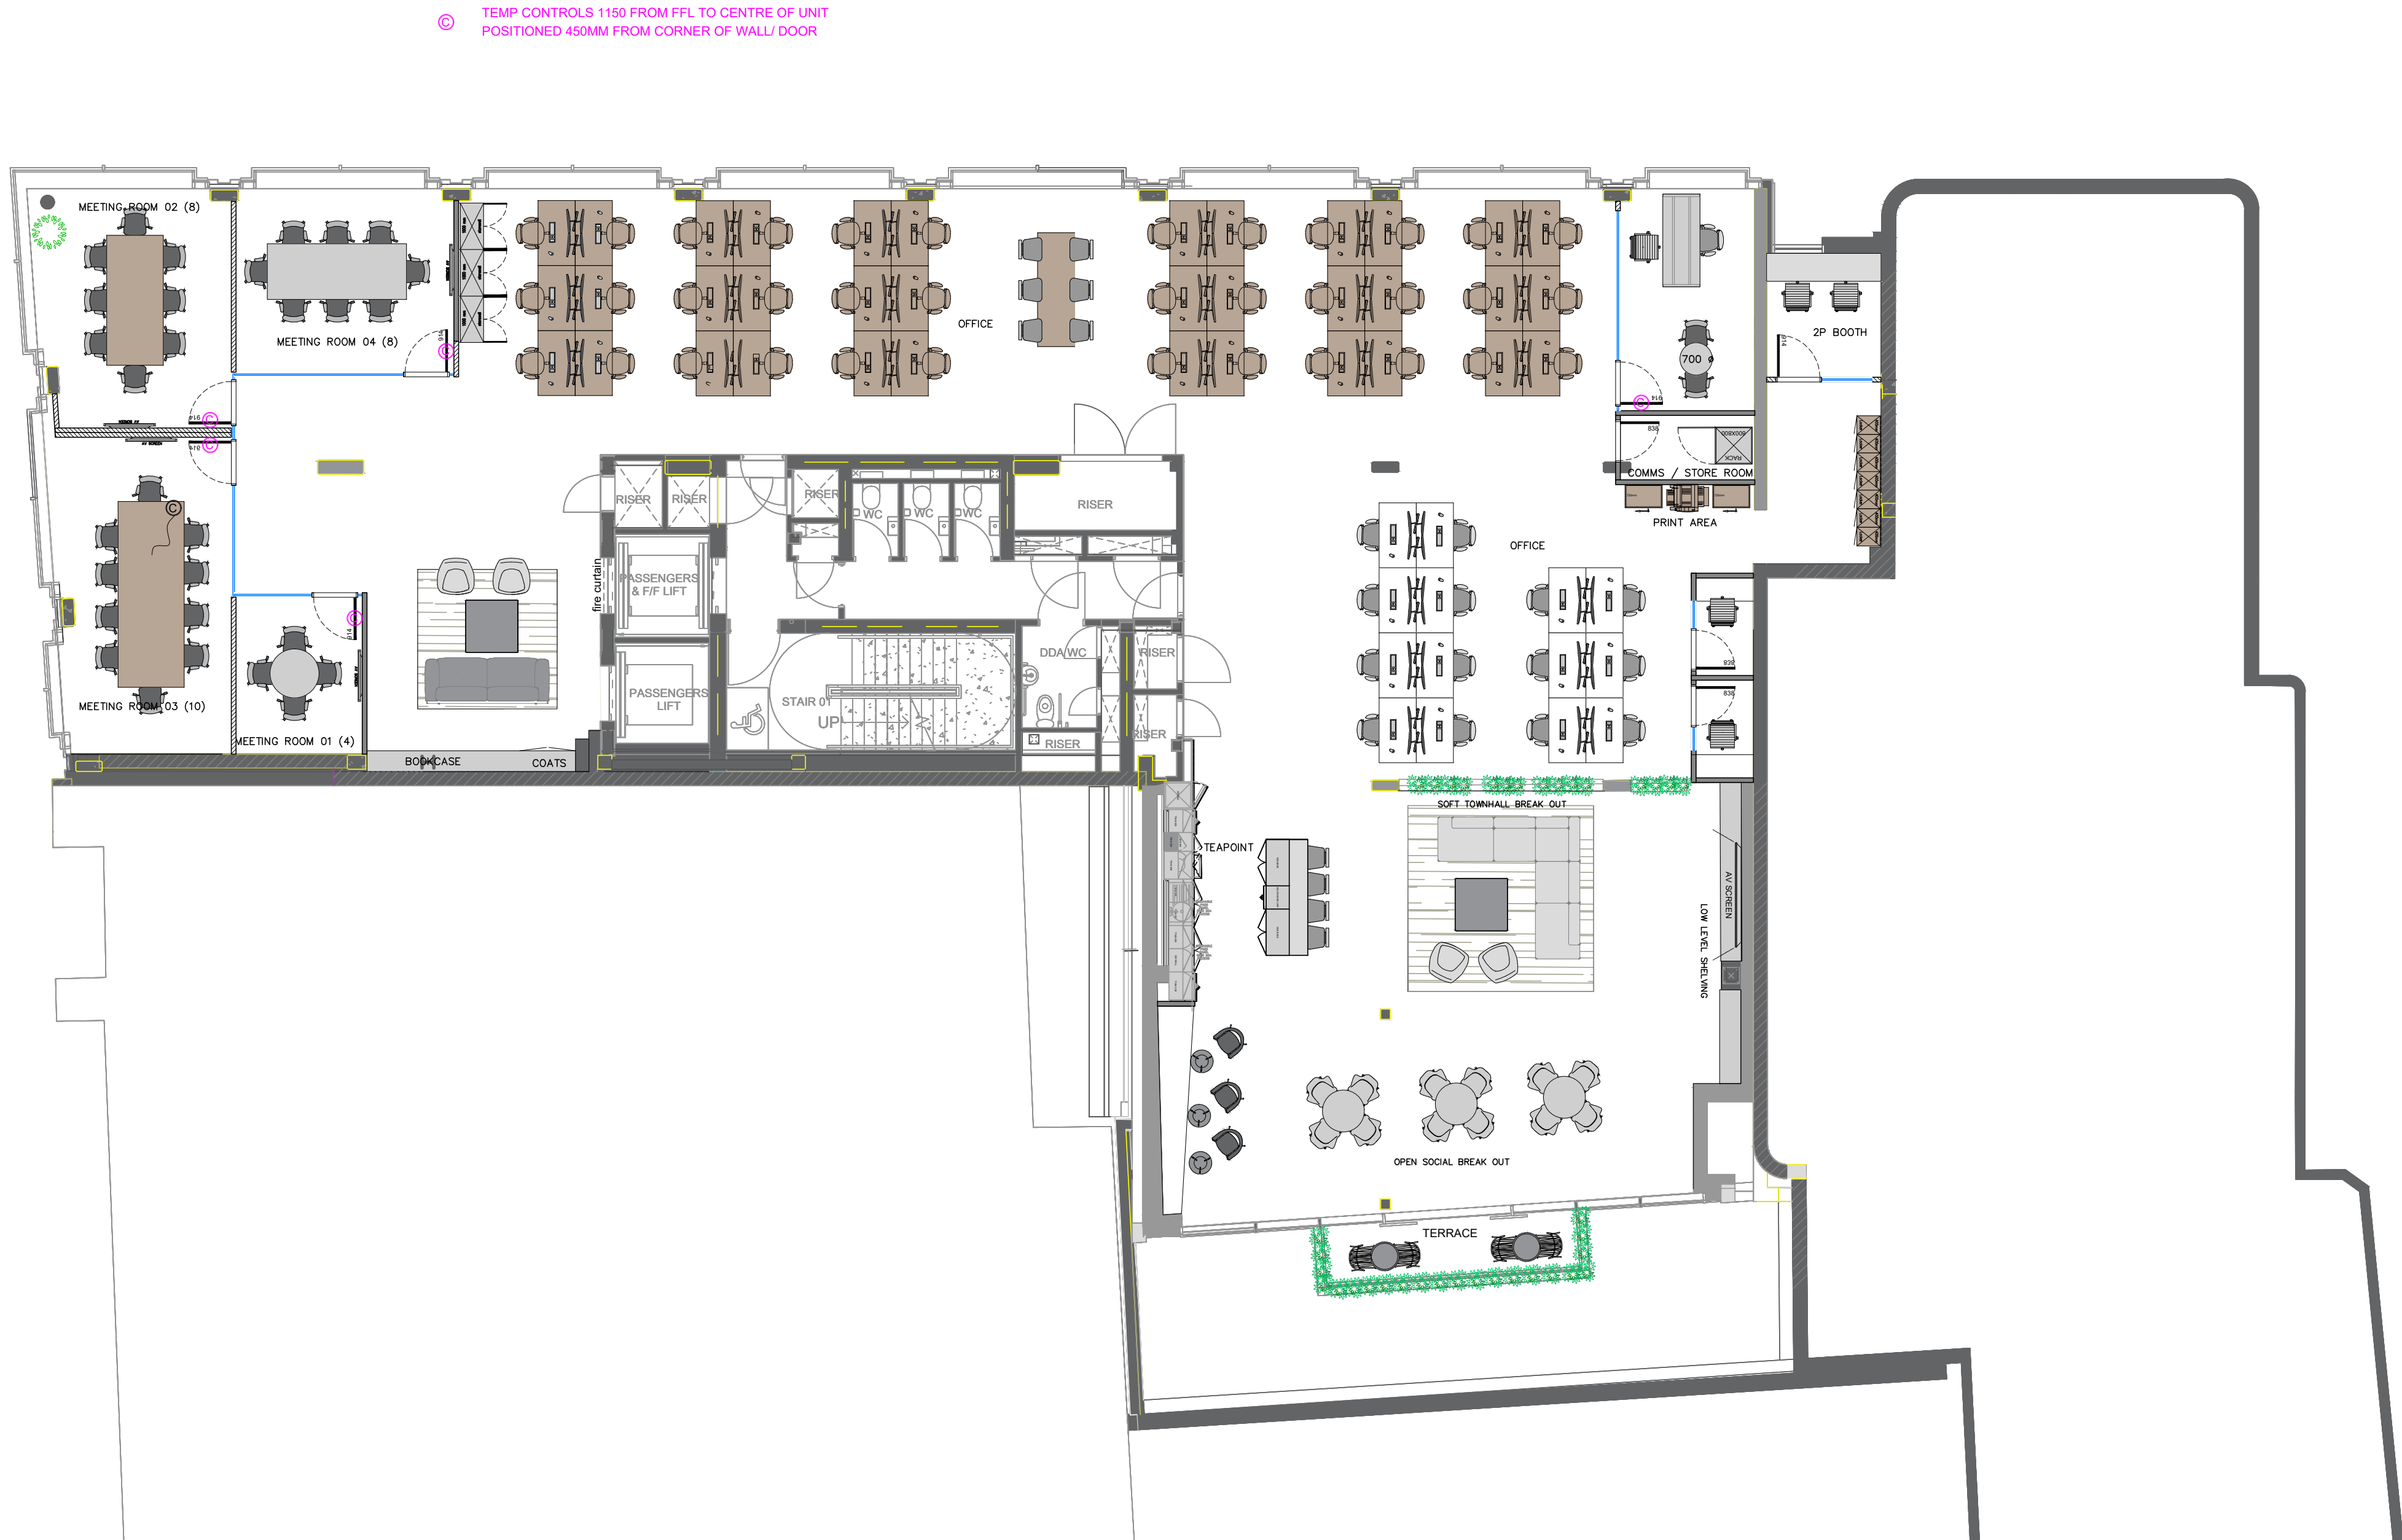

NOTES

THIRDWAY INTERIORS DO NOT ACCEPT LIABILITY FOR ANY ERRORS AND OMISSIONS ARISING FROM THE PREPARATION OF BASE BUILD DRAWINGS WHICH ARE DERIVED FROM ORIGINAL MATERIAL PROVIDED BY OTHERS.

ALL DISCREPANCIES ARE TO BE REPORTED TO THIRDWAY INTERIORS.

GRID LINES ARE FOR REFERENCE PURPOSES ONLY.

ALL DIMENSIONS TO BE VERIFIED BY CONTRACTOR ON SITE PRIOR TO ANY WORKS COMMENCING.

DO NOT SCALE FROM THIS DRAWING.

THIS DOCUMENT IS THE PROPERTY OF THIRDWAY INTERIORS. COPYRIGHT IS RESERVED BY THEM, AND THE DRAWING IS ISSUED ON THE CONDITION THAT IT IS NOT COPIED, REPRODUCED OR RETAINED BY, NOR DISCLOSED TO ANY UNAUTHORISED PERSON, EITHER WHOLLY OR IN PART, WITHOUT THE CONSENT IN WRITING FROM THIRDWAY INTERIORS.


©THIRDWAY INTERIORS

GENERAL KEY:


Some symbols shown may not appear in drawing, and may not be to scale. Drawing to be printed in colour.




EXISTING FIT-OUT

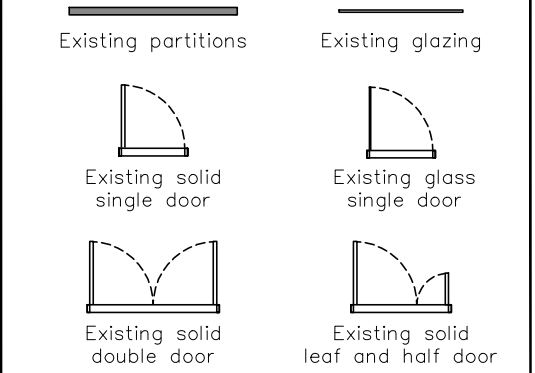


NEW PARTITIONING, GLAZING AND DOORS

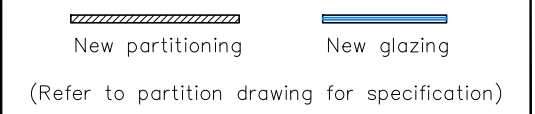

NEW DOORS (REFER TO DOOR SCHEDULE)

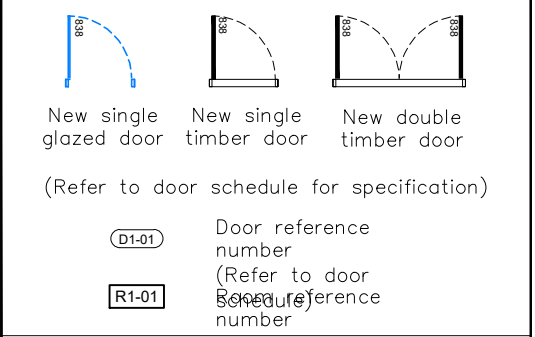

FURNITURE & FIXED ITEMS

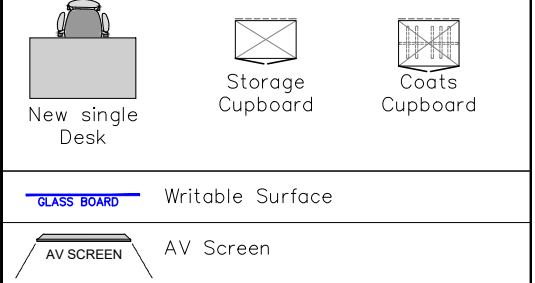

STATUS



REVISION DETAIL

REV	DETAIL	BY	DATE
P1	CONTRACT	TG	02.07.26
P2	TEMP CONTROLS	TG	14.08.26

CLIENT

BAUMONT V7

PROJECT ADDRESS

182-184 HIGH HOLBORN
LONDON
WC1V 7AP
—

DRAWING TITLE

FIRST FLOOR
GENERAL ARRANGEMENT

DWG NO: 49004-01-GA

REVISION: P1

SCALE @A1: 1:100 @ A3: 1:200

DATE: 05.06.26

DRAWN BY: TG

CHECKED BY: LS

