177360 N

530560 E

530600 E

530640 E

177360 N

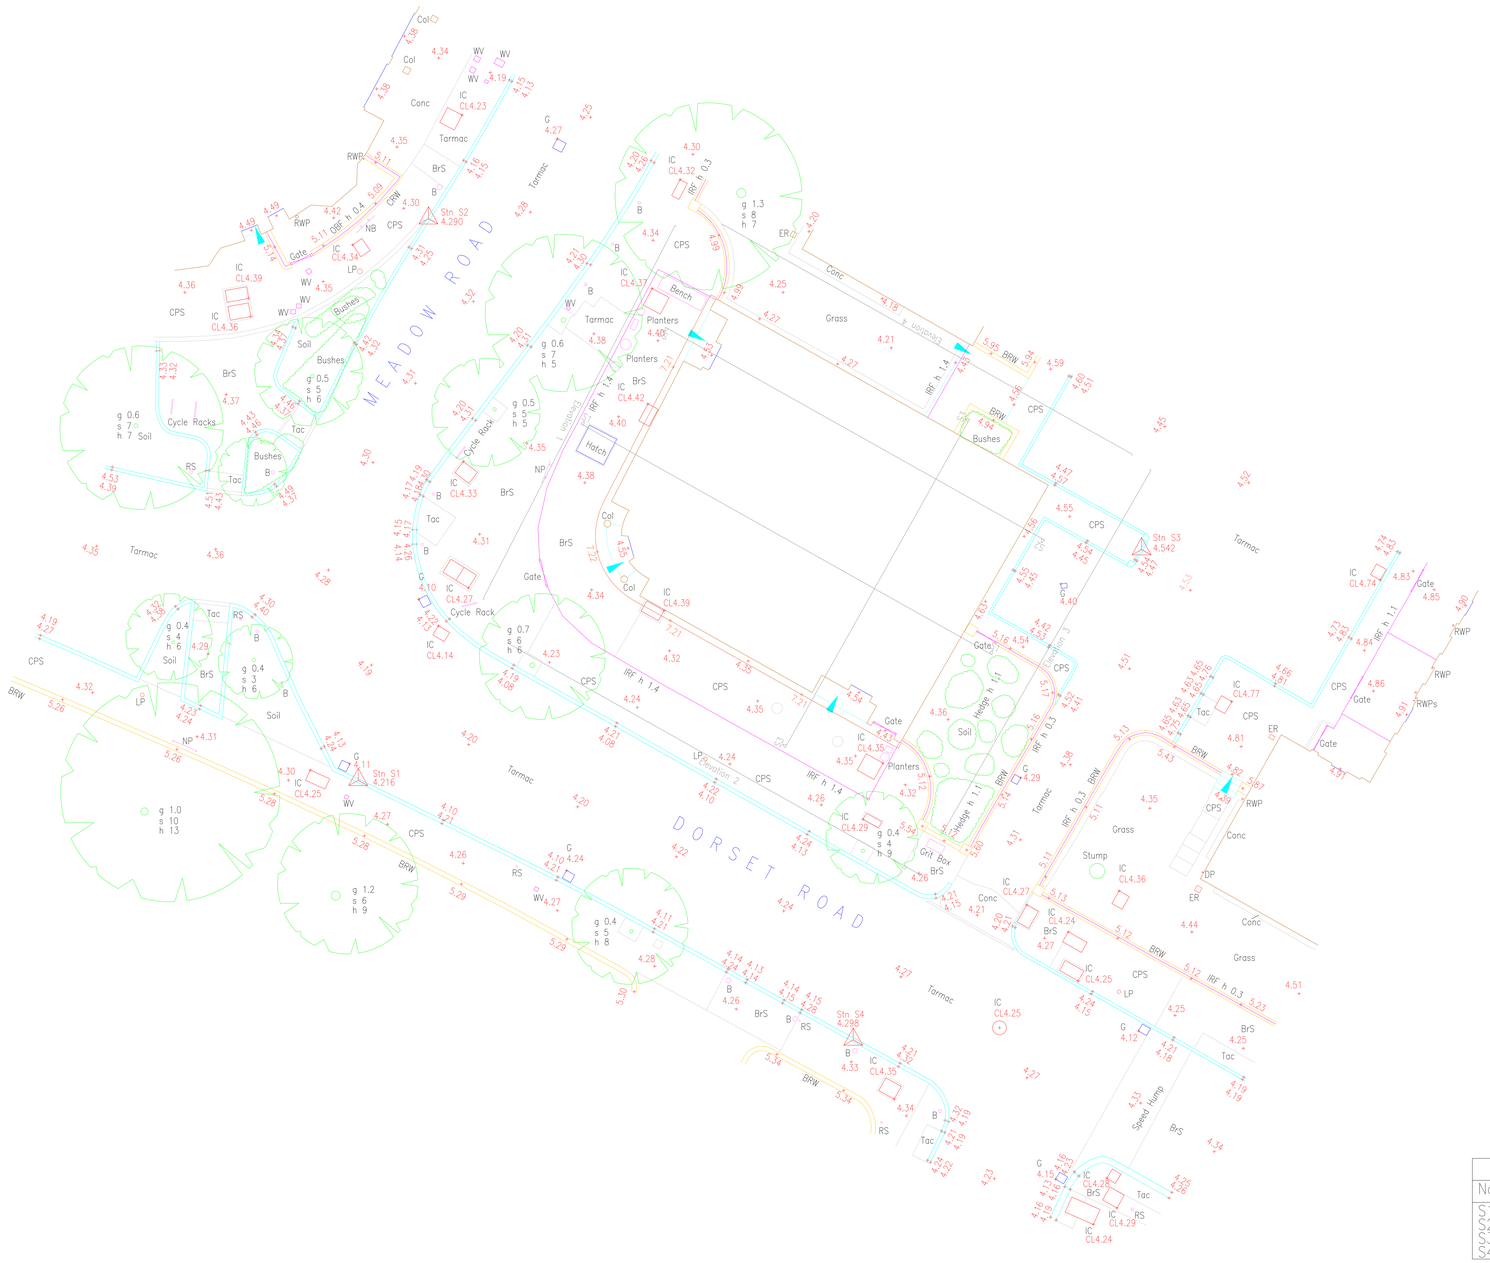

177320 N

177320 N

Survey Stations			
Name	Easting	Northing	Height
S1	530575.570	177310.902	4.216
S2	530578.815	177336.824	4.290
S3	530611.726	177321.554	4.542
S4	530598.420	177298.919	4.298

Scale 1:200

177280 N

530560 E

530600 E

530640 E

177280 N

ABBREVIATIONS

A/C	Air Conditioner	MH	Manhole
ATM	Automated Teller Machine	Min	Minimum
B	Bollard	Mkr	Marker
BB	Baldev Beacon	NB	Notice Board
Bk	Bowlerk	NP	Name Plate
BL	Bin Light	OBR	Open Board Fence
BrS	Brick Setts	O/H	Overhead
BRW	Brick Retaining Wall	OSBM	Ordnance Survey
Bus	Bus Stop	P	Post
BSh	Bus Shelter	PaB	Parking Bollard
BW	Brick Wall	PB	Pillar Box
BWF	Barbed Wire Fence	PCM	Permanent Ground Mark
CAT	Cable Television Cover	PD	Pedestrian Door
CBF	Close Boarded Fence	PPM	Parking Payment Machine
CCP	Car Changing Point	PPS	Permeable Paving Surface
CCTV	Closed Circuit Television	PRF	Post and Rail Fence
CIF	Corrugated Iron Fence	PS	Paving Stones
CL	Cover Level	PVCF	PVC Fence
CLF	Chain Link Fence	PWF	Post and Wire Fence
Col	Column	R	Radius Gully
Conc	Concrete	RC	Radiating Curb
CPS	Concrete Paving Slabs	RS	Road Sign
CRW	Concrete Retaining Wall	RSS	Rubberised Safety Surface
CW	Concrete Wall	RWP	Rain Water Pipe
d	depth	s	spread
DP	Down Pipe	SB	Sign Board
DrC	Drainage Channel	SBW	Site Bench Work
EB	Electrical Inspection Cover	SF	Security Fence
EC	Electrical Connection Box	SKB	Skip Bin
EP	Electricity Pole	SL	Survey Level
ER	Earthing Rod	SO	Smoke Outlet
ESS	Electrical Switchgear	SP	Sign Post
FB	Flower Bed	SV	Stop Valve
Fh	Fire Hydrant	SRW	Stone Retaining Wall
FL	Floor Level	SW	Stone Wall
G	Gullies/Grating	TC	Tree Circle
g	girth	TBW	Temporary Bench Work
C	Gully	TCB	Telephone Call Box
C/C	Cross Concrete	TCP	Traffic Control Post
GM	Gas Meter	TC	Telecom Inspection Cover
GP	Gate Post	TJB	Telephone Junction Box
GV	Gas Valve	TL	Traffic Light
H	Height	TC	Traffic Control
HR	Handrail	Tlt	Toilet Machine
IB	Illuminated Bollard	TMCB	Traffic Management Control Box
IC	Inspection Cover	TMIC	Traffic Management Inspection Cover
IL	Invert Level	TP	Telephone Pole
int	Intercom	Typ	Typical
IRF	Iron Railing Fence	U	Unknown
JB	Junction Box	UTS	Unable To Survey
JS	Illuminated Road Sign	V	Vent
KO	Kerb Outlet	VP	Vent Pipe
L	Light	W	Window
LP	Lamp Post	WL	Water Level
Mtr	Meathum	WM	Water Meter
Mb	Multibole	WV	Water Valve

NOTES

The survey is commensurate with band D accuracy, as specified in the RICS survey detail accuracy banding table.
All levels are above OS Newlyn Datum and the survey grid shown on the drawing is only referenced to OS National Grid at the following point: E530561.133E, 177311.050N, obtained by multiple network RTK GPS observations.
Drawing units are metres.
All quoted dimensions and levels are in metres.

Rev.	Date	By	Details

MBS SYMBOLS

51.80	Ceiling Level	1.80	Ceiling Height
FS2.30	False Ceiling Level	F2.30	False Ceiling Height
BSL 60.00	Beam Soffit Level	BH 2.30	Beam Soffit Height
S 50.80	Sill Level	S 0.80	Sill Height
H 52.40	Head Level	H 1.60	Head Height
Min 56.50 Max 57.00	Ceiling Sloping Level	Min 1.50 Max 2.00	Ceiling Sloping Height
ASL 52.00 AL 52.30	Arch Levels	ASH 2.00 AH 2.30	Arch Heights
DL 52.00	Door Level	DH 2.00	Door Height
50.00	Spot Level	h 0.90	Feature Height
21.37	Spot Level Elevation		Roof Arrows Point Down
	Stair/Step Arrows Point Up		Stair Cutline
	Sloping Ceiling Arrows Point Up		Assumed Position

RED LASER
www.redlaserscanning.co.uk
enquiry@redlaserscanning.co.uk
London Head Office
23 Sussex Street
SW1V 4RR
0207 477 2175

Project
47-49 Dorset Road
London
SW8 1EX

Description
2D Topographical Survey

Survey Date	Drawing Date
14/07/2025	05/08/2025
Sheet: 4A0	Scale: 1:200

Drawing No.
3753-T0-XX-M2-01

Checked	Revision
PS	P01