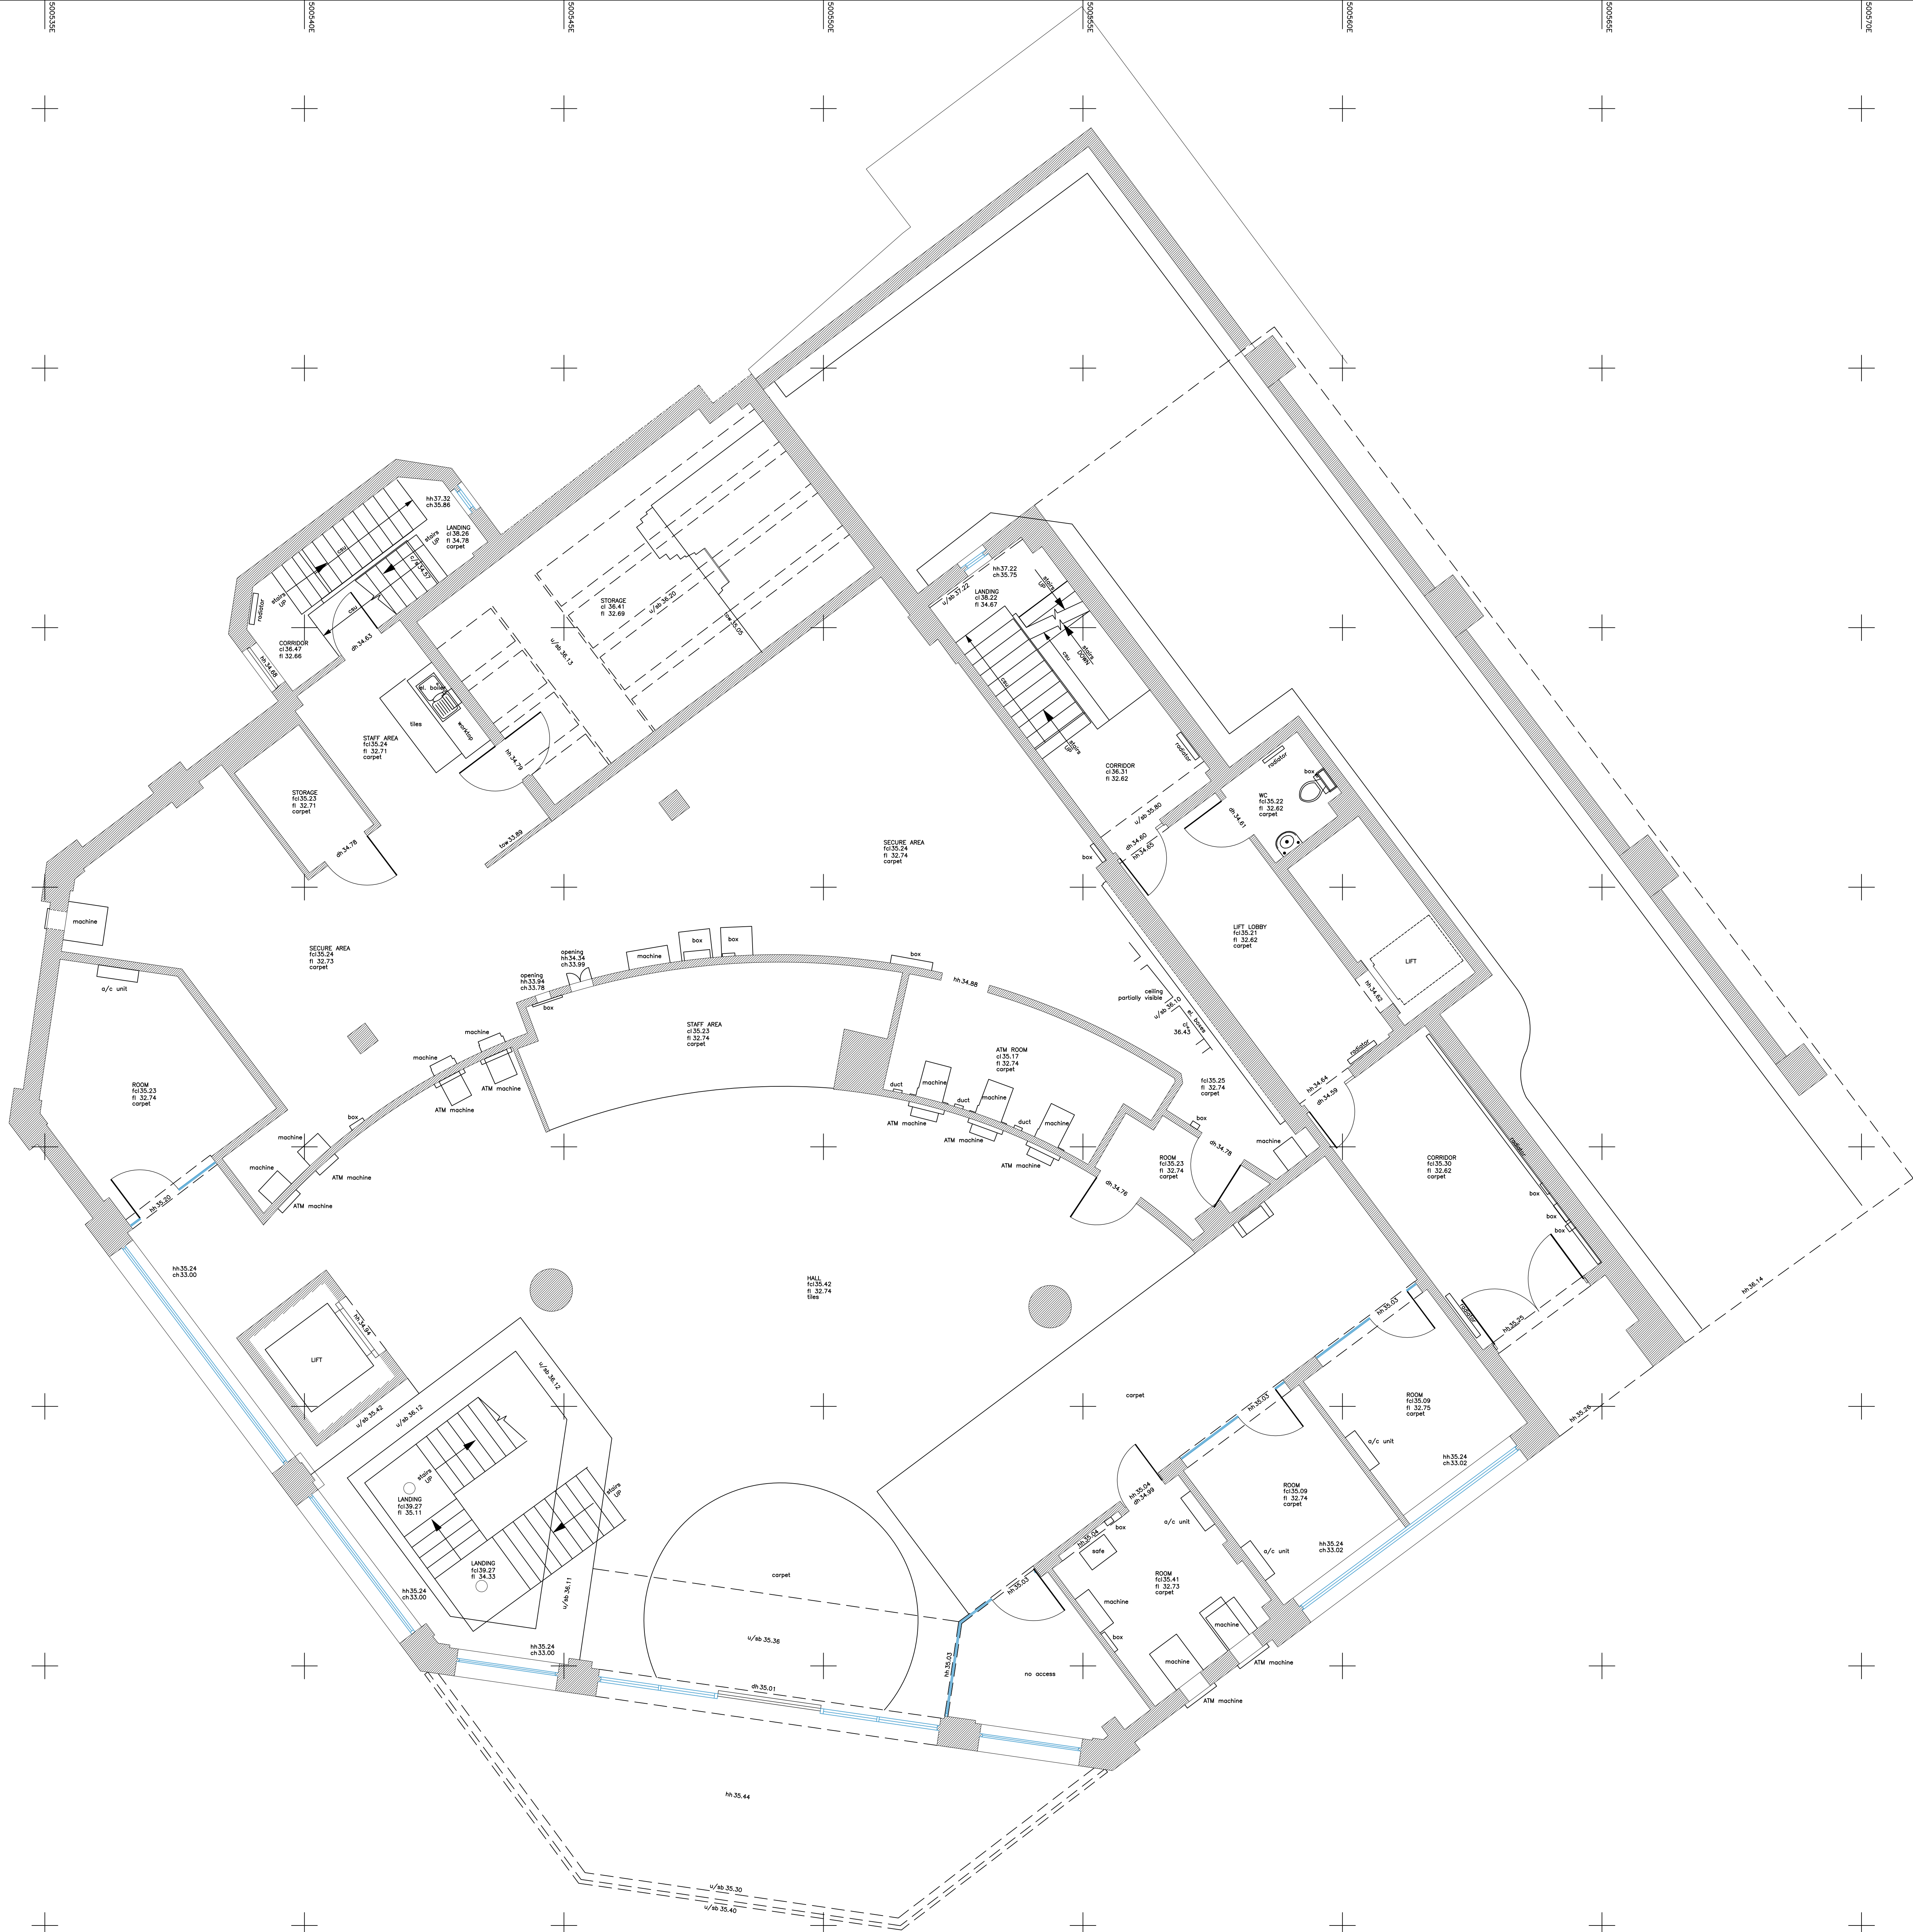
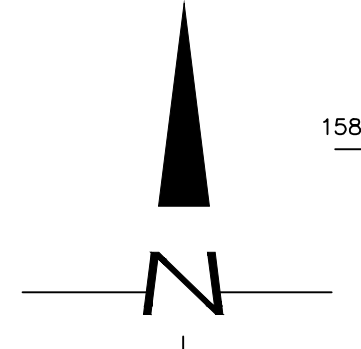


Key	
Beam	_____
Ceiling	_____
Customer/Worktop	_____
Door	_____
Duct/Railing	_____
Door/Turner	_____
Level	00.00
Manhole	○
Overhead	_____
Section	_____
Services	_____
Steps/Ramps	_____
Wall	_____
Window	_____

Abbreviations	
fl = floor level	dh = door head
cl = ceiling level	dc = door cill
fd = false level	hh = head height
ulb = underside of	ch = cill height
ulsb = underside of beam	sh = strike height
csu = ceiling slopes up	sph = spring height
mh = manhole cover	ah = apex height
tb = top of beam	tow = top of wall

SWS
SouthWestSurveys

Tel: 01454 501683
Mobile: 0755948456
www.southwestsurveys.co.uk
info@southwestsurveys.co.uk

28 Frutkney Park
Hastings
East
Sussex
TN35 3JY

Drawing Title:
Ground Floor Plan

Project Name:
Towns Gate House
Jubilee Square, Woking, GU21 6XS

Client:
Howell Commercial
Agent:
H/S

Site Level Datum ODN Height	Grid Orientation Grid
Date: 12th July 2024	Scale: 1:50 (A3)
Surveyed By SW	Drawn By SW
Sheet ID 0000000000	Rev 00