


COOKE & ARKWRIGHT - PLAN SHEET

PROPERTY: 3rd floor, 10/11 Mill Lane

FILE:

SURVEYOR: MS

DATE: 4.11.2020

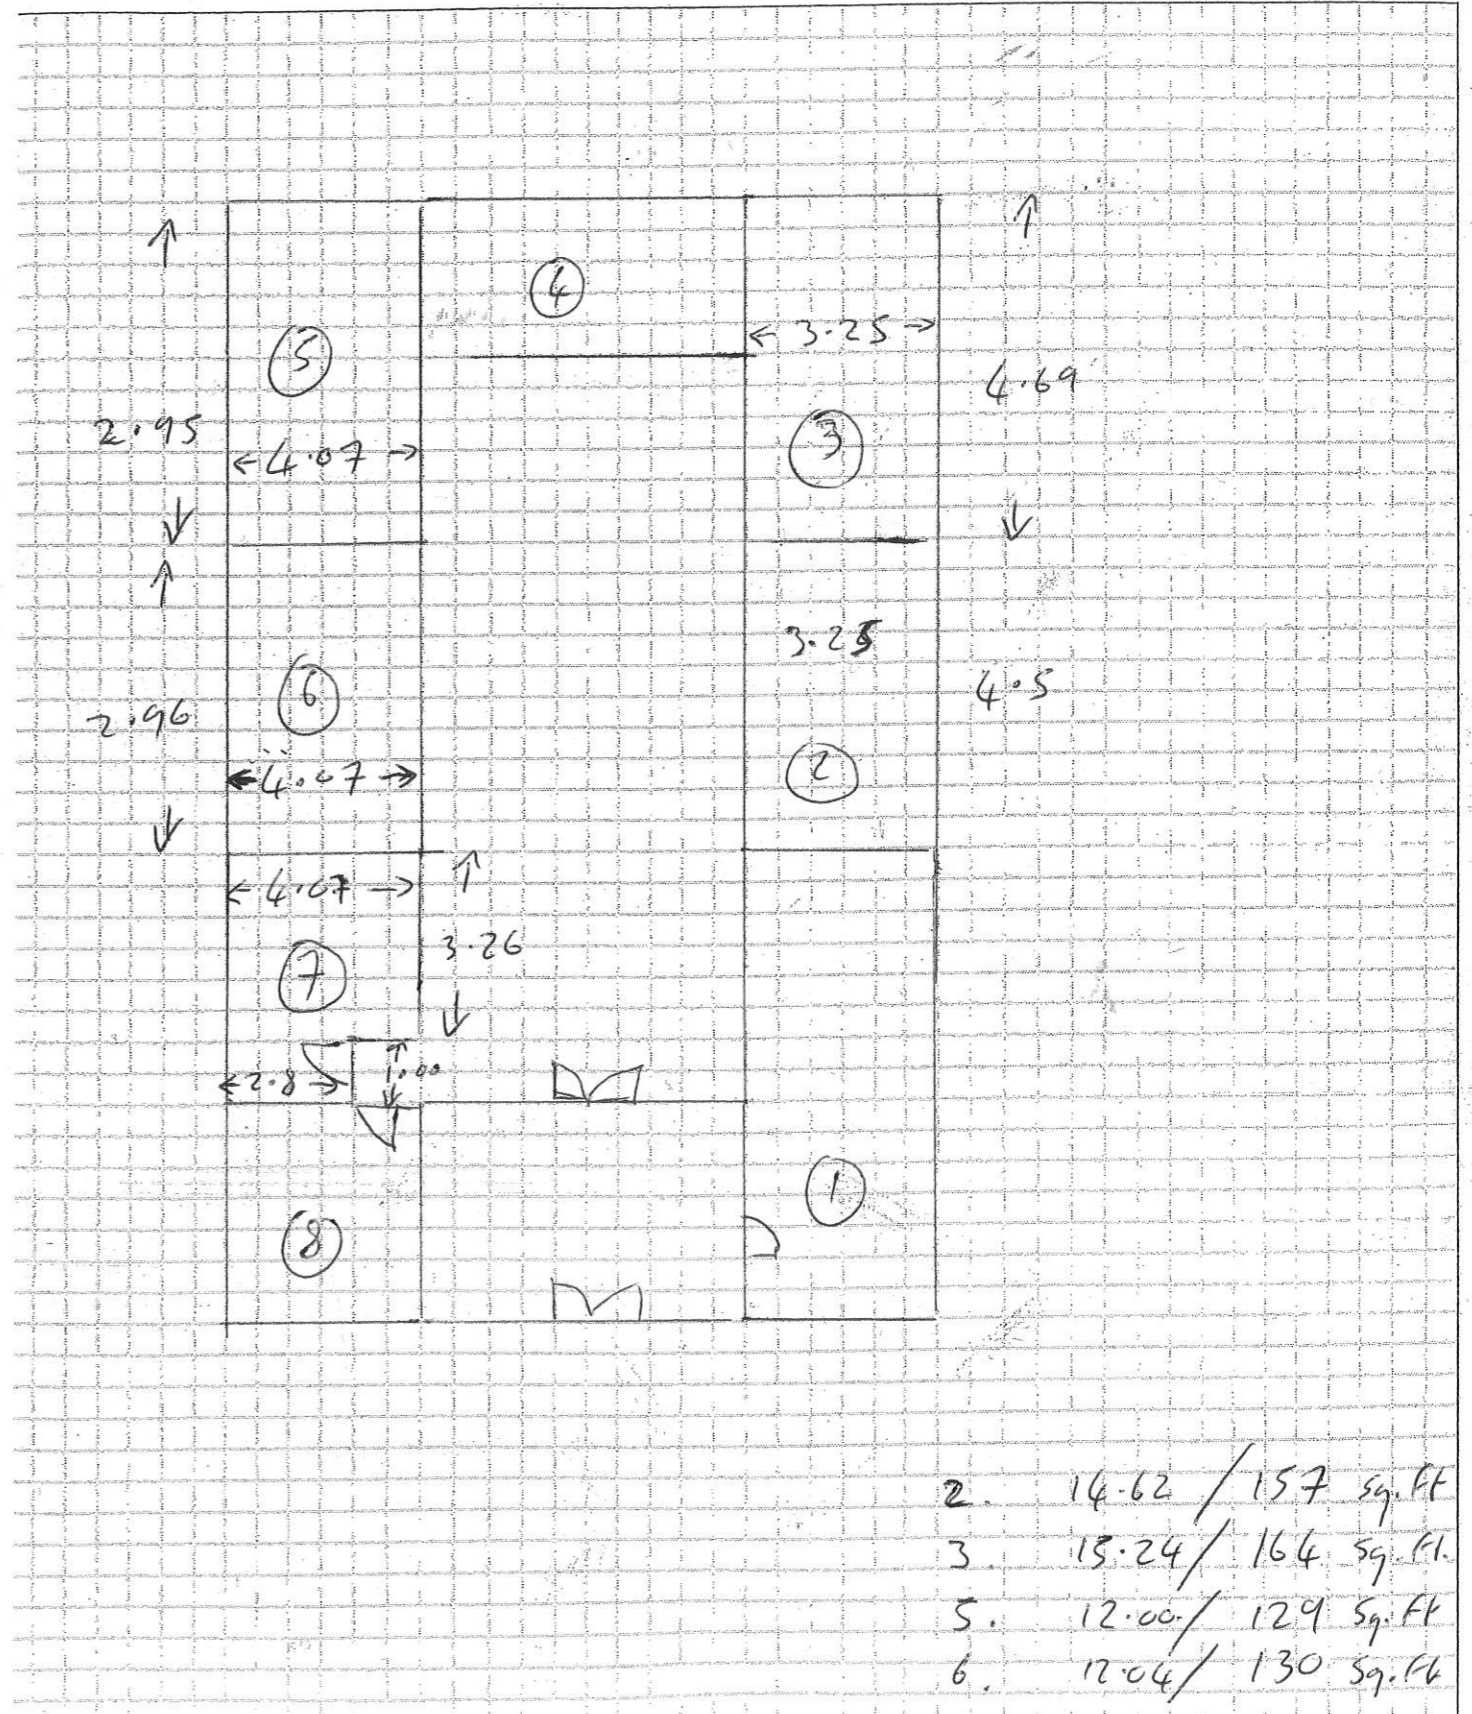

2.	14.62 / 157	Sq. Ft.
3.	15.24 / 164	Sq. Ft.
5.	12.00 / 129	Sq. Ft.
6.	12.04 / 130	Sq. Ft.
