
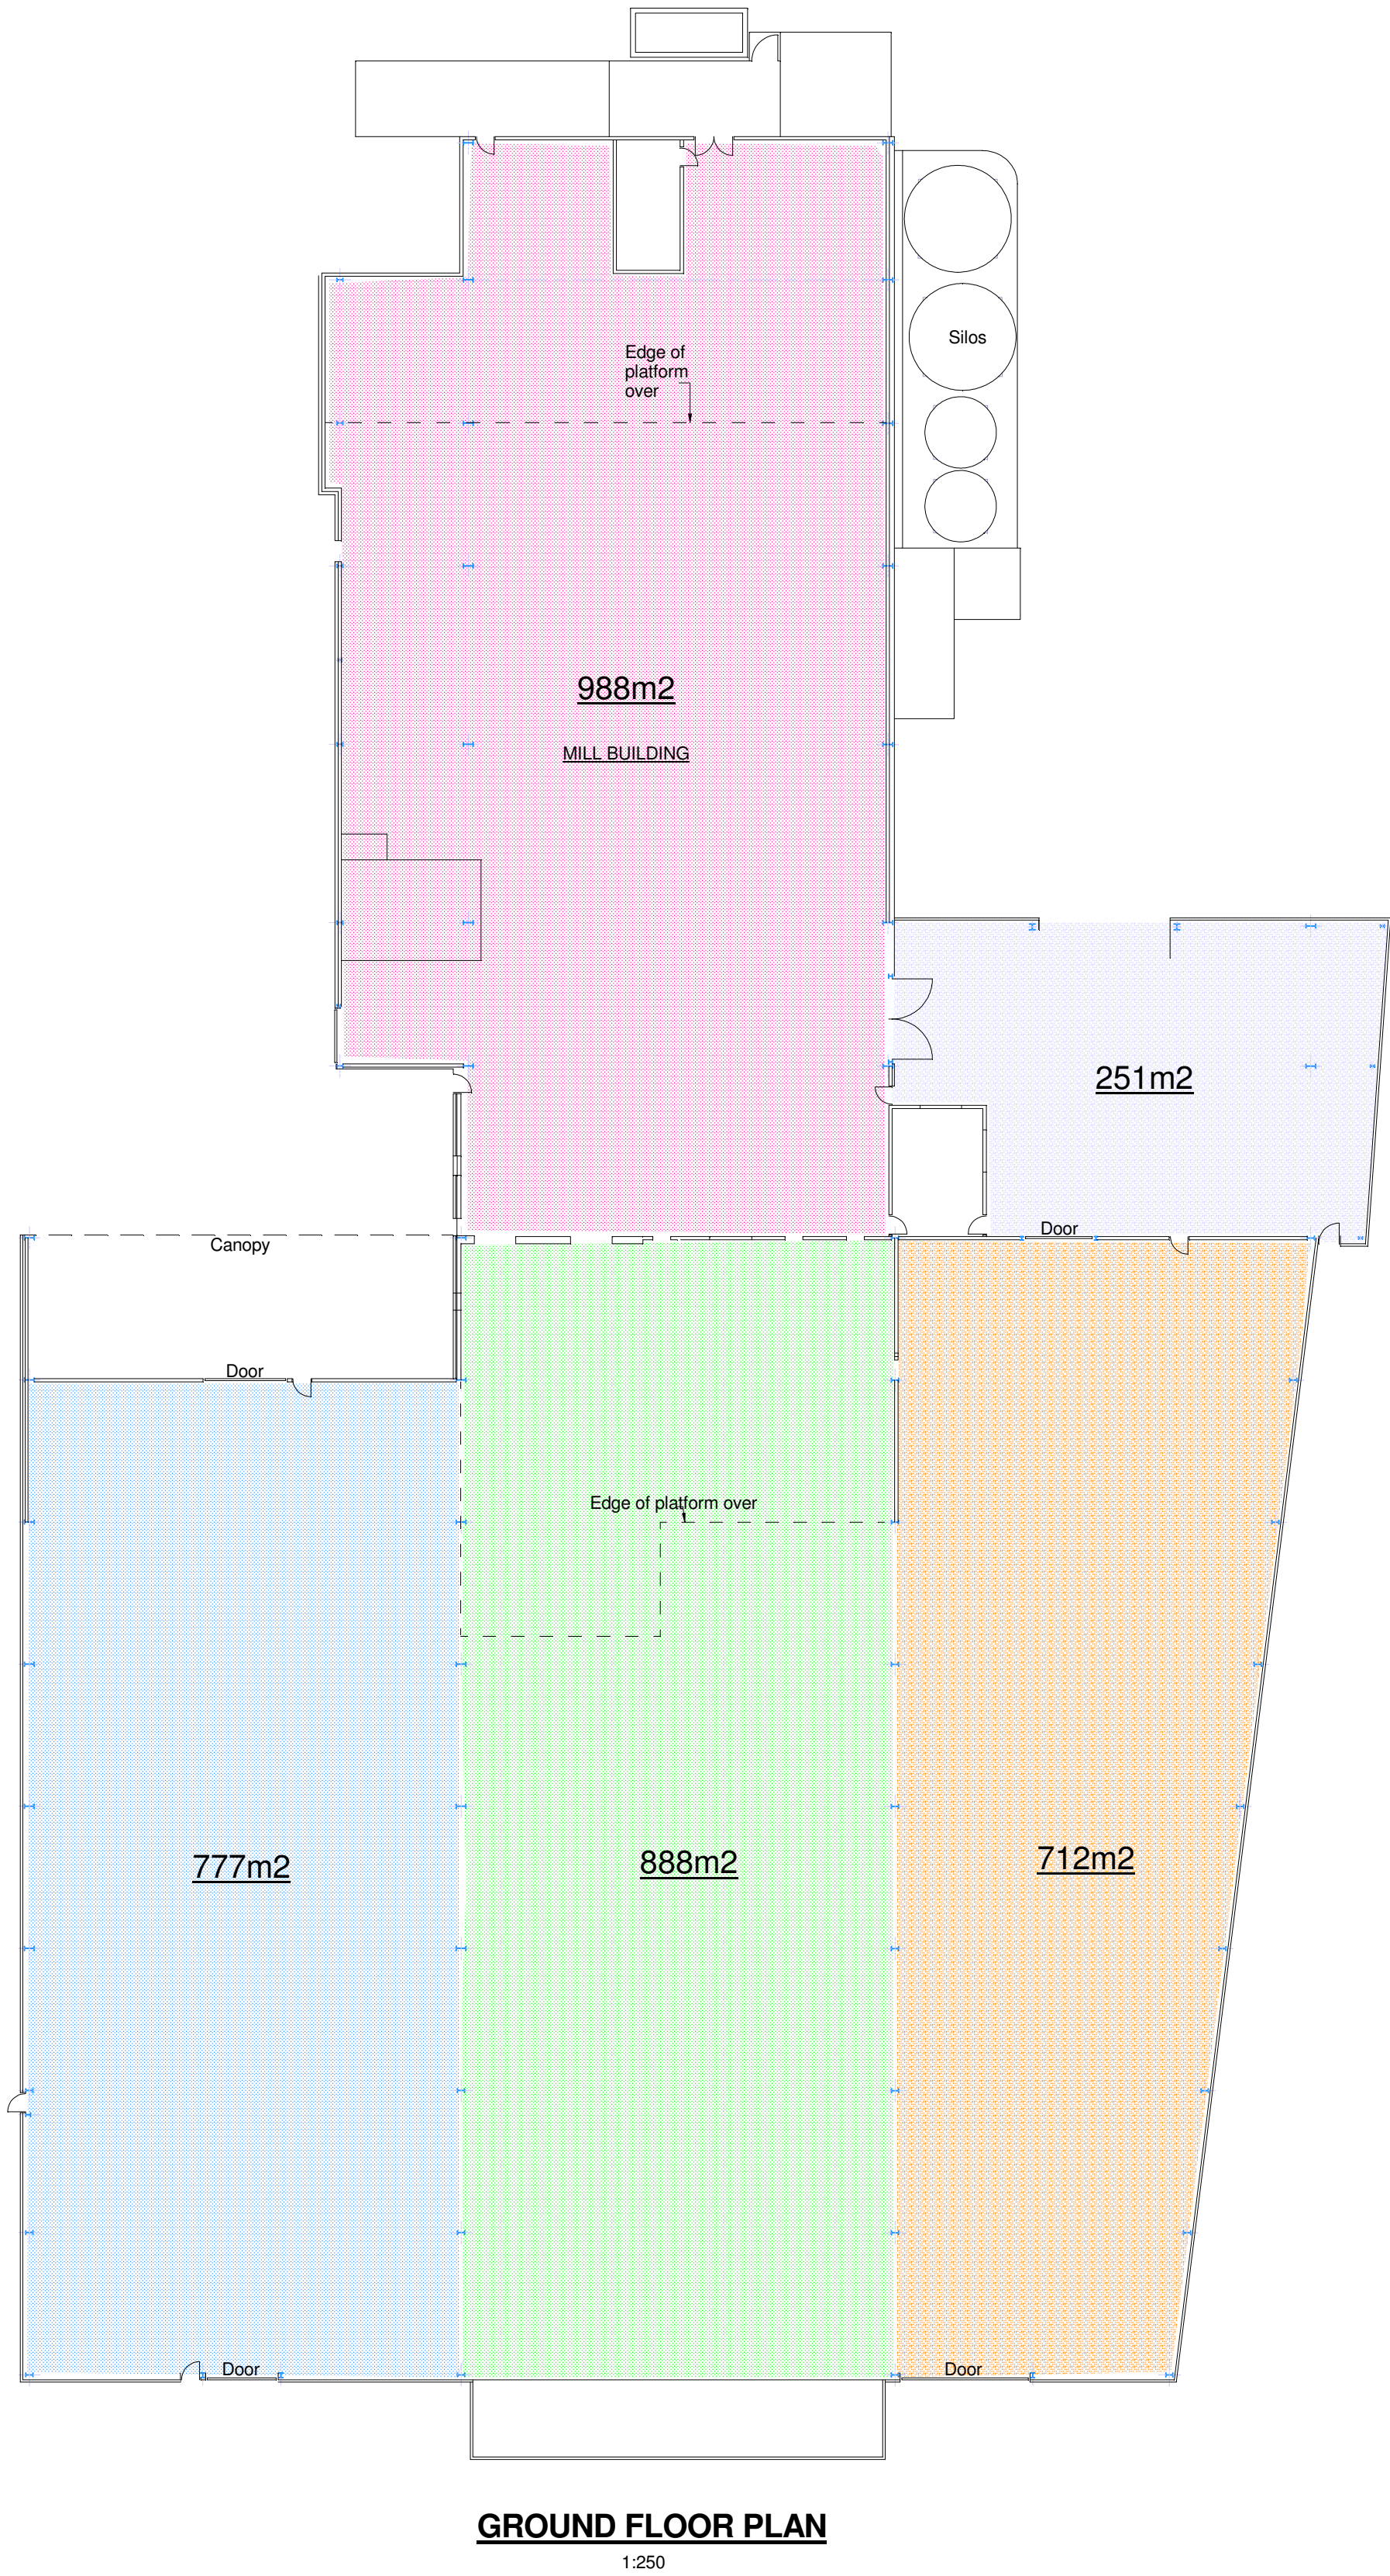
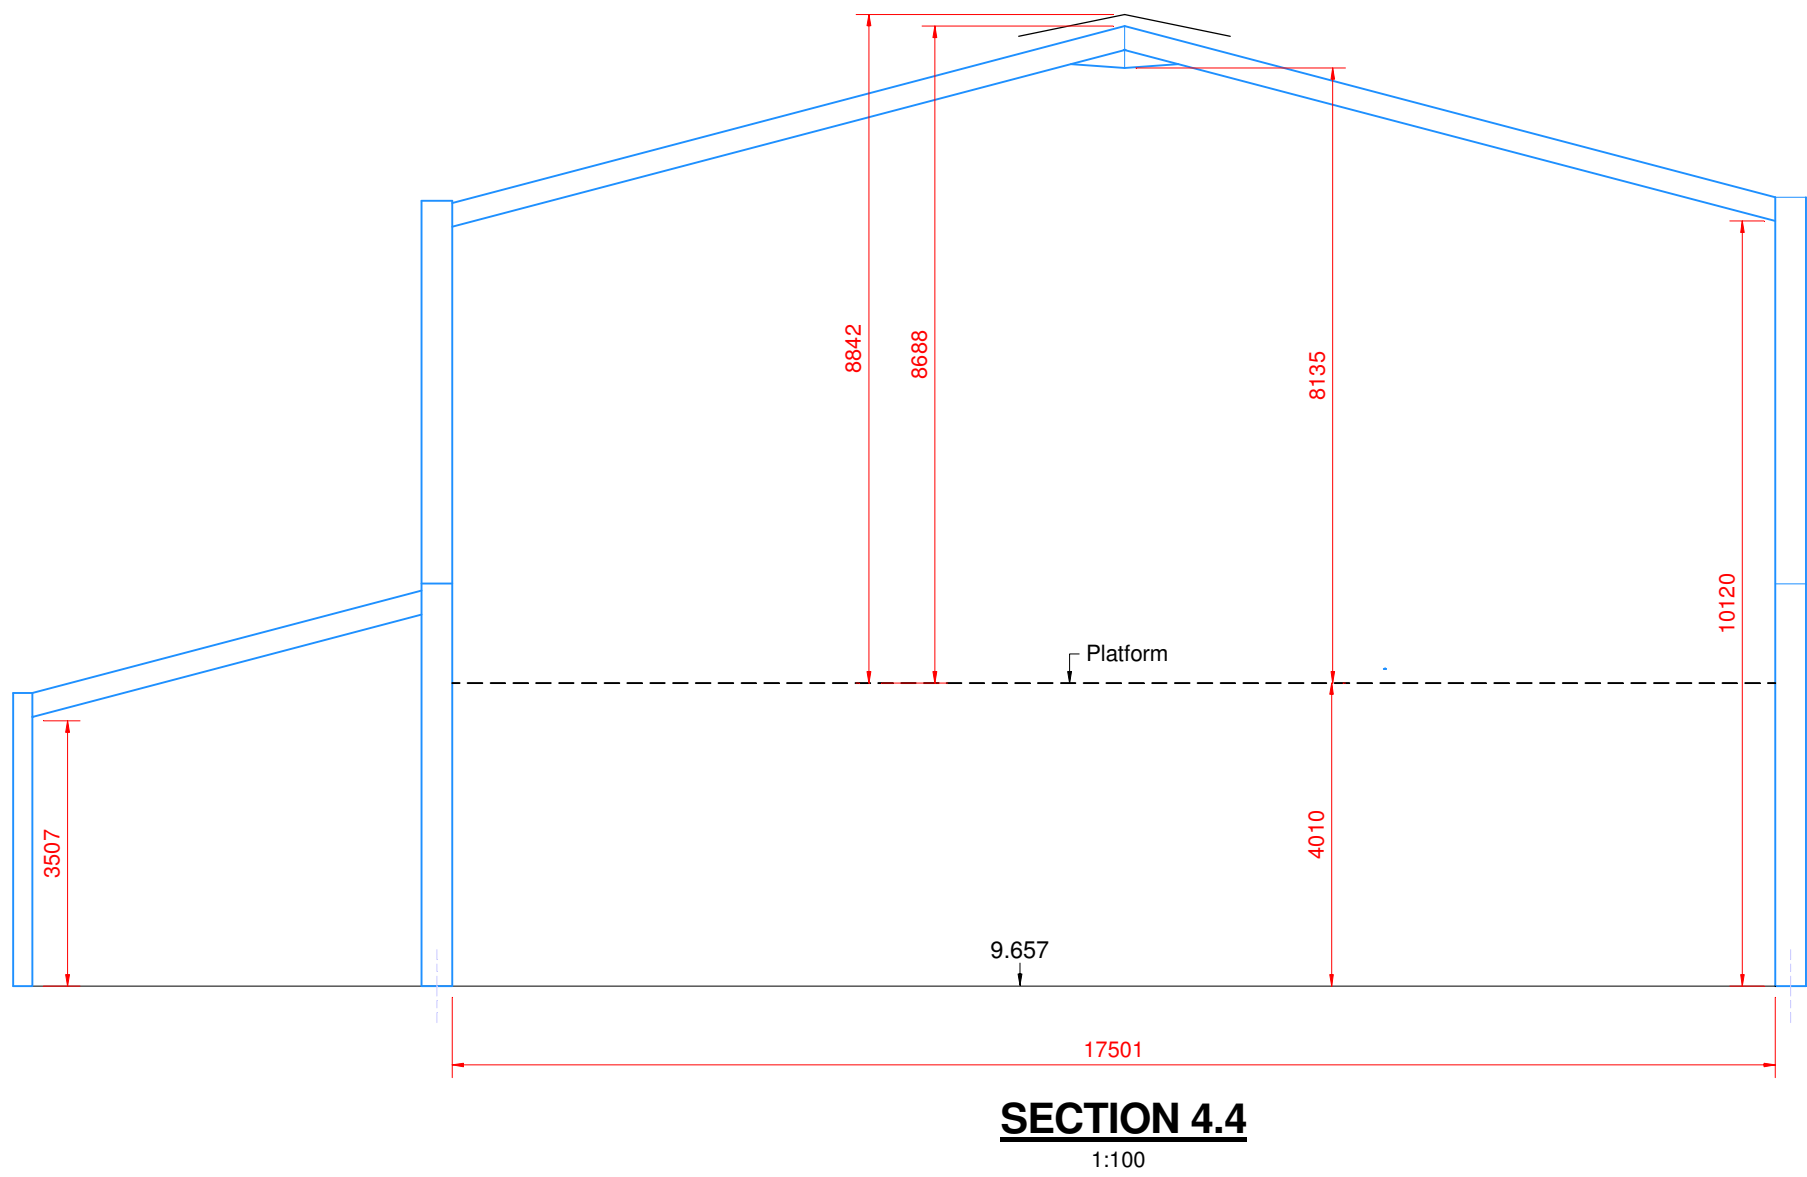
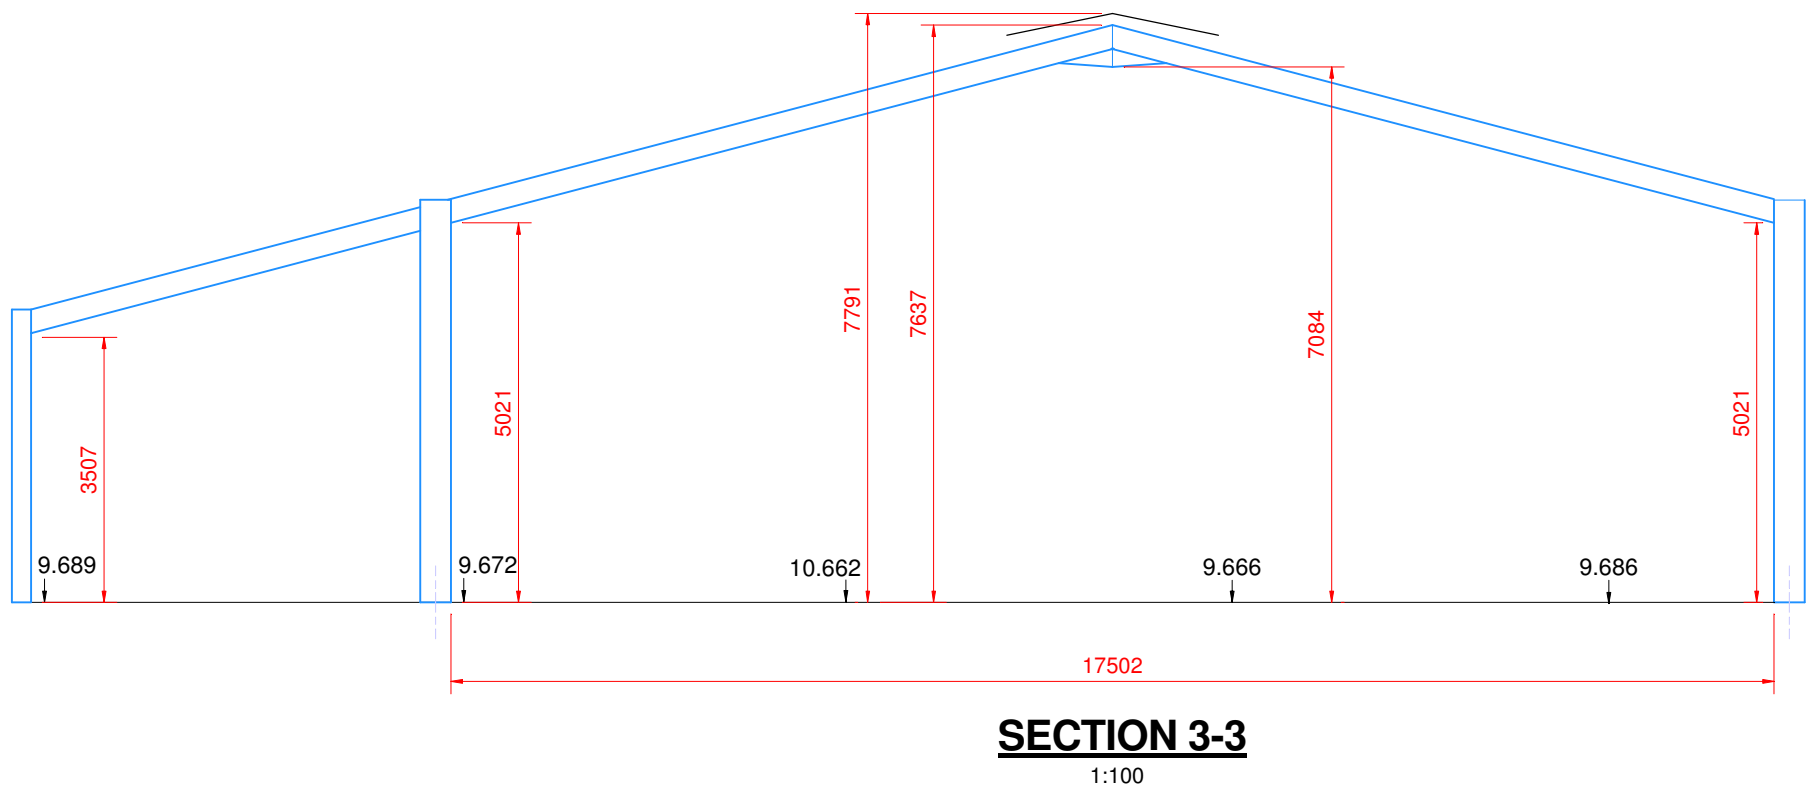
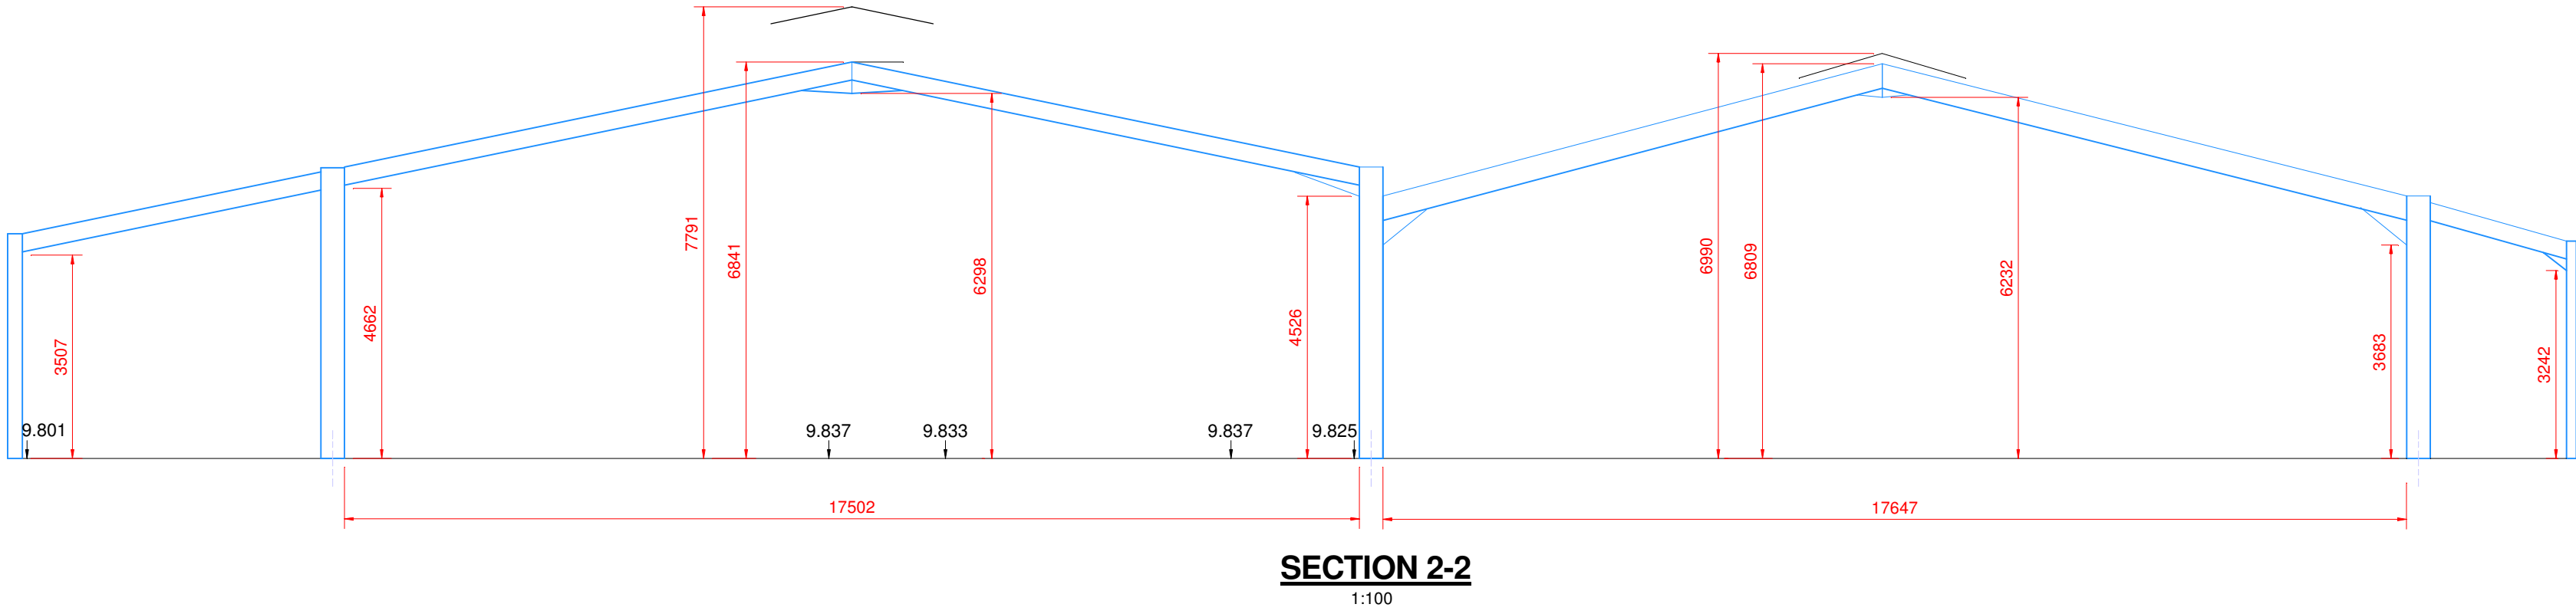


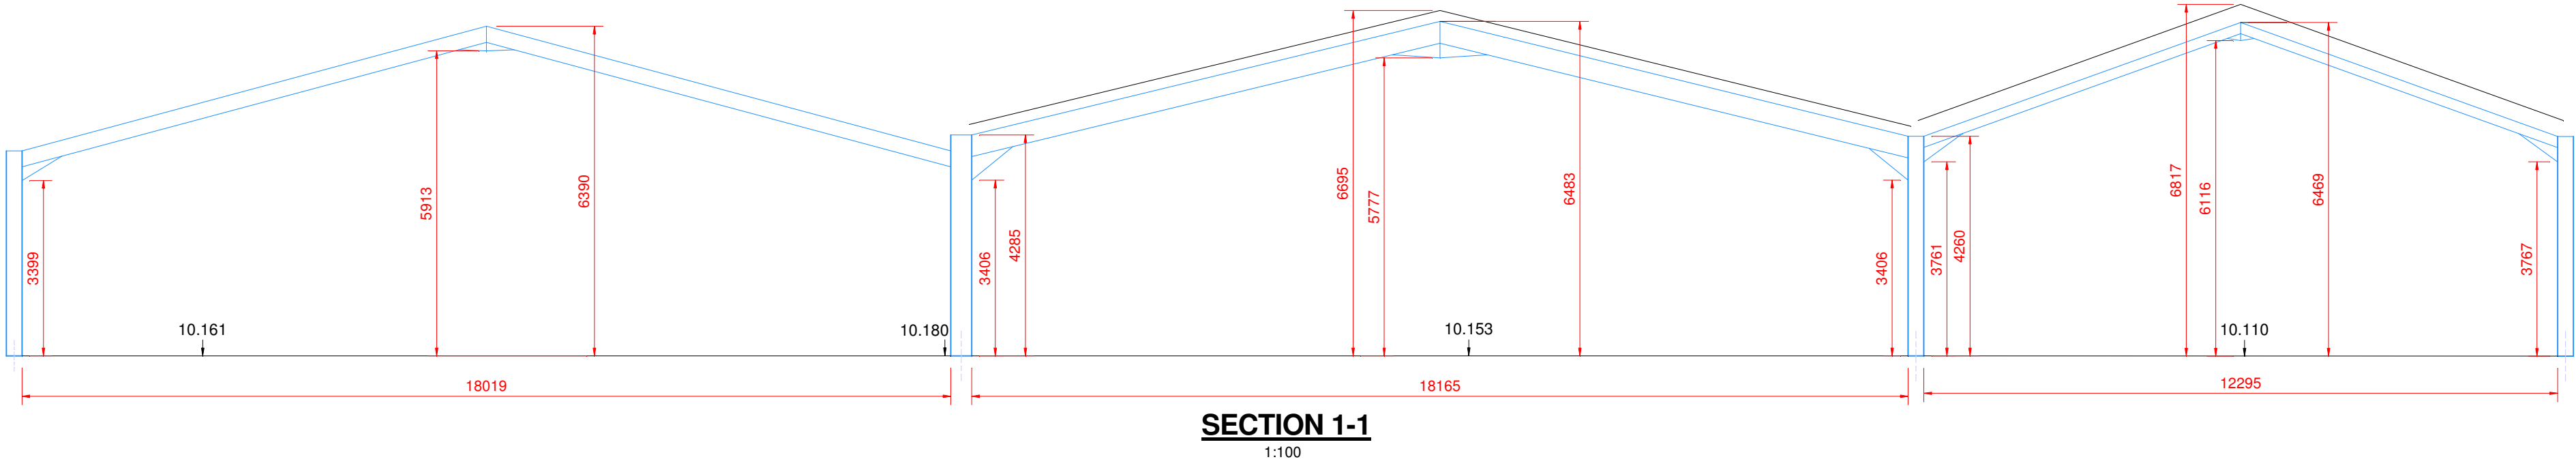

Project				WYATT & WATTS CONSULTING CIVIL AND STRUCTURAL ENGINEERS Wyatt & Watts Ltd 39 Llanmias Street Carmarthen Tel : 01267 234294 watts_martin@btconnect.com			
Title							
SECTIONS AND FLOOR AREAS							
Scale	Date	Drawn	Checked	Paper size	Job No	Dwg No	Rev
1:100 1:250	8.4.14.	MH	MJMW	A1	7058	03	