



Notes

ALL LEVELS ARE IN METRES DERIVED FROM GPS TRANSFORMATION OSGM15
 THE CO-ORDINATES ARE DERIVED FROM THE ORDNANCE SURVEY ACTIVE STATION NETWORK OSTN15 (BASE STATION ST02)

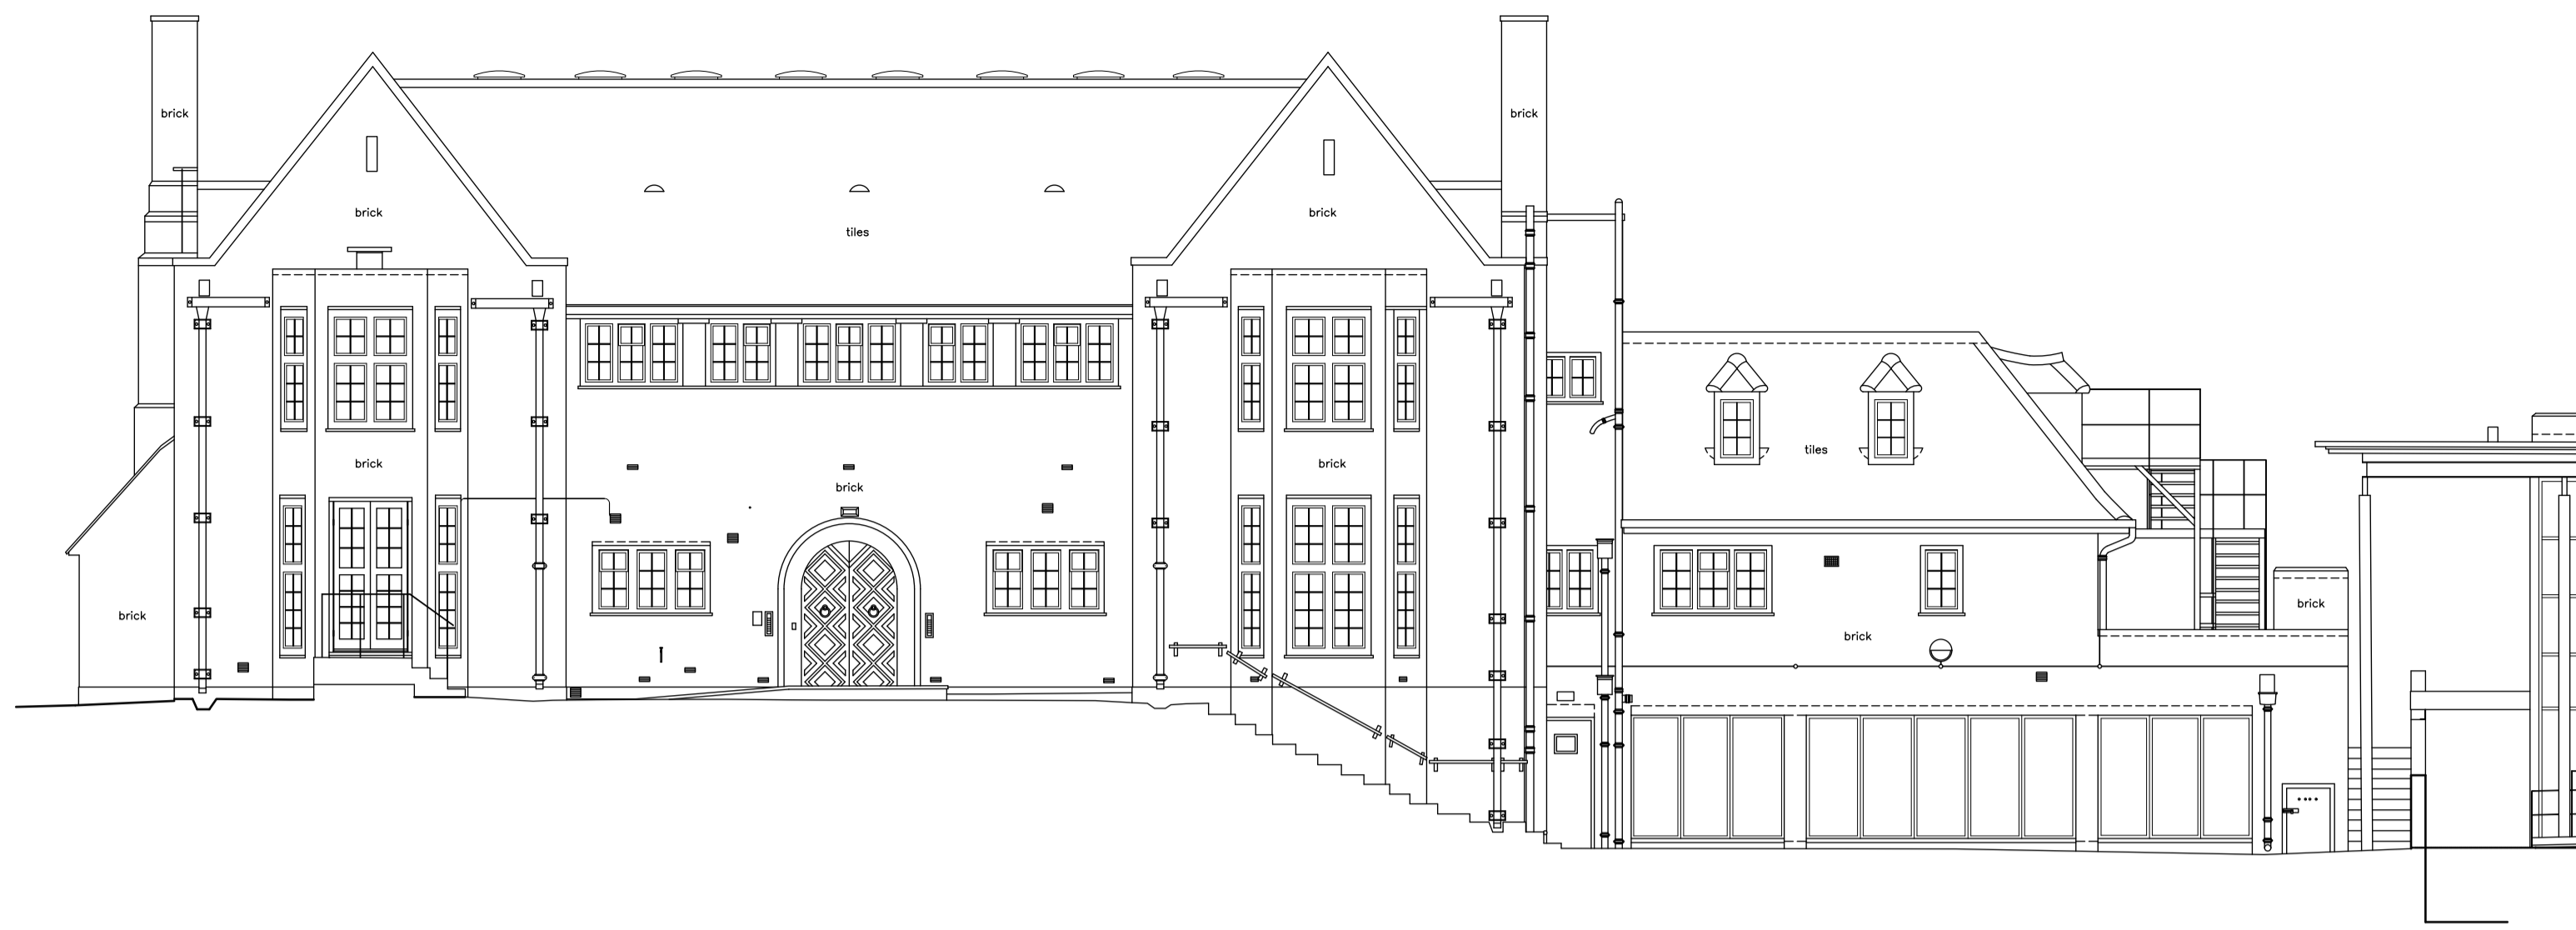

NORTH ELEVATION
 Δ 147.00m A.O.D.

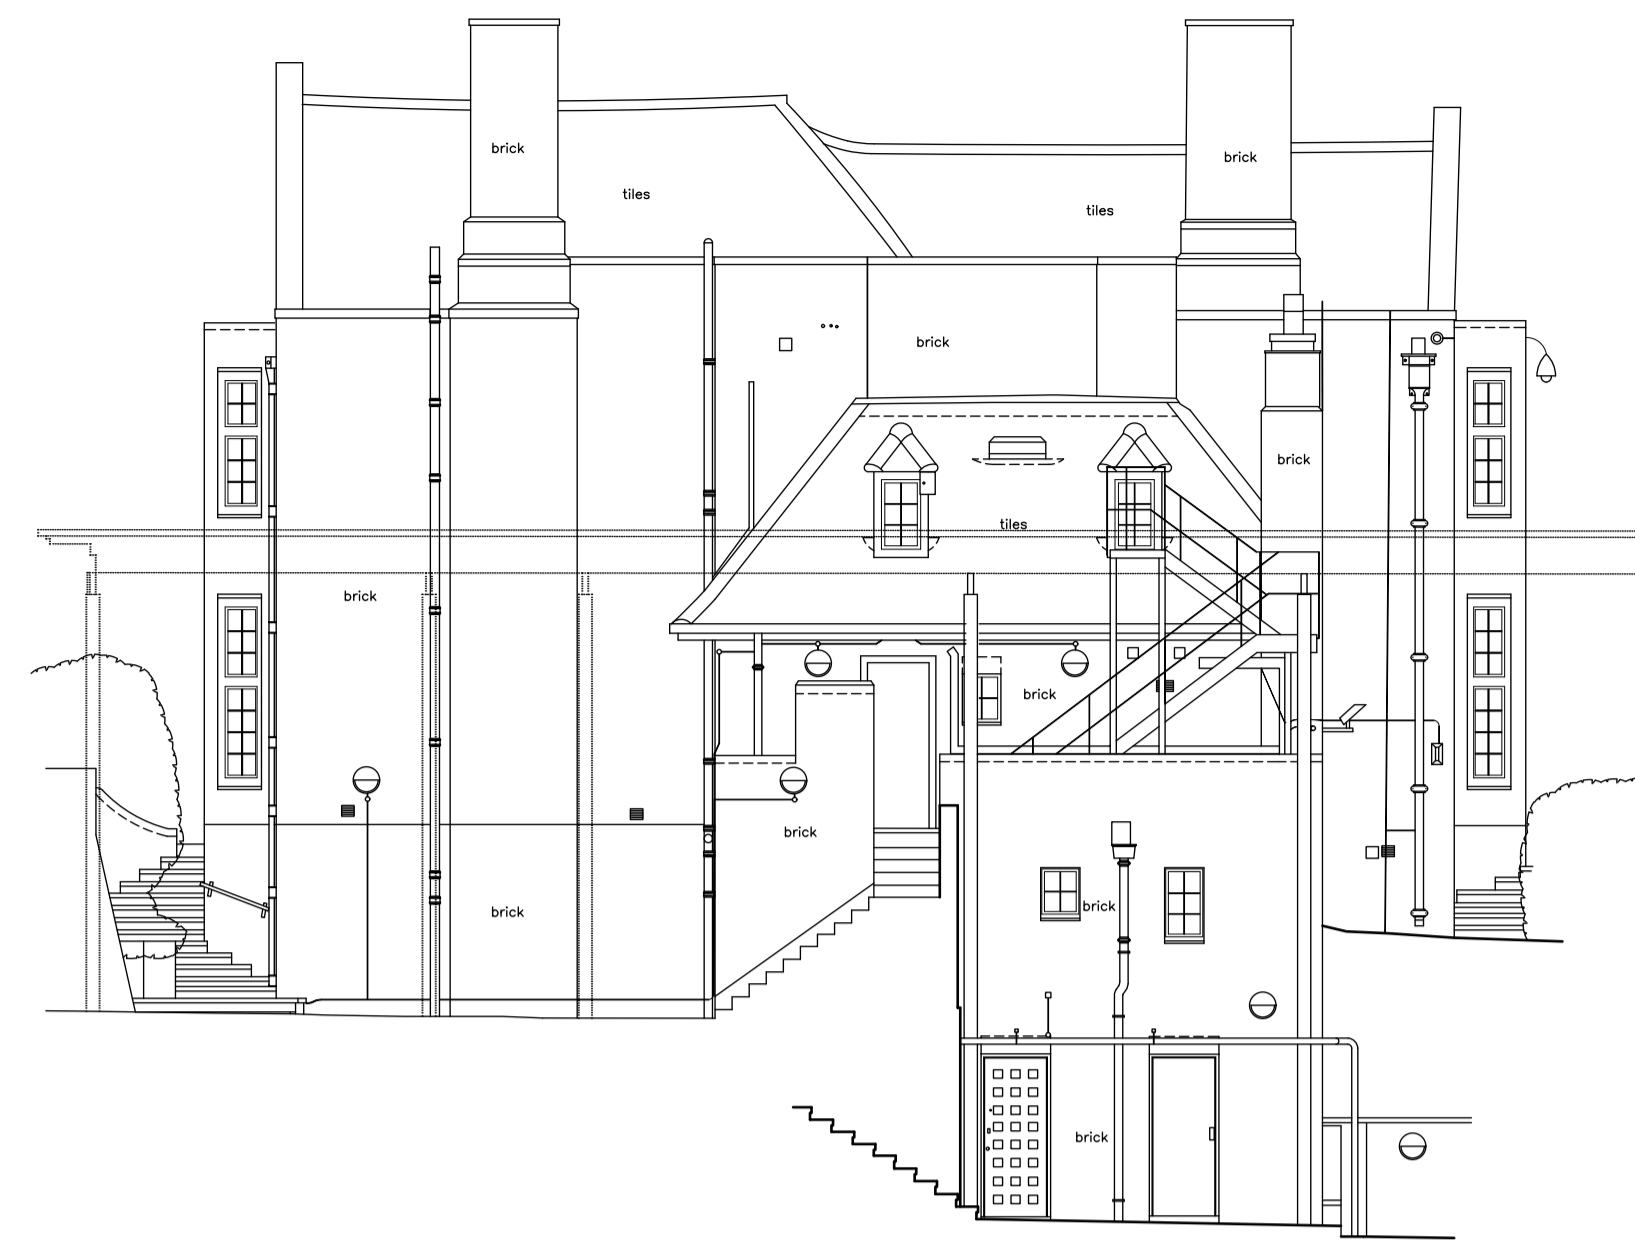


WEST ELEVATION
 Δ 147.00m A.O.D.




SOUTH ELEVATION
 Δ 147.00m A.O.D.



EAST ELEVATION
 Δ 147.00m A.O.D.

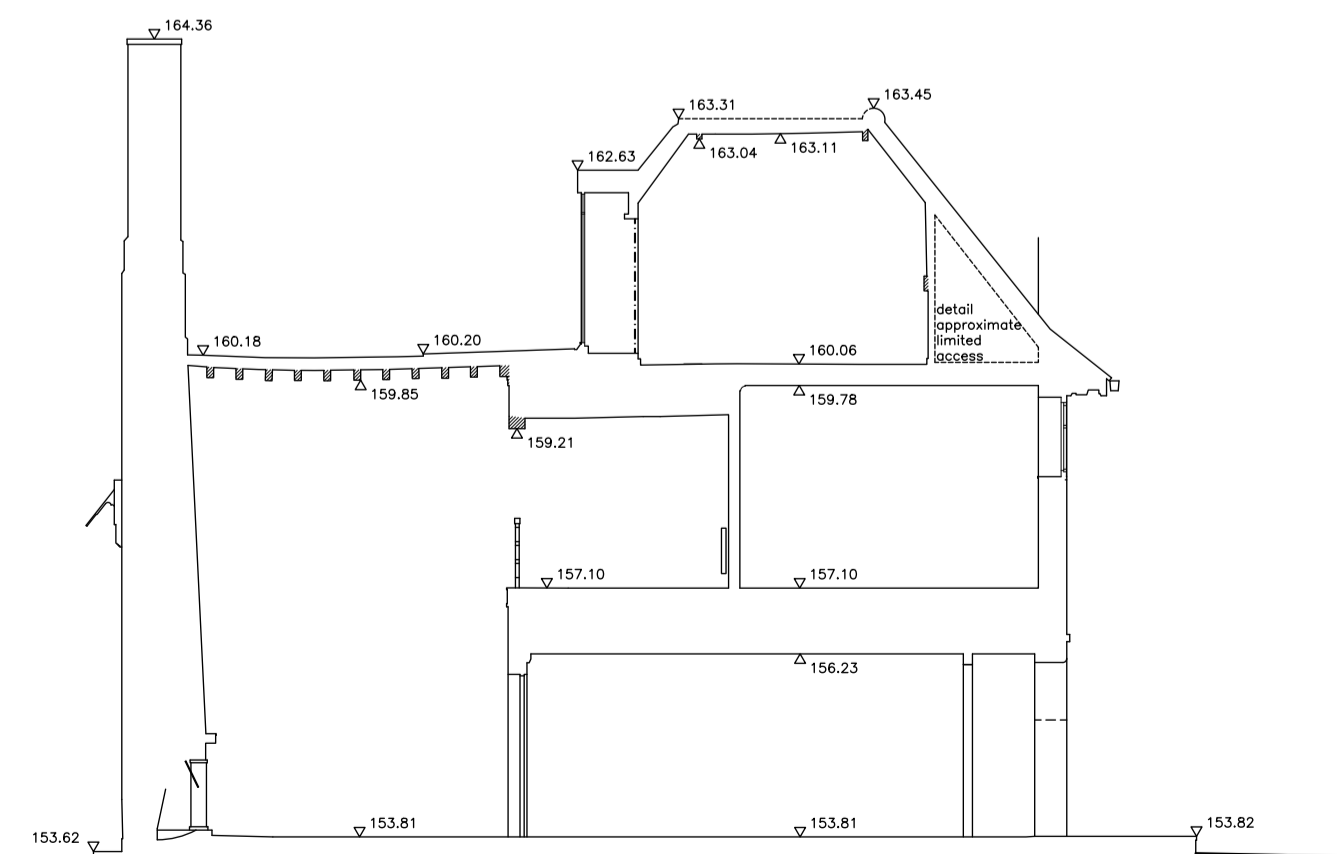

SECTION A - A
 Δ 151.00m A.O.D.

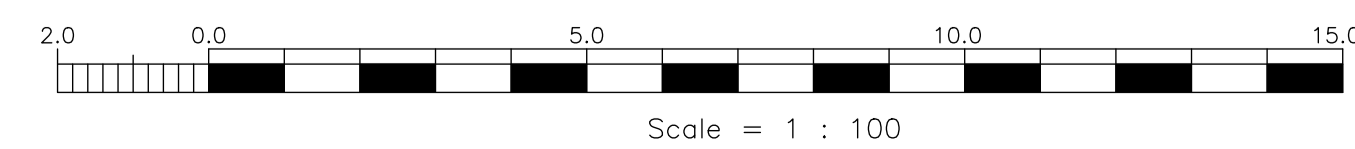

AS/HL/RW © ON CENTRE SURVEYS LTD, 2026

job **BEVAN HOUSE & RAVENSURBY HOUSE**
 9 WESTBOURNE ROAD
 BIRMINGHAM
 WEST MIDLANDS
 B15 3TR

client **CALTHORPE ESTATES**

title **ELEVATIONS & SECTION A-A**
 RAVENSURBY HOUSE

dwg no. 29785A/7

scale 1/50

date 9th March 2026

ON CENTRE SURVEYS LTD.
 LAND & BUILDING SURVEYORS
 GEODETIC ENGINEERS
 2 CHARLES COURT, BUDBROOKE ROAD, WARWICK CV34 5LZ
 TEL: 01925 494294
 E-MAIL: info@oncentre.co.uk
 A member of The Survey Association