



Existing First Floor Plan

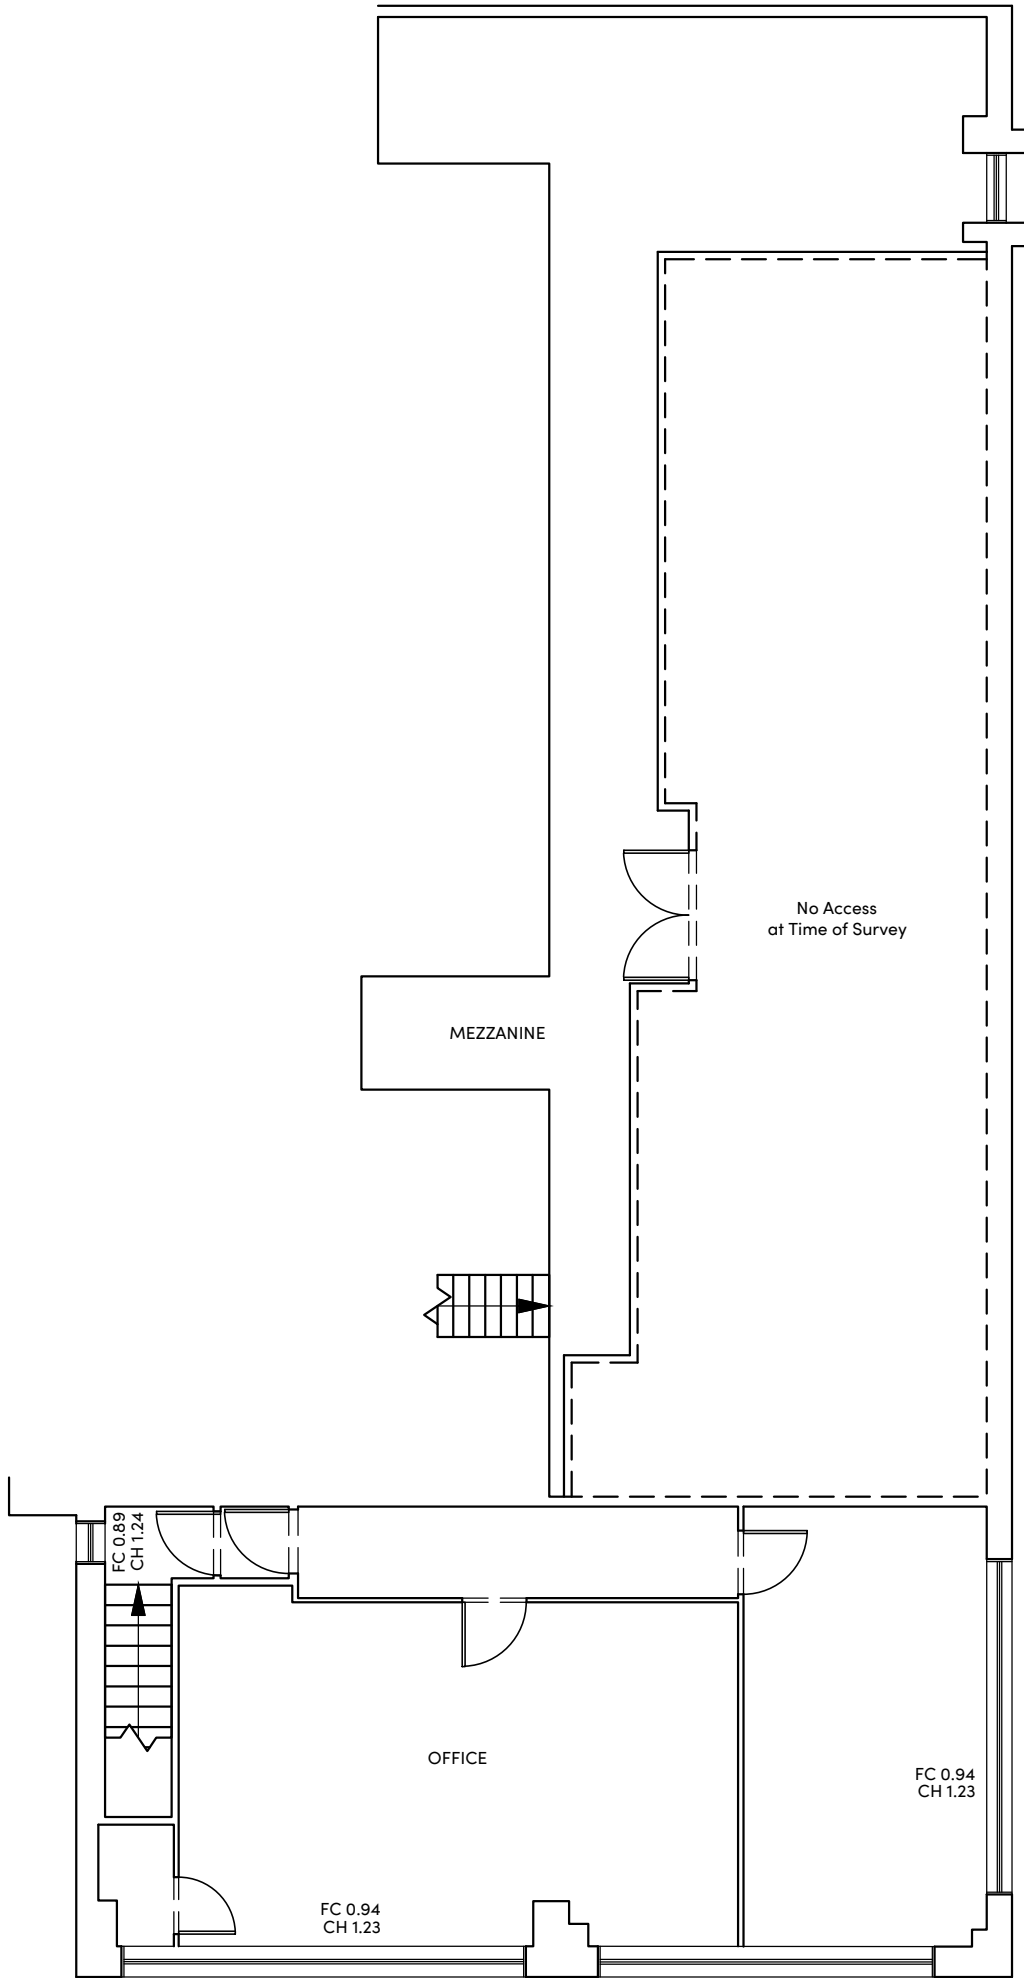

Existing Ground Floor Plan

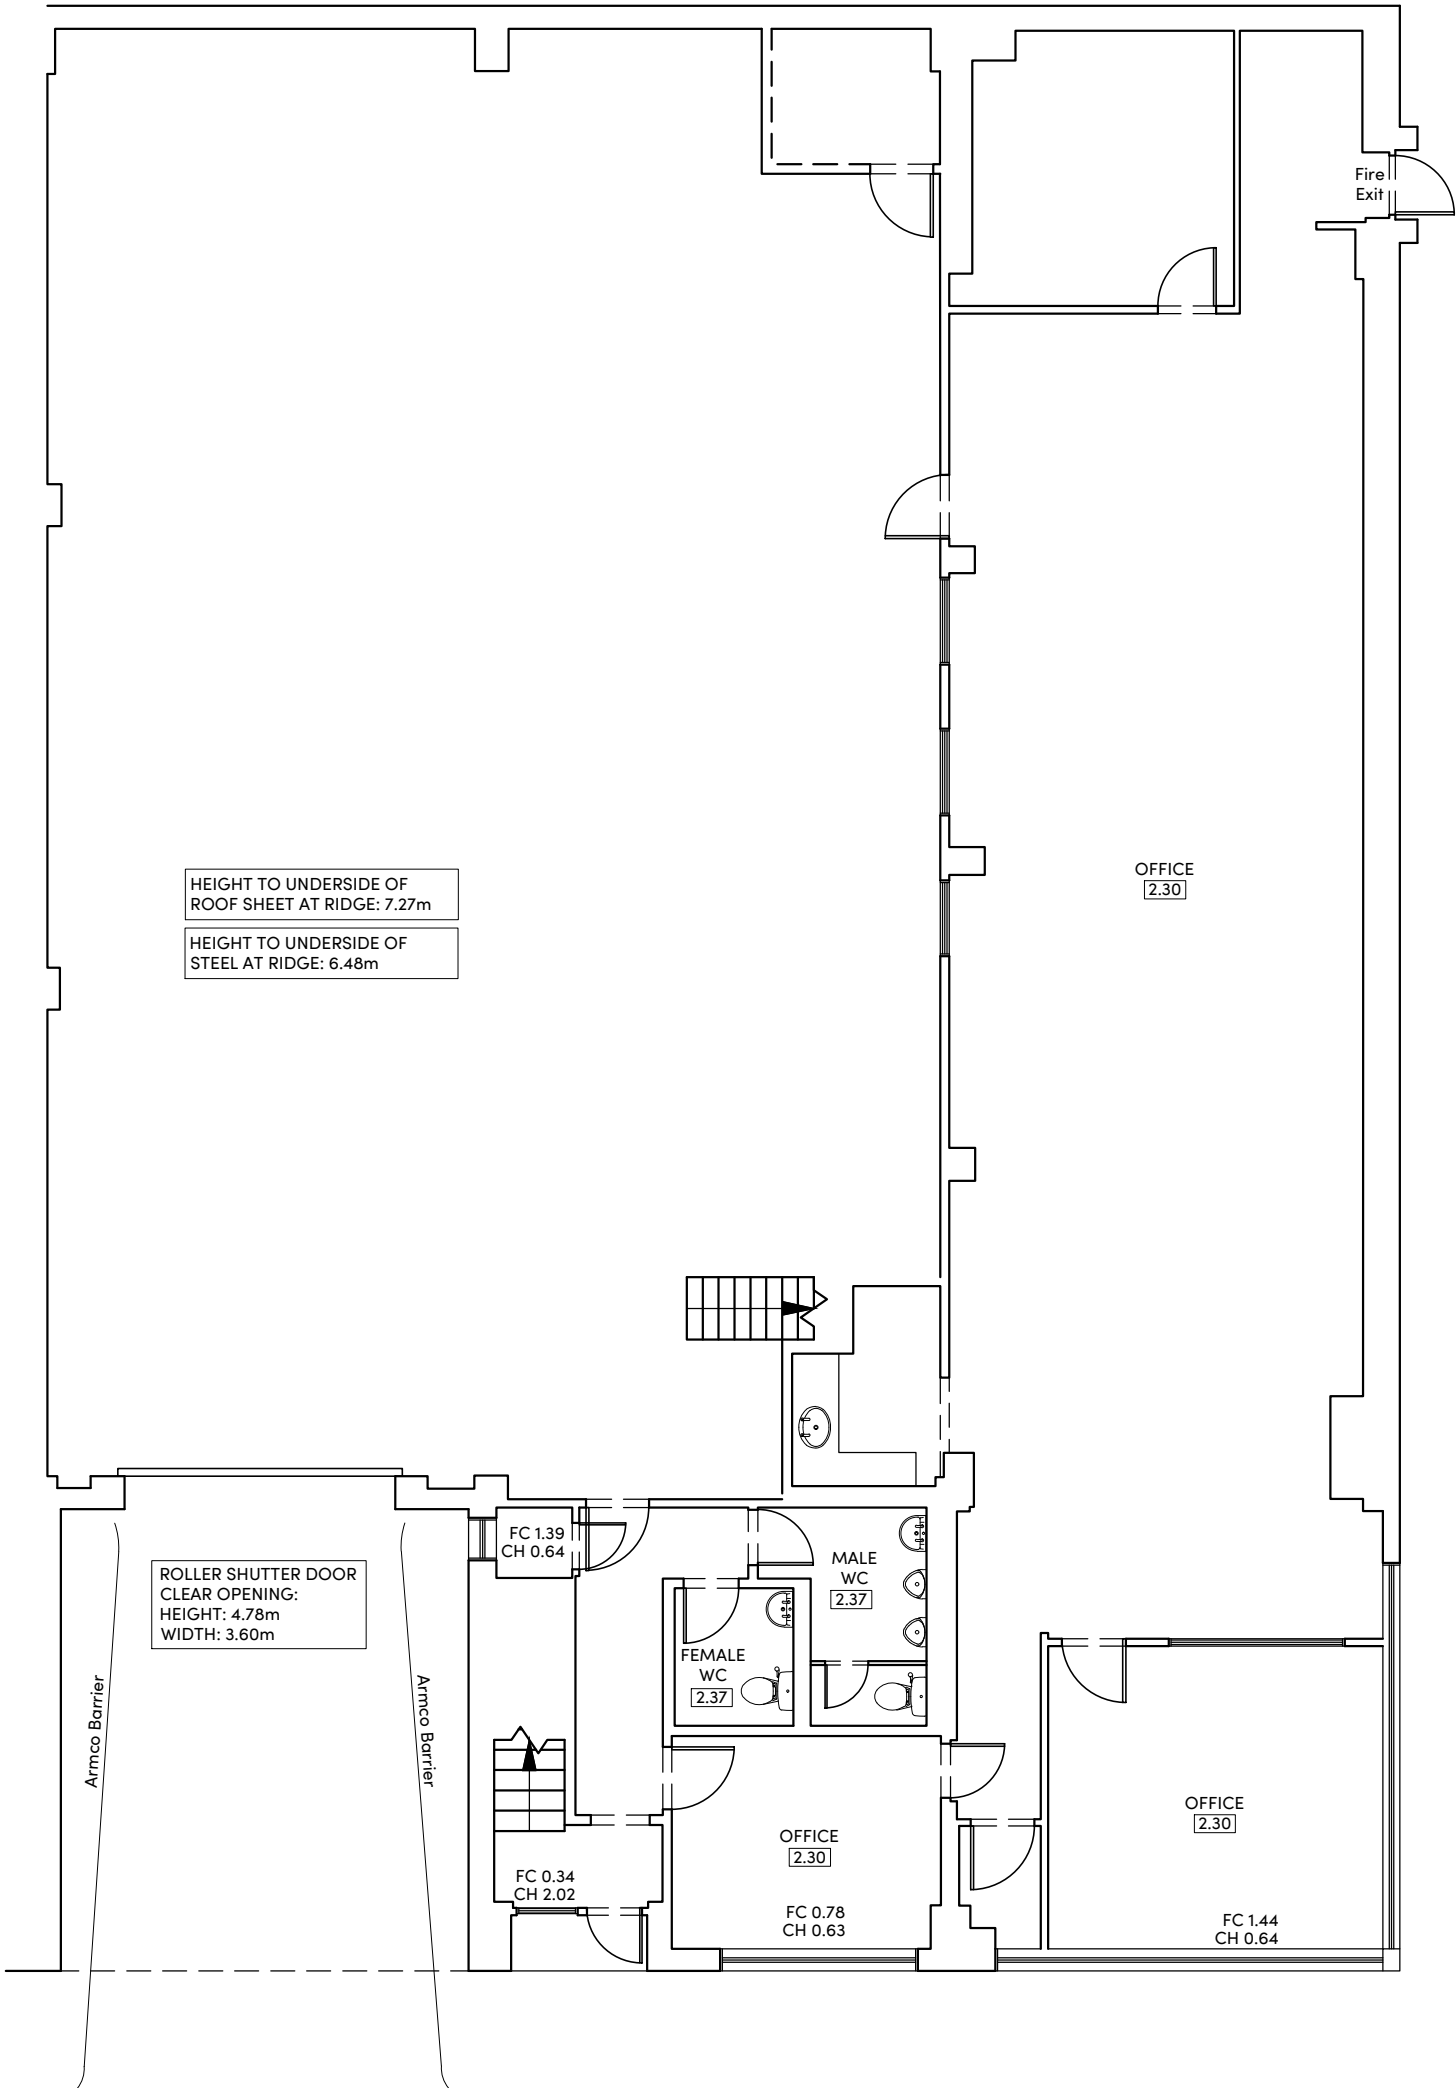


NOTES

- 1) ALL DIMENSIONS TO BE CHECKED ON SITE AND NOT SCALED FROM THIS DRAWING.
- 2) HOLLIS SHALL BE INFORMED IN WRITING OF ANY DISCREPANCIES.
- 3) ALL DIMENSIONS ARE IN METRES ONLY.
- 4) THE ORIGIN AND ORIENTATION OF THE SURVEY GRID RELATE TO AN ARBITRARY GRID.
- 5) ALL LEVELS ARE BASED ON AN ARBITRARY DATUM.

KEY

A	Alarm	h	Height
A/C	Air Conditioner	HB	Hand Bath
AK	Arch Height	HB	Handrail
AL	Arch Level	IC	Inspection Cover
ASH	Arch Spring Height	IBF	Iron-Baling Fence
ASL	Arch Spring Level	JB	Junction Box
ATM	Automated Teller Machine	L	Light

FLOOR PLAN SYMBOLS

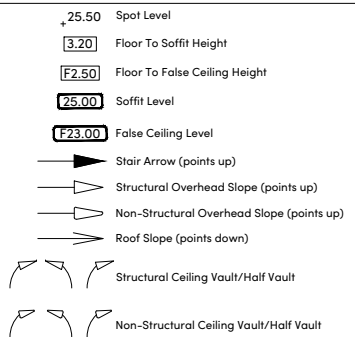

REVISIONS

REV	DATE	AMENDMENTS	INITIAL

THIS DRAWING IS FOR THE FOLLOWING PURPOSE ONLY:
PRELIMINARY ☐ TENDER ☐ CONSTRUCTION ☐
SKETCH ☐ MEASURED SURVEY ☒ CONTRACT ☐

TITLE
EXISTING GROUND &
FIRST FLOOR PLAN

CLIENT
JLL
4 Longwalk, Stockley Park
Uxbridge
UB11 1FE

PROJECT NAME
Unit 1
Trident Industrial Estate,
Blackthorne Road,
Poyle, SL3 0AX

HOLLIS
140 London Wall
London
EC2Y 5DN

T +44 20 7622 9555
W hollisglobal.com

DATE	02.11.2020	DRAWN BY	MRob
SCALE	1:100	CHECKED	PV
PROJECT	ORIGINATOR	VOLUME/ZONE/BLDG	LEVEL
87628	HLS	U1	ZZ
DISCIPLINE/ROLE	NUMBER	STATUS	REVISION
G	10200	A7	---