


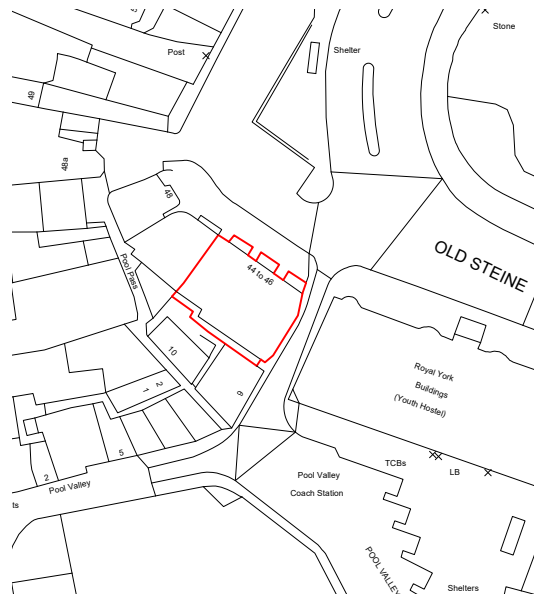

1 Location Plan
Scale: 1:1250



2 Block Plan
Scale: 1:500

Disclaimer:

This drawing is the copyright of archangels ARCHITECTS Ltd and may not be reproduced or used except by written permission.

Figured dimensions to have precedence over scaling. Check all site dimensions prior to fabrication. Refer any discrepancies found to archangels ARCHITECTS Ltd.


Revisions:

** dd/mm/yyyy **

Checked



**


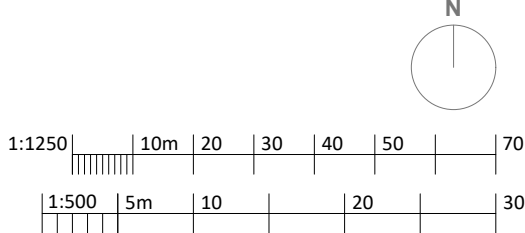


Dwg No. 25017-P-001

Drawing Title Location & Block Plan
Address 44-46 Old Steine, Brighton BN1 1NH
Client Stephen Antram
Scale 1:1250 & 1:1500
Stage Survey
Drawn by MMS
Checked by RZ

archangels
ARCHITECTS

create your dream home
archangels ARCHITECTS Ltd
Suite 7 & 8, 5th Floor, Vantage Point, New
England Road, Brighton, BN1 4GW
e: info@aaarchitects.co.uk, t: 01273 267184
www.aaarchitects.co.uk

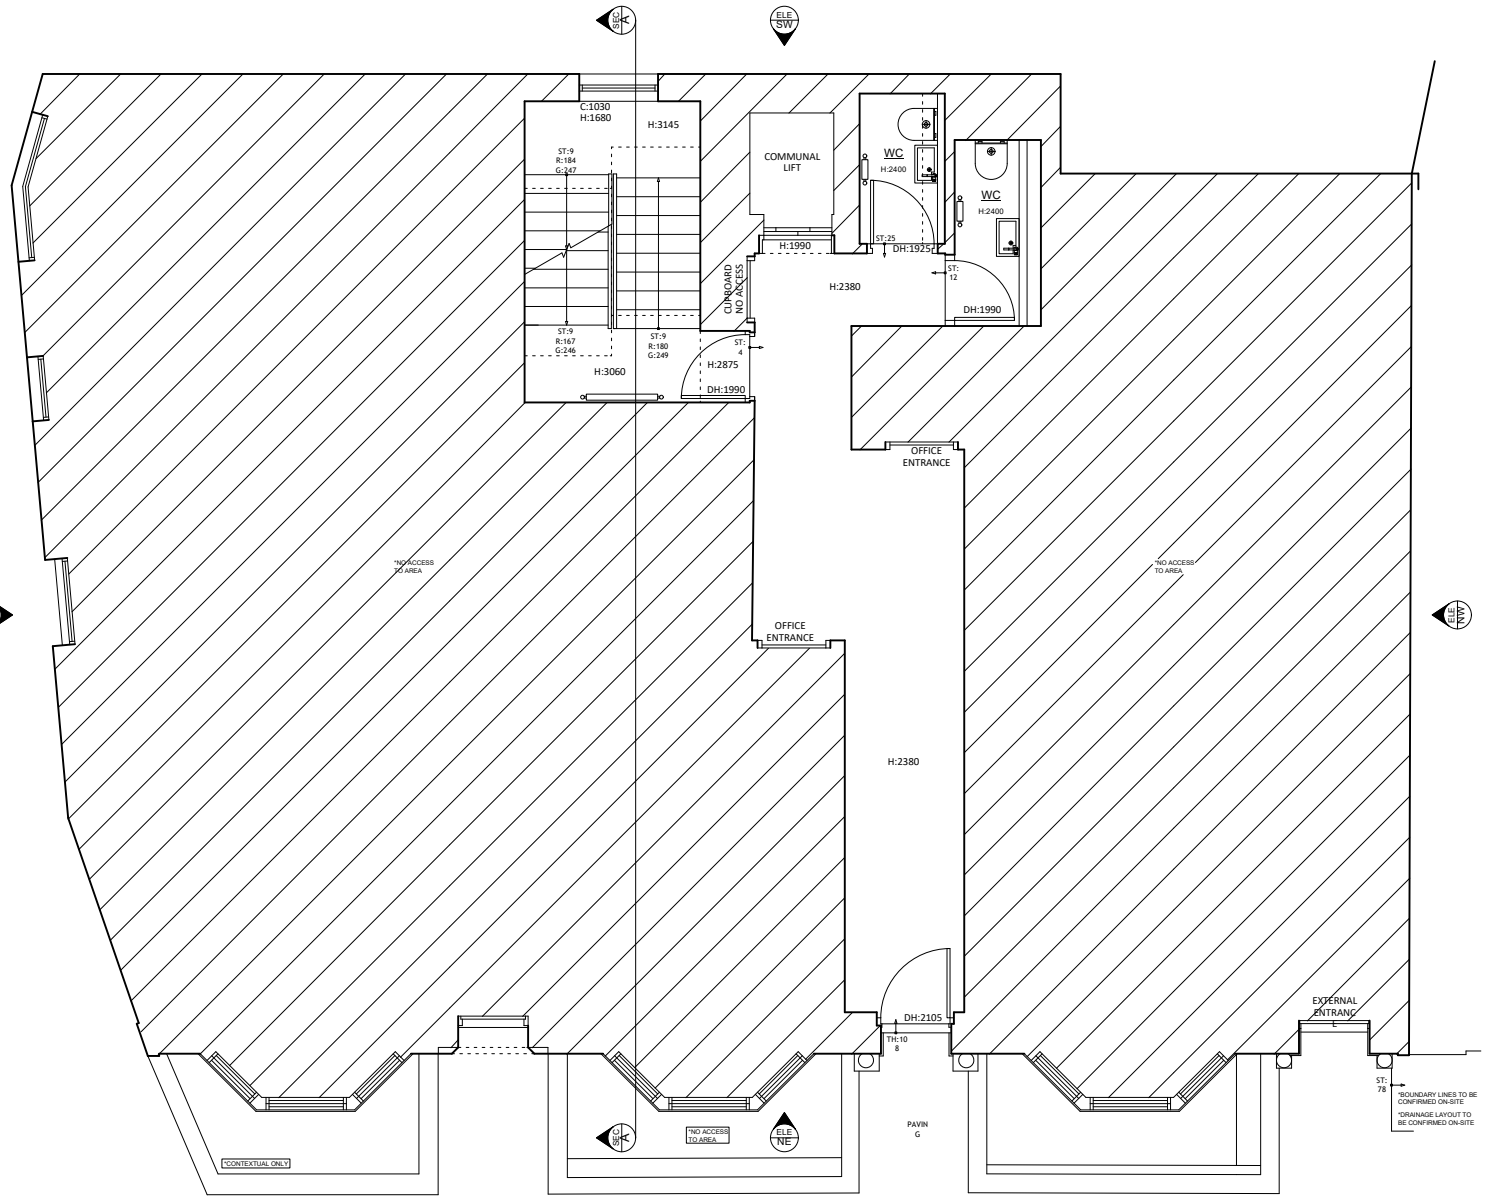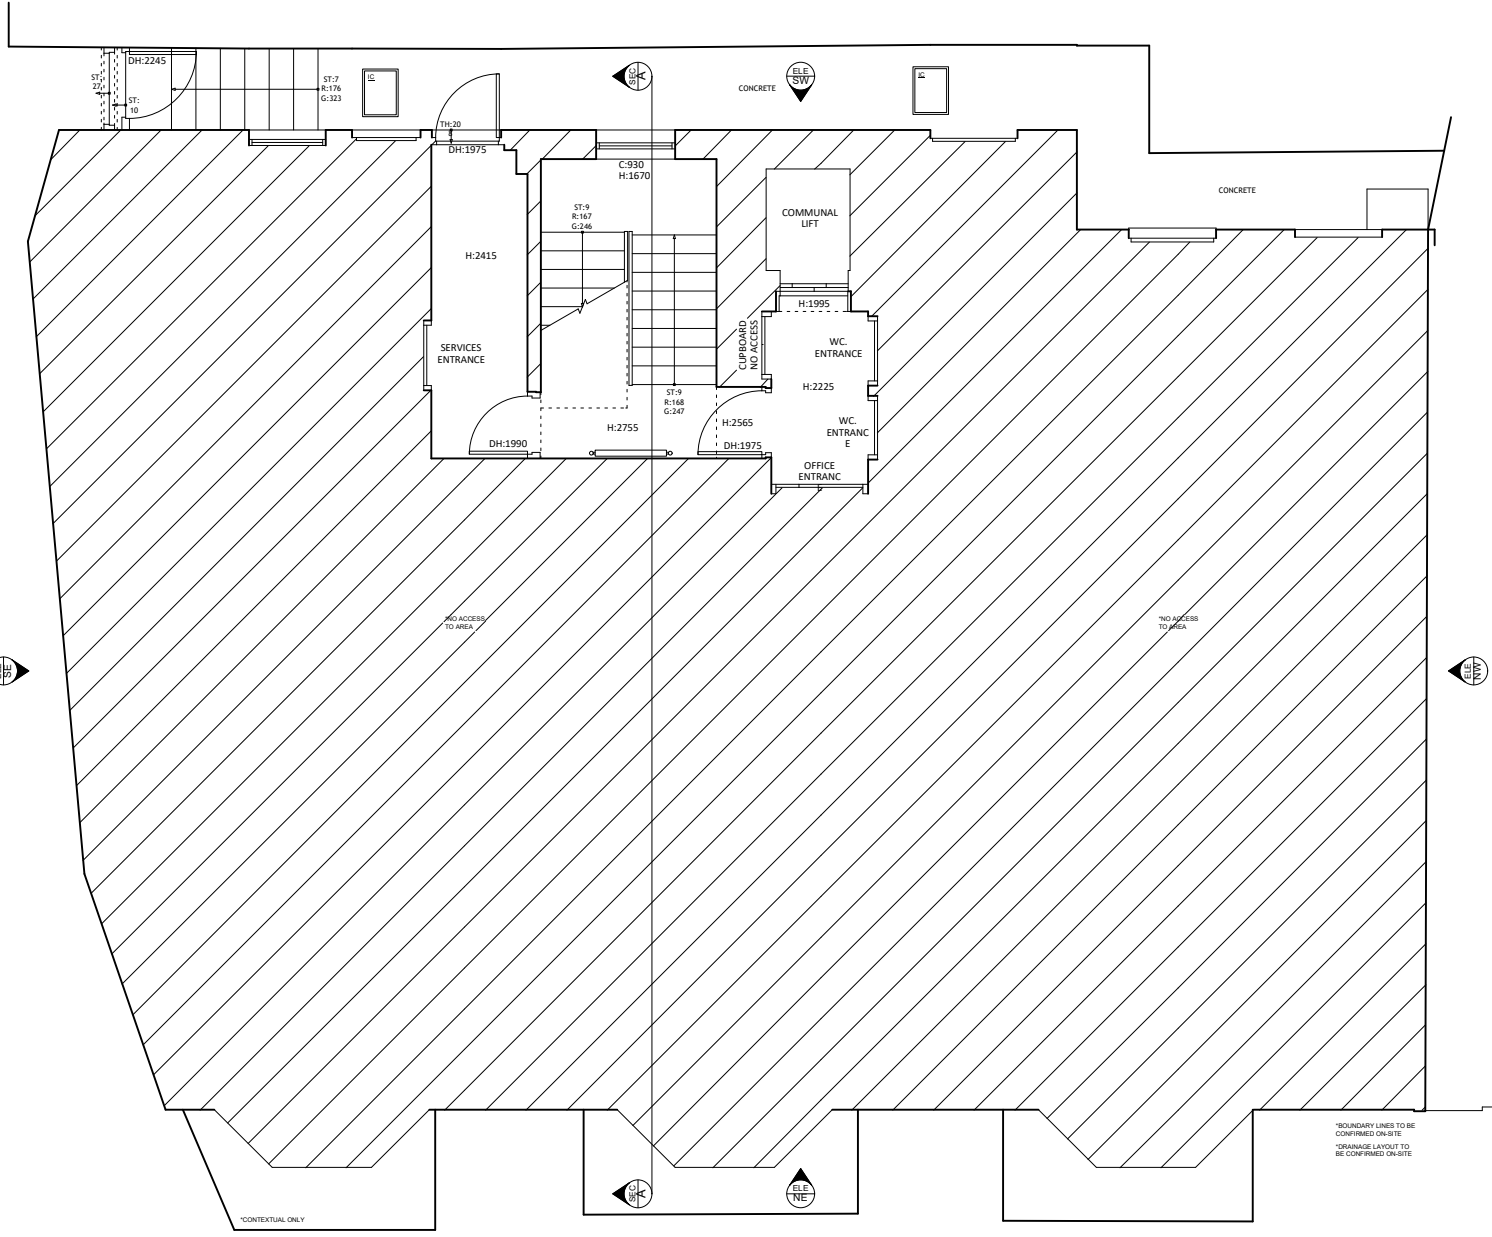

1 Existing Lower Ground Floor Plan
Scale: 1:100

2 Existing Ground Floor Plan
Scale: 1:100

Disclaimer:

This drawing is the copyright of archangels ARCHITECTS Ltd and may not be reproduced or used except by written permission.


Figured dimensions to have precedence over scaling. Check all site dimensions prior to fabrication. Refer any discrepancies found to archangels ARCHITECTS Ltd.

Revisions:


**	dd/mm/yyyy	**
----	------------	----

Checked


**

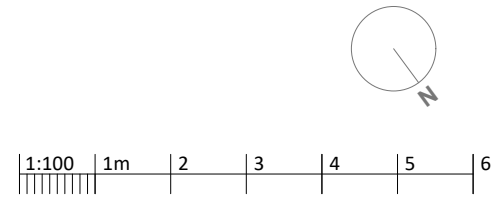

Dwg No.	25017-P-002
Drawing Title	Existing Floor Plans 1/3
Address	44-46 Old Steine, Brighton BN1 1NH
Client	Stephen Antram
Scale	1:100 @ A3
Stage	Survey
Drawn by	MMS
Checked by	RZ

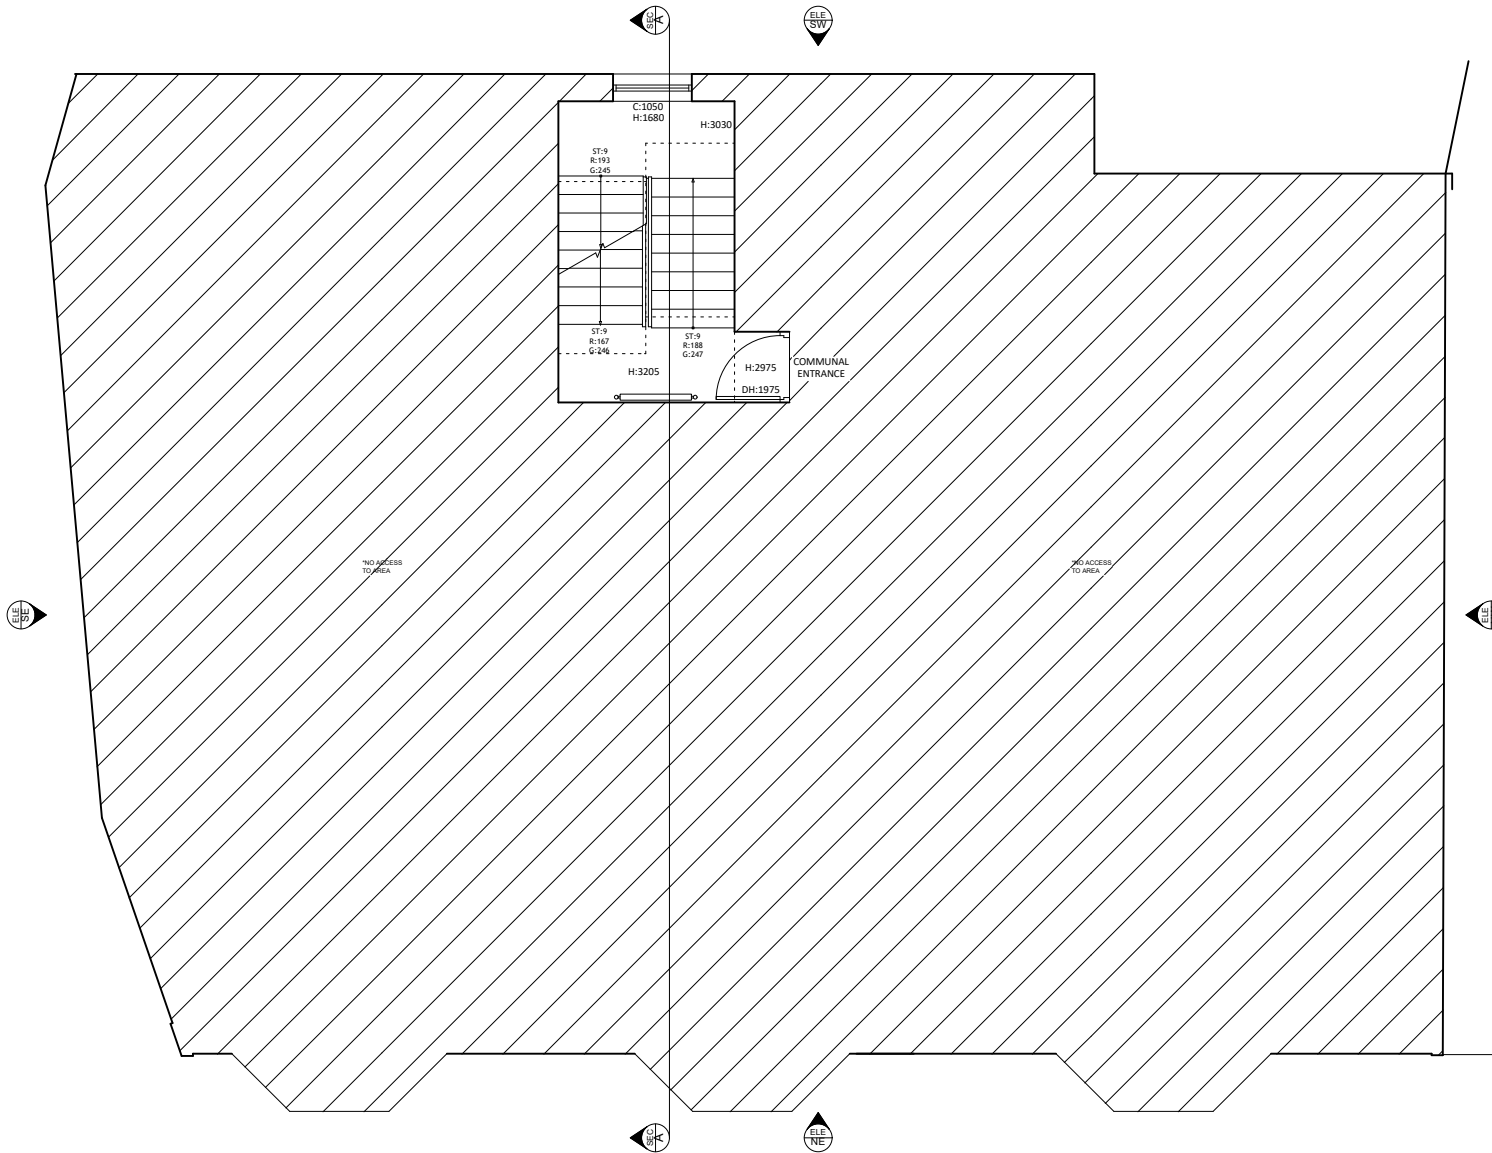

1 Existing First Floor Plan
Scale: 1:100

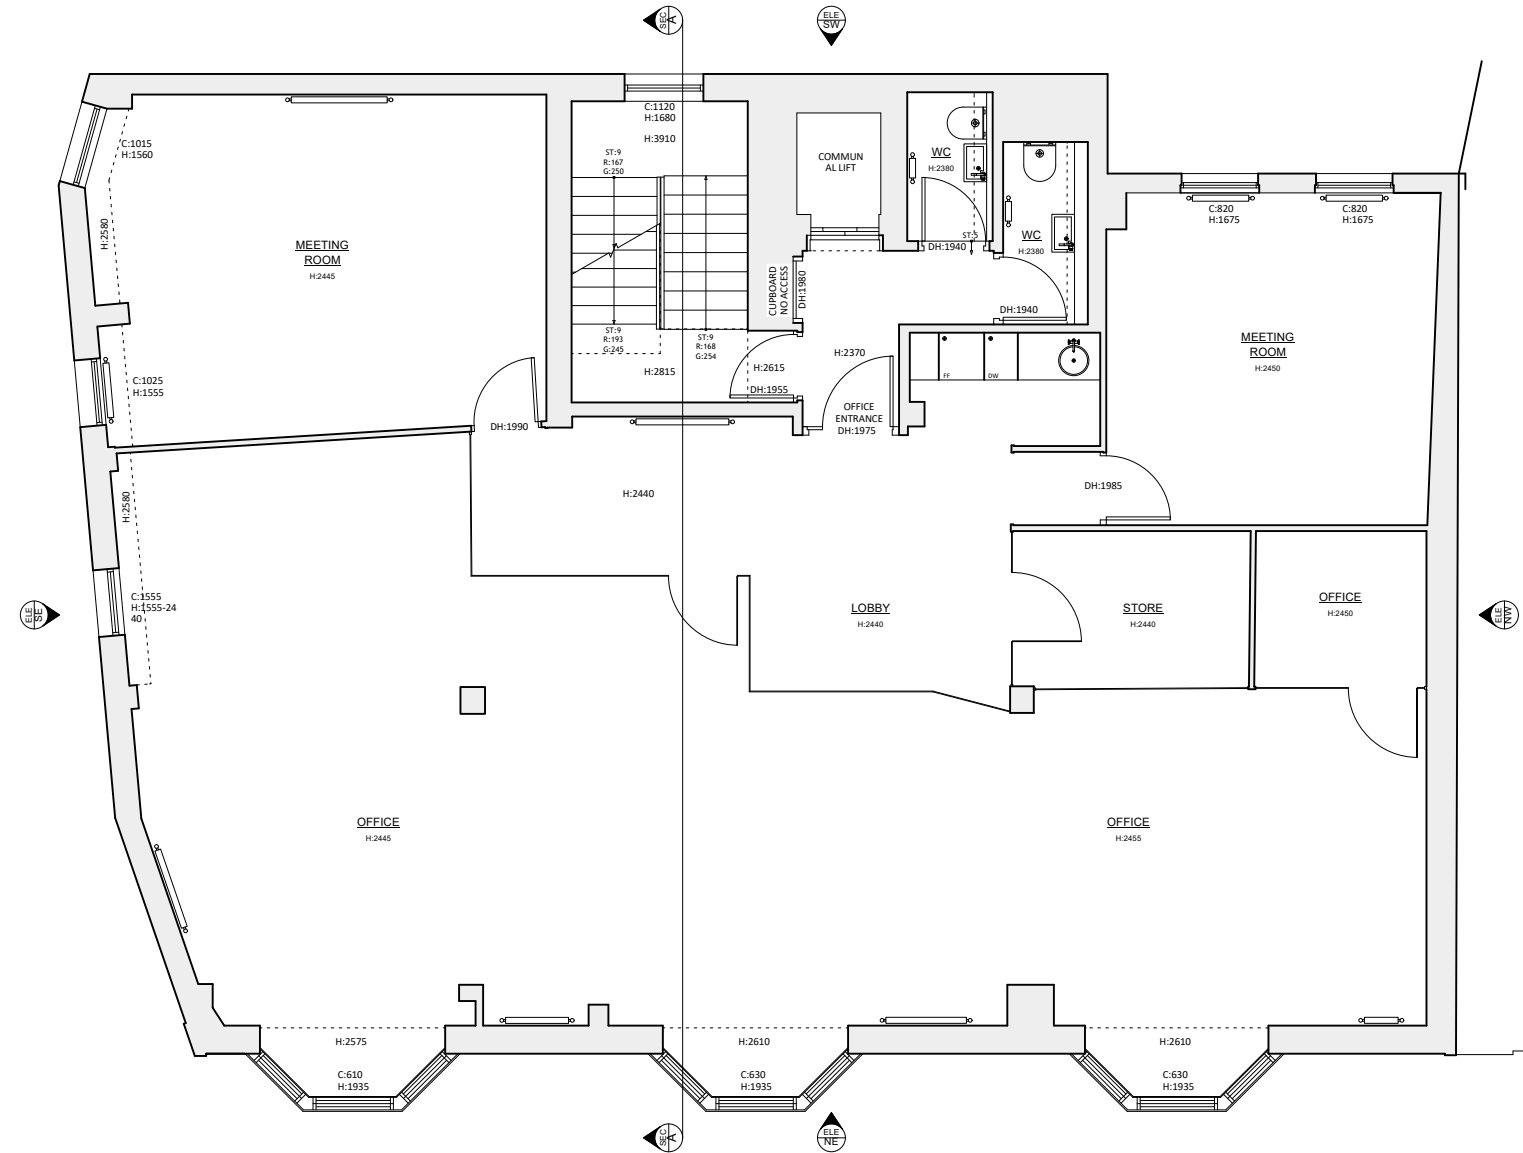

2 Existing Second Floor Plan
Scale: 1:100

Disclaimer:

This drawing is the copyright of archangels ARCHITECTS Ltd and may not be reproduced or used except by written permission.


Figured dimensions to have precedence over scaling. Check all site dimensions prior to fabrication. Refer any discrepancies found to archangels ARCHITECTS Ltd.

Revisions:

** dd/mm/yyyy **

Checked

**

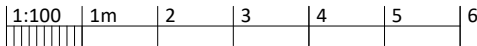


Dwg No. 25017-P-003


Drawing Title Existing Floor Plans 2/3
Address 44-46 Old Steine, Brighton BN1 1NH
Client Stephen Antram
Scale 1:100 @ A3
Stage Survey
Drawn by MMS
Checked by RZ

archangels
ARCHITECTS

create your dream home
archangels ARCHITECTS Ltd
Suite 7 & 8, 5th Floor, Vantage Point, New
England Road, Brighton, BN1 4GW
e: info@aaarchitects.co.uk, t: 01273 267184
www.aaarchitects.co.uk

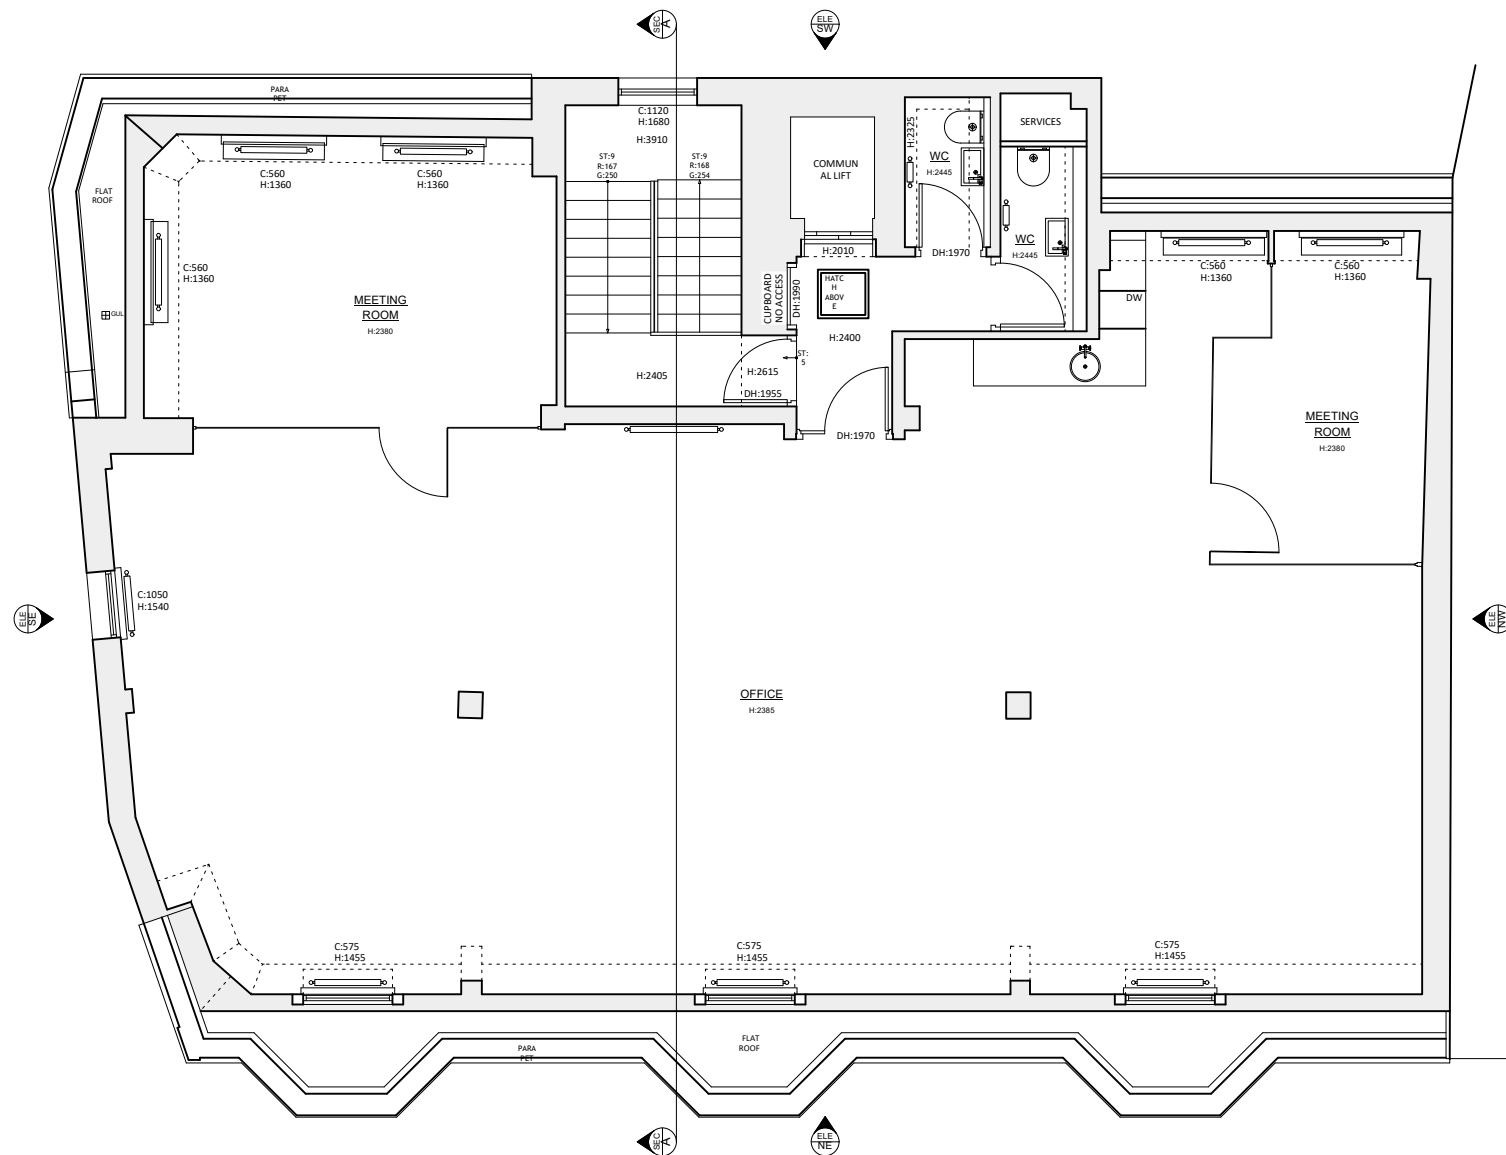

1 Existing Third Floor Plan
Scale: 1:100

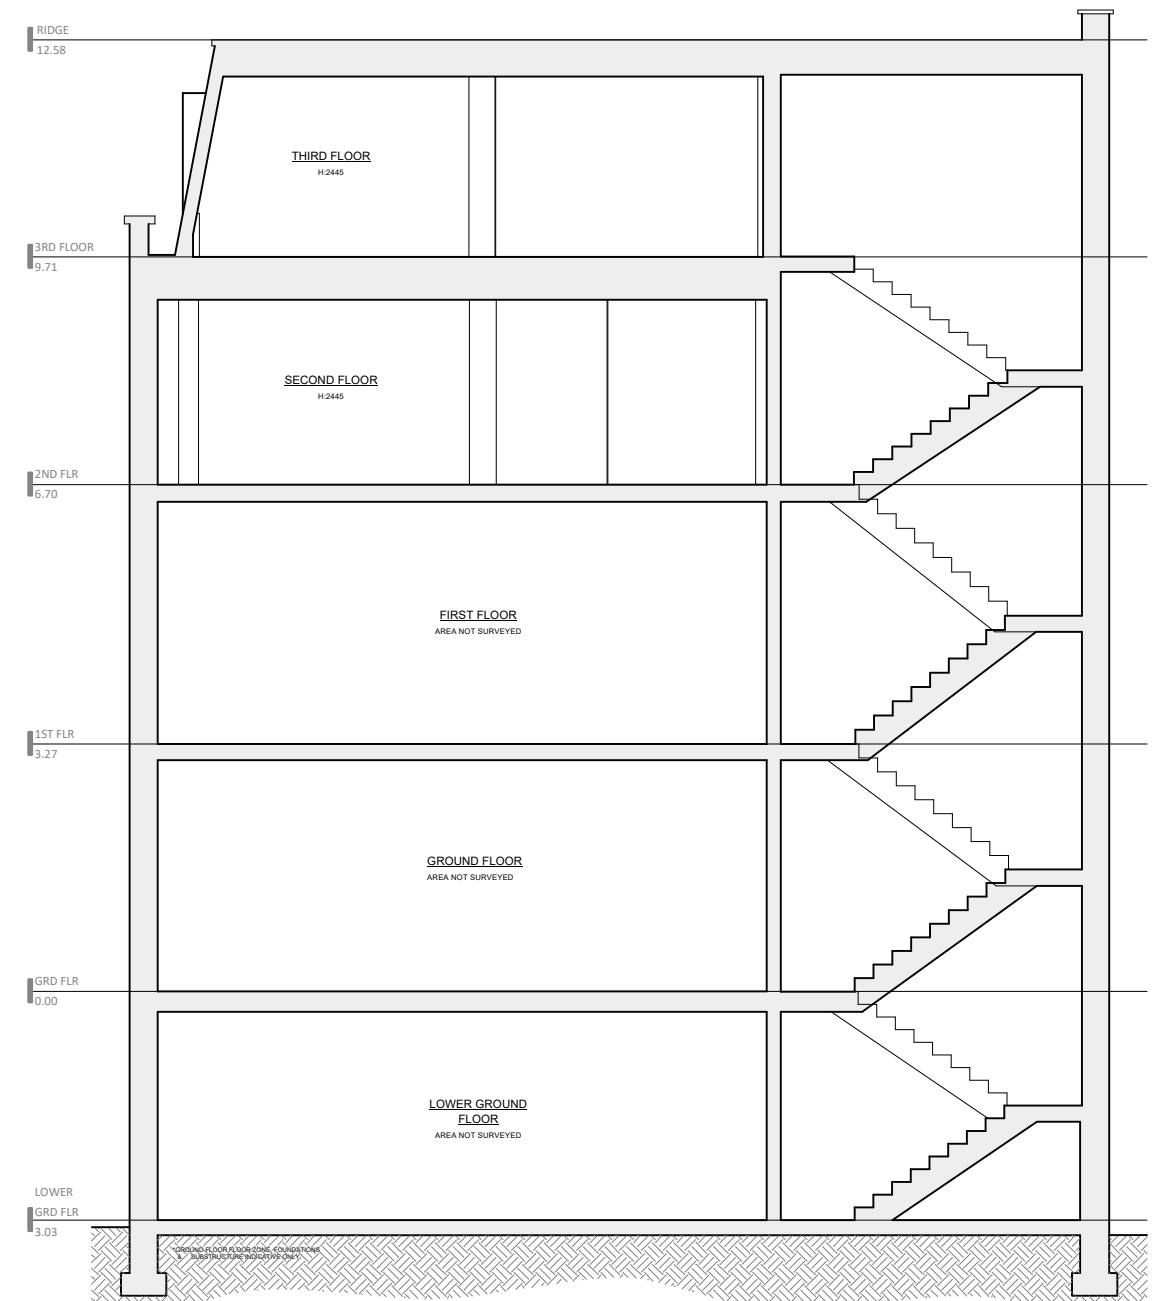

2 Existing Section A-A
Scale: 1:100


Disclaimer:

This drawing is the copyright of archangels ARCHITECTS Ltd and may not be reproduced or used except by written permission.

Figured dimensions to have precedence over scaling. Check all site dimensions prior to fabrication. Refer any discrepancies found to archangels ARCHITECTS Ltd.

Revisions:

**	dd/mm/yyyy	**	Checked ▼	**
----	------------	----	--------------	----

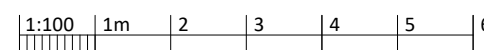



Dwg No. **25017-P-004**

Drawing Title Existing Floor Plans 3/3 and Section A-A
Address 44-46 Old Steine, Brighton BN1 1NH
Client Stephen Antram
Scale 1:100 @ A3
Stage Survey
Drawn by MMS
Checked by RZ

archangels
ARCHITECTS

create your dream home

archangels ARCHITECTS Ltd
 Suite 7 & 8, 5th Floor, Vantage Point, New
 England Road, Brighton, BN1 4GW
 e: info@aaarchitects.co.uk, t: 01273 267184
 www.aaarchitects.co.uk

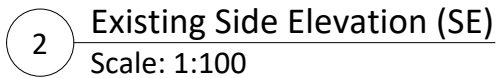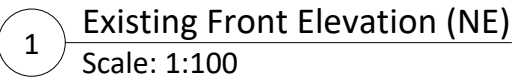


Figured dimensions to have precedence over scaling. Check all site dimensions prior to fabrication. Refer any discrepancies found to archangels ARCHITECTS Ltd.

Revisions:

**** dd/mm/yyyy ****

Checked



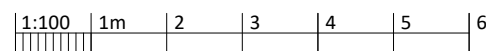

Dwg No. 25017-P-005

Drawing Title	Existing Elevations 1/2
Address	44-46 Old Steine, Brighton BN1 1NH
Client	Stephen Antram
Scale	1:100 @ A3
Stage	Survey
Drawn by	MMS
Checked by	RZ

archangels
ARCHITECTS

create your dream home

archangels ARCHITECTS Ltd

Suite 7 & 8, 5th Floor, Vantage Point, New

England Road, Brighton, BN1 4GW

s.co.uk, t: 01273 267184
www.aaarchitects.co.uk



1 Existing Rear Elevation (SW)
Scale: 1:100

Disclaimer:

This drawing is the copyright of archangels ARCHITECTS Ltd and may not be reproduced or used except by written permission.

Figured dimensions to have precedence over scaling. Check all site dimensions prior to fabrication. Refer any discrepancies found to archangels ARCHITECTS Ltd.


Revisions:

**	dd/mm/yyyy	**
----	------------	----

Checked



**

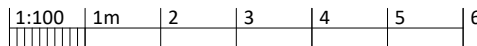

Dwg No. 25017-P-006

Drawing Title Existing Elevations 2/2
Address 44-46 Old Steine, Brighton BN1 1NH
Client Stephen Antram
Scale 1:100 @ A3
Stage Survey
Drawn by MMS
Checked by RZ

archangels
ARCHITECTS

create your dream home
archangels ARCHITECTS Ltd
Suite 7 & 8, 5th Floor, Vantage Point, New
England Road, Brighton, BN1 4GW
e: info@aaarchitects.co.uk, t: 01273 267184
www.aaarchitects.co.uk