525560E 525570E 525580E 525590E 525600E

184750N

184740N

184730N

184720N

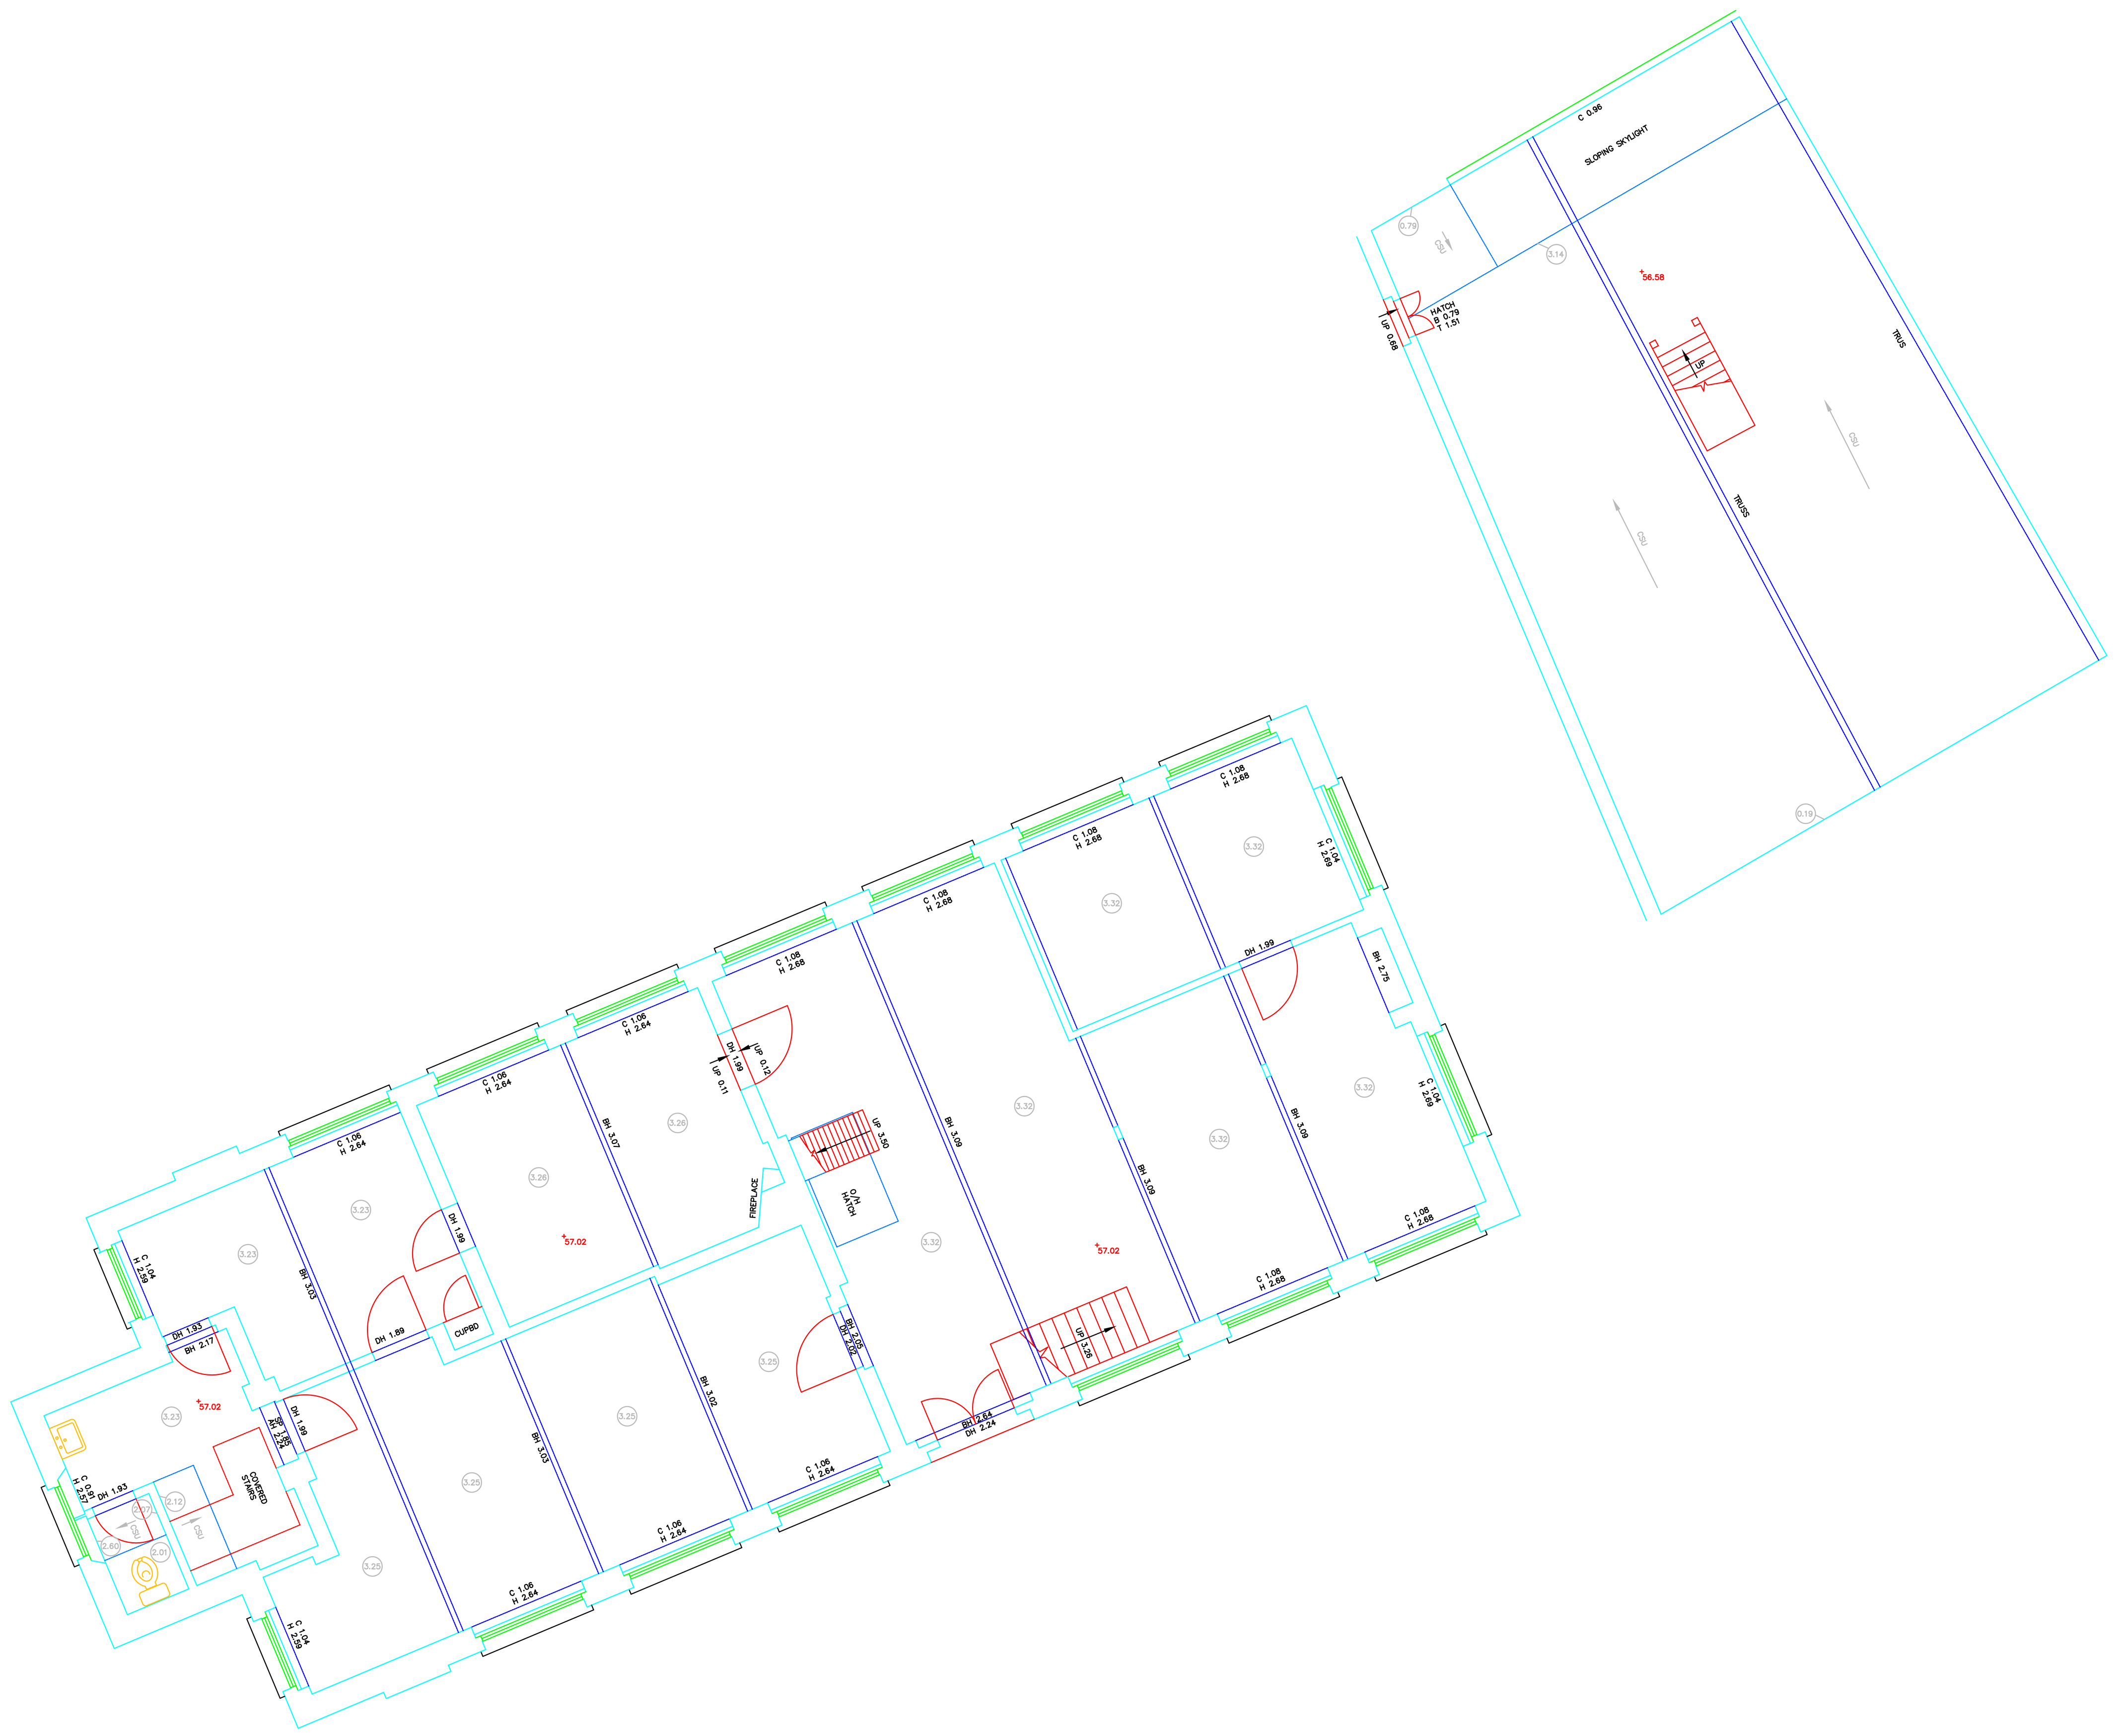



SURVEYED BY:

*ENGINEERING LAND & BUILDING SURVEYS*
*98 MIDDLE STREET*
*BROCKHAM*
*SURREY*
*RH3 7JF*

TEL: 01737 844981
FAX: 01737 841540


*Job No* *B7979*

## LEGEND

| | |
|---|---|
| (symbol) | SURVEY STATION |
| (symbol) | BANKING |
| (symbol) | HEDGE |
| (symbol) | FENCE |
| (symbol) | PROPOSED CELL BOUNDARY |

## ABBREVIATIONS (WHERE APPLICABLE)

| | | | |
|---|---|---|---|
| A/C | AIR CONDITIONER | | |
| AH | ARCH HEIGHT | KO | KERB OUTLET |
| AV | AIR VALVE | L | LIGHT |
| B | BOLLARD | LP | LAMP POST |
| BG | BOX GULLY | MH | MANHOLE |
| BH | BEAM SOFFIT HEIGHT | MKR | MARKER |
| BL | BEAM SOFFIT LEVEL | NB | NOTICE BOARD |
| BW | BRICK WALL | NFI | NO FURTHER INFORMATION |
| C | WINDOW CILL HEIGHT | | |
| CE | CLEANING EYE | O/H | OVERHEAD |
| | | P | POST |
| (1.90)F | CEILING HEIGHT (FALSE) | PL | PAVEMENT LIGHT |
| | | PM | PARKING METER |
| CL | COVER LEVEL | R | ROOF |
| CM | CABLE MARKER | (R) | FROM RECORDS |
| CONC | CONCRETE | RG | ROAD GULLY |
| CP | CATCH PIT | RS | ROAD SIGN |
| CPS | CONC PAVING SLABS | RSJ | ROLLED STEEL JOIST |
| D | DEPTH | RW | RETAINING WALL |
| DH | DOOR HEIGHT | RWP | RAIN WATER PIPE |
| DP | DOWN PIPE | S | SPREAD |
| E | EARTHING POINT | SC | STOP COCK |
| ECP | ELEC CABLE PIT | SKL | SKYLIGHT |
| EJB | ELEC JUNCTION BOX | SL | SUMP LEVEL |
| EP | ELECTRICITY POLE | SP | SPRING POINT HEIGHT |
| F | FLOOR | SV | SLUICE VALVE |
| FB | FLOWER BED | TIC | TELEPHONE IC |
| FH | FIRE HYDRANT | TJB | TEL. JUNCTION BOX |
| FIG | FEEDS INTO GROUND | TL | THRESHOLD LEVEL |
| FL | FLOOR LEVEL | TP | TELEPHONE POLE |
| G | GULLY OR GIRTH | TRL | TRAFFIC LIGHT |
| GV | GAS VALVE | UTL | UNABLE TO LIFT |
| H | WINDOW HEAD HEIGHT OR HEIGHT | UTT | UNABLE TO TRACE |
| | | VP | VENT PIPE |
| HB | HAND BASIN | W | WALL |
| HD | HEATING DUCT | WC | WATER CLOSET |
| IC | INSPECTION COVER | WM | WATER METER |
| IL | INVERT LEVEL | | |

## FENCE TYPES AND DETAILS

| | |
|---|---|
| B/W | BARBED WIRE |
| C/B | CLOSE BOARDED |
| C/I | CORRUGATED IRON |
| C/L | CHAIN LINK |
| C/P | CHESTNUT PALING |
| H/R | HAND RAIL |
| I/R | IRON RAILINGS |
| O/B | OPEN BOARDED |
| P/R | POST & RAIL |
| P/W | POST & WIRE |
| S/W | SHEEP WIRE |
| W/M | WIRE MESH |

## NOTES

DATUM USED: NEWLYN


THIS SURVEY DATA HAS BEEN PREPARED FOR THE CLIENT DETAILED BELOW TO AN AGREED SPECIFICATION. UNLESS OTHERWISE AGREED IN WRITING THE LIABILITY OF ENGINEERING LAND & BUILDING SURVEYS IS LIMITED TO THE CLIENT OR HIS APPOINTED AGENT AND DOES NOT EXTEND TO USE BEYOND THE LIMITATIONS OF THE SPECIFICATION.


| REV SUFFIX | DATE | INITIAL | REVISION DETAILS |
|---|---|---|---|

HORDEN CHERRY LEE ARCHITECTS
36–38 BERKELEY SQUARE
LONDON
W1J 5AE

JOB TITLE
11 BLACKBURN ROAD
WEST HAMPSTEAD
LONDON NW6 1RZ

DRAWING TITLE
# FIRST FLOOR

| JOB No. | | DRAWING No. | |
|---|---|---|---|
| SHEET SIZE A0 | | REVISION SUFFIX 0 | |
| SCALE 1: 50 | DATE OCT 2014 | DRAWN MDH | CHECKED PRC |