


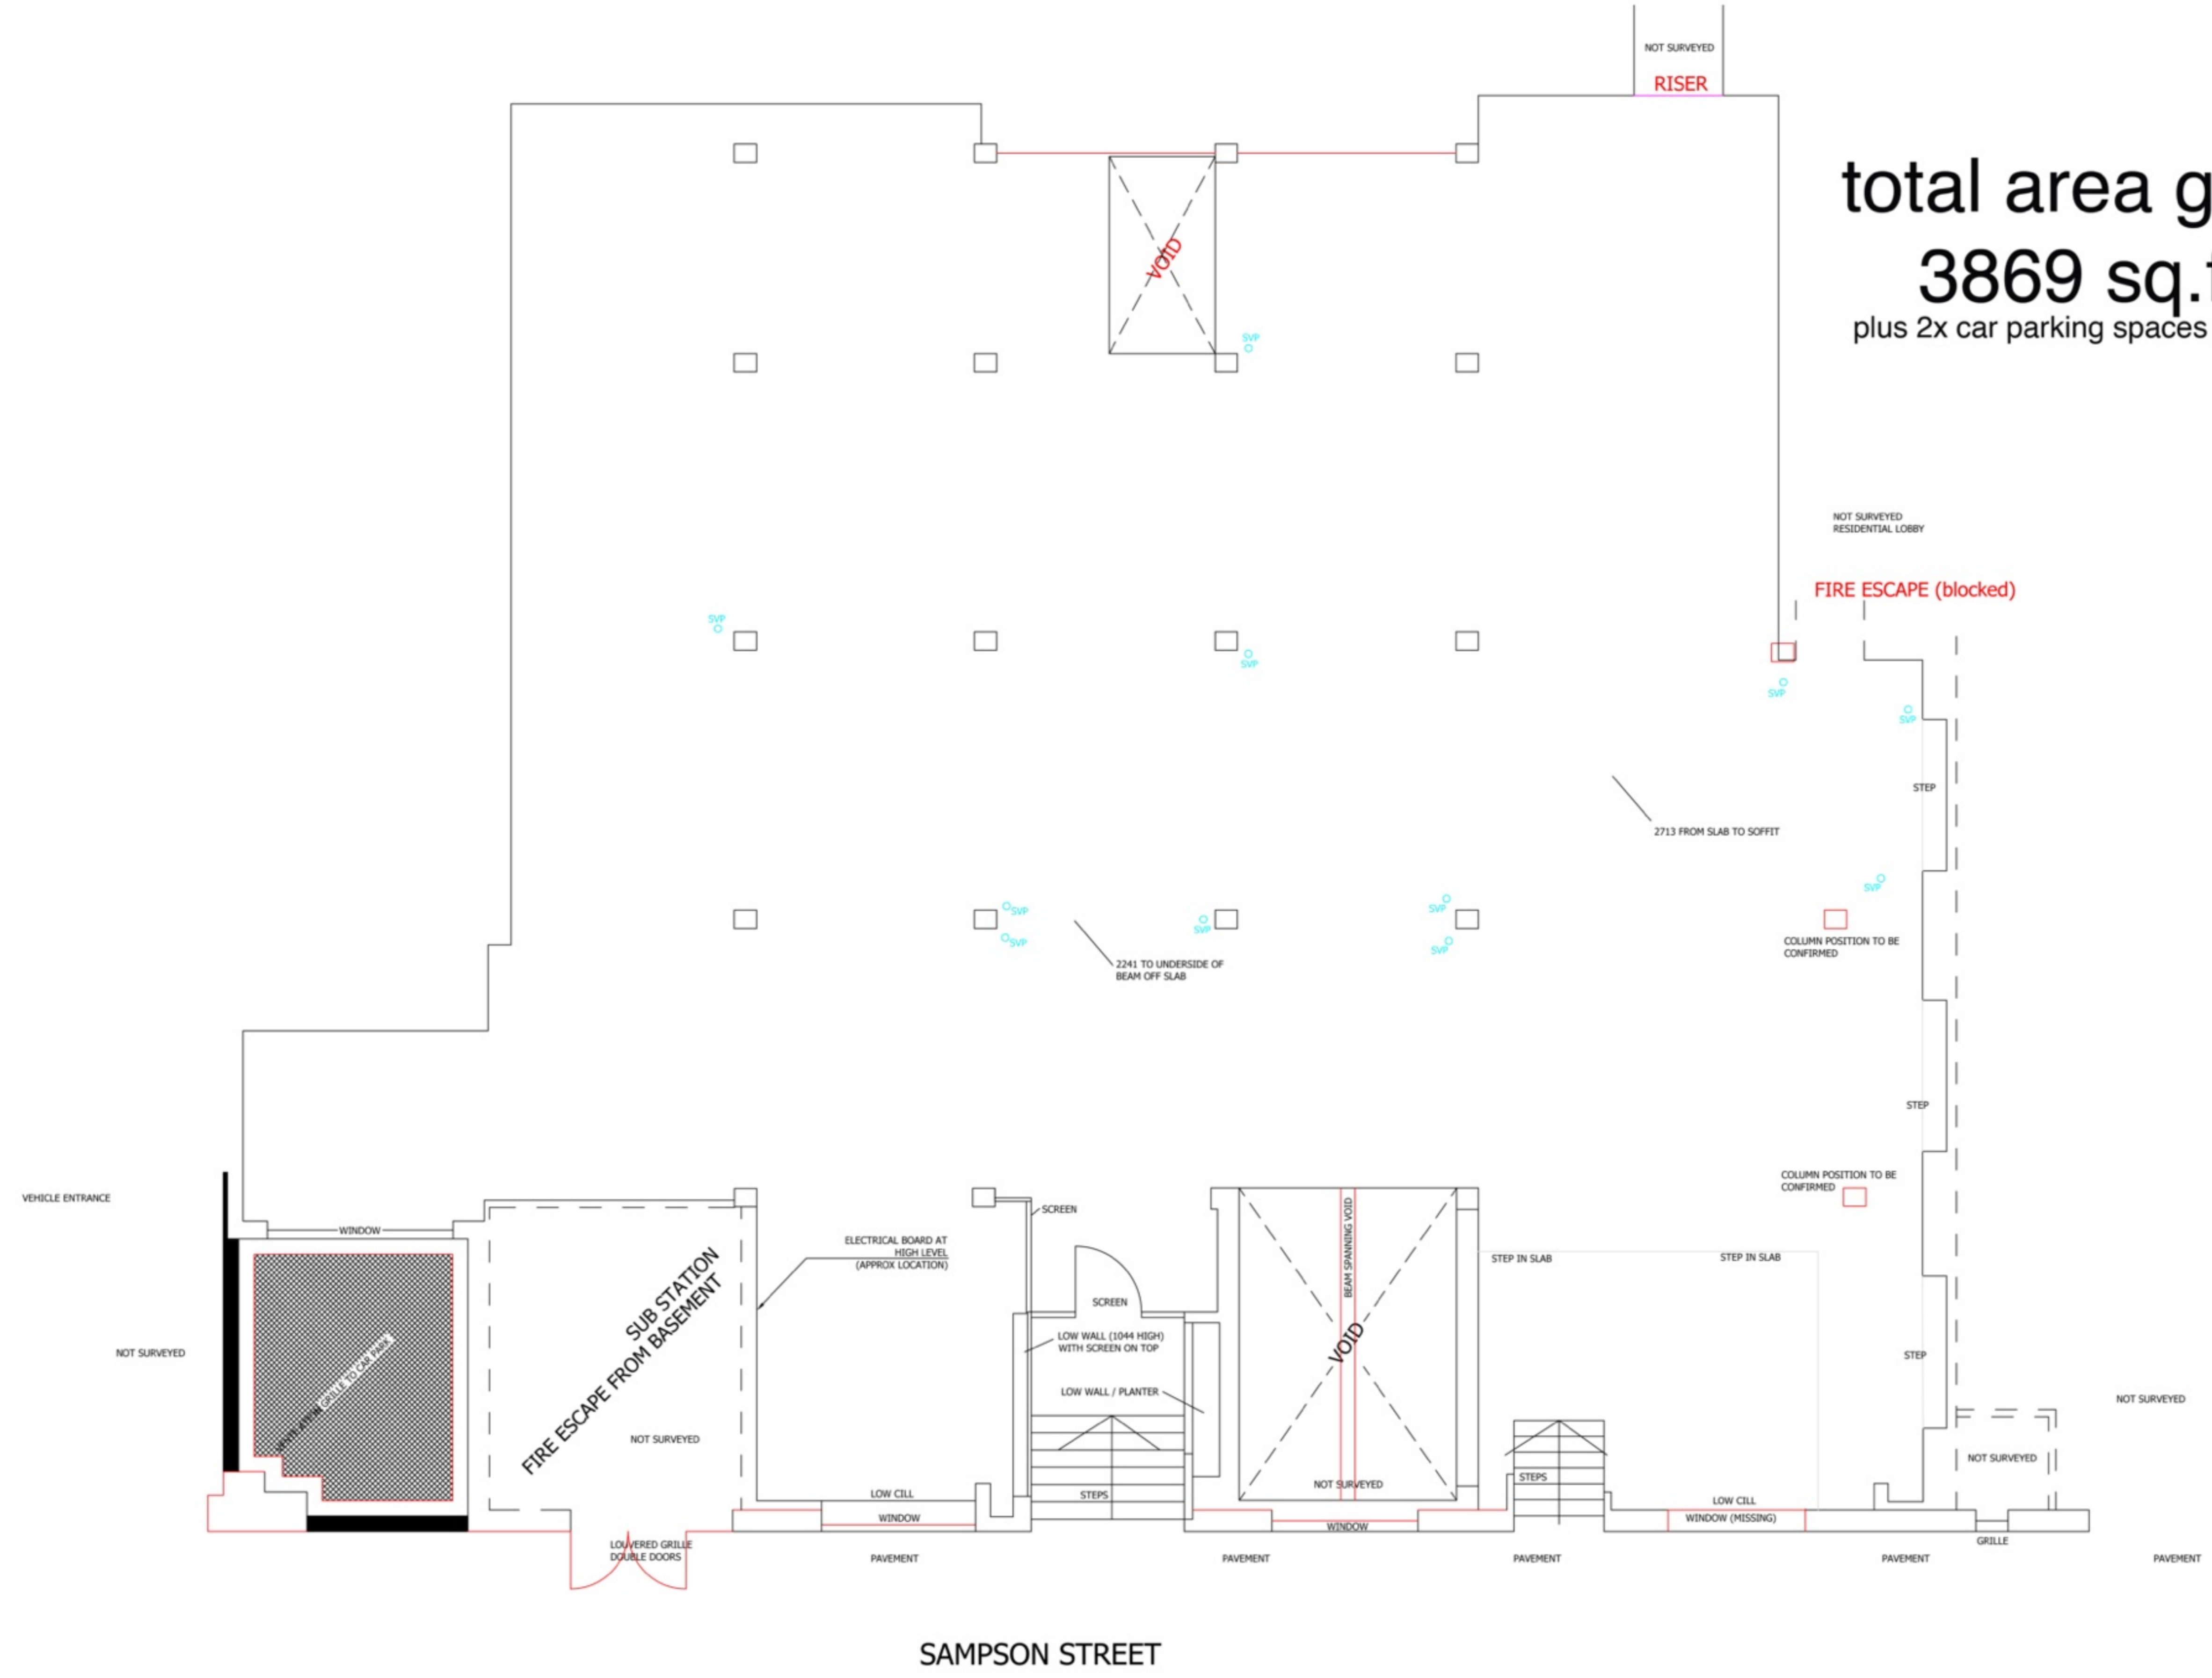

REV.	DATE	REVISION
A	15.03.16	First Issue
B	18.03.16	additional survey dims taken

total area ground floor
3869 sq.ft approx
plus 2x car parking spaces in exterior private car park



Osel
architects and
development consultants

PROJECT:
2 & 4 Sampson Street
Wapping
London E1w 1NA

CLIENT:
Cherry Duck
UK Image LTD

DRAWING:
Existing Ground Floor Plan

DRAWING No.:
E16-008. E03

REV.:
B

SCALE: 1:50

DRAWN: PM **DATE:** 14.03.16

CHECKED: MW **DATE:** 14.03.16