


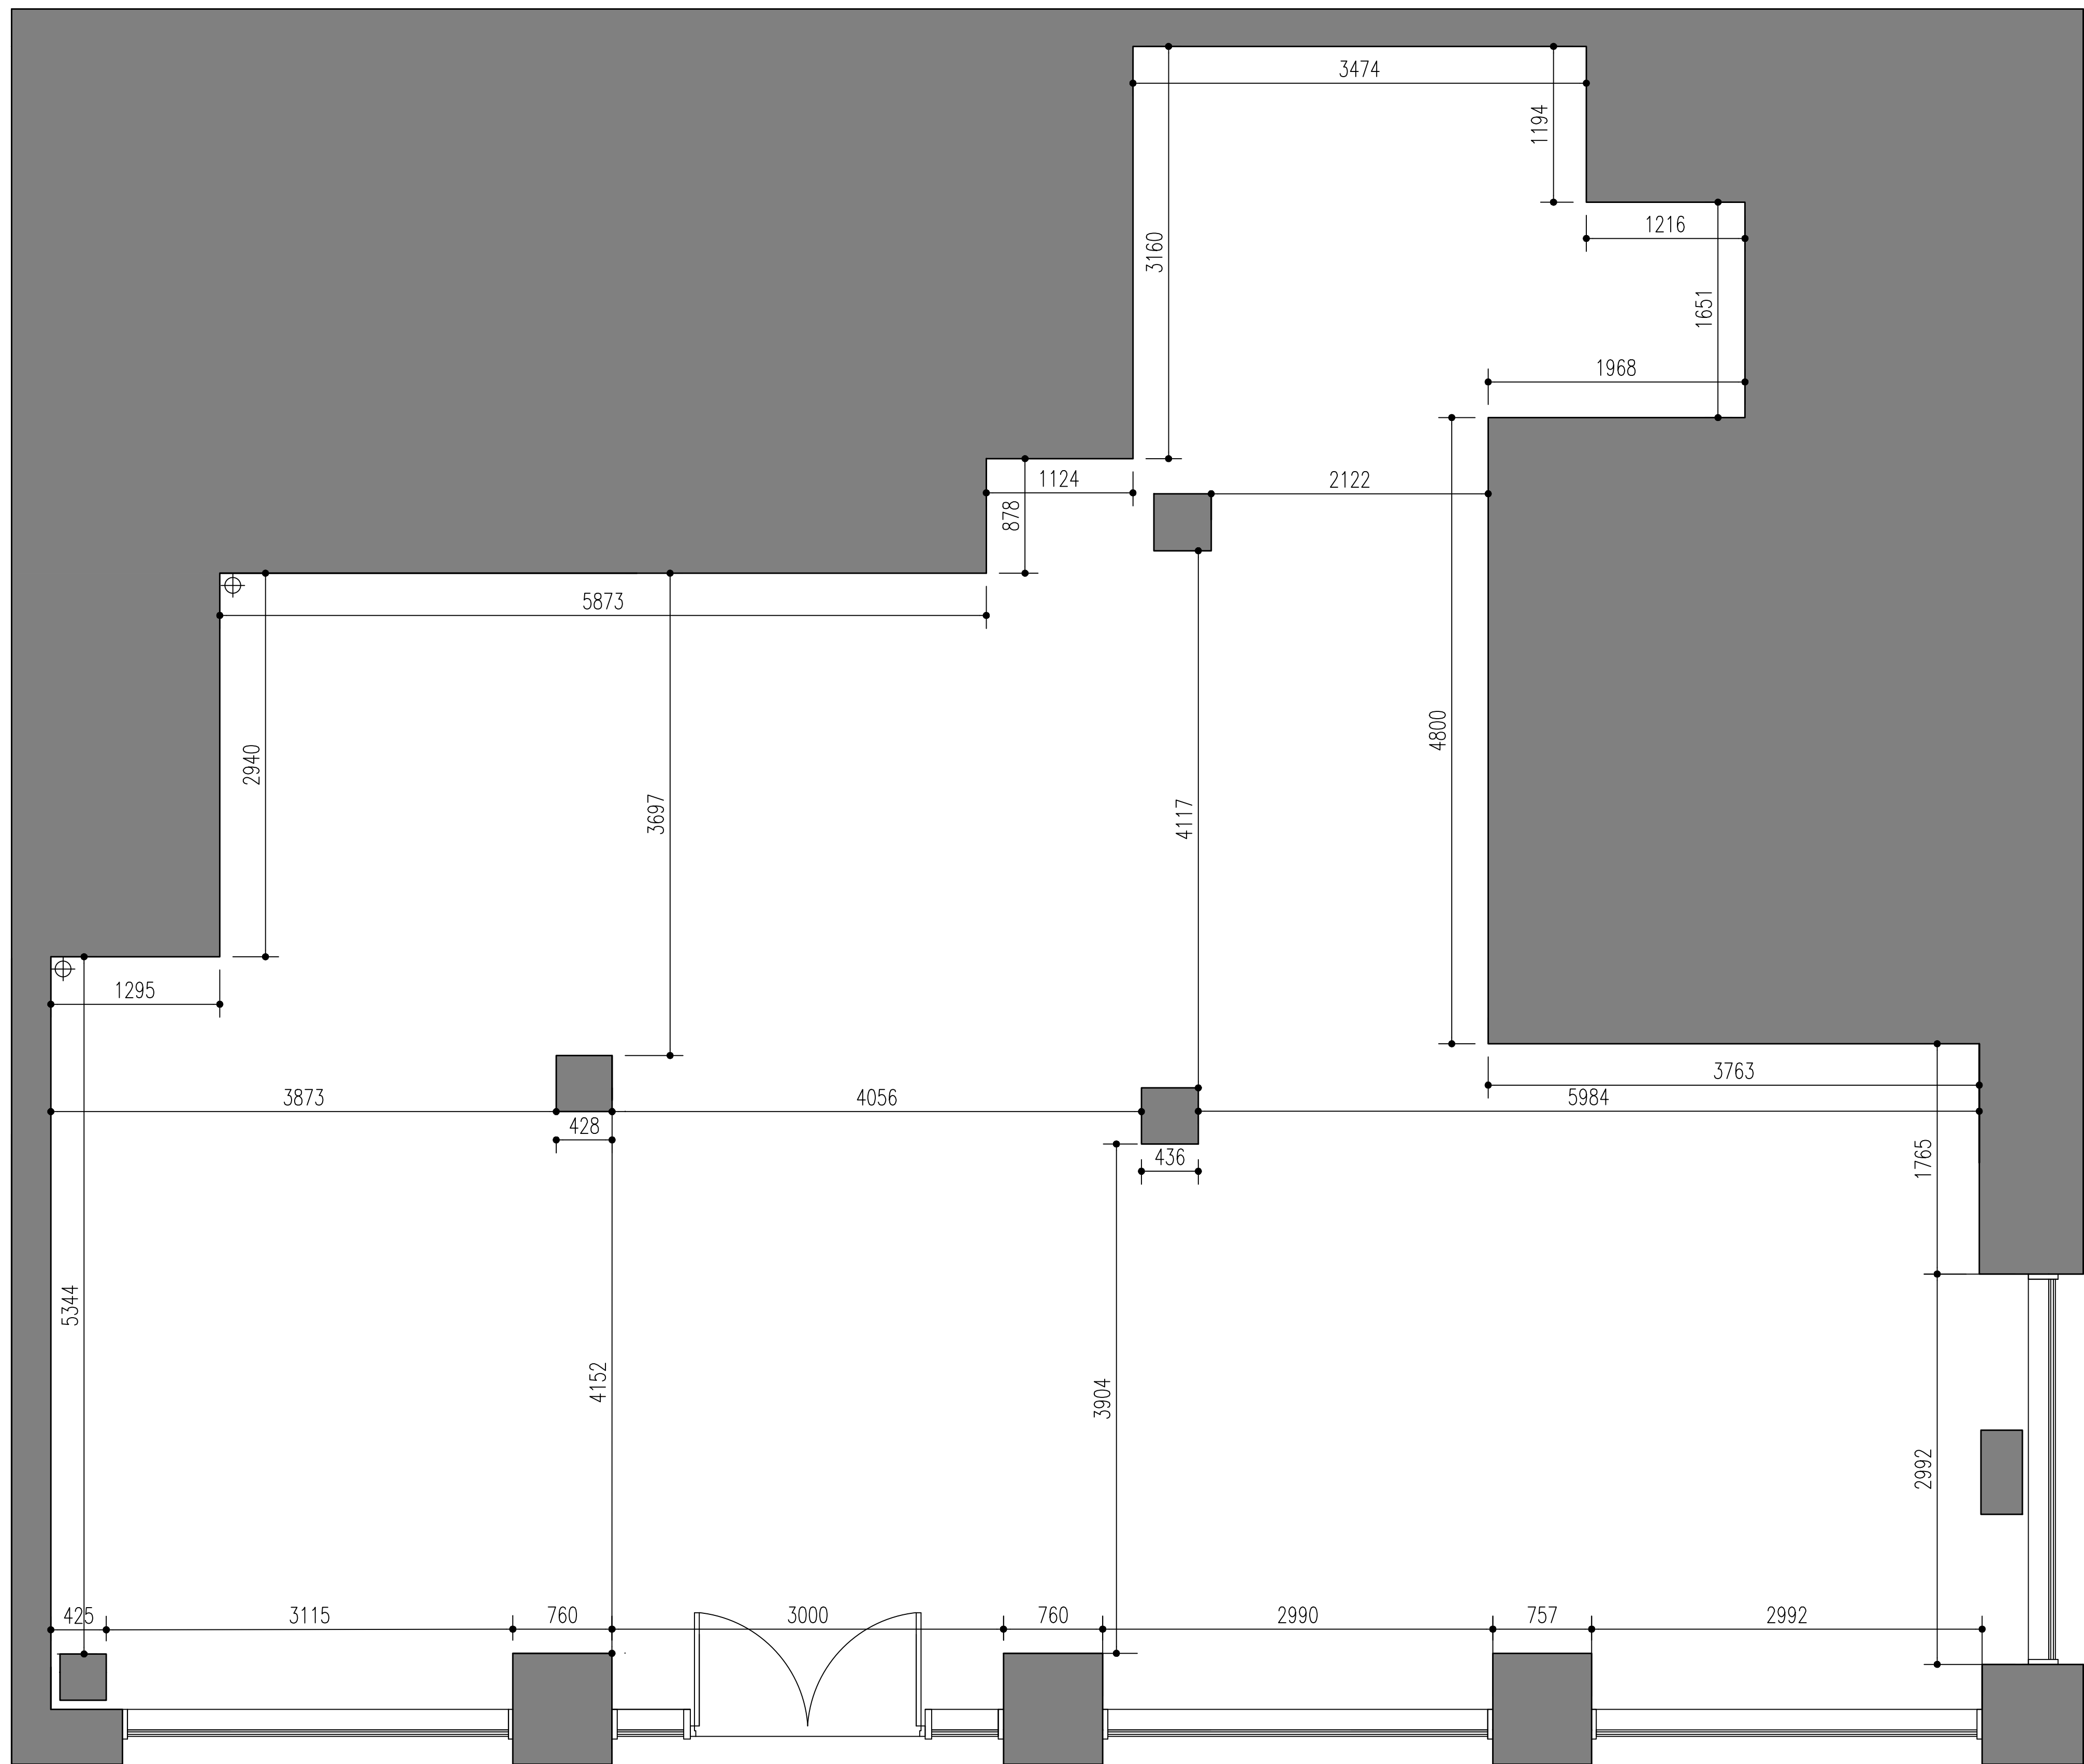

Job:
75 Great Peter street

Title:
Existing plan

Drawn: GS Scale: 1:30 @ A3

Date: JAN 2022 Checked:



Drg. No. GS 219