


CADSPACE Solutions
 This drawing is the property of CADSPACE Solutions. It must not be copied without prior written consent. It is to be regarded as confidential and must not be disclosed to a third party.

DO NOT SCALE FROM THIS DRAWING
 ALL DIMENSIONS TO BE CHECKED ON SITE
 SITE SURVEY REQUIRED
 DRAWING SUBJECT TO HEALTH & SAFETY, FIRE OFFICER & LOCAL AUTHORITY APPROVAL

LEGEND

- ⊙ FIRE SOUNDER
- ⊙ SMOKE DETECTOR
- FALSE WALL
- DATA (CAT5)
- ⊗ CAMERA

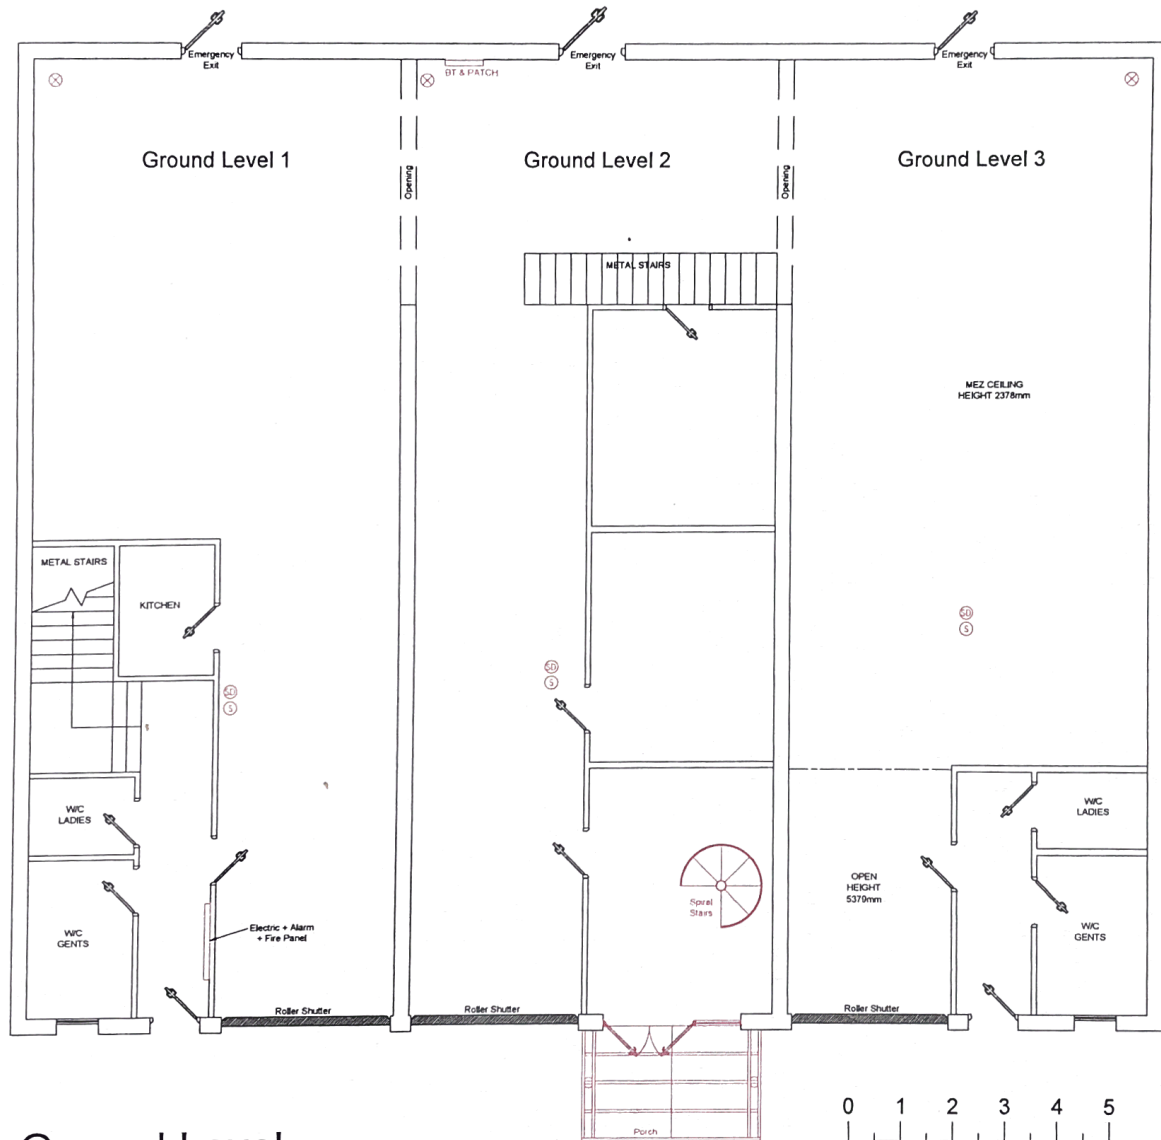

Ground Level

Handwritten signature/initials

PROPOSED

A	PROPOSED PARTITIONING & STAIRS	REV	22.01.18
REV	DESCRIPTION	SKN	DATE



Ground Level
 General Arrangement

Existing Proposed


1:50 @ A1 20.01.18 RCP

CADSPACE A

© 2018 CADSPACE Solutions



Upper Level

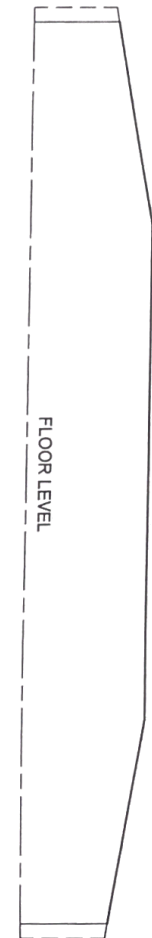

Roof Profile

CADSPACE Solutions
 This drawing is the property of CADSPACE Solutions. It must not be copied without prior written consent and must be returned on request. The information shown is to be regarded as confidential and must not be disclosed to a third party.
 DO NOT SCALE FROM THIS DRAWING
 ALL DIMENSIONS TO BE CHECKED ON SITE
 SITE SURVEY REQUIRED
 DRAWING SUBJECT TO HEALTH & SAFETY, FIRE OFFICER & LOCAL AUTHORITY APPROVAL

- LEGEND**
- ① FIRE SOUNDER
 - ⊕ SMOKE DETECTOR
 - FALSE WALL
 - DATA (CAT5)
 - ⊗ CAMERA

PROPOSED

B	MINOR ALTERATIONS / BREAKOUT AREA	RCM	22.01.18
A	PROPOSED PARTITIONING & STAIRS	RCM	22.01.18
REV	DESCRIPTION	IGN	DATE



Project Name: Upper Level
 General Arrangement

Scale: Existing Proposed

Scale: 1:50 @ A1
 Date: 20.01.18
 Project: RCM

CFMANGLES