

A No Comment
05-Mar-18
make

THIS DRAWING IS COPYRIGHT OF AND SHALL REMAIN THE PROPERTY OF:
ARNEY FENDER KATSALIDIS
NOTES
CHECK AND VERIFY ALL DIMENSIONS PRIOR TO COMMENCEMENT OF WORK. THIS DRAWING SHALL BE READ IN CONJUNCTION WITH ALL OTHER CONTRACT DOCUMENTS INCLUDING THOSE BY OTHER CONSULTANTS, AND INCLUDING SPECIFICATIONS. SEEK CLARIFICATION OF INCONSISTENCIES/CONFLICTS. FIGURED DIMENSIONS SHALL TAKE PRECEDENCE TO SCALED DIMENSIONS.

- TO BE READ IN CONJUNCTION WITH FOLLOWING DRAWINGS AND DOCUMENTS:
1. A-11 SERIES FOR 1 : 50 PLANS
 2. A-20 SERIES FOR ELEVATIONS
 3. A-25 SERIES FOR SECTIONS
 4. A-40 SERIES FOR FACADE ELEVATIONS
 5. STRUCTURAL AND MEP ENGINEER'S DRAWINGS
 6. A-CSP SERIES FOR ARCHITECTURAL SPECIFICATIONS
 7. A-02-A0200 DRAWING FOR GRID SETOUT
 8. FF&E ITEMS SHOWN AS GREY DASHED LINES ARE INDICATIVE ONLY AND ARE OUTSIDE THE CONTRACTOR'S SCOPE.


MULTIPLEX

CONSULTANT DOCUMENT REVIEW
Multiplex Received Date:
No Comment
Noted subject to comments, incorporate comments promptly.
Reviewed, correct and resubmit within 5 Business Days
MFK CHECKED BY: Laura Vanni
DATE: 09/03/2018
Multiplex review status does not absolve the Consultant of its obligations with regard to coordination and conformity with the other Consultant's and specialist Subcontractor's design and the Client's Requirements, Employer's Requirements and the Code Plan and for ensuring that there are no ambiguities, discrepancies, contradictions, omissions, design or construction impracticalities or omissions within the document or between it and any other design document.

MPX note drawing reviewed only in relation to clouded changes for EAI-177 new tenant riser

14	08/02/2018	BOG EAI 177 A TROST	SA	HW
13	08/02/2018	BOG EAI 177 A TROST	SA	HW
12	08/02/2018	ARUP TROST	SA	HW
11	08/02/2018	ARUP TROST, TROST	SA	HW
10	03/01/2018	ARUP TROST	SA	HW
09	10/01/2018	ARUP TROST	SA	HW
08	01/10/2017	STAGE 5 UPDATE	MF	PV
07	04/09/2017	STAGE 4 UPDATE	MF	PV
06	08/02/2017	STAGE 3 UPDATE	MF	PV
05	20/01/2017	STAGE 2 UPDATE	TJ	PV
REV	DDMMYYYY	DESCRIPTION		

REVISION 14 COMMENTS:
* REVISION ROOM NUMBERS ADDED
THIS DRAWING HAS BEEN ISSUED TO REFLECT TENANT AMENDMENTS TO THE DESIGN BUT DOES NOT ADDRESS CMT COMMENTS WHICH WILL BE UPDATED IN THE NEXT ISSUE

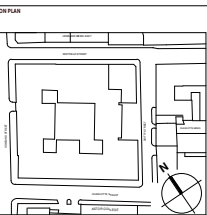

Arney Fender Katsalidis
Arney Fender Katsalidis
T / +44 20 3772 7320
E / info@afkstudios.com
W / afkstudios.com
44-46 Scrutton Street, London, EC2A 4HH.

CLIENT:
DERWENT LONDON

PROJECT:
80 CHARLOTTE STREET

DRAWING TITLE:
GA LEVEL 02


PROJECT NO:
44034

STATUS:
FOR CONSTRUCTION

DRAWING NO:
A-10-A2102

SCALE:
1:100@A0

REVISION:
14

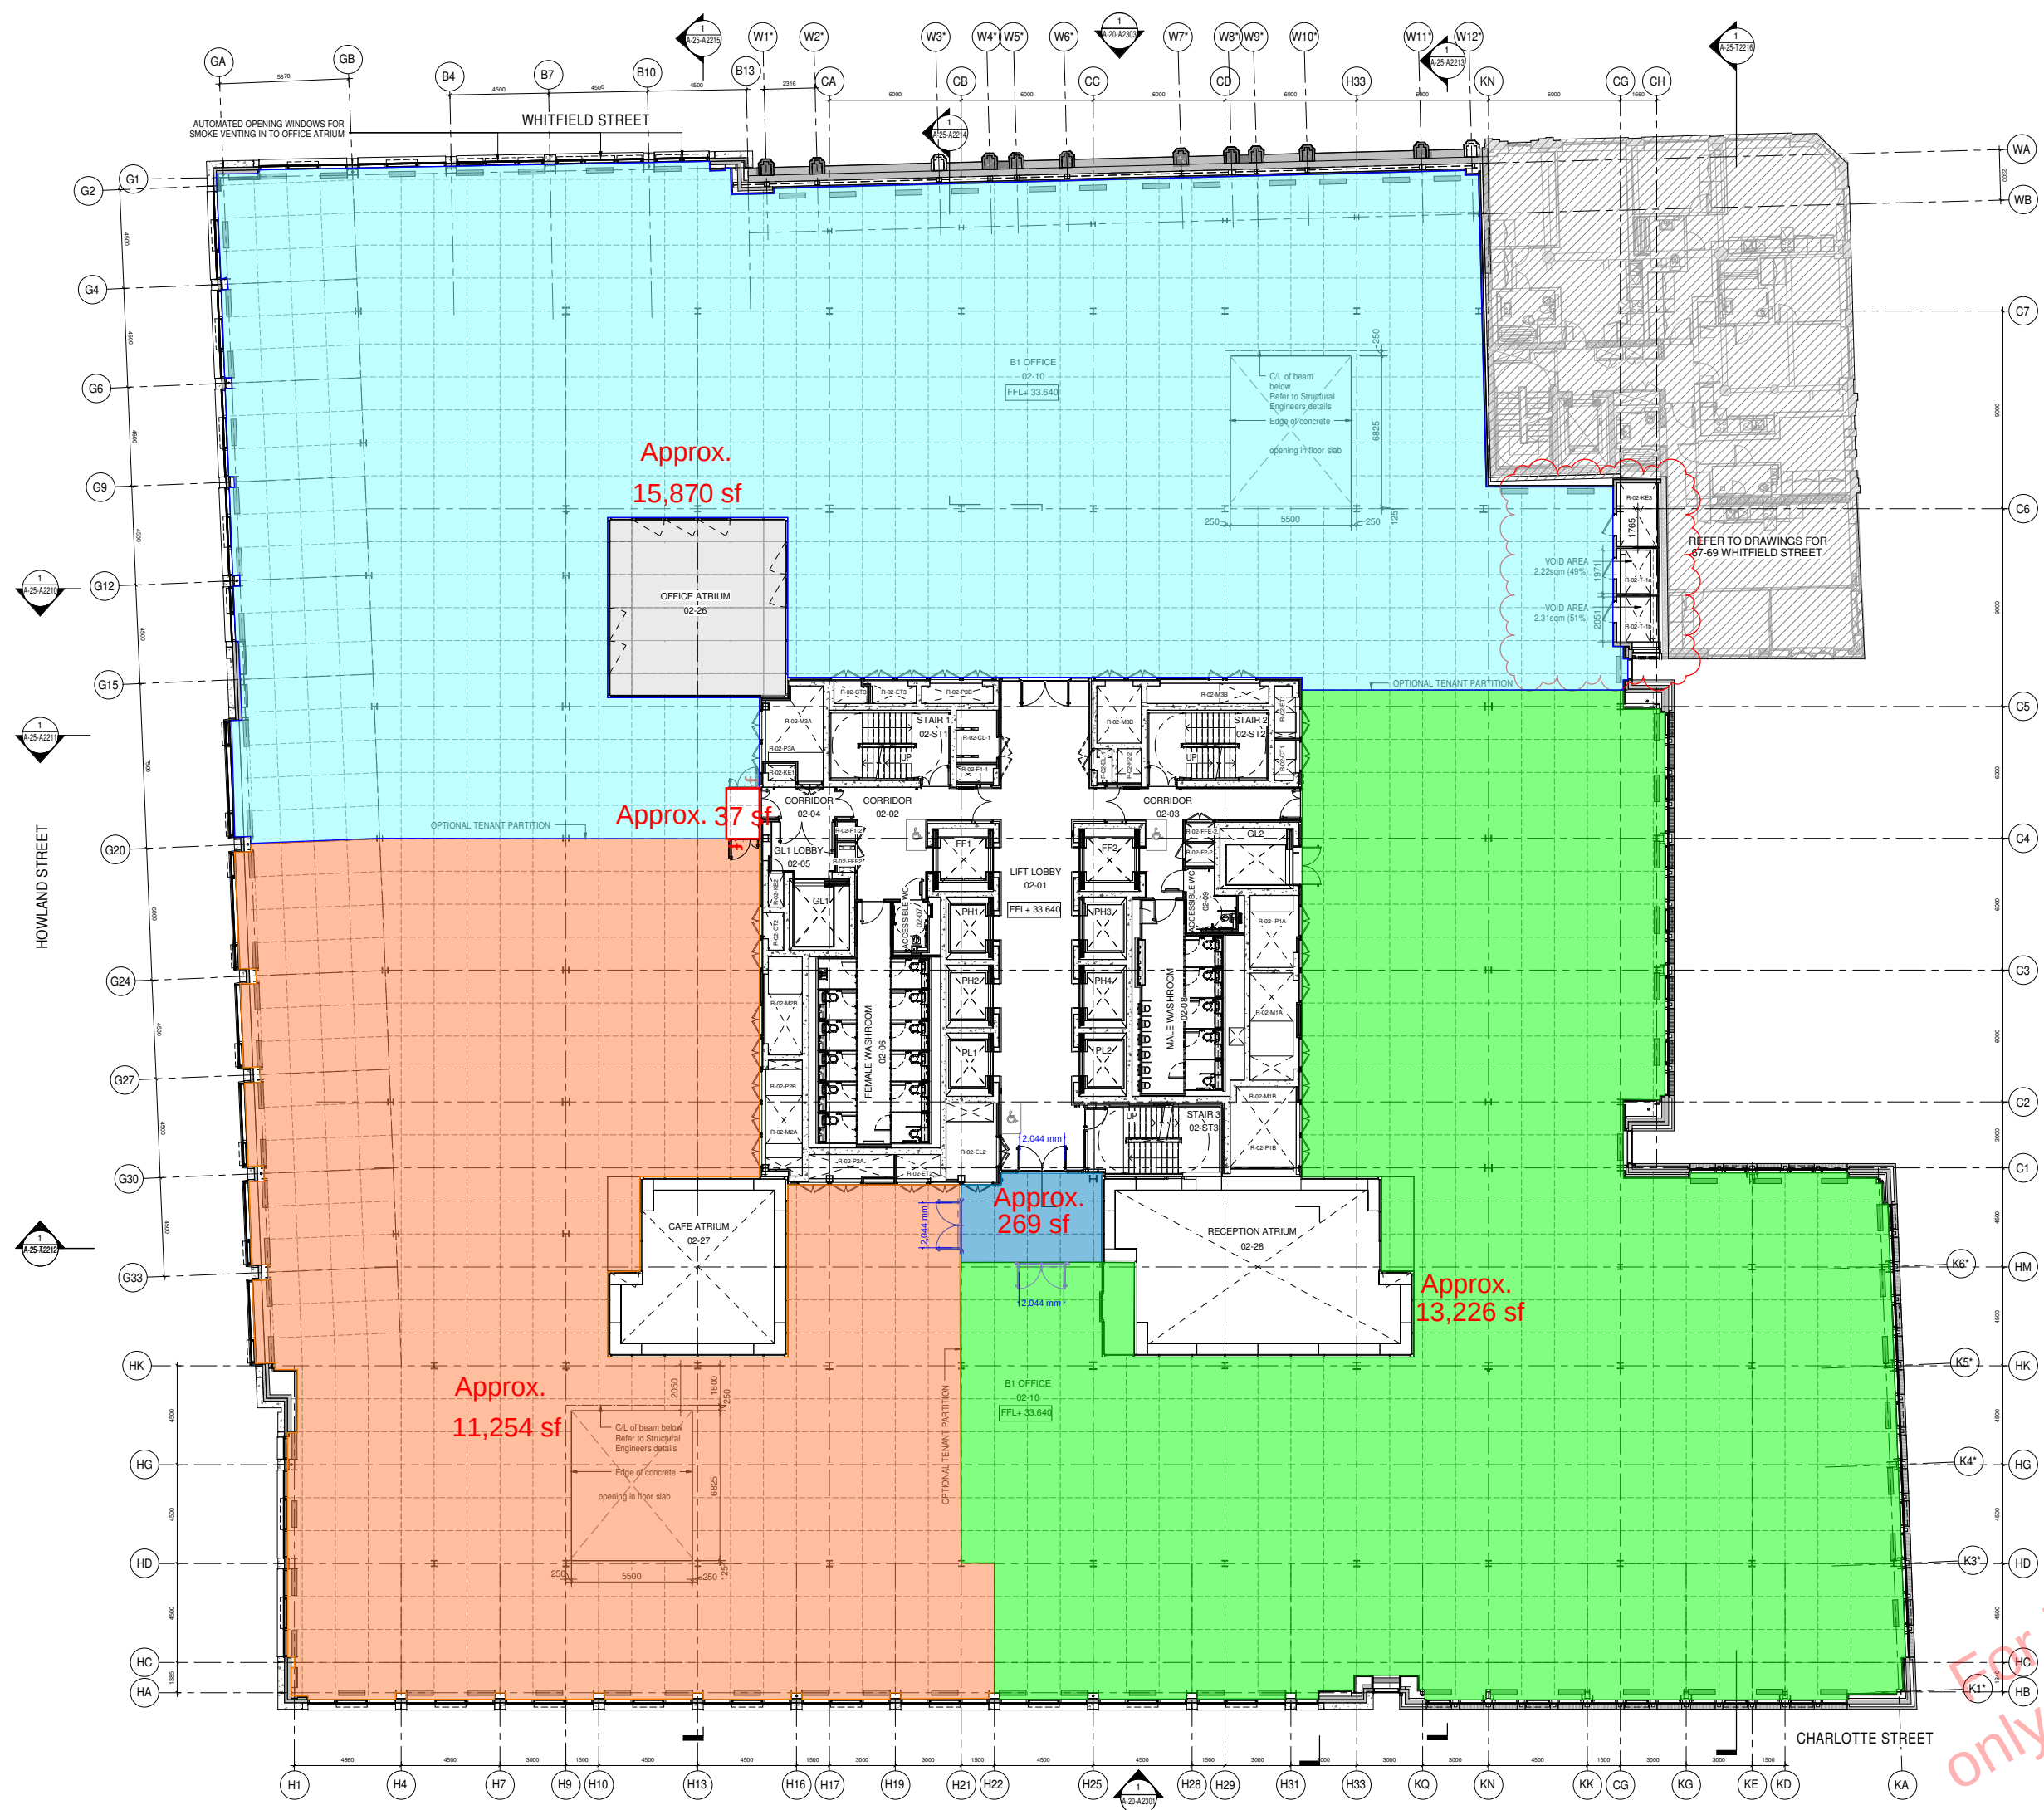

For information only, not for tender