




GENERAL NOTES:
1. THIS DRAWING IS TO BE READ IN CONJUNCTION WITH THE OTHER RELEVANT CONSULTANTS DRAWINGS.
2. ALL FINISHES ARE TO CONFORM TO THE CURRENT BUILDING REGULATIONS.
3. REFER TO A SEPARATE DOCUMENT FOR THE DESIGNERS RISK ASSESSMENT.
4. ALL WORKS OR MATERIALS INDICATED ON THIS DRAWING ARE TO BE TO THE LATEST RELEVANT BRITISH STANDARDS AND CARRIED OUT IN ACCORDANCE WITH THE BRITISH STANDARDS CODES OF PRACTICE OR RECOGNIZED INSTITUTE OR TRADE ASSOCIATION RECOMMENDATIONS AND PUBLICATIONS.

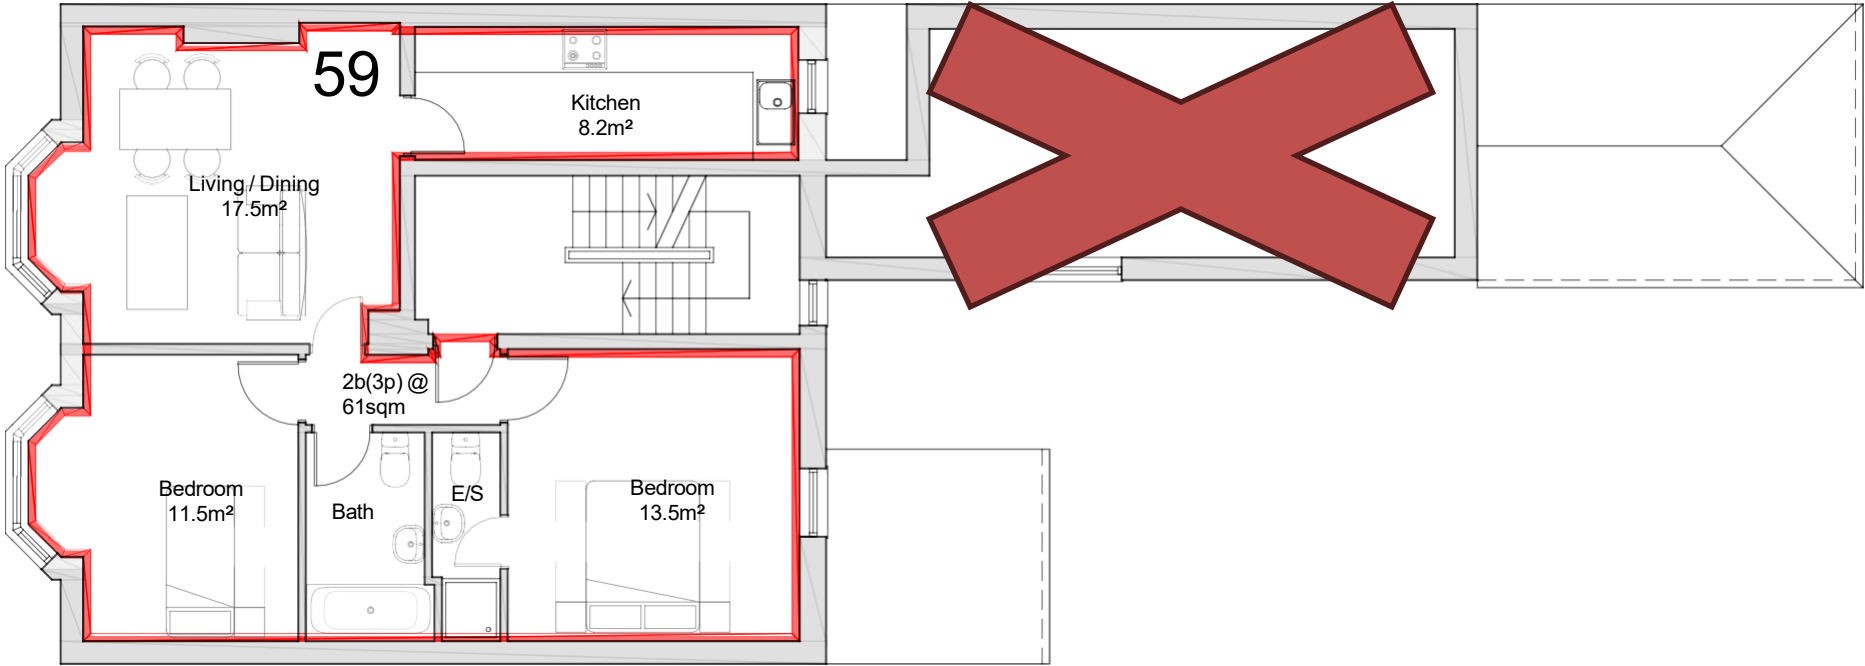

1:100 scale

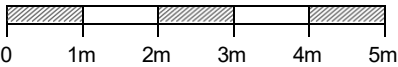

First Floor

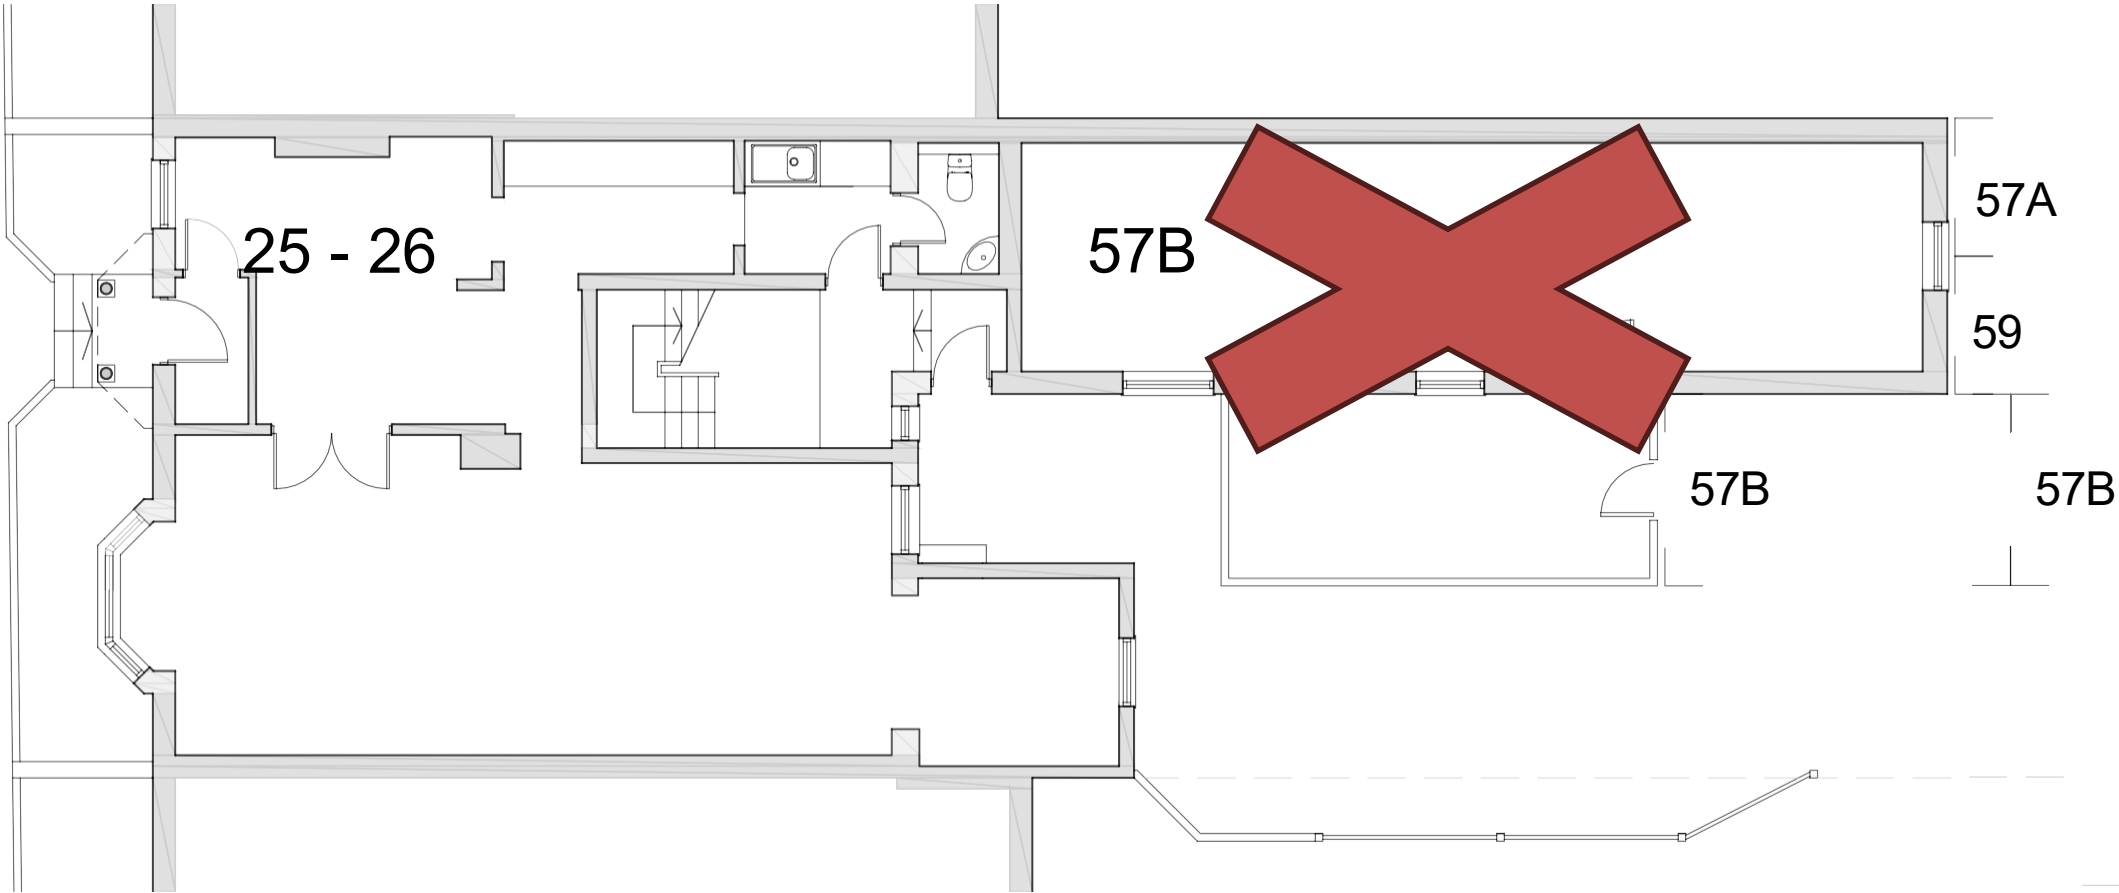

Ground Floor

Revision	Date	Description	Dwn	Chd
----------	------	-------------	-----	-----



Lansdowne House
25-26 Hampshire Terrace
Portsmouth PO1 2QF
Hampshire England

Tel: (023) 92 755 333

E-Mail: admin@plcarchitects.com

Web: www.plcarchitects.com

Client:

Project:

59 Lansdowne Street
Portsmouth

Drawing Title:

Proposed Floor Plan

Drawn By	Date	Checked By	Date	Approved By	Date
JCB	Feb' 25				
Drawing No.	Revision:		Scale:		
22.3301.201	P1		As Stated @ A3		
PLC ARCHITECTS © COPYRIGHT RESERVED 2021					
NOT TO BE SCALED. DIMENSIONS TO BE CHECKED ON SITE					
SCALING ONLY FOR LOCAL AUTHORITY PURPOSES					