Notes

ALL LEVELS ARE IN METRES DERIVED FROM GPS TRANSFORMATION OSGM15

THE CO-ORDINATES ARE DERIVED FROM THE ORDNANCE SURVEY ACTIVE STATION NETWORK OSTN15 (BASE STATION ST02)

1.0 0.0 1.0 2.0 3.0 4.0 5.0 6.0 7.0

Scale = 1 : 50

GROUND FLOOR

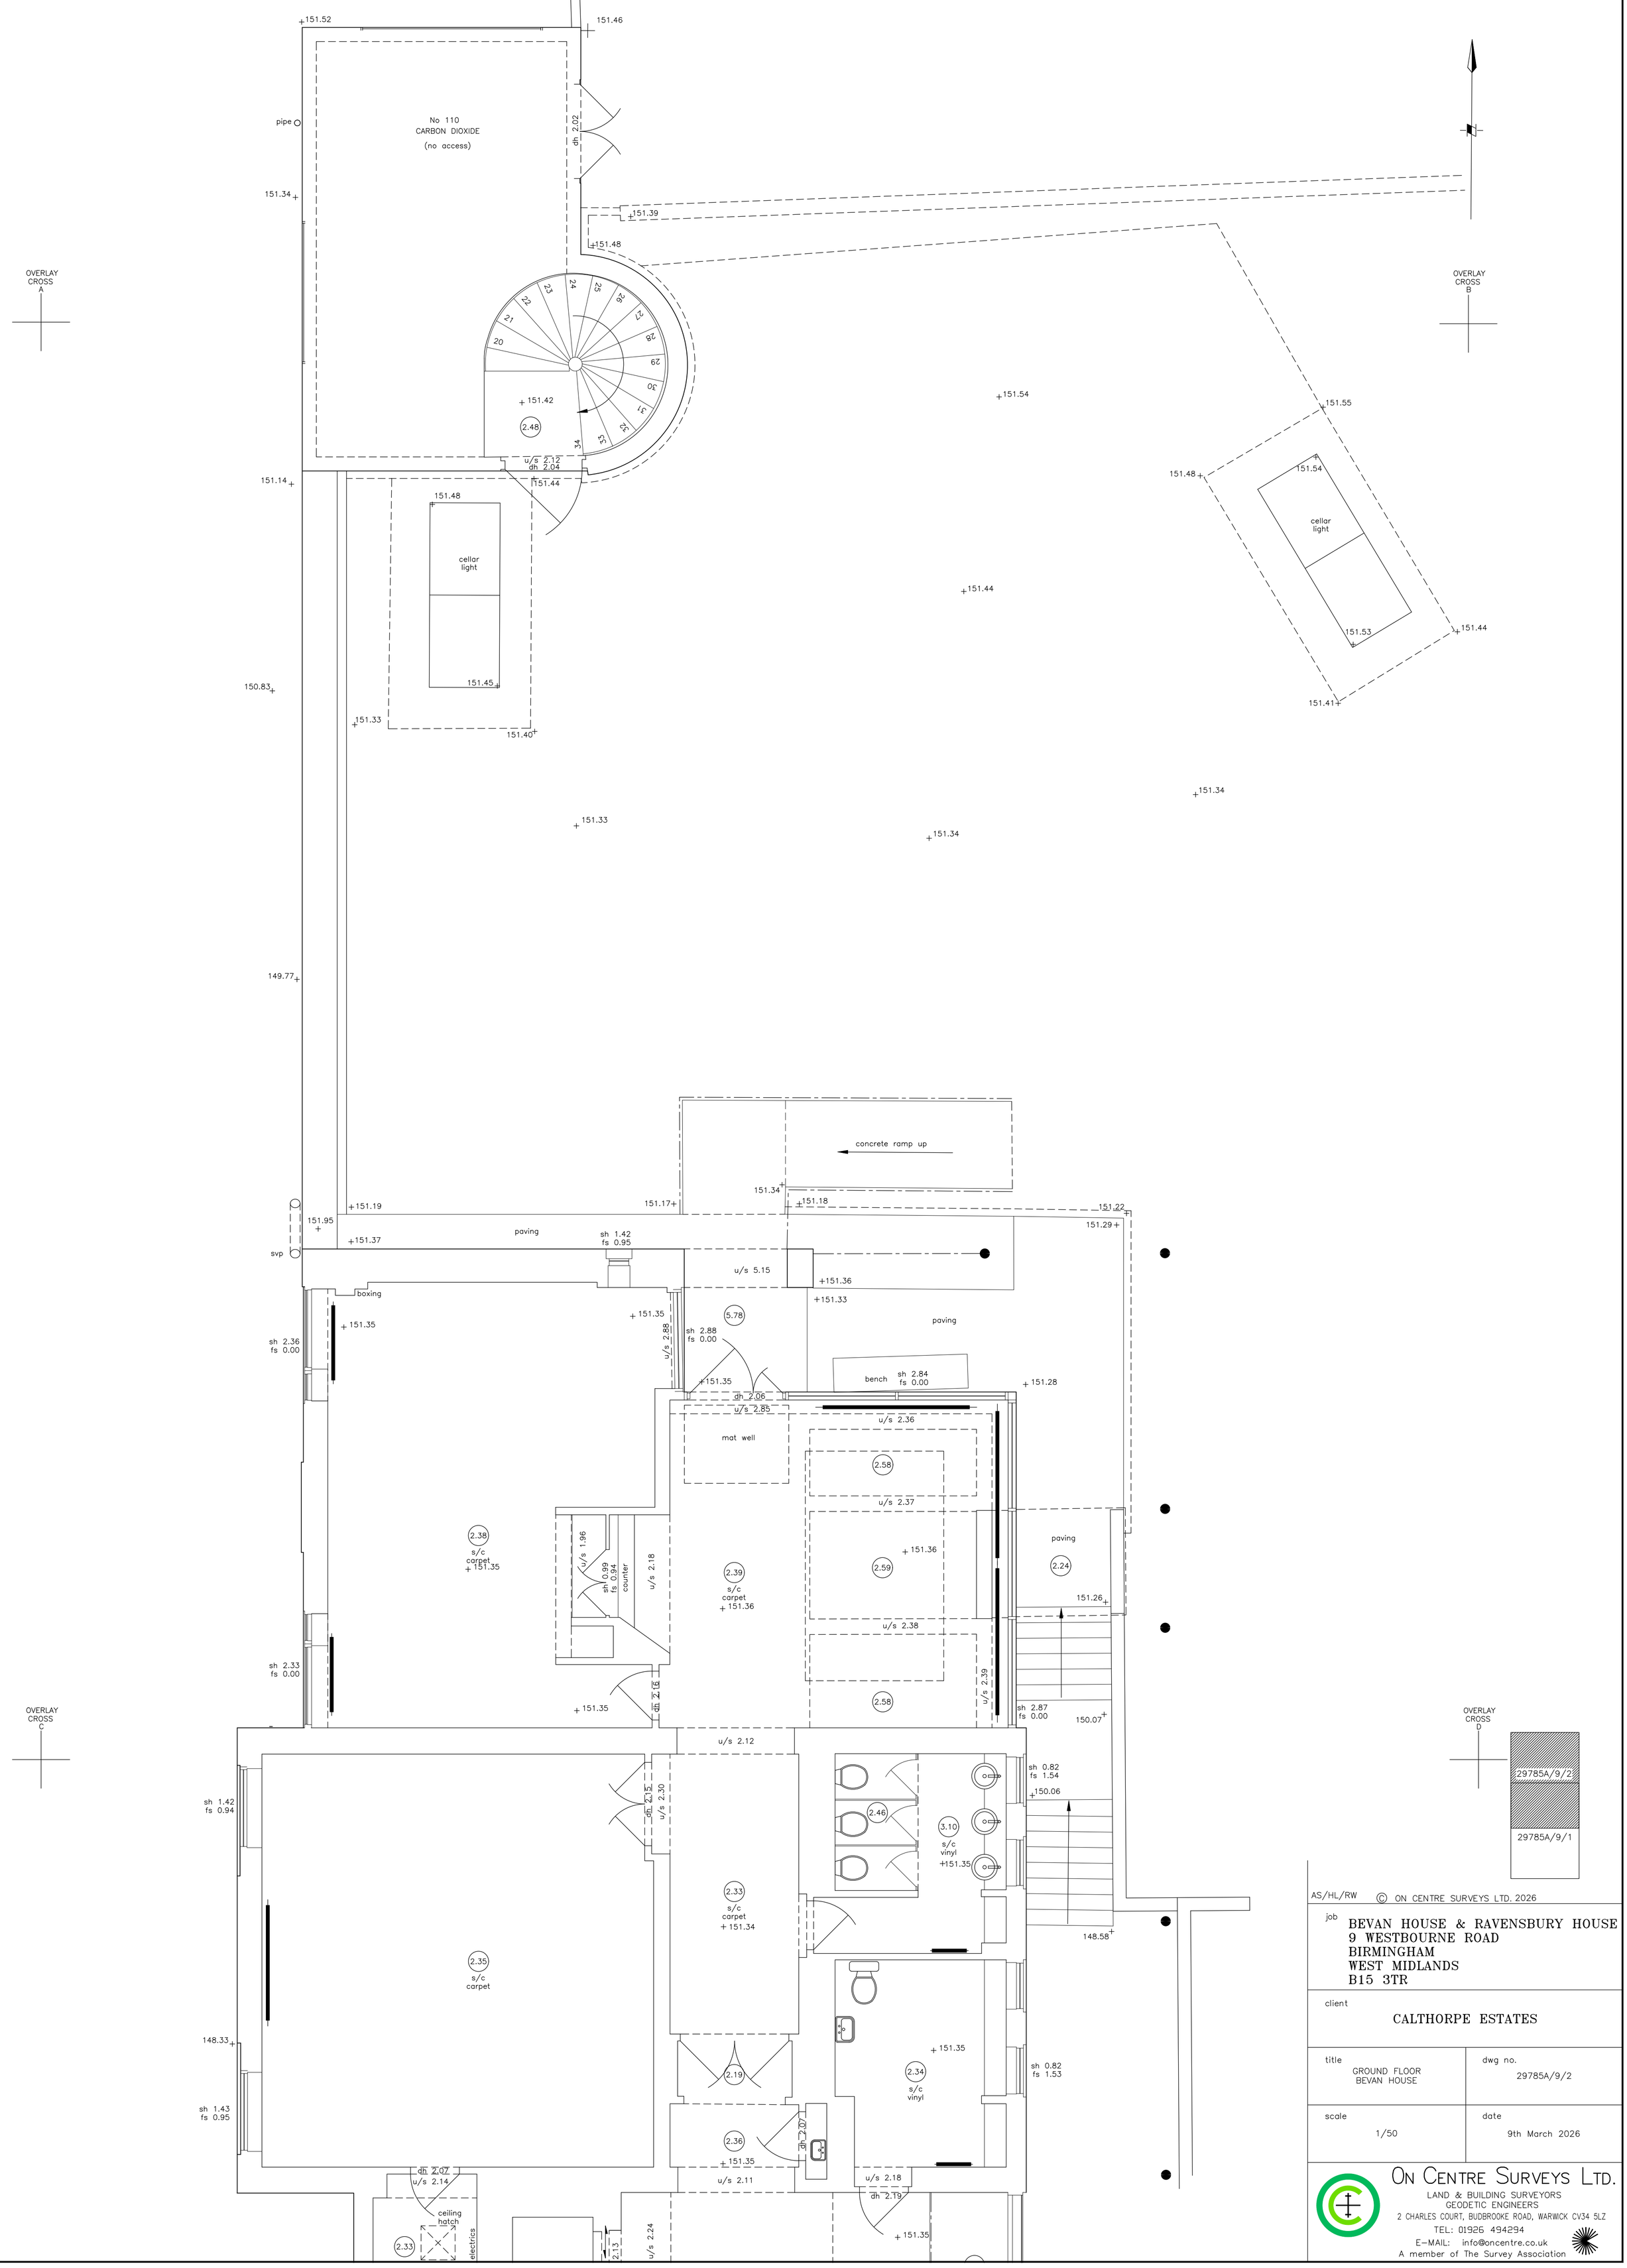

AS/HL/RW

© ON CENTRE SURVEYS LTD. 2026

job
BEVAN HOUSE & RAVENSBURY HOUSE
9 WESTBOURNE ROAD
BIRMINGHAM
WEST MIDLANDS
B15 3TR

client
CALTHORPE ESTATES

title	dwg no.
GROUND FLOOR BEVAN HOUSE	29785A/9/2
scale	date
1/50	9th March 2026

ON CENTRE SURVEYS LTD.
LAND & BUILDING SURVEYORS
GEODETIC ENGINEERS
2 CHARLES COURT, BUDBROOKE ROAD, WARWICK CV34 5LZ
TEL: 01926 494294
E-MAIL: info@oncentre.co.uk
A member of The Survey Association