


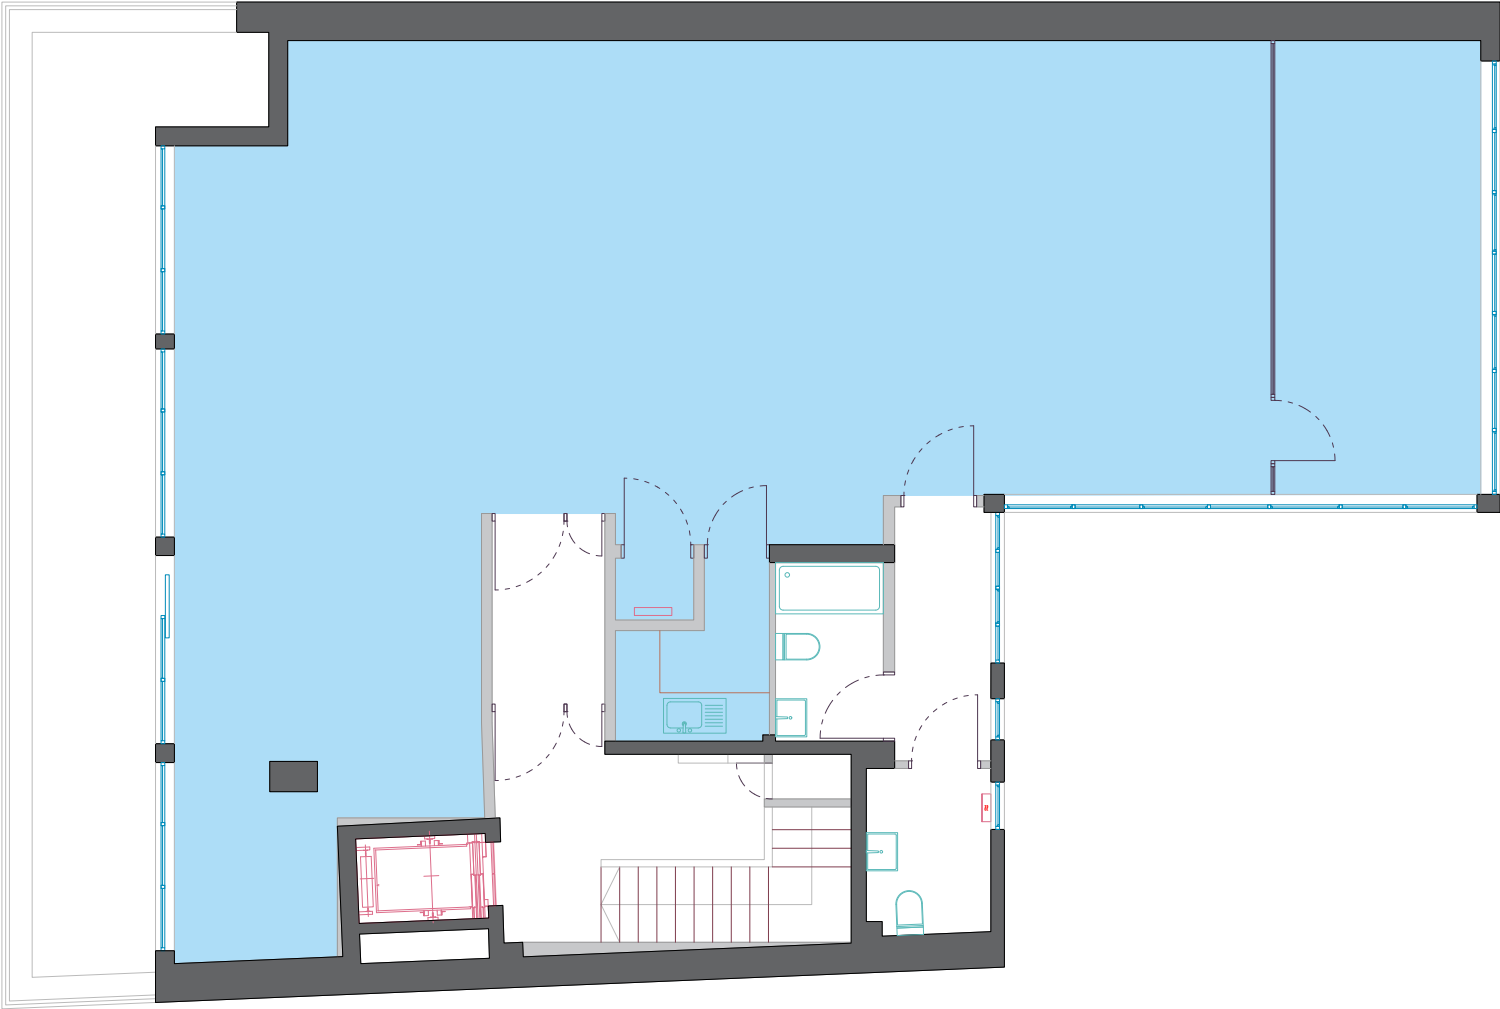

Fourth Level



0m 5m
Scale 1:100

Great Sutton Street

33 Great Sutton Street
London
EC1V 0DS

Drawing Name
Fourth Level Floor Plan

REFERENCES

 Net Internal Area

Date	Revision	Project Number	Description	Rev
20/06/2025	00	25.05.3330	Property Survey	0/0

sterlingtemple

0203 4639225
www.sterlingtemple.com