

SCHEDULE OF NIA	
BUILDING 2	
GROUND FLOOR SUITE A	5,572.69 sq.ft
GROUND FLOOR SUITE B	6,954.99 sq.ft
FIRST FLOOR	12,573.54 sqft
SECOND FLOOR	12,575.48 sqft
THIRD FLOOR	10,897.06 sq.ft
ROOF PLANT	1,184.76 sq.ft

BUILDING 2 - GROUND FLOOR PLAN AS EXISTING 1:100

0 INITIAL ISSUE 26/08/25

DMU DESIGNS
ARCHITECTURAL SERVICES LTD

PLANNING APPLICATIONS
BUILDING REGULATIONS
RESIDENTIAL BUILDING PRODUCTS
WORKING DRAWINGS
FACILITIES / FACTORY OFFICES
SPACE PLANNING

MAX@DMUDESIGNS.CO.UK
WWW.DMUDESIGNS.CO.UK
+44 (0)1977 157261


CLIENT
DAVELA ESTATE LTD

STATUS
MEASURED BUILDING SURVEY

DRAWING NUMBER 3398-001	DRAWING TITLE BUILDING 2 - GROUND FLOOR
DRAWING REVISION 0	DATE AUGUST 2025
SCALE 1:100	PAPER SIZE A1
	DRAWN BY PTM

PROPERTY
**BUILDING 2 & 3, CITY WEST
THE BOULEVARD, HOLBECK
LEEDS, LS12 6NJ**

DO NOT SCALE FROM THIS DRAWING. ANY DISCREPANCIES TO BE REPORTED IMMEDIATELY.
DMU DESIGNS IS A LIMITED COMPANY REGISTERED IN ENGLAND AND WALES. REGISTERED NUMBER: 710997

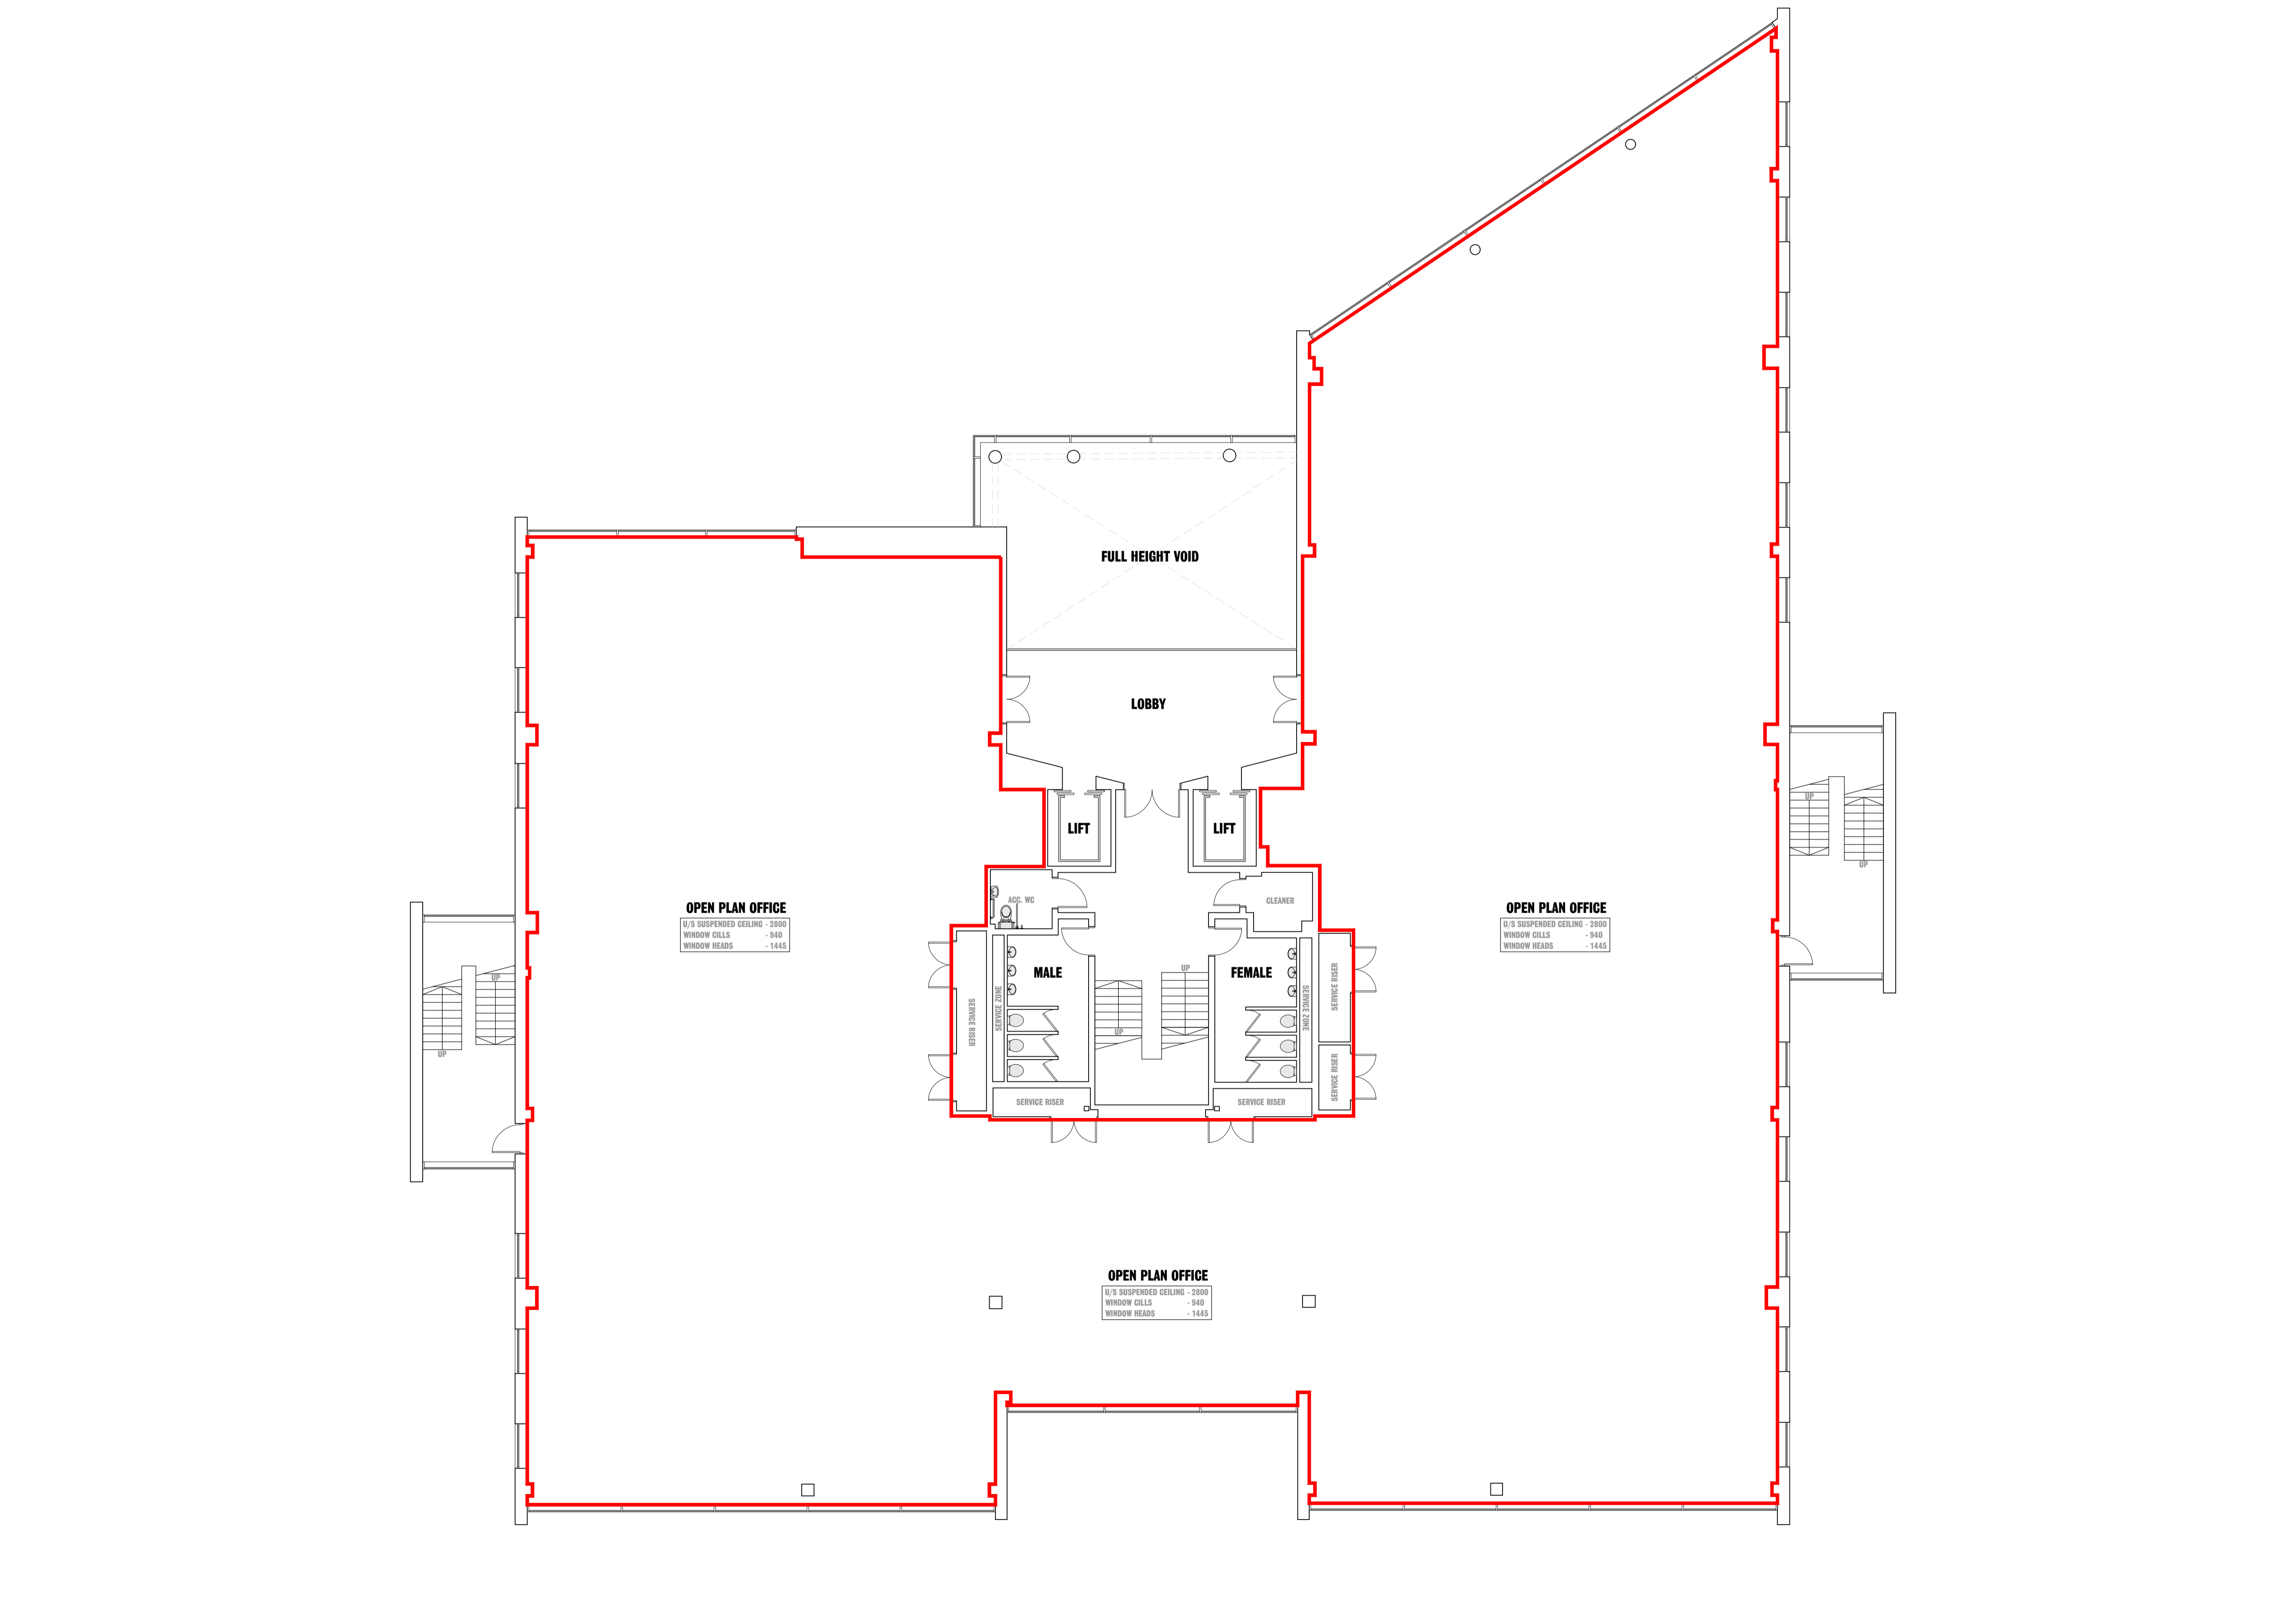

SCHEDULE OF NIA	
BUILDING 2	
GROUND FLOOR SUITE A	5,572.69 sq.ft
GROUND FLOOR SUITE B	6,954.99 sq.ft
FIRST FLOOR	12,573.54 sq.ft
SECOND FLOOR	12,575.48 sq.ft
THIRD FLOOR	10,897.06 sq.ft
ROOF PLANT	1,184.76 sq.ft

0 INITIAL ISSUE 26/08/25

DMU DESIGNS

ARCHITECTURAL SERVICES LTD

- PLANNING APPLICATIONS
- BUILDING REGULATIONS
- RESIDENTIAL BUILDING SURVEYS
- WORKING DRAWINGS
- EXHIBITIONS / EXHIBIT GUIDANCE
- SPACE PLANNING

MAX@DMUDESIGNS.CO.UK
WWW.DMUDESIGNS.CO.UK
+44 1947 557265

CLIENT
DAVELA ESTATE LTD

STATUS
MEASURED BUILDING SURVEY

DRAWING NUMBER 3398-002	DRAWING TITLE BUILDING 2 - FIRST FLOOR
DRAWING REVISION 0	DATE AUGUST 2025
SCALE 1:100	PAPER SIZE A1
	DRAWN BY PTM

PROPERTY
**BUILDING 2 & 3, CITY WEST
THE BOULEVARD, HOLBECK
LEEDS, LS12 6NJ**


DO NOT SCALE FROM THIS DRAWING. ANY DISCREPANCIES TO BE REPORTED IMMEDIATELY.
DMU DESIGNS IS A LIMITED COMPANY REGISTERED IN ENGLAND AND WALES. REGISTERED NUMBER: 710997

BUILDING 2 - FIRST FLOOR PLAN AS EXISTING 1:100



SCHEDULE OF NIA	
BUILDING 2	
GROUND FLOOR SUITE A	5,572.69 sq.ft
GROUND FLOOR SUITE B	6,954.99 sq.ft
FIRST FLOOR	12,573.54 sq.ft
SECOND FLOOR	12,575.48 sq.ft
THIRD FLOOR	10,897.06 sq.ft
ROOF PLANT	1,164.76 sq.ft

BUILDING 2 - SECOND FLOOR PLAN AS EXISTING 1:100

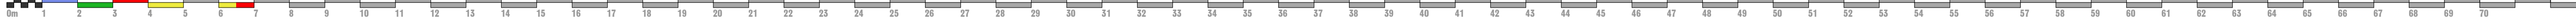

0 INITIAL ISSUE 26/08/25

DMU DESIGNS
ARCHITECTURAL SERVICES LTD

PLANNING APPLICATIONS
BUILDING REGULATIONS
RESIDENTIAL BUILDING SURVEYS
WORKING DRAWINGS
FACILITIES / FACTORY GRADING
SPACE PLANNING

MAX@DMUDESIGNS.CO.UK
WWW.DMUDESIGNS.CO.UK
+44 (0)1977 157265


CLIENT
DAVELA ESTATE LTD

STATUS
MEASURED BUILDING SURVEY

DRAWING NUMBER 3398-003	DRAWING TITLE BUILDING 2 - SECOND FLOOR
DRAWING REVISION 0	DATE AUGUST 2025
SCALE 1:100	PAPER SIZE A1
	DRAWN BY PTM

PROPERTY
**BUILDING 2 & 3, CITY WEST
THE BOULEVARD, HOLBECK
LEEDS, LS12 6NJ**

DO NOT SCALE FROM THIS DRAWING. ANY DISCREPANCIES TO BE REPORTED IMMEDIATELY.
DMU DESIGNS IS A LIMITED COMPANY REGISTERED IN ENGLAND AND WALES. REGISTERED NUMBER: 710997

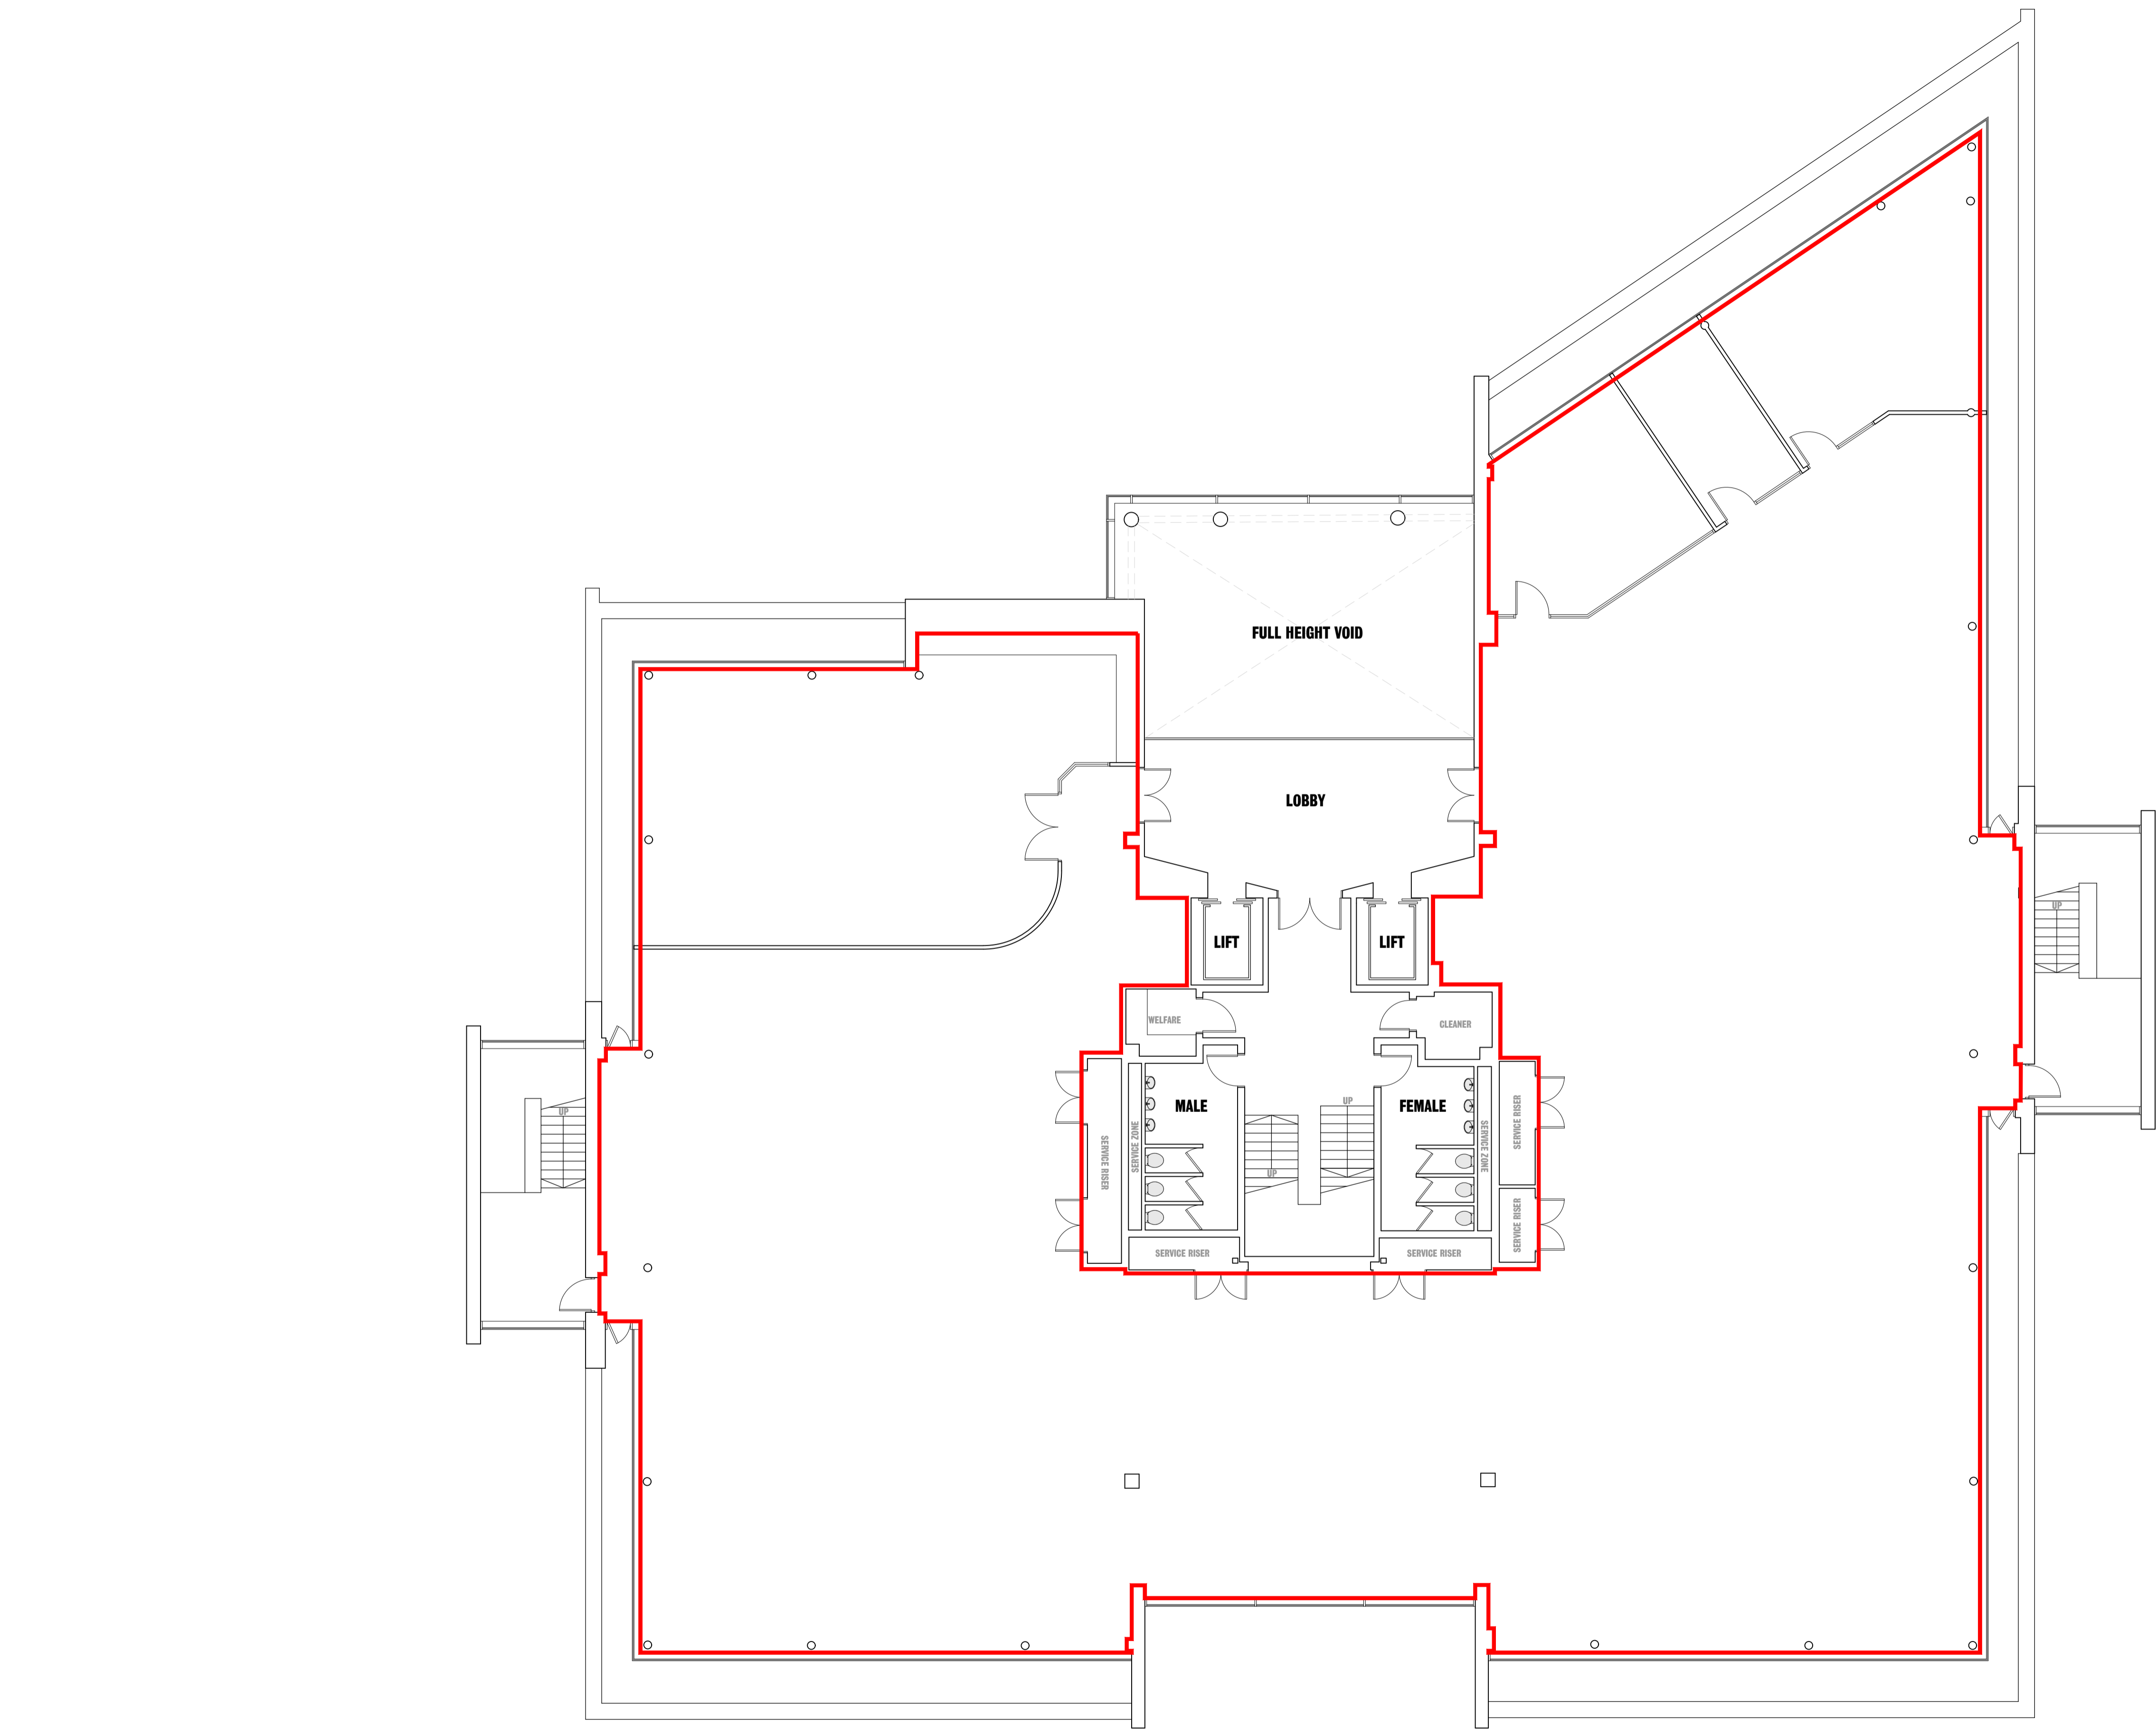

SCHEDULE OF NIA	
BUILDING 2	
GROUND FLOOR SUITE A	5,572.69 sq.ft
GROUND FLOOR SUITE B	6,954.99 sq.ft
FIRST FLOOR	12,573.54 sq.ft
SECOND FLOOR	12,575.48 sq.ft
THIRD FLOOR	10,897.06 sq.ft
ROOF PLANT	1,164.76 sq.ft

0 INITIAL ISSUE 26/08/25

DMU DESIGNS
ARCHITECTURAL SERVICES LTD

- PLANNING APPLICATIONS
- BUILDING REGULATIONS
- RESIDENTIAL BUILDING SURVEYS
- WORKING DRAWINGS
- EXHIBITIONS / EXHIBIT GUIDANCE
- SPACE PLANNING


MAX@DMUDESIGNS.CO.UK
WWW.DMUDESIGNS.CO.UK
+44 (0)1977 157265

CLIENT DAVELA ESTATE LTD		
STATUS MEASURED BUILDING SURVEY		
DRAWING NUMBER 3398-004	DRAWING TITLE BUILDING 2 - THIRD FLOOR	
DRAWING REVISION 0	DATE AUGUST 2025	
SCALE 1:100	PAPER SIZE A1	DRAWN BY PTM

PROPERTY
**BUILDING 2 & 3, CITY WEST
THE BOULEVARD, HOLBECK
LEEDS, LS12 6NJ**


DO NOT SCALE FROM THIS DRAWING. ANY DISCREPANCIES TO BE REPORTED IMMEDIATELY.
DMU DESIGNS IS A LIMITED COMPANY REGISTERED IN ENGLAND AND WALES. REGISTERED NUMBER: 710907

BUILDING 2 - THIRD FLOOR PLAN AS EXISTING 1:100

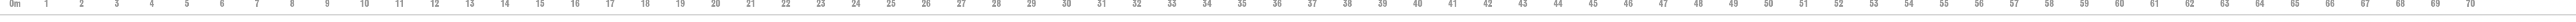


SCHEDULE OF NIA

BUILDING 2	
GROUND FLOOR SUITE A	5,572.69 sq.ft
GROUND FLOOR SUITE B	6,954.99 sq.ft
FIRST FLOOR	12,573.54 sq.ft
SECOND FLOOR	12,575.48 sq.ft
THIRD FLOOR	10,897.06 sq.ft
ROOF PLANT	1,184.76 sq.ft

 

BUILDING 2 - ROOF PLANT AS EXISTING 1:100

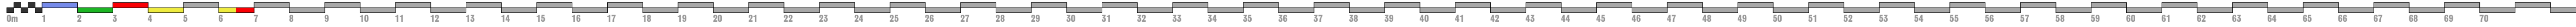

0 INITIAL ISSUE 26/08/25

DMU DESIGNS
ARCHITECTURAL SERVICES LTD

- PLANNING APPLICATIONS
- BUILDING REGULATIONS
- RESIDENTIAL BUILDING SURVEYS
- WORKING DRAWINGS
- EXHIBITIONS / EXHIBIT GUIDES
- SPACE PLANNING

MAX@DMUDESIGNS.CO.UK
WWW.DMUDESIGNS.CO.UK
+44 (0)113 2767 15726

CLIENT
DAVELA ESTATE LTD

STATUS
MEASURED BUILDING SURVEY

DRAWING NUMBER	DRAWING TITLE	
3398-005	BUILDING 2 - ROOF PLANT	
DRAWING REVISION	DATE	
0	AUGUST 2025	
SCALE	PAPER SIZE	DRAWN BY
1:100	A1	PTM

PROPERTY
**BUILDING 2 & 3, CITY WEST
THE BOULEVARD, HOLBECK
LEEDS, LS12 6NJ**


DO NOT SCALE FROM THIS DRAWING. ANY DISCREPANCIES TO BE REPORTED IMMEDIATELY.
DMU DESIGNS IS A LIMITED COMPANY REGISTERED IN ENGLAND AND WALES. REGISTERED NUMBER: 710897

SCHEDULE OF NIA

BUILDING 3	
GROUND FLOOR	9,278.81 sq.ft
FIRST FLOOR	9,280.75 sq.ft
SECOND FLOOR SUITE A	4,578.43 sq.ft
SECOND FLOOR SUITE B	4,461.00 sq.ft
THIRD FLOOR	7,908.14 sq.ft
ROOF PLANT	622.80 sq.ft



BUILDING 3 - GROUND FLOOR PLAN AS EXISTING 1:100

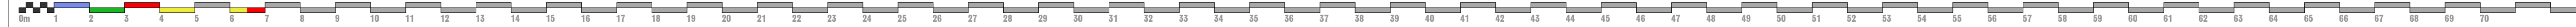

0 INITIAL ISSUE 26/08/25

DMU DESIGNS
ARCHITECTURAL SERVICES LTD

- PLANNING APPLICATIONS
- BUILDING REGULATIONS
- RESIDENTIAL BUILDING SERVICES
- WORKING DRAWINGS
- EXHIBITIONS / EXHIBIT DESIGN
- SPACE PLANNING

MAX@DMUDESIGNS.CO.UK
WWW.DMUDESIGNS.CO.UK
+44 (0)1977 157265

CLIENT
DAVELA ESTATE LTD

STATUS
MEASURED BUILDING SURVEY

DRAWING NUMBER	DRAWING TITLE	
3398-006	BUILDING 3 - GROUND FLOOR	
DRAWING REVISION	DATE	
0	AUGUST 2025	
SCALE	PAPER SIZE	DRAWN BY
1:100	A1	PTM

PROPERTY
**BUILDING 2 & 3, CITY WEST
THE BOULEVARD, HOLBECK
LEEDS, LS12 6NJ**


DO NOT SCALE FROM THIS DRAWING. ANY DISCREPANCIES TO BE REPORTED IMMEDIATELY.
DMU DESIGNS IS A LIMITED COMPANY REGISTERED IN ENGLAND AND WALES. REGISTERED NUMBER: 710897

SCHEDULE OF NIA

BUILDING 3	
GROUND FLOOR	9,278.81 sq.ft
FIRST FLOOR	9,280.75 sq.ft
SECOND FLOOR SUITE A	4,578.43 sq.ft
SECOND FLOOR SUITE B	4,461.00 sq.ft
THIRD FLOOR	7,908.14 sq.ft
ROOF PLANT	622.80 sq.ft



BUILDING 3 - FIRST FLOOR PLAN AS EXISTING 1:100

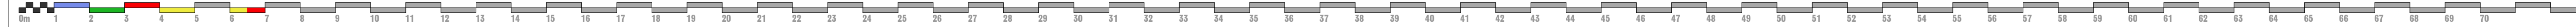

0 INITIAL ISSUE 26/08/25

DMU DESIGNS
ARCHITECTURAL SERVICES LTD

- PLANNING APPLICATIONS
- BUILDING REGULATIONS
- REGISTERED BUILDING SURVEYORS
- WORKING DRAWINGS
- EXHIBITION / EXHIBIT DESIGN
- SPACE PLANNING

MAX J@DMUDESIGNS.CO.UK
WWW.DMUDESIGNS.CO.UK
+44 1947 157261

CLIENT
DAVELA ESTATE LTD

STATUS
MEASURED BUILDING SURVEY


DRAWING NUMBER	DRAWING TITLE	
3398-007	BUILDING 3 - FIRST FLOOR	
DRAWING REVISION	DATE	
0	AUGUST 2025	
SCALE	PAPER SIZE	DRAWN BY
1:100	A1	PTM

PROPERTY
**BUILDING 2 & 3, CITY WEST
THE BOULEVARD, HOLBECK
LEEDS, LS12 6NJ**


DO NOT SCALE FROM THIS DRAWING. ANY DISCREPANCIES TO BE REPORTED IMMEDIATELY.
DMU DESIGNS IS A LIMITED COMPANY REGISTERED IN ENGLAND AND WALES. REGISTERED NUMBER: 710897

SCHEDULE OF NIA

BUILDING 3	
GROUND FLOOR	9,278.81 sq.ft
FIRST FLOOR	9,280.75 sq.ft
SECOND FLOOR SUITE A	4,578.43 sq.ft
SECOND FLOOR SUITE B	4,461.00 sq.ft
THIRD FLOOR	7,908.14 sq.ft
ROOF PLANT	622.80 sq.ft

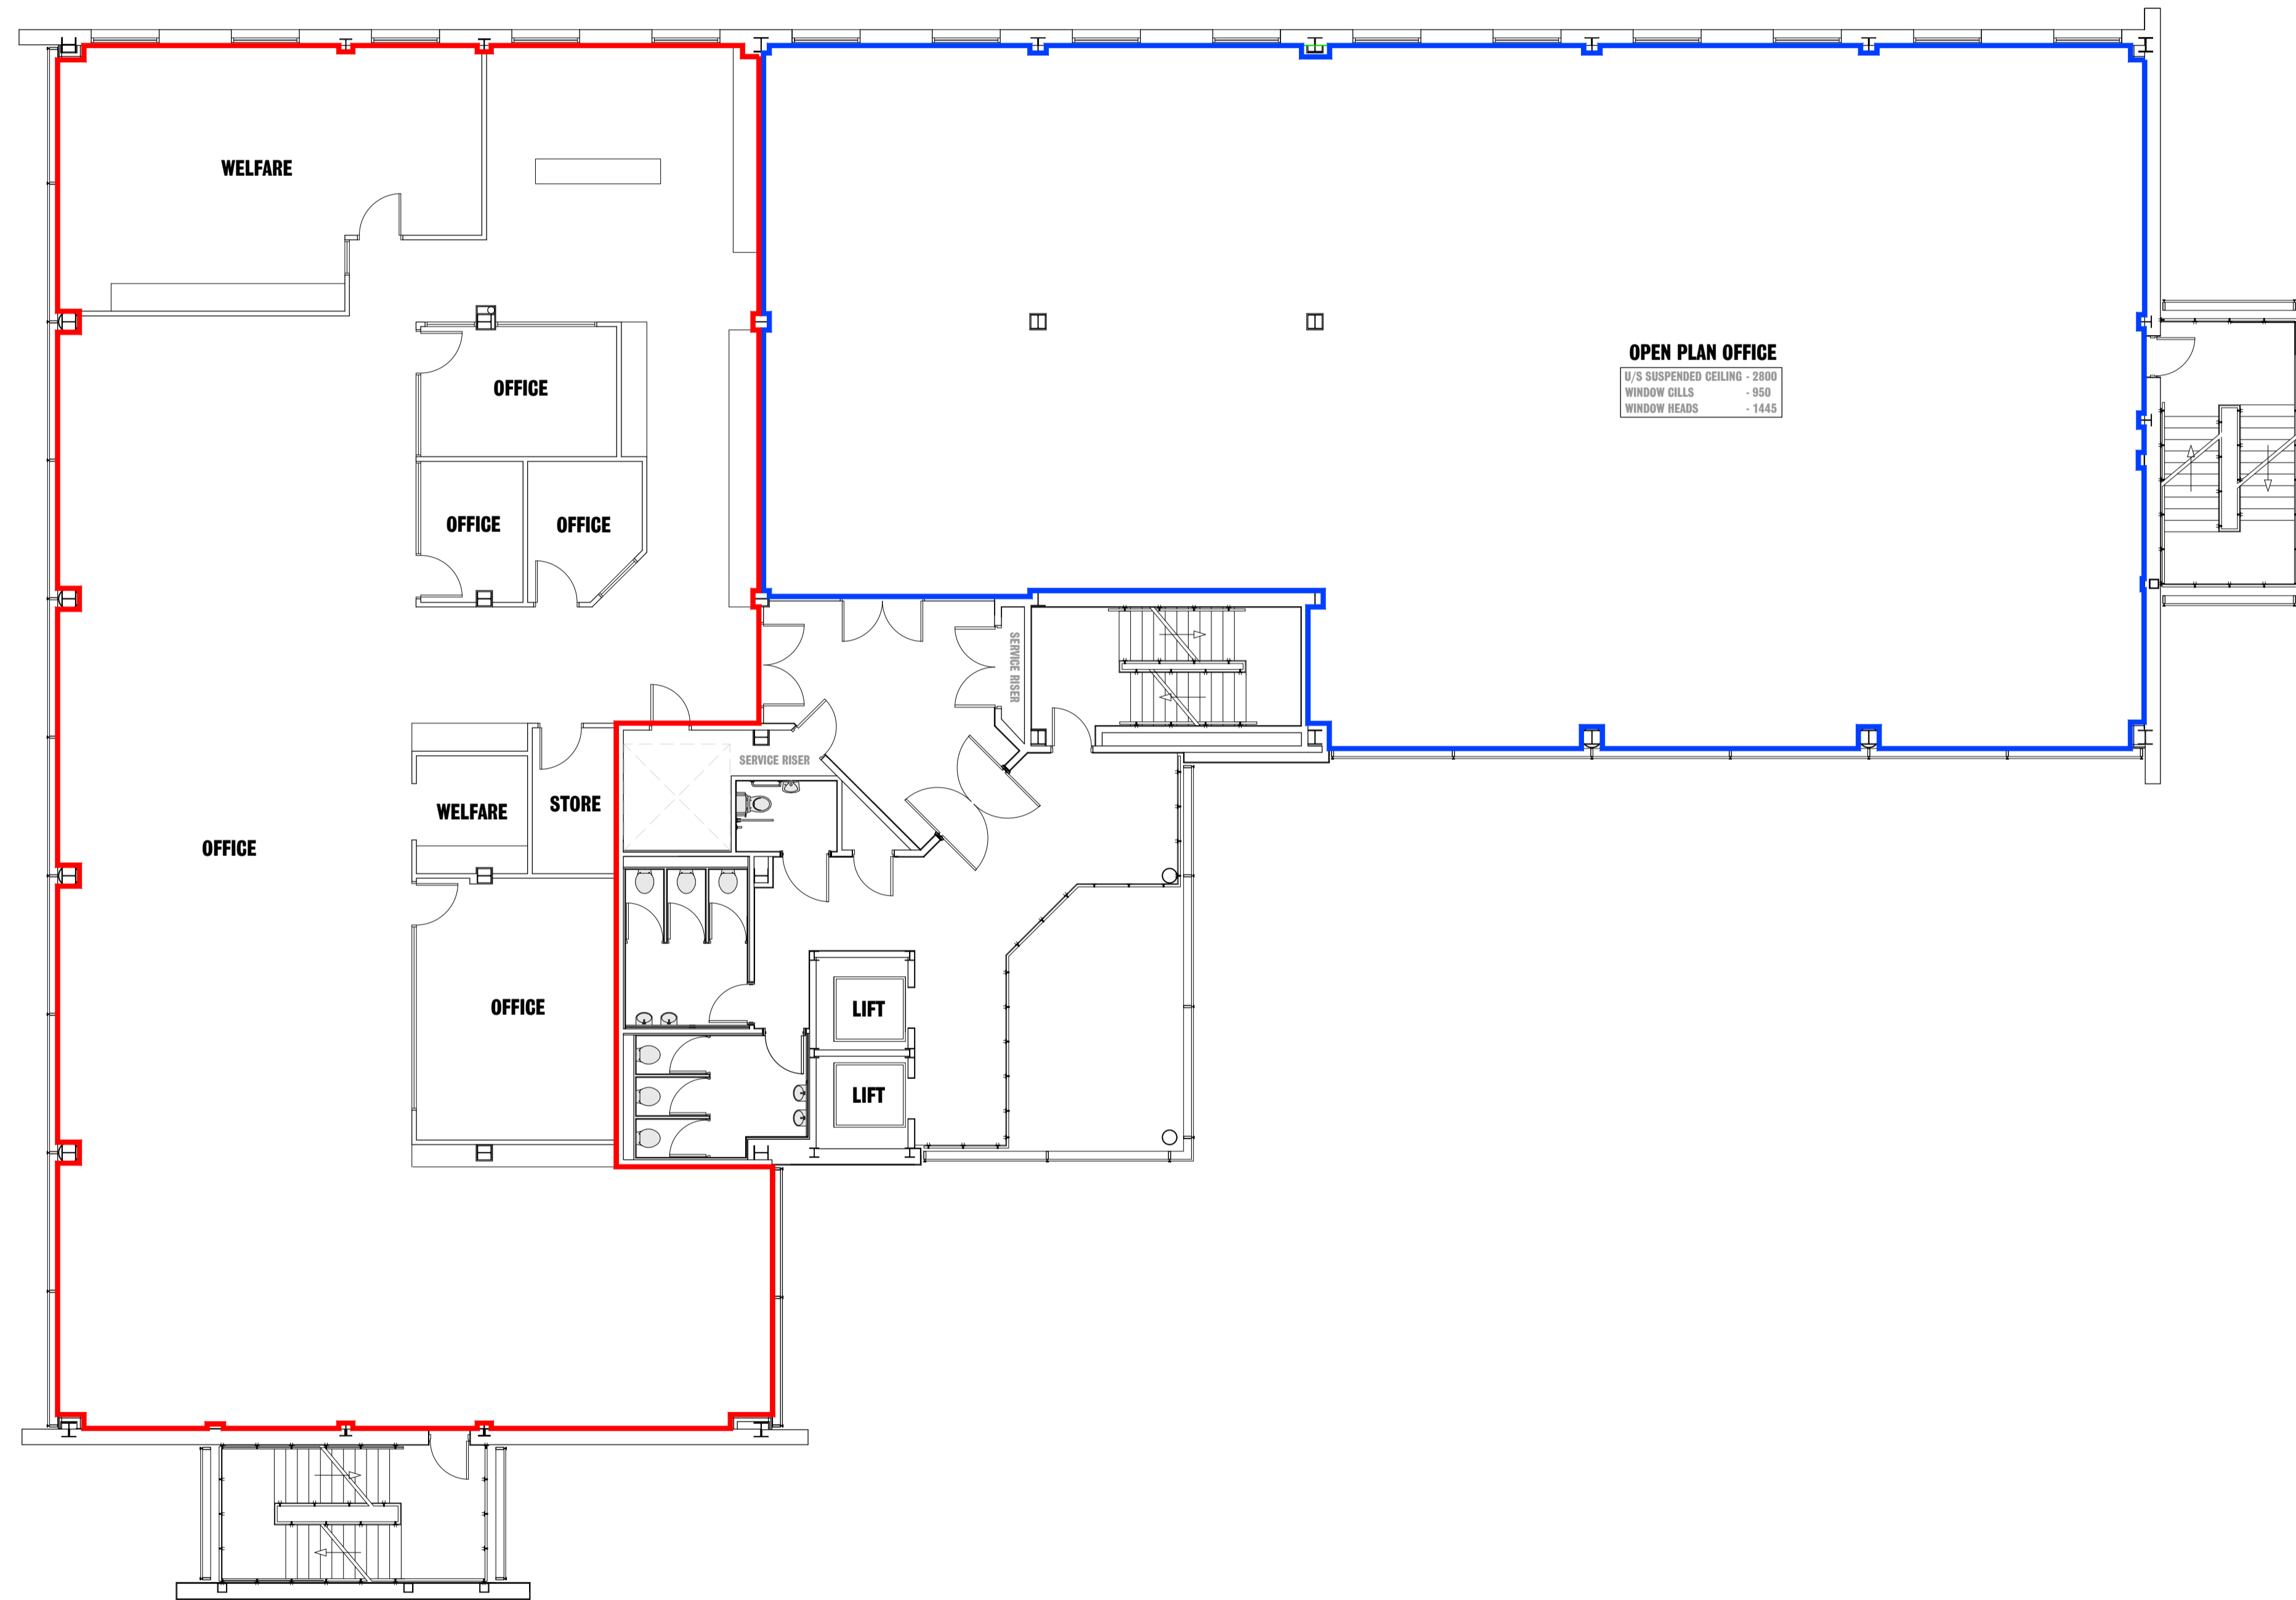

BUILDING 3 - SECOND FLOOR PLAN AS EXISTING 1:100

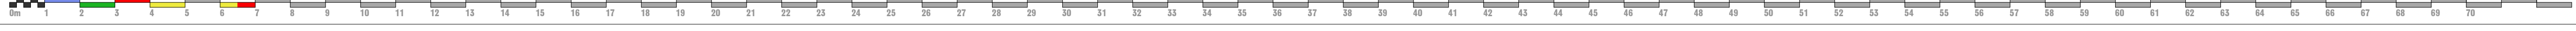

0 INITIAL ISSUE 26/08/25

DMU DESIGNS
ARCHITECTURAL SERVICES LTD

- PLANNING APPLICATIONS
- BUILDING REGULATIONS
- MEASURED BUILDING SURVEYS
- WORKING DRAWINGS
- EXHIBITION / EXHIBIT DESIGN
- SPACE PLANNING

WWW.DMUDESIGNS.CO.UK
+44 1947 157261


CLIENT
DAVELA ESTATE LTD

STATUS
MEASURED BUILDING SURVEY

DRAWING NUMBER	DRAWING TITLE	
3398-008	BUILDING 3 - SECOND FLOOR	
DRAWING REVISION	DATE	
0	AUGUST 2025	
SCALE	PAPER SIZE	DRAWN BY
1:100	A1	PTM


PROPERTY
**BUILDING 2 & 3, CITY WEST
THE BOULEVARD, HOLBECK
LEEDS, LS12 6NJ**

DO NOT SCALE FROM THIS DRAWING. ANY DISCREPANCIES TO BE REPORTED IMMEDIATELY.
DMU DESIGNS IS A LIMITED COMPANY REGISTERED IN ENGLAND AND WALES. REGISTERED NUMBER: 710897

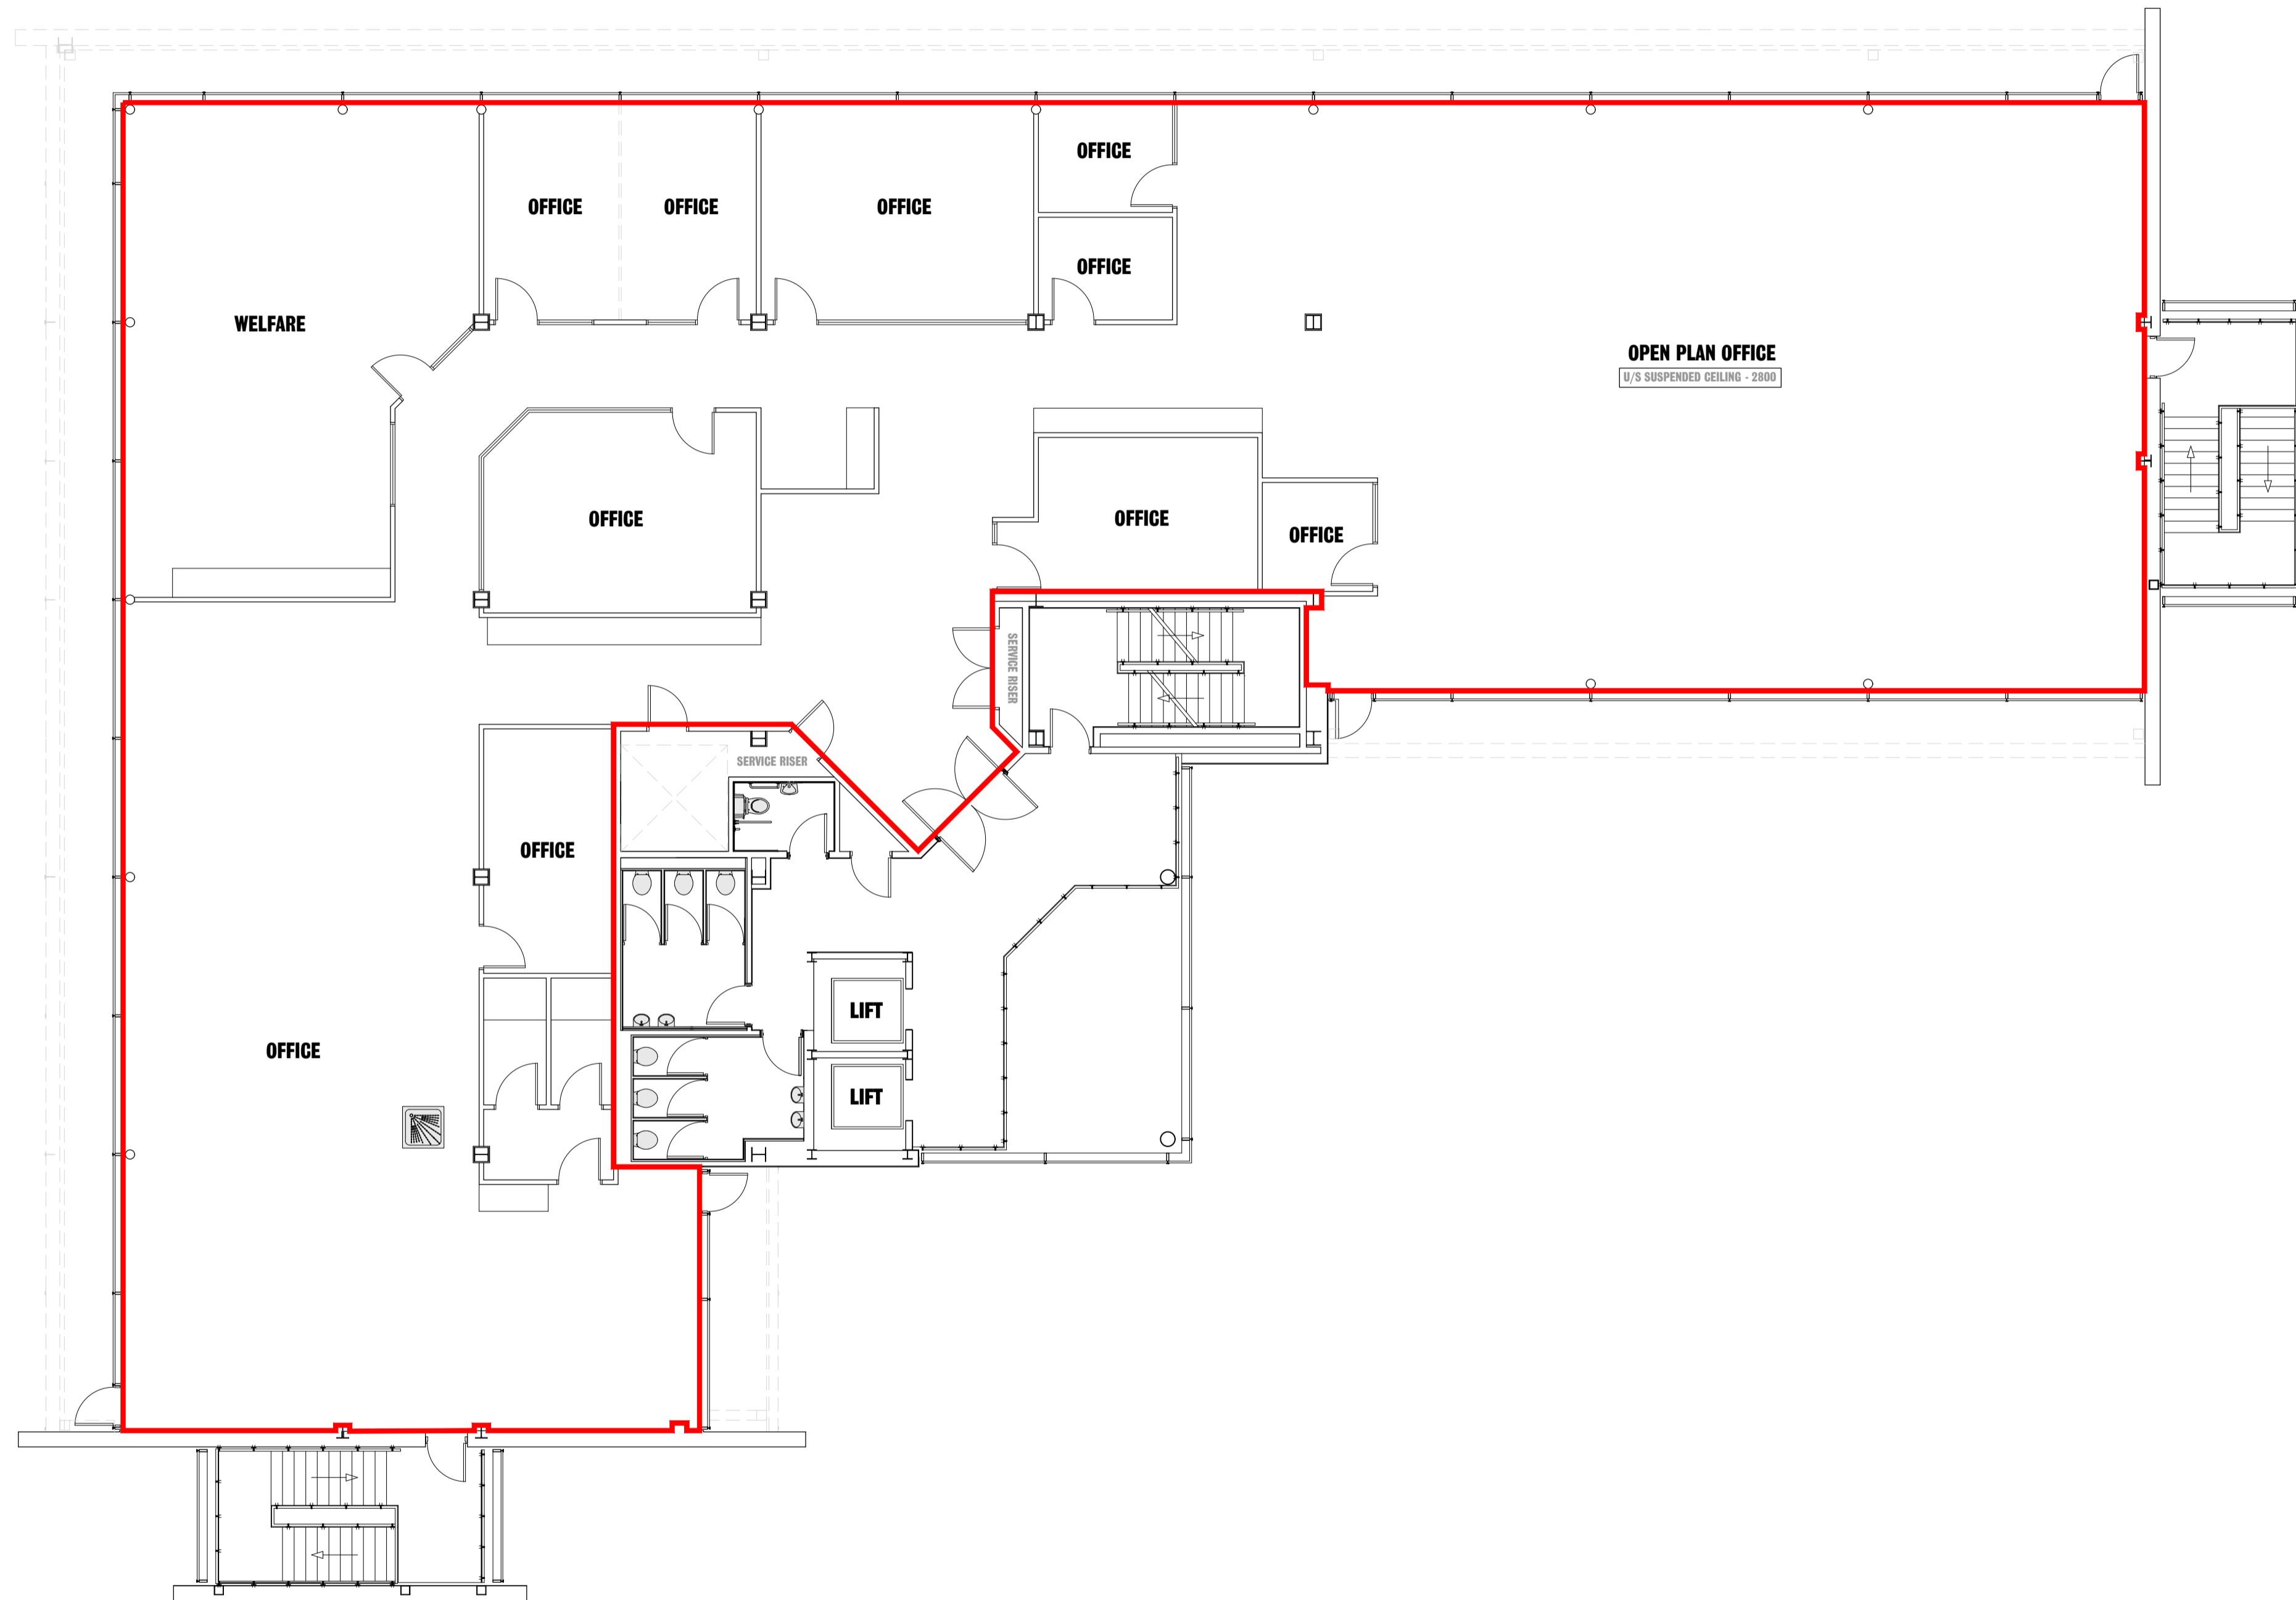

SCHEDULE OF NIA	
BUILDING 3	
GROUND FLOOR	9,278.81 sq.ft
FIRST FLOOR	9,280.75 sq.ft
SECOND FLOOR SUITE A	4,578.43 sq.ft
SECOND FLOOR SUITE B	4,461.00 sq.ft
THIRD FLOOR	7,908.14 sq.ft
ROOF PLANT	622.80 sq.ft

BUILDING 3 - THIRD FLOOR PLAN AS EXISTING 1:100

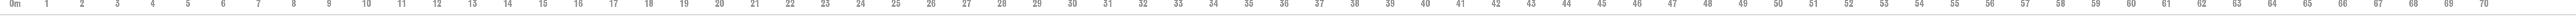

0 INITIAL ISSUE 26/08/25

DMU DESIGNS

ARCHITECTURAL SERVICES LTD

- PLANNING APPLICATIONS
- BUILDING REGULATIONS
- MEASURED BUILDING SURVEYS
- WORKING DRAWINGS
- EXHIBITIONS / EXHIBIT GUIDES
- SPACE PLANNING

MAX@DMUDESIGNS.CO.UK
WWW.DMUDESIGNS.CO.UK
+44 (0)1977 157265

CLIENT
DAVELA ESTATE LTD

STATUS
MEASURED BUILDING SURVEY


DRAWING NUMBER 3398-009	DRAWING TITLE BUILDING 3 - THIRD FLOOR
DRAWING REVISION 0	DATE AUGUST 2025
SCALE 1:100	PAPER SIZE A1
	DRAWN BY PTM

PROPERTY
**BUILDING 2 & 3, CITY WEST
THE BOULEVARD, HOLBECK
LEEDS, LS12 6NJ**


DO NOT SCALE FROM THIS DRAWING. ANY DISCREPANCIES TO BE REPORTED IMMEDIATELY.
DMU DESIGNS IS A LIMITED COMPANY REGISTERED IN ENGLAND AND WALES. REGISTERED NUMBER: 710897

SCHEDULE OF NIA

BUILDING 3	
GROUND FLOOR	9,278.81 sq.ft
FIRST FLOOR	9,280.75 sq.ft
SECOND FLOOR SUITE A	4,578.43 sq.ft
SECOND FLOOR SUITE B	4,461.00 sq.ft
THIRD FLOOR	7,908.14 sq.ft
ROOF PLANT	622.80 sq.ft

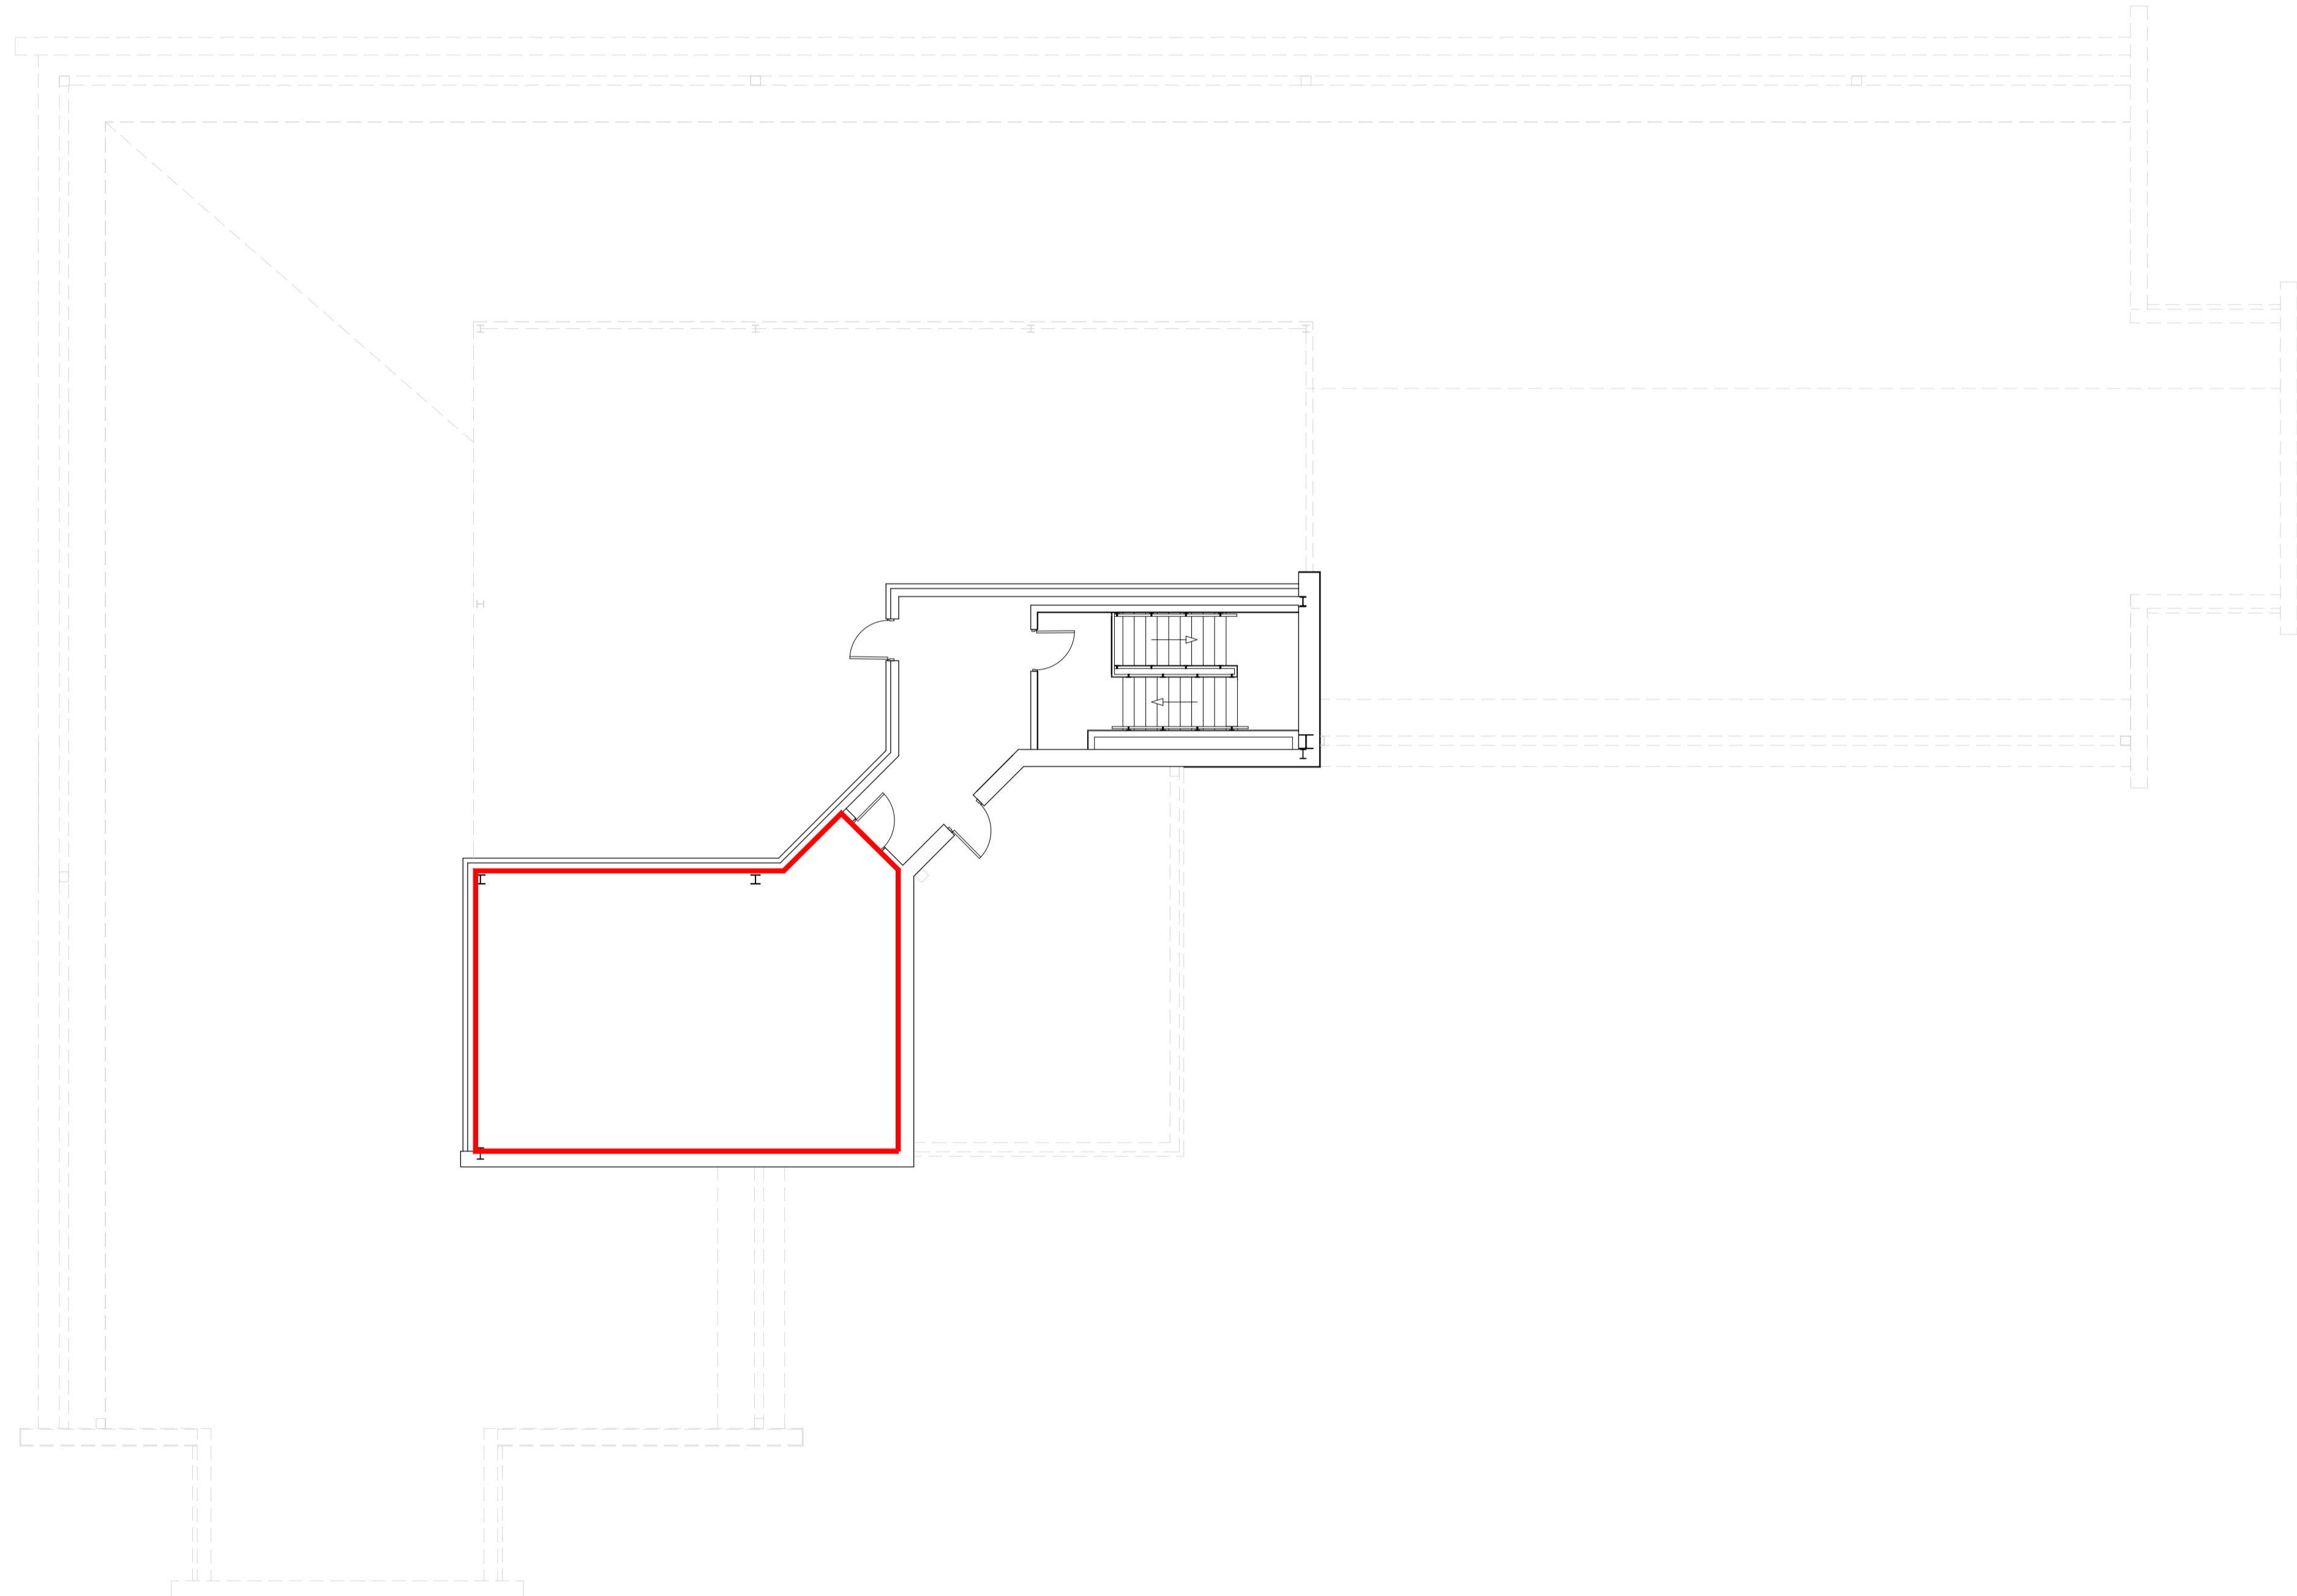

BUILDING 3 - ROOF PLANT AS EXISTING 1:100

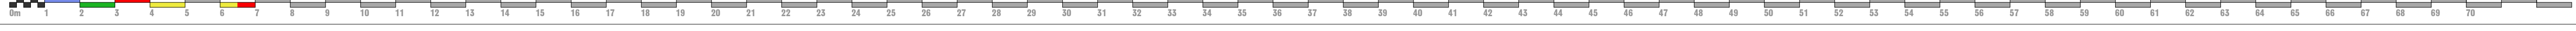

0 INITIAL ISSUE 26/08/25

DMU DESIGNS
ARCHITECTURAL SERVICES LTD

- PLANNING APPLICATIONS
- BUILDING REGULATIONS
- MEASURED BUILDING SURVEYS
- WORKING DRAWINGS
- EXHIBITIONS / EXHIBIT GUIDANCE
- SPACE PLANNING

MAX@DMUDESIGNS.CO.UK
WWW.DMUDESIGNS.CO.UK
+44 1162 557265

CLIENT
DAVELA ESTATE LTD

STATUS
MEASURED BUILDING SURVEY

DRAWING NUMBER	DRAWING TITLE	
3398-010	BUILDING 3 - ROOF PLANT	
DRAWING REVISION	DATE	
0	AUGUST 2025	
SCALE	PAPER SIZE	DRAWN BY
1:100	A1	PTM

PROPERTY
**BUILDING 2 & 3, CITY WEST
THE BOULEVARD, HOLBECK
LEEDS, LS12 6NJ**

DO NOT SCALE FROM THIS DRAWING. ANY DISCREPANCIES TO BE REPORTED IMMEDIATELY.
DMU DESIGNS IS A LIMITED COMPANY REGISTERED IN ENGLAND AND WALES. REGISTERED NUMBER: 710897