


All designs are the sole property of Knotel Inc. and may not be used, transferred, or disclosed to a third party without their express permission. No dimensions or other information should be inferred from the electronic copy unless specifically shown on the hard copy drawings or specifications. Do not scale from this drawing. Figured dimensions only are to be used 'For Construction' and any scaling of the drawing will be at the Contractor's risk. Contractor to verify all dimensions, levels and components on-site. Any discrepancies shall be addressed in writing to Knotel Inc. for clarification prior to the commencement of the work, otherwise Contractor shall bear the full responsibility for any associated cost. Any claims for variations or extras shall be submitted to Knotel Inc. for assessment prior to approval of any such variation or extra. This drawing is to be read in conjunction with all other contract documentation.

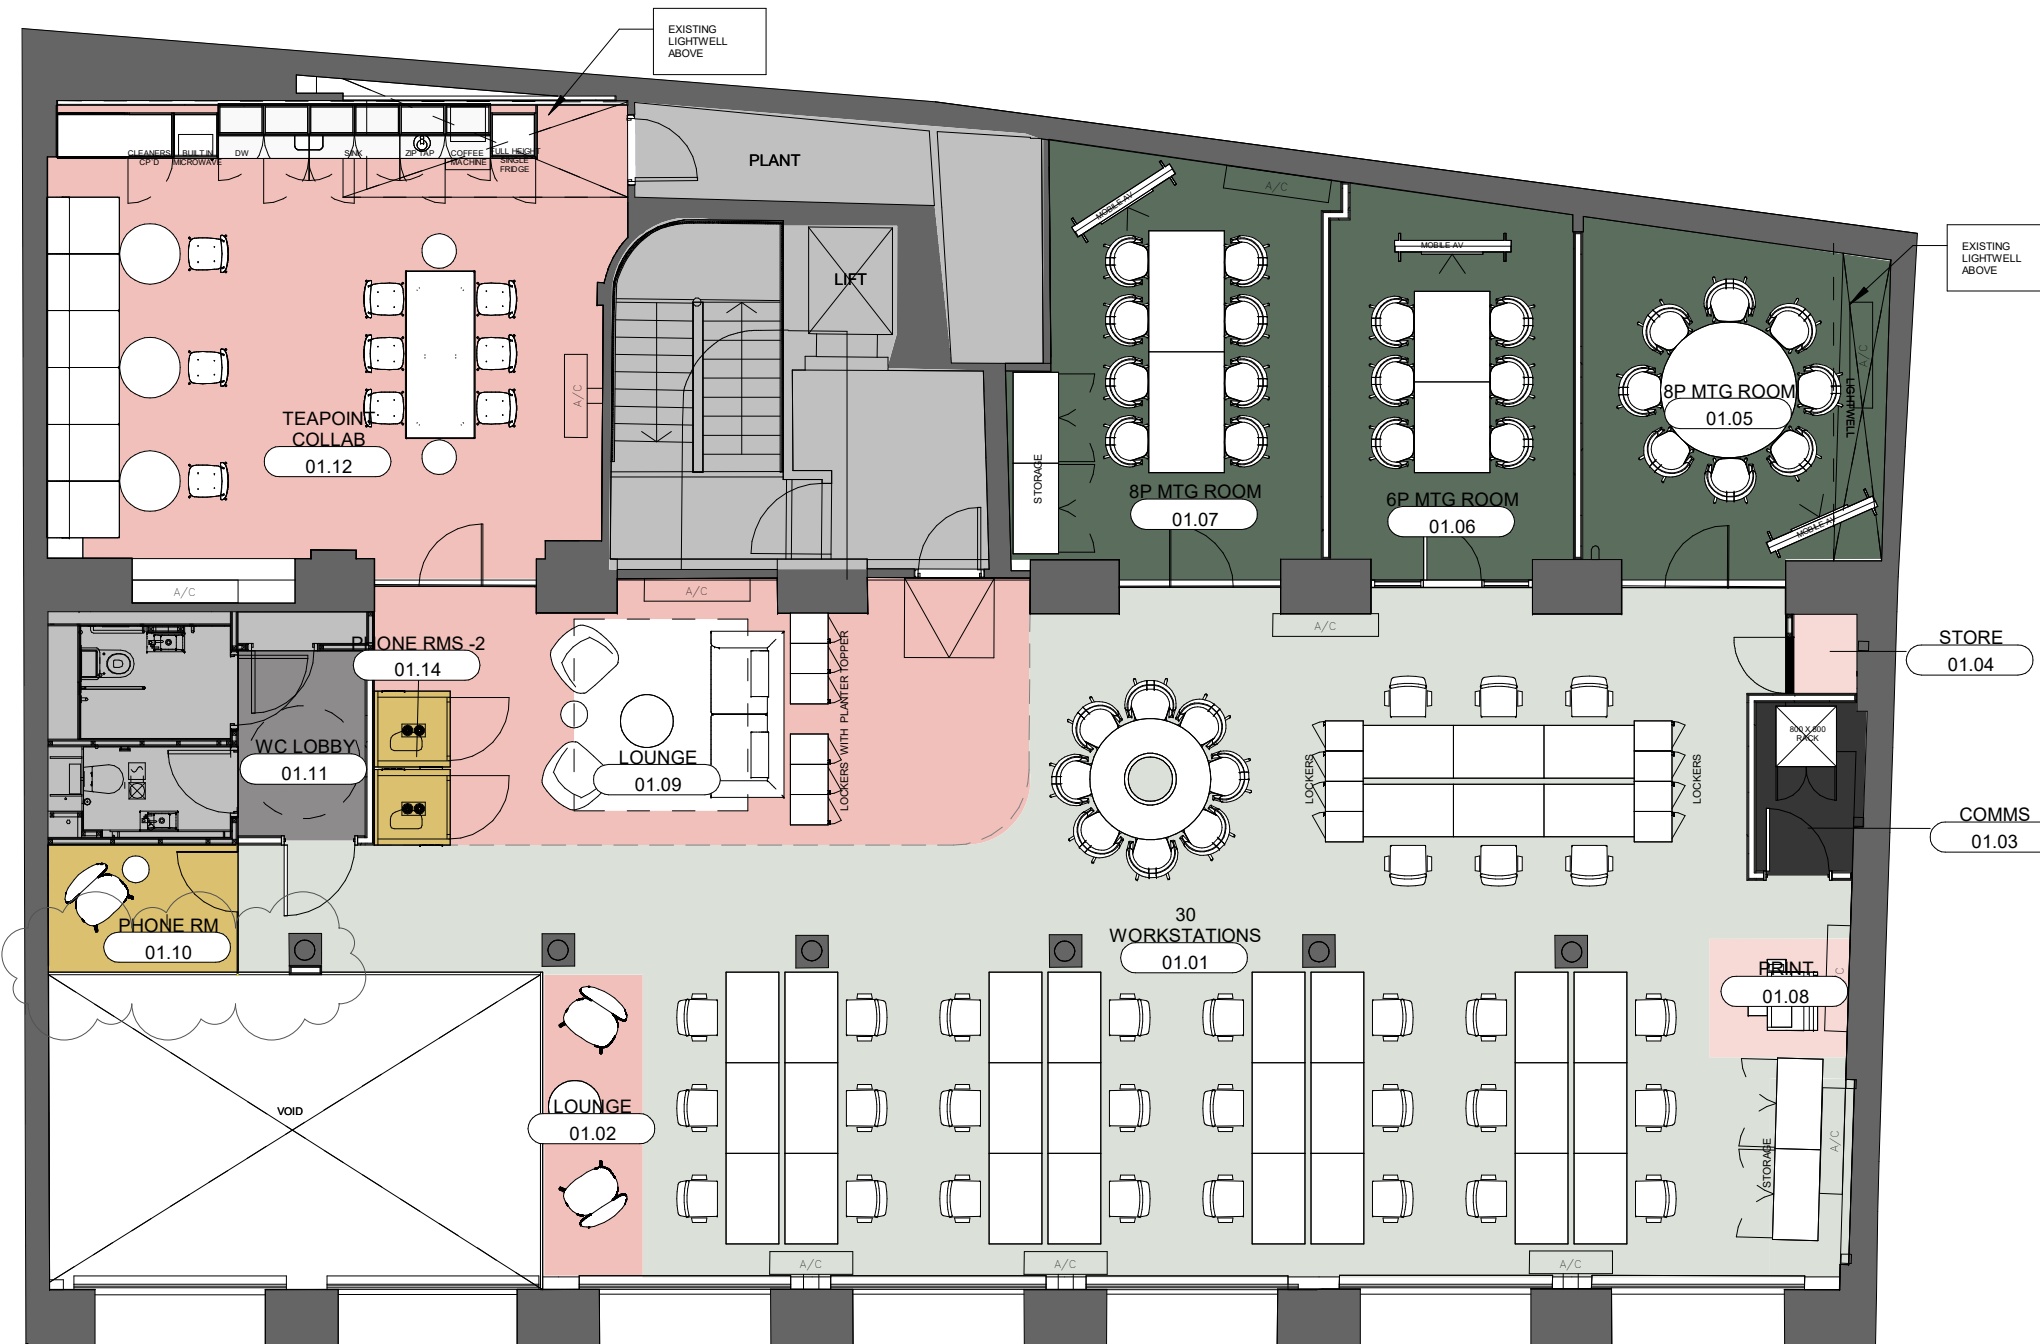

GENERAL

LEGEND:

- DENOTES AREA OUTSIDE OF SCOPE (AREA OUTSIDE OF PROJECT SCOPE)
- DENOTES AREA OUTSIDE OF DEMISE (AREA OF LANDLORDS DEMISE)

ROOM NAME

ROOM NUMBER

REVISION

ID	NAME	DATE	COMMENTS
P1	SM	17.09.24	First Issue
P2	SM	18.09.24	Issued To Contractor
P3	SM	25.09.24	Landlord Issue. Partition length amended

# FLOORPLAN

PROPERTY  
Weybourne  
2 Pear Tree Court, London, EC1

RENTABLE 3,102 sqft	SCALE As indicated@A3
DRAWN Designer-MM	CHECKED SM-KN

FILE  
LEVEL 01 GENERAL ARRANGEMENT PLAN

**KNOTEL**

LEGEND

- Workspace
- Reception
- Meeting Room
- Communal
- Wellness
- Storage
- Circulation
- Phone Booths
- IT/ Comms
- Toilets
- Building Core