

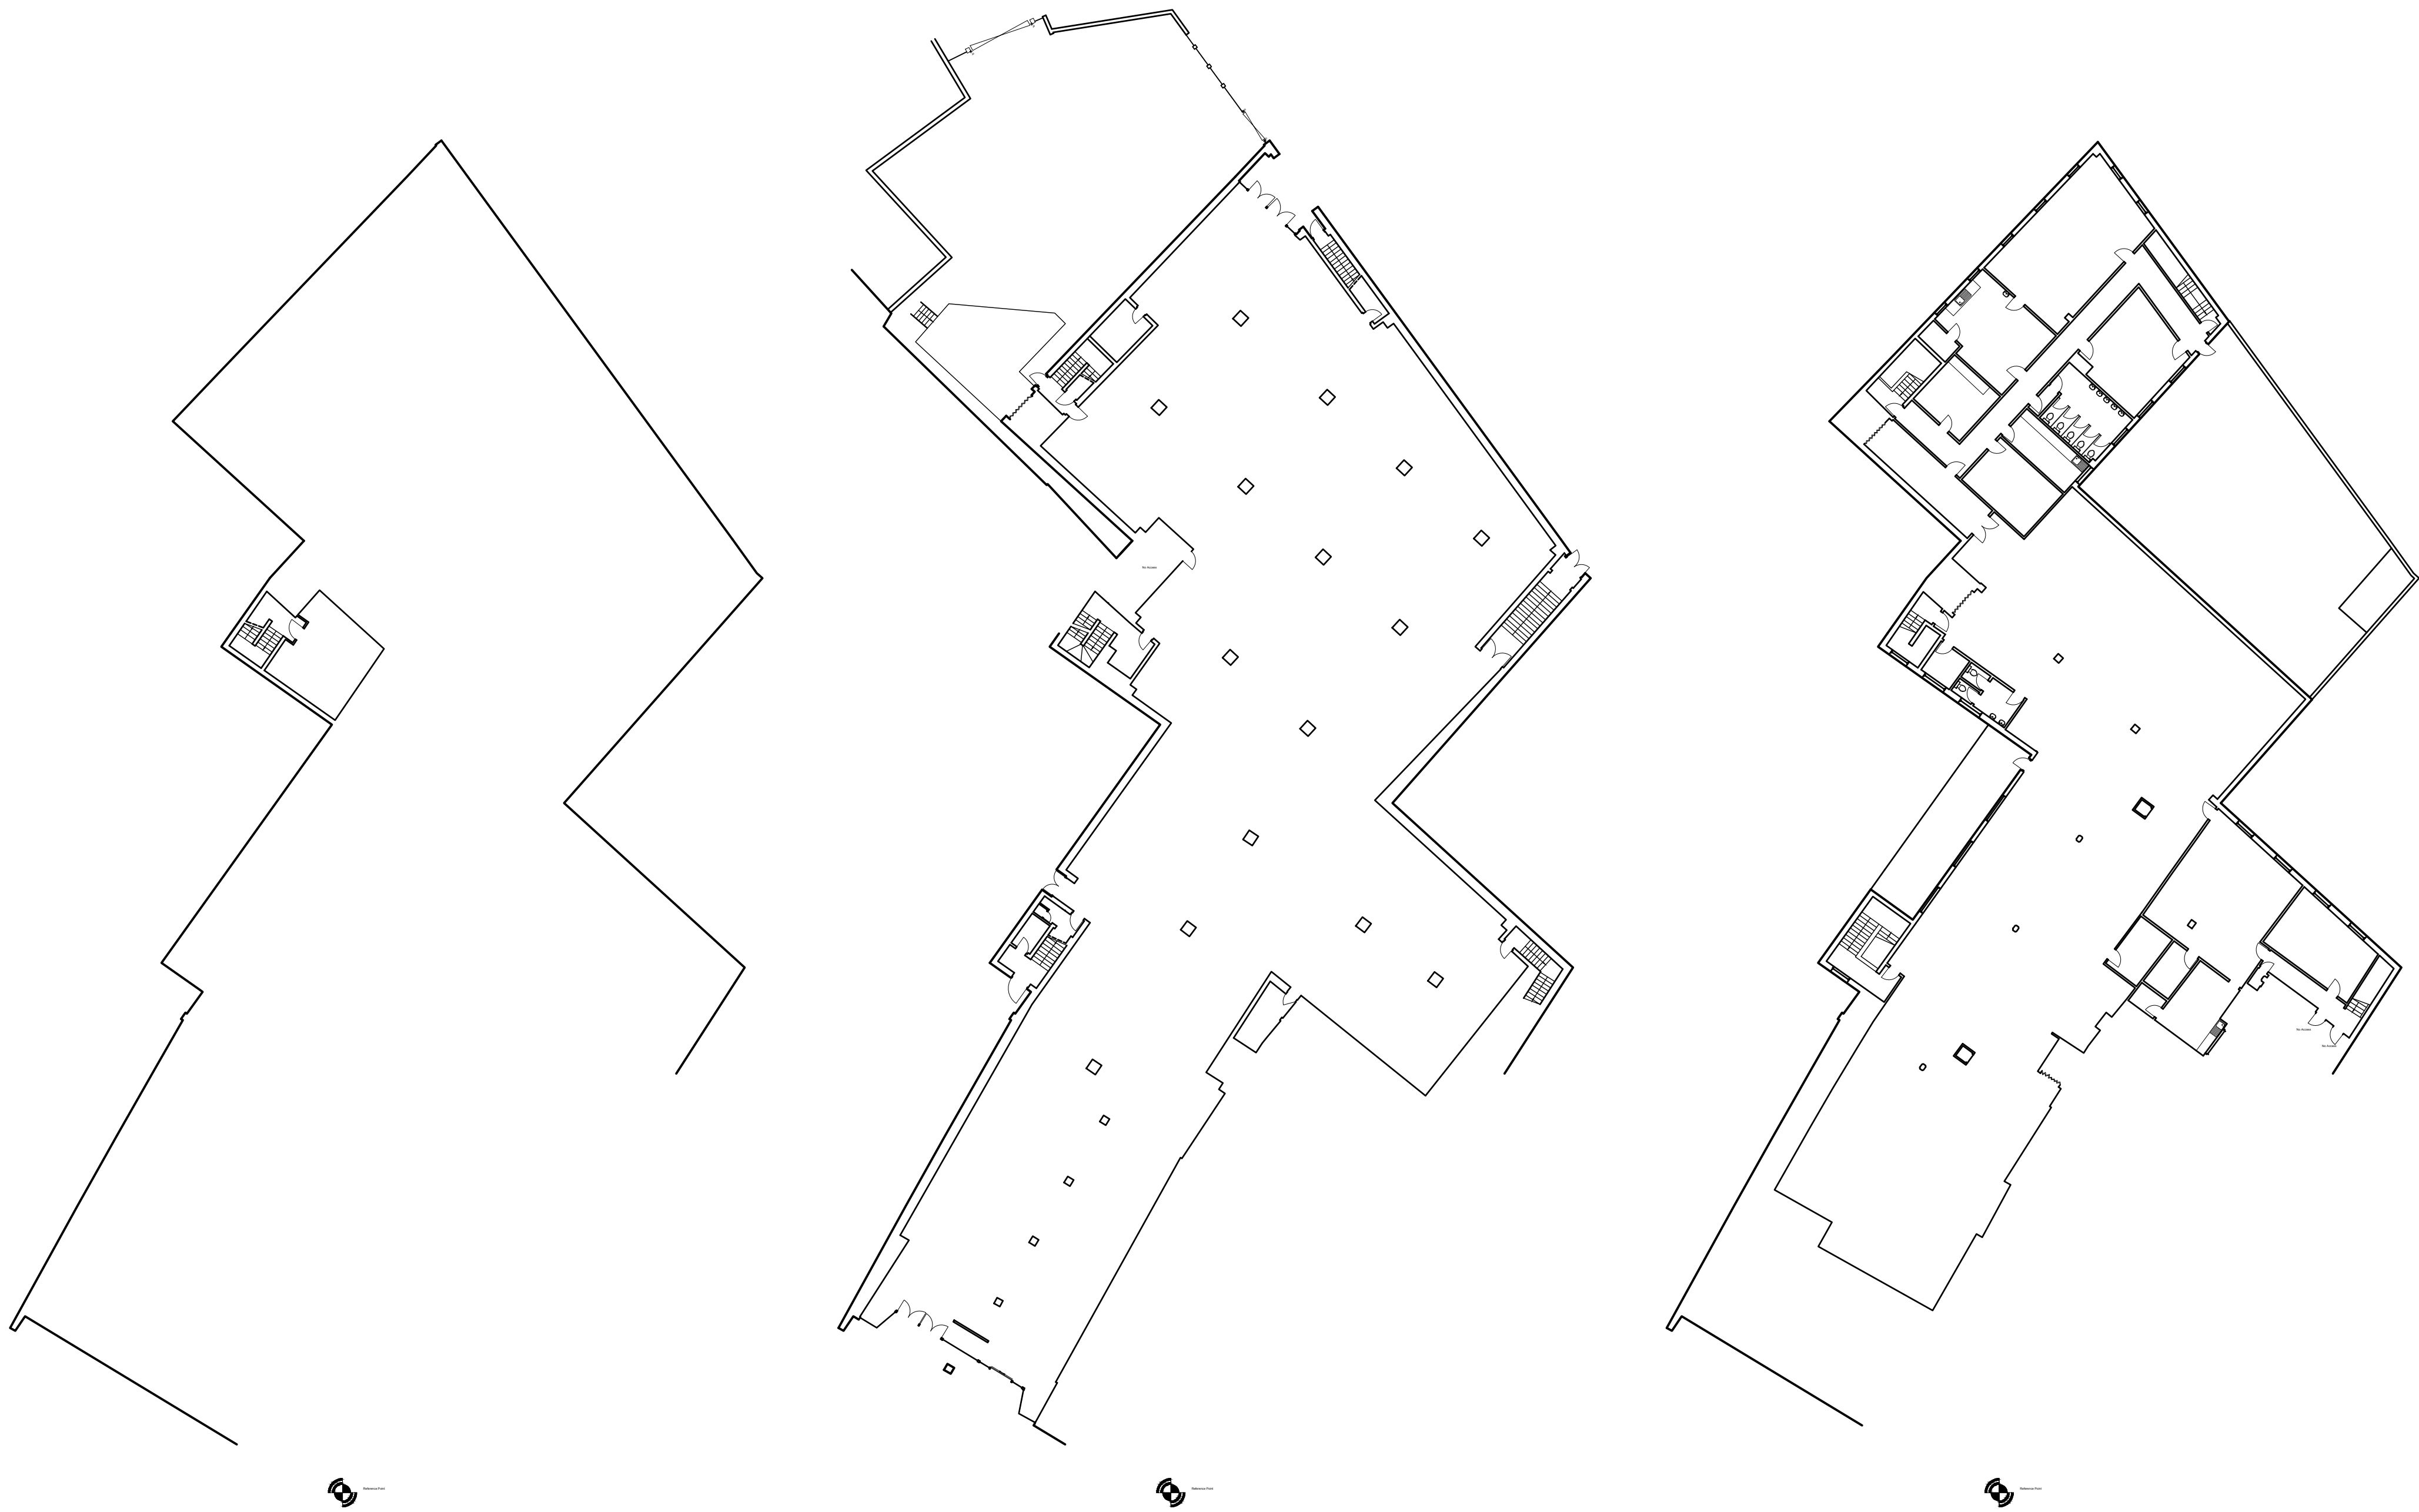


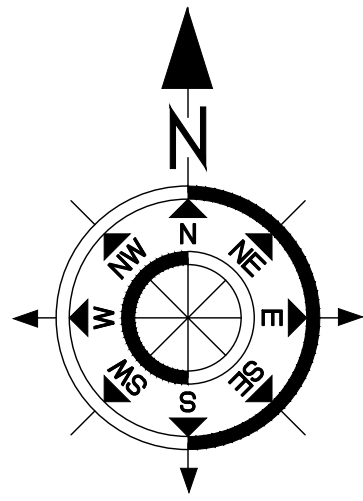

Floor Plan Abbreviations & Legend			
AH	ARCH HEIGHT	MH	MANHOLE
BH	BEAM HEIGHT	OH	OPENING HEIGHT
CH	CEILING HEIGHT	OVH	OVERHEAD
CU	CONSUMER UNIT	ST	STOP TAP
DH	DOOR HEIGHT	TOC	TOP OF COLUMN LEVEL
F/C	FALSE CEILING HEIGHT	TOW	TOP OF WALL LEVEL
G	GULLY	U/S	UNDERSIDE
FL 50.21	FINISHED FLOOR LEVEL		
BL 53.89	UNDERSIDE BEAM LEVEL		
CL 54.42	UNDERSIDE CEILING LEVEL/FALSE CEILING		
	EXTERNAL BUILDING LINE (FOOTPRINT)		
	INTERNAL WALL LINE		
	CEILING LINE/CHANGE CEILING LEVEL		
	BEAM LINE		
	WINDOW		
	SLOPING CEILING LINE		 SINK (SYMBOLIC) NOT TO SCALE
	STAIRS/STEPS		 TOILET (SYMBOLIC) NOT TO SCALE
	RAMP		
	SINGLE STEP		 URINAL (SYMBOLIC) NOT TO SCALE
	DOOR SWING (SYMBOLIC)		
	SECTION LINE		

- Technical Notes:**
- All levels are related to arbitrary site datum. STN/1 = 50.00m. The grid is related to Approx North.
 - Critical Dimensions, Steel Sizes and Heights MUST be checked on site prior to construction.
 - Above ground features and heights have been measured from floor level using non-contact methods. Actual heights and sizes may vary owing to end point definition.
 - Wall finishes are, in places, uneven. Therefore, measurements have been taken to the best fit corners. This may mean wall thickness may vary from that shown.
 - Wall measurements where possible have been taken to the main face at approx 1.5m above floor level.
 - Levels shown to Ceilings/Beams/portal Frames/Wind Bracing/Ducts are taken to underside unless specified.
 - Radiators and other M&E Apparatus including pipework, ducting, cables, switches/sockets have not been shown.
 - Some areas of the building may have been inaccessible at the time of survey, details in these areas have been omitted or are approx but will have been noted accordingly.
 - Some Window, Door and Architectural detailing may have been simplified for clarity
 - Do not scale from this drawing.

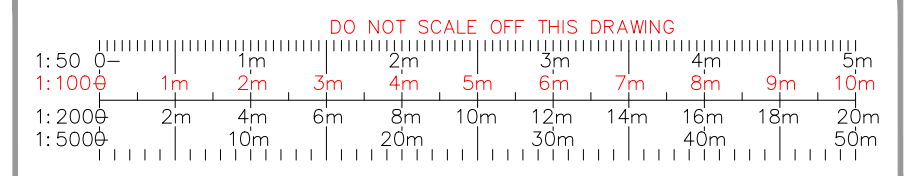

Report Arranged by *

0333 772 1835
info@mypropertysurvey.co.uk
www.myproperty.co.uk

UNIT 8 MALLARD COURT
MALLARD WAY
CREWE BUSINESS PARK
CREWE
CHESHIRE

Client:

My Property Survey

Project:

B&M Store
6-7 Hall St, South Wales
Carmarthen SA31 1PH

Drawing Title:

Floorplans

Rev.	Description	Surveyed	Approved	Date
Surveyor:	Checked By:	Approved By:	Date of Survey:	Date of Issue:
BR	BB	AJS	21/07/26	24/07/26
Drawing Status:	Scale:	Paper Size:	Sheet No:	
Final	1:200	A1	1 of 1	
Project No:	Drawing No:	Revision:		
RBS - 26/5150	RBS - 26/5150/001	-		