

NOTES

- 1) ALL DIMENSIONS TO BE CHECKED ON SITE AND NOT SCALED FROM THIS DRAWING.
2) HOLLIS SHALL BE INFORMED IN WRITING OF ANY DISCREPANCIES.
3) ALL DIMENSIONS ARE IN METRES ONLY.
4) THE ORIGIN AND ORIENTATION OF THE SURVEY GRID RELATE TO AN ARBITRARY GRID.
5) ALL LEVELS ARE BASED ON AN ARBITRARY DATUM.

KEY

Proposed

REVISIONS			
REV.	DATE	AMENDMENTS	INITIAL

THIS DRAWING IS FOR THE FOLLOWING PURPOSE ONLY:
PRELIMINARY ☐ TENDER ☐ CONSTRUCTION ☐
SKETCH ☐ BUILDING REGULATIONS ☒ CONTRACT ☐

TITLE
PROPOSED PLAN

CLIENT
CRESCENT REAL ESTATE
3 ALDWYCKS CLOSE
MILTON KEYNES
MK5 6HZ


PROJECT NAME
6 SNOWDON DRIVE
WINTERHILL
MILTON KEYNES
MK6 1BU

HOLLIS
Sovereign Court
211 Witon Gate East
Central Milton Keynes
MK9 2HP



T +44 1908 774 460
W hollisglobal.com

DATE 10.03.2026		DRAWN BY SM	
SCALE 1:100		CHECKED TD	
PROJECT	LINE	ORIGINATOR	VOLUME/ ZONE/REGD
130420	P02	HLS	00
FILE TYPE	DISCIPLINE/ SCL	NUMBER	STATUS
M2	B	10290	S0

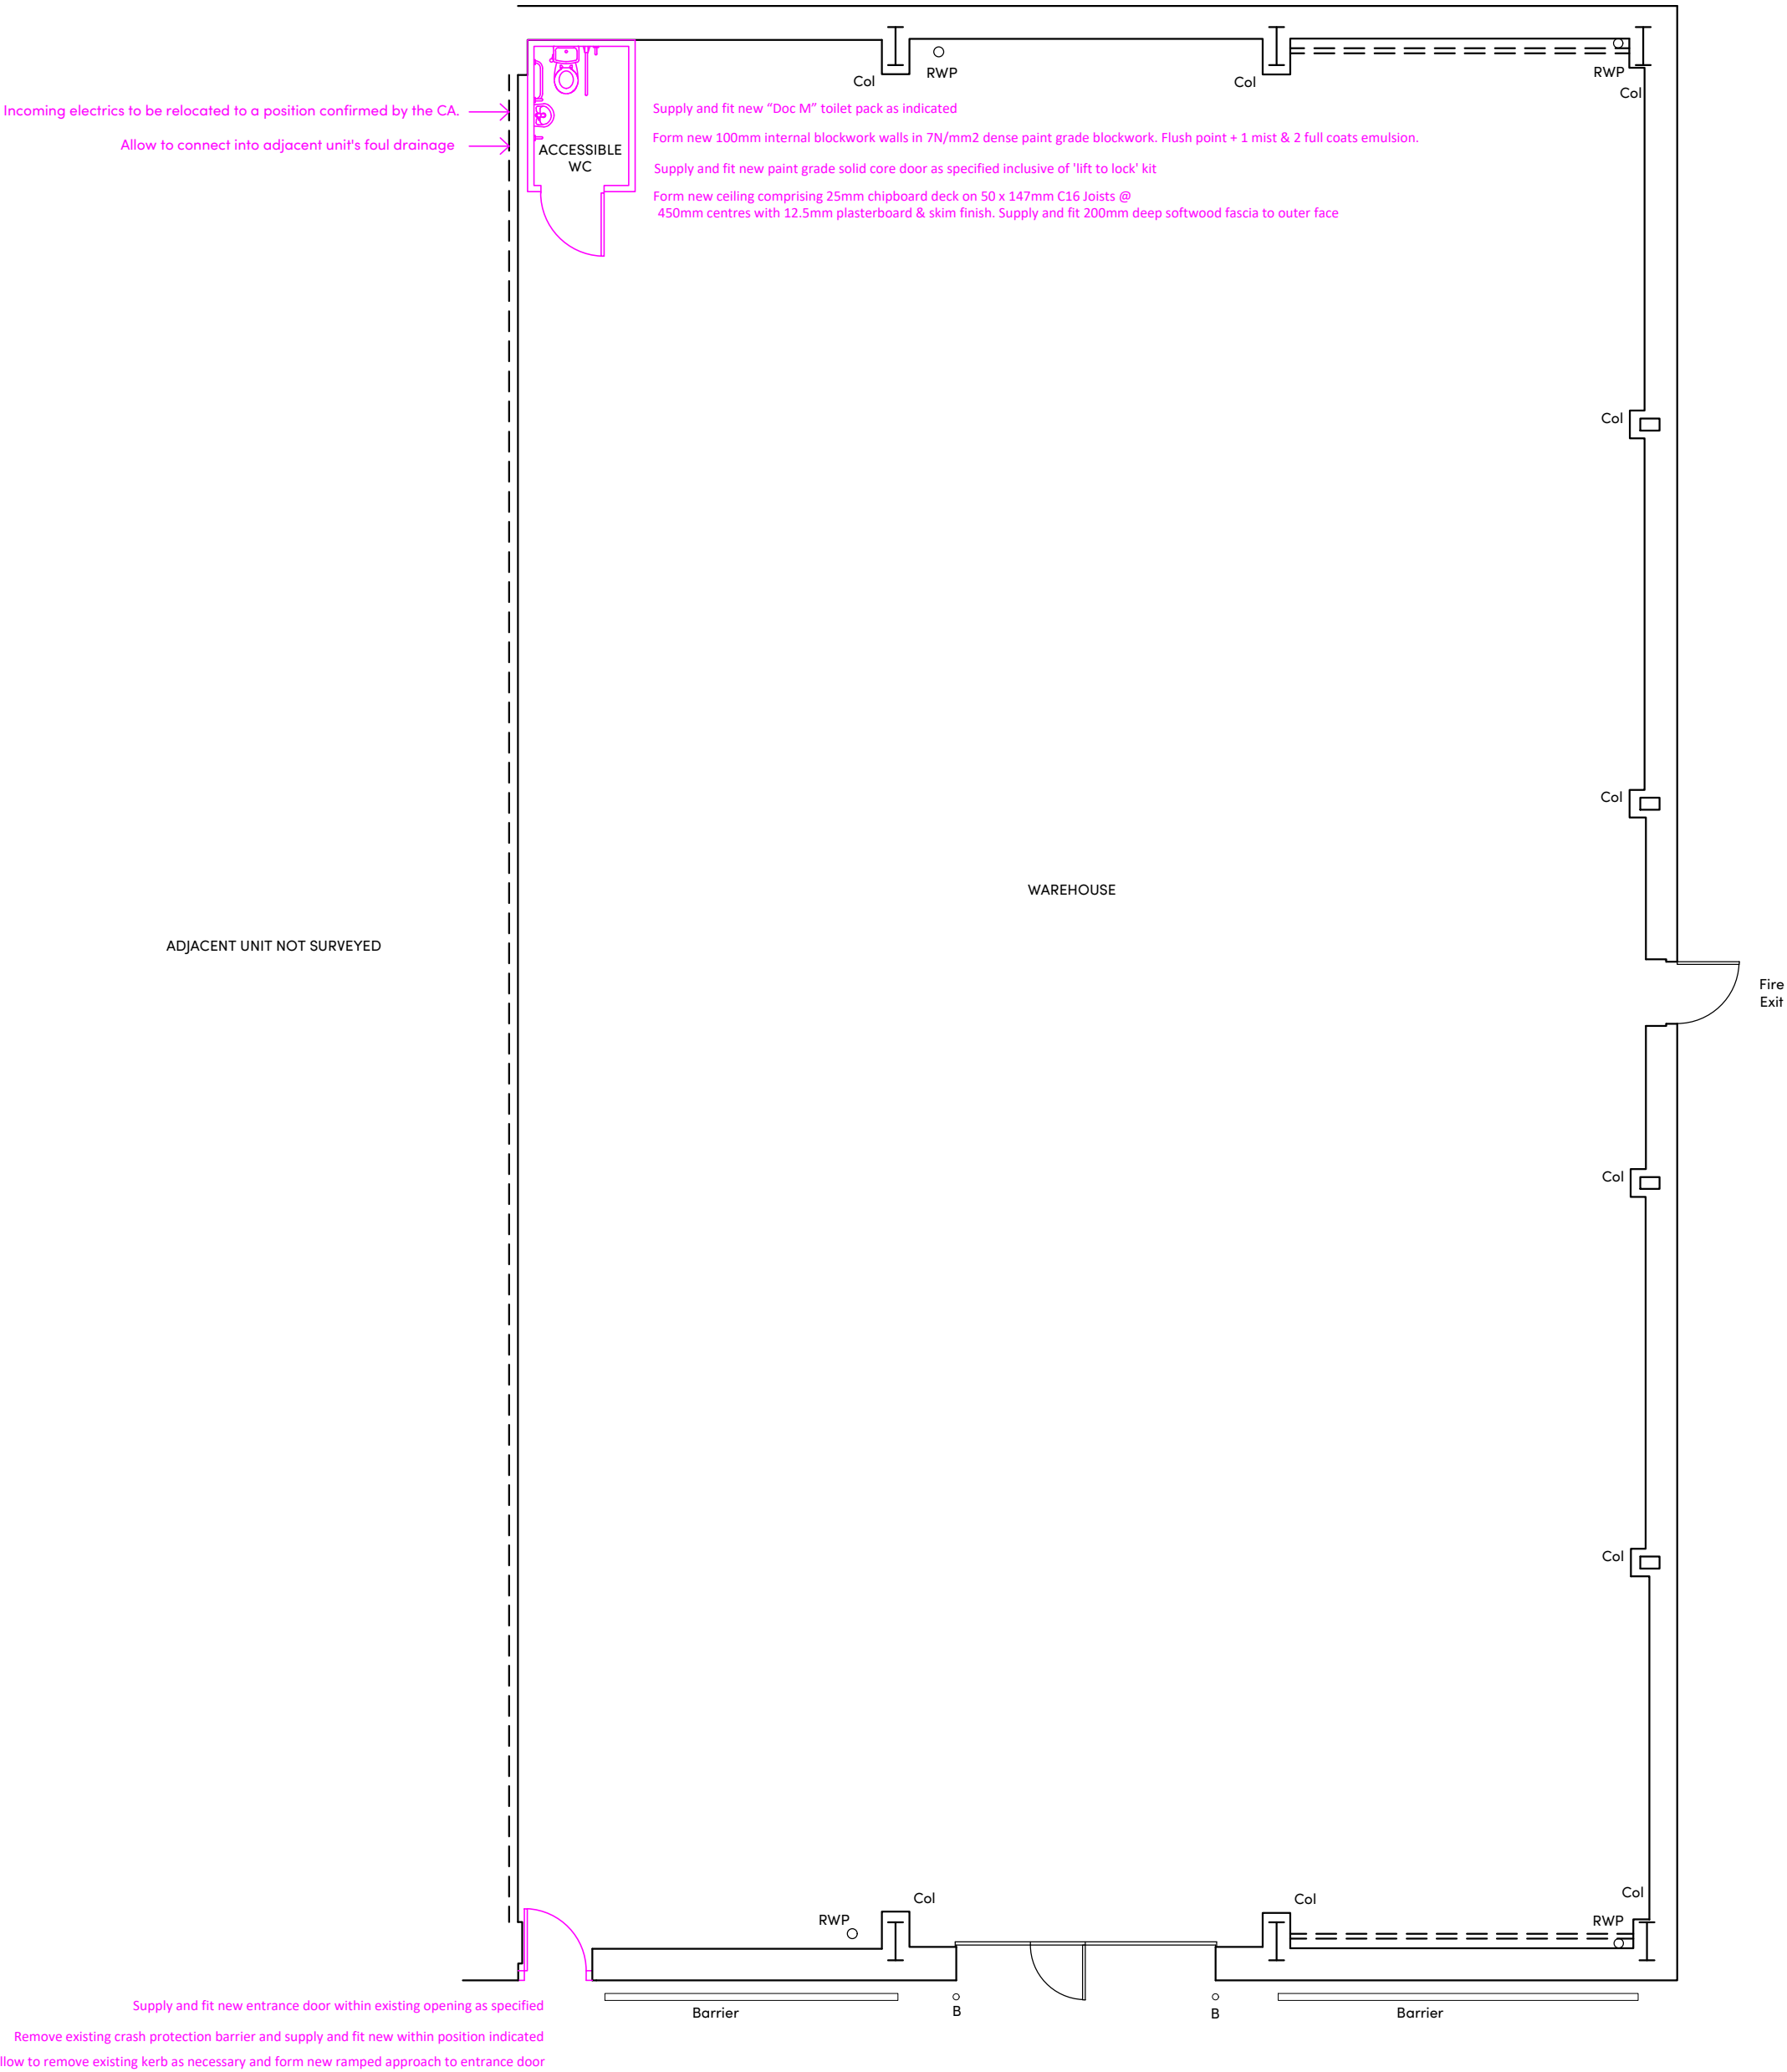

GROUND FLOOR

