


Net Internal Area

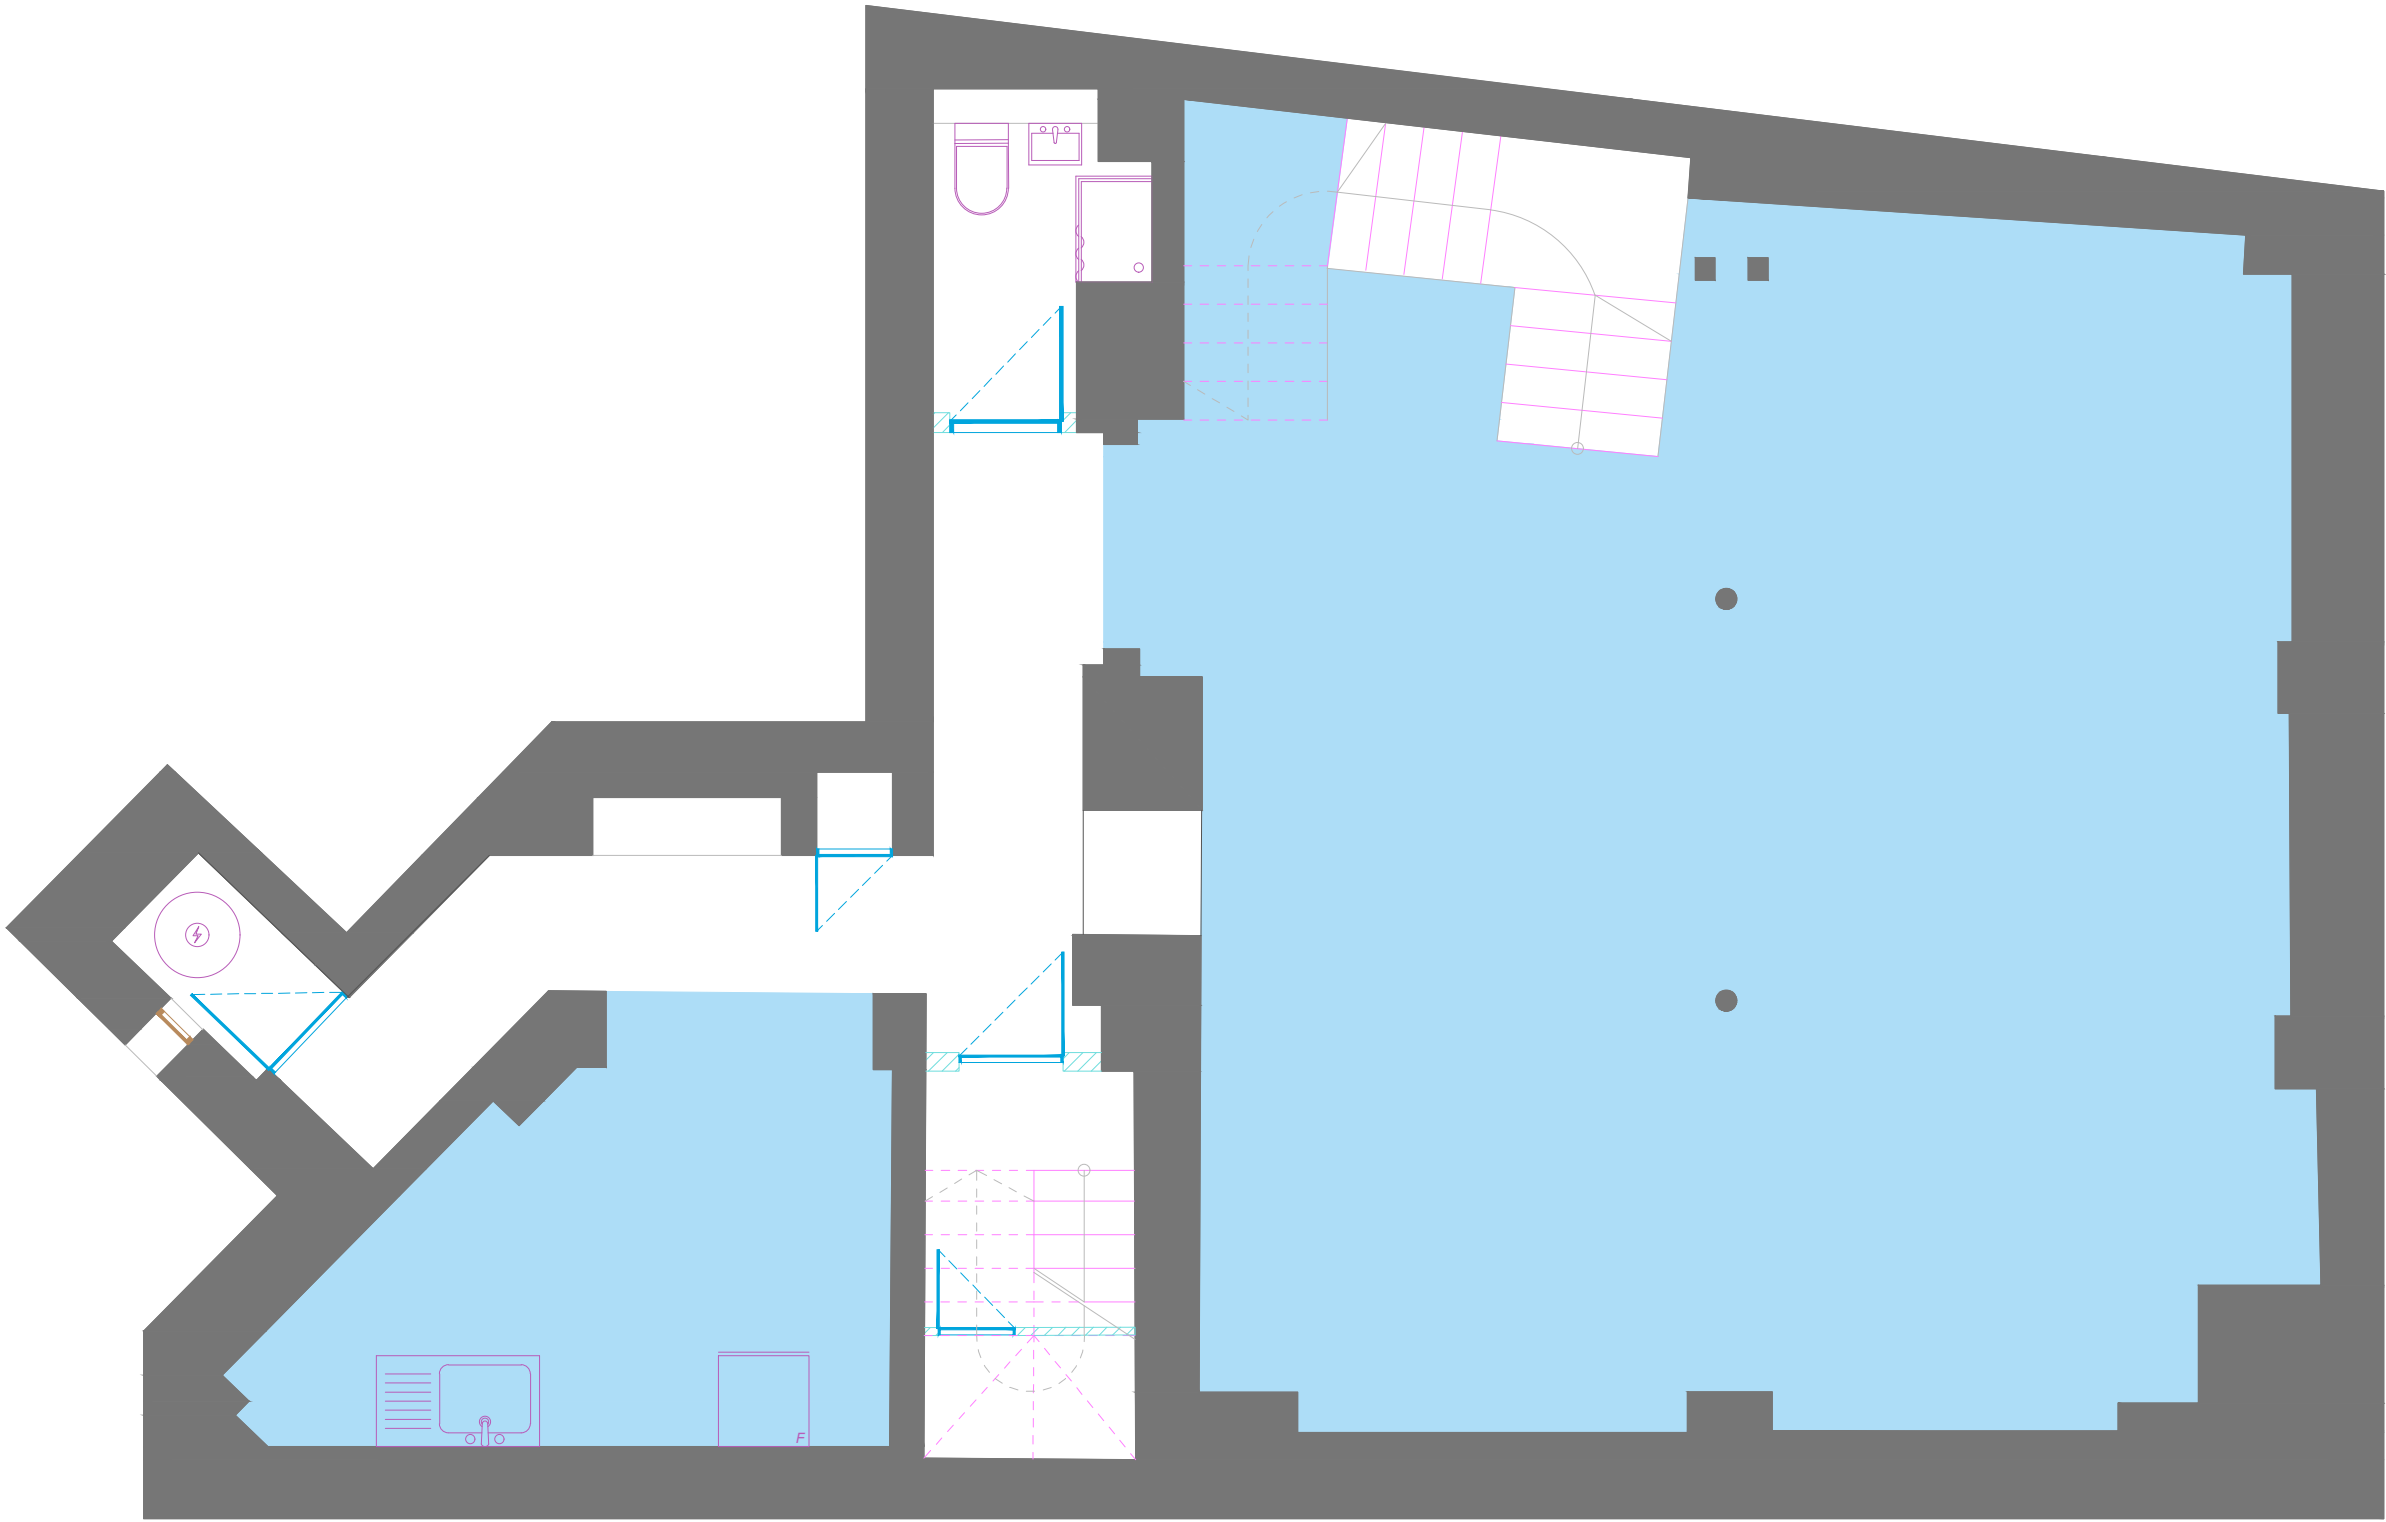

Lower Ground Level

Endell Street

81A Endell Street
London
W2CH 9DX

Drawing Name
Lower Ground Floor Plan

Date	Revision	Project Number	Description	Rev
16/02/2024	00	24.02.2844	Property Survey	0/0

REFERENCE KEY




0m 2.5m
Scale 1:50


sterlingtemple

0203 4639225
www.sterlingtemple.com

Net Internal Area

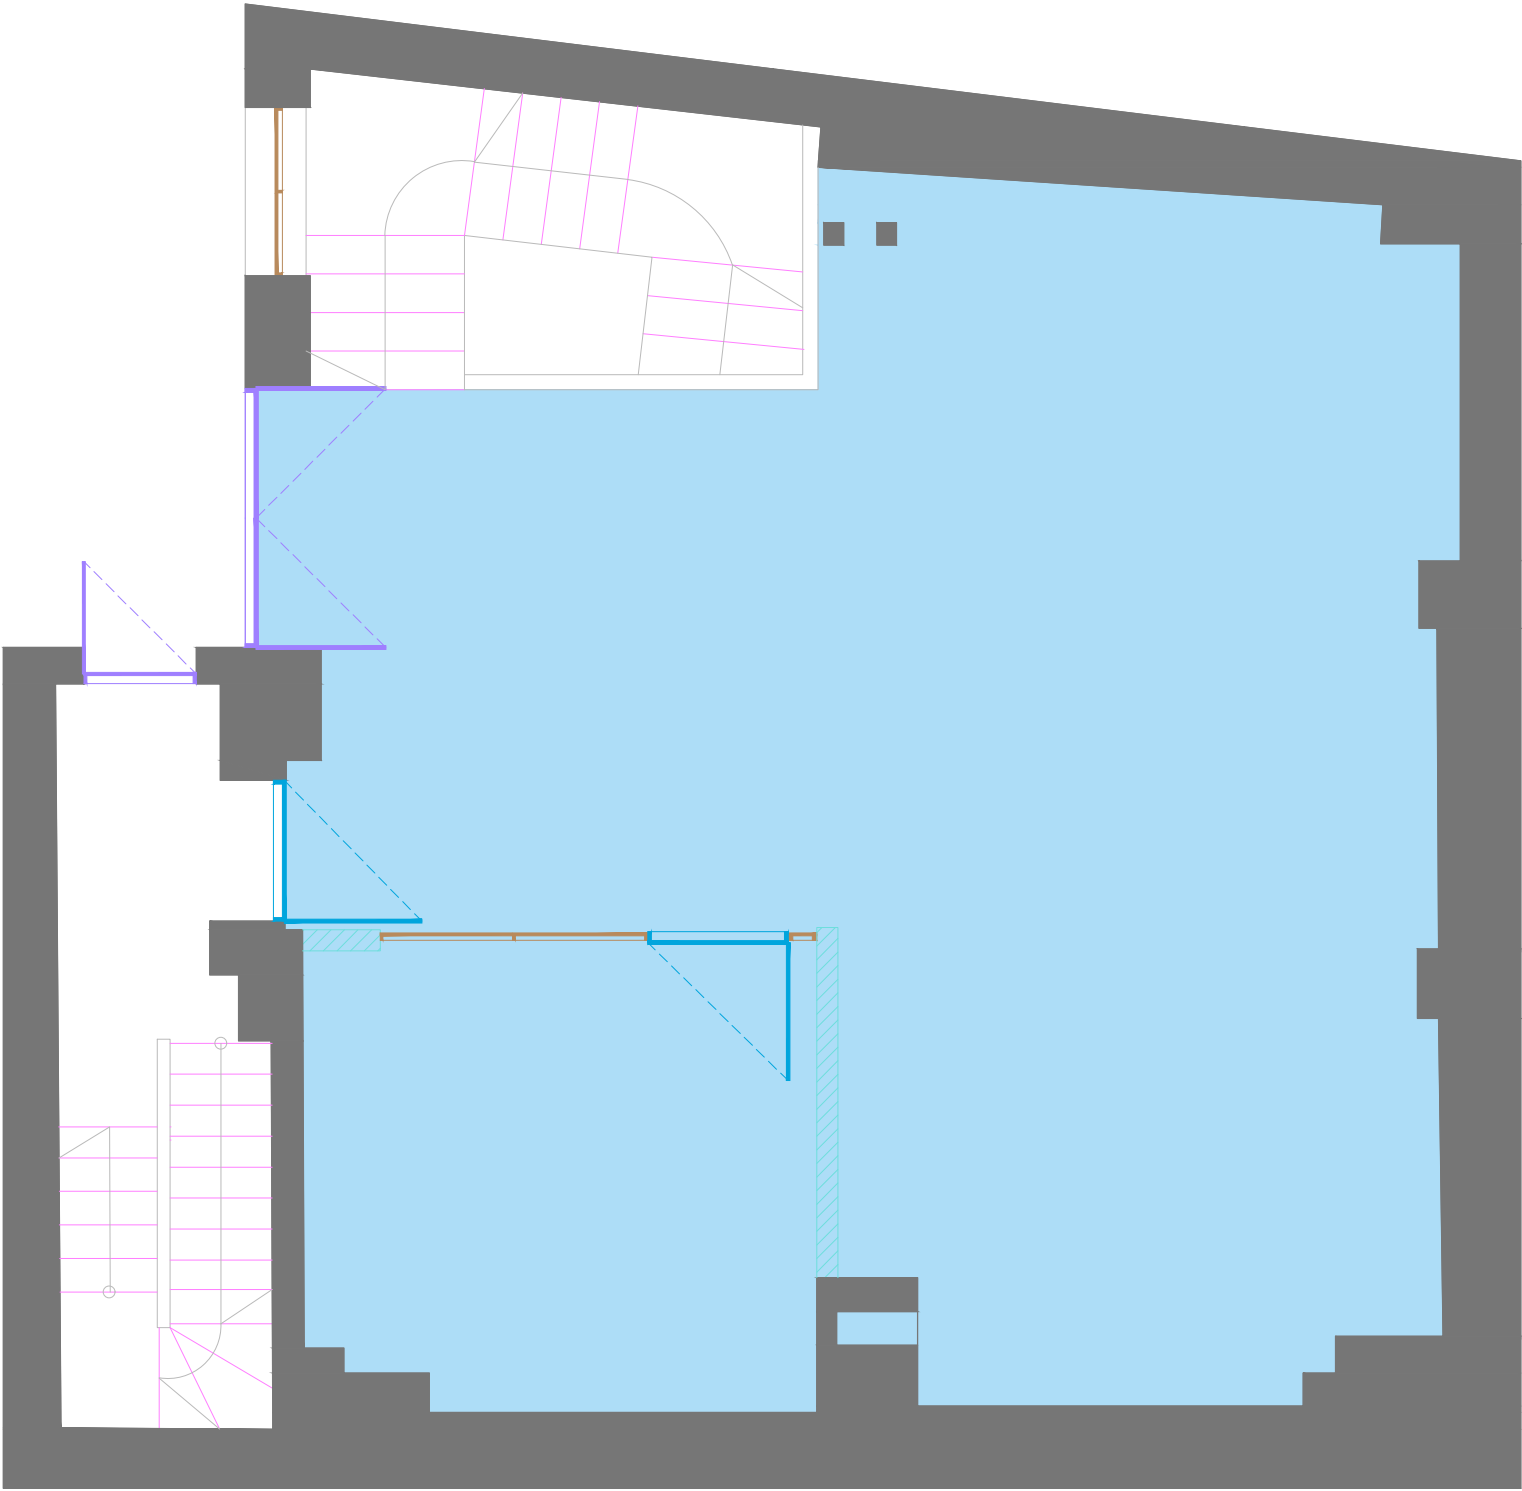

Ground level

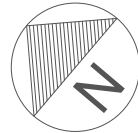

0m 2.5m
Scale 1:50

Endell Street

81A Endell Street
London
W2CH 9DX

Drawing Name
Ground Floor Plan


Date	Revision	Project Number	Description	Rev
16/02/2024	00	24.02.2844	Property Survey	0/0

REFERENCE KEY


sterlingtemple

0203 4639225
www.sterlingtemple.com

Net Internal Area

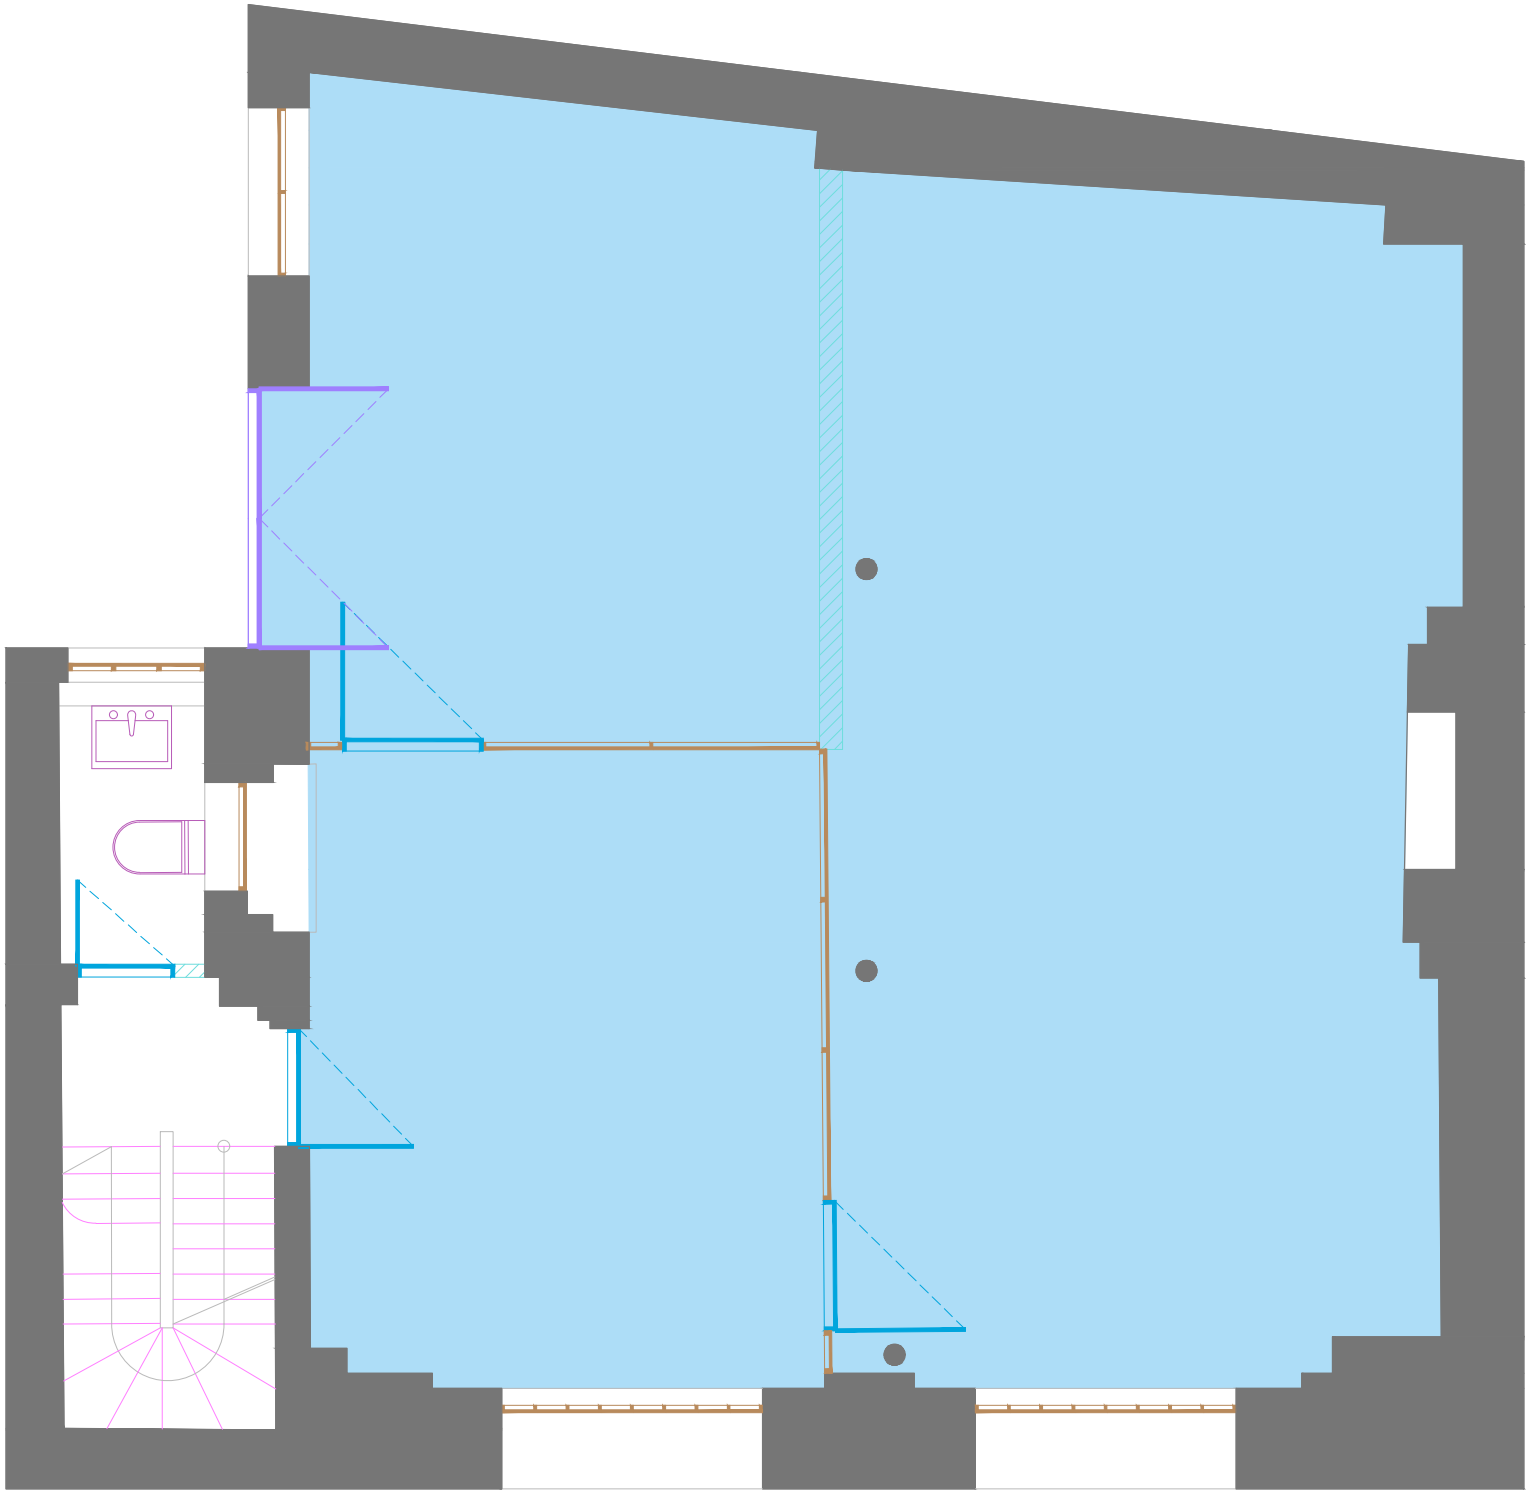

First Level

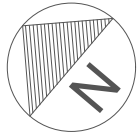

Endell Street

81A Endell Street
London
W2CH 9DX

Drawing Name
First Level Floor Plan


Date	Revision	Project Number	Description	Rev
16/02/2024	00	24.02.2844	Property Survey	0/0

REFERENCE KEY

sterlingtemple

0203 4639225
www.sterlingtemple.com

Net Internal Area

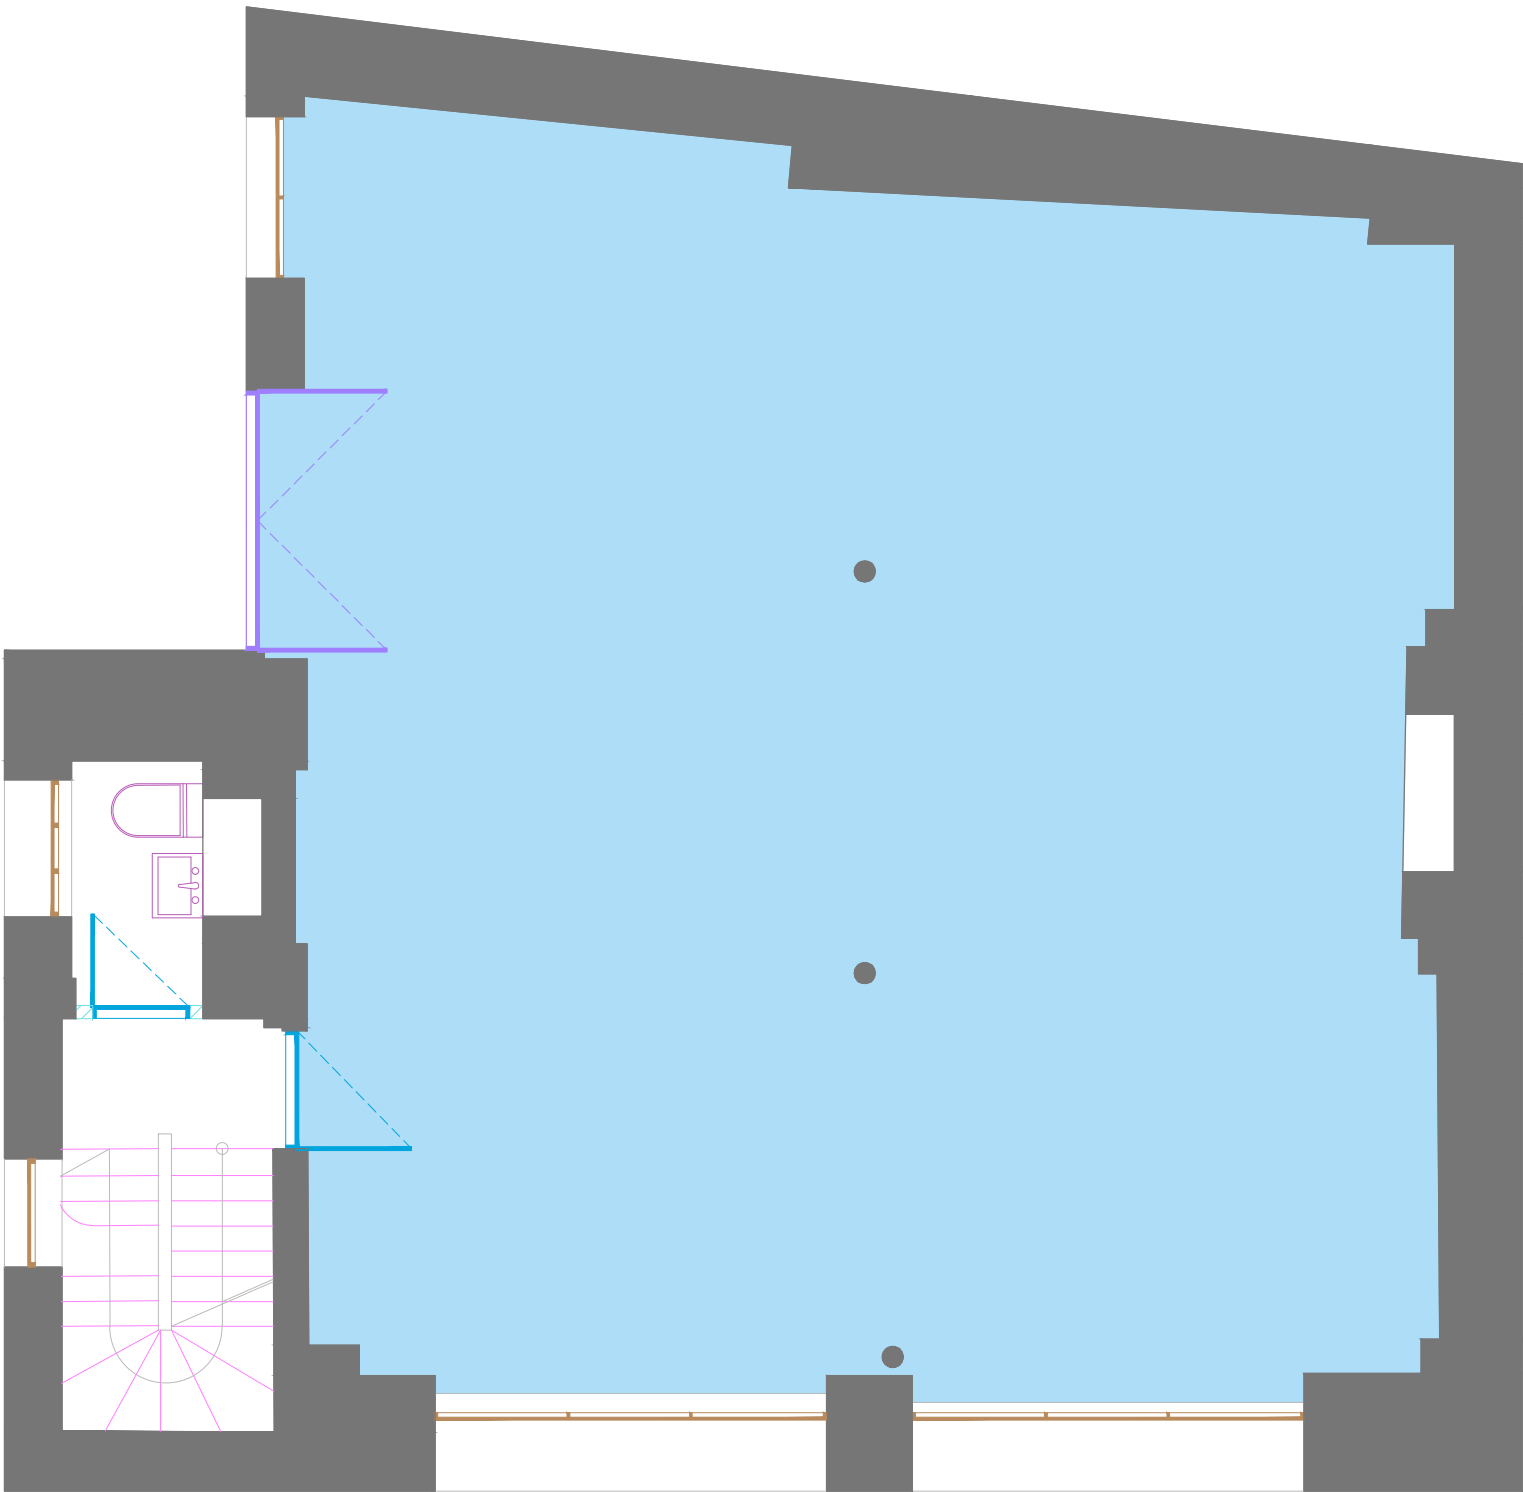

Second Level



0m 2.5m
Scale 1:50

Endell Street

81A Endell Street
London
W2CH 9DX

Drawing Name
Second Level Floor Plan


Date	Revision	Project Number	Description	Rev
16/02/2024	00	24.02.2844	Property Survey	0/0

REFERENCE KEY


sterlingtemple

0203 4639225
www.sterlingtemple.com

Net Internal Area

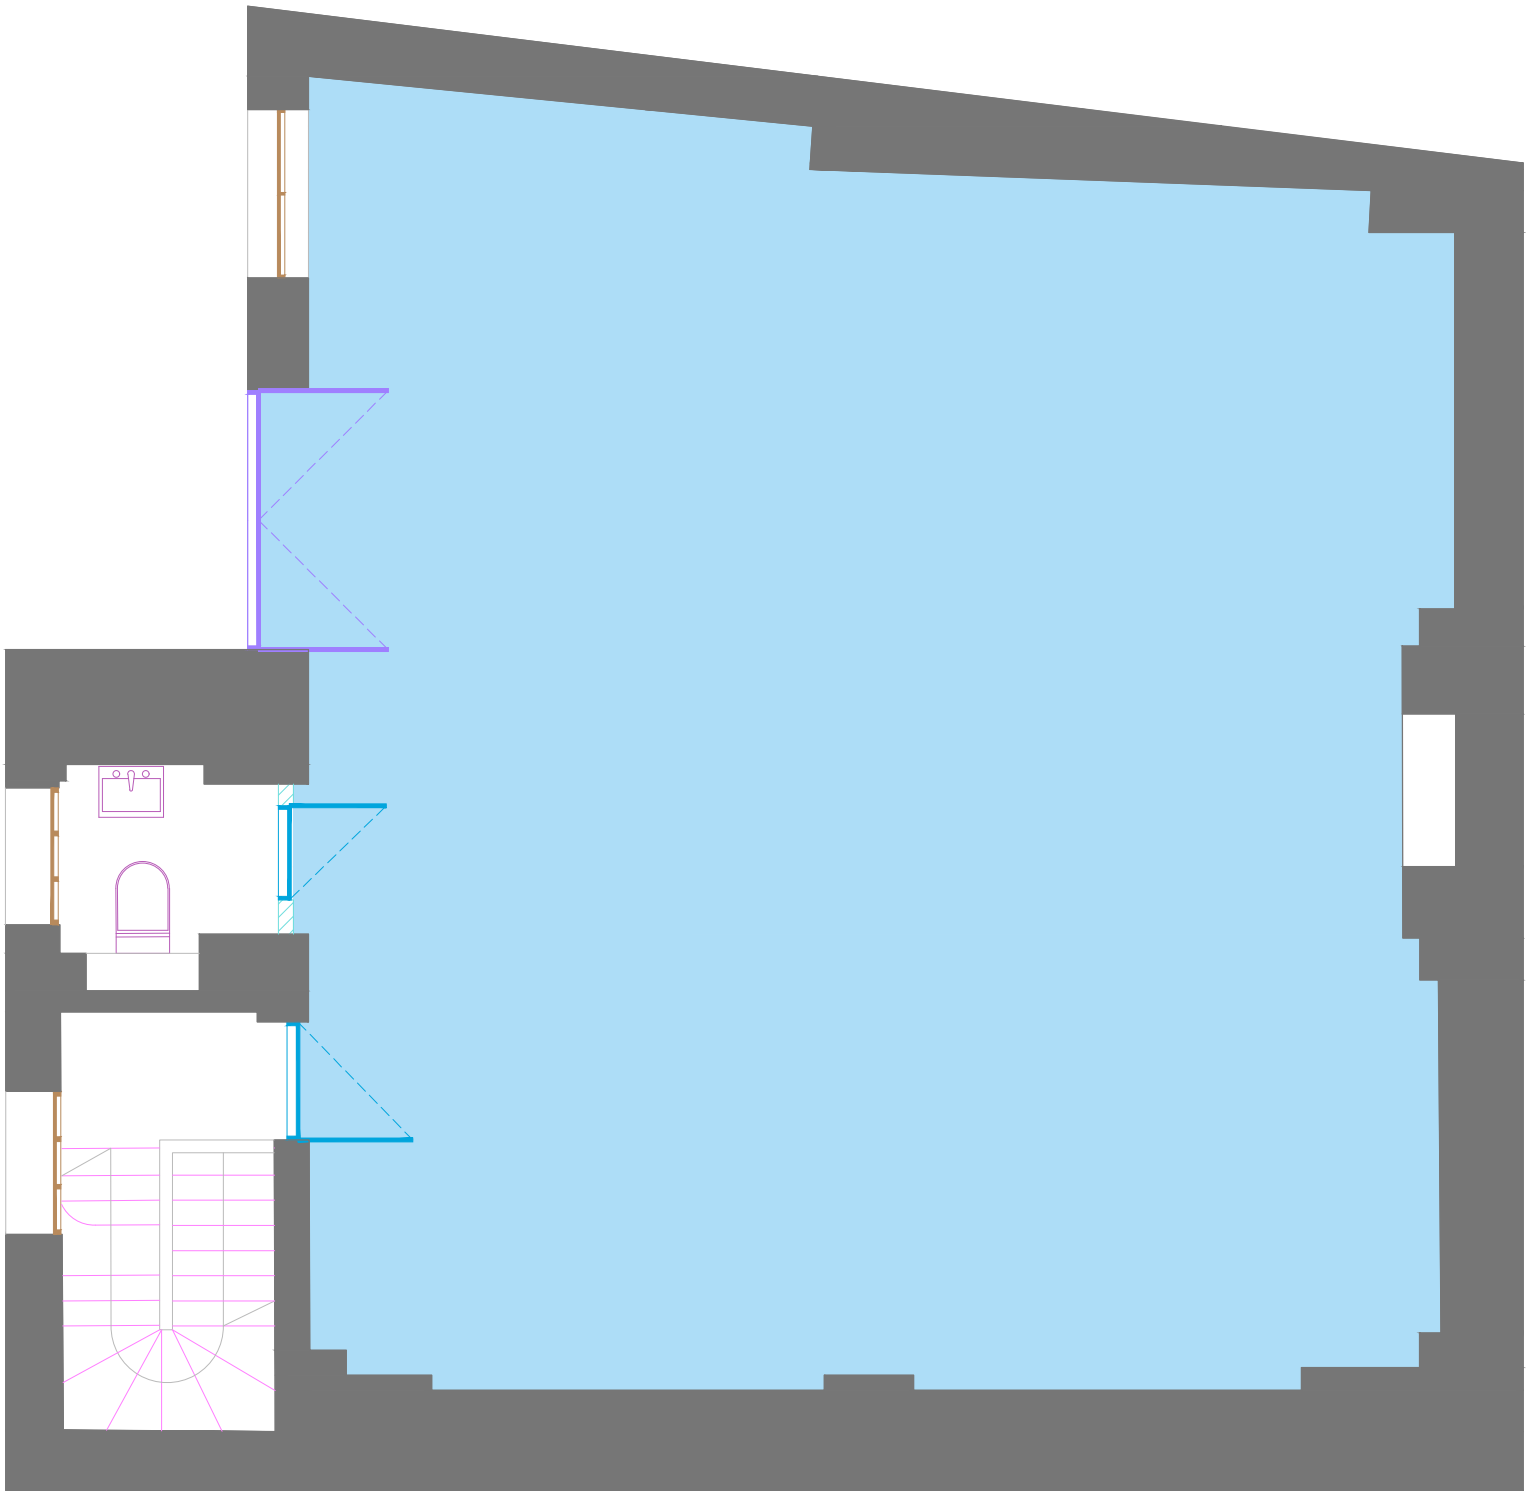

Third Level

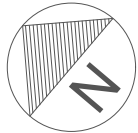

Endell Street

81A Endell Street
London
W2CH 9DX

Drawing Name
Third Level Floor Plan

Date	Revision	Project Number	Description	Rev
16/02/2024	00	24.02.2844	Property Survey	0/0

REFERENCE KEY

sterlingtemple

0203 4639225
www.sterlingtemple.com