
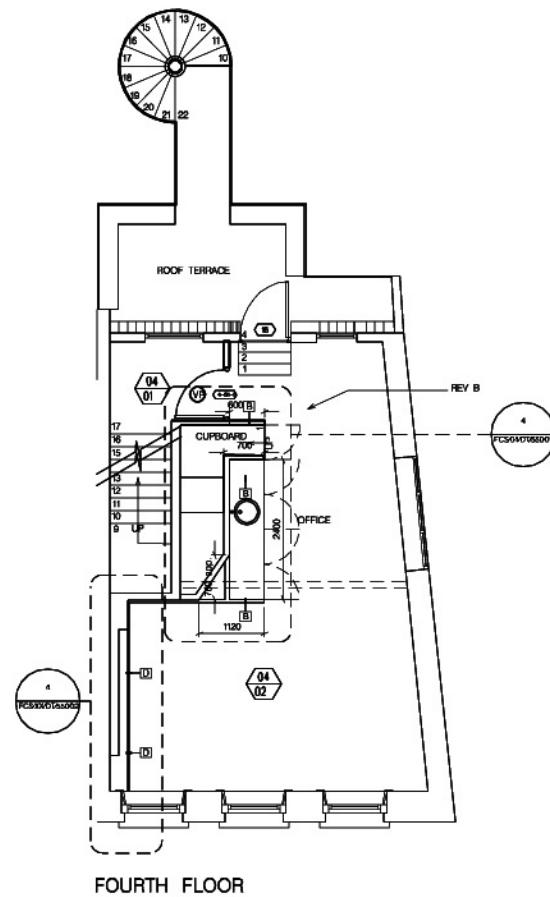


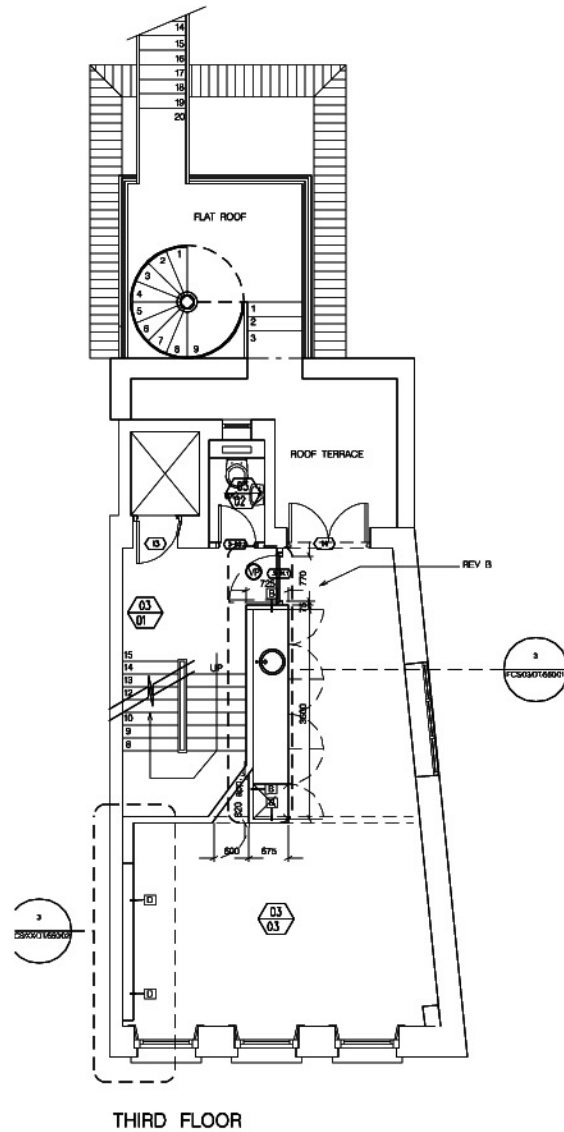

PARTITION KEY:-

- A SINGLE GLAZED PARTITION USING 10MM STRUCTURAL 11MM TOUGHENED GLASS FROM FLUOROPOLYMER FLOOR TO SUSPENDED CEILING. 40mm SOUND FLOOR WITHIN 56 CHANNEL ALL EXPOSED EDGES TO BE POLISHED
- B 30 MINUTES FIRE RATED PARTITION FROM STRUCTURAL FLOOR TO SUSPENDED CEILING TO BE 75mm OVERALL THICKNESS ONE LAYER OF WALLBOARD EACH SIDE OF 40mm STUDS
- C DWARF WALL TO 1500mm HIGH. LAMINATE FINISH TO BOTH SIDES. TO BE FIXED TO TOP OF 40mm STUD WITHIN OTHER FACE USING 2 C-CLIPS OR SPURT BATTENS TO MANUFACTURERS DETAILS. TOP FACE TO BE 4mm STAINLESS STEEL WITH VISIBLE COUNTERSUNK SCREW FRINGS.
- D 10MM PANELED WALL TO VARIOUS HEIGHTS WITH INTEGRATED POWER AND DATA SURF. FIXED USING 2 C-CLIPS OR SPURT BATTENS TO OPEN FRAMEWORK TO MANUFACTURERS DETAILS.
- E DRYWALL CONSTRUCTION FROM STRUCTURAL FLOOR TO UNDERSIDE OF SUSPENDED CEILING TO BE 100mm OVERALL THICKNESS ONE LAYER 12.5mm SOUNDGLAZ WALLBOARD AND INNER LAYER 15MM PLASTER. EACH 40mm METAL STUDS WITH 40mm CAVITY VOID.
- F 60 MINUTE FIRE RATED PARTITION FROM STRUCTURAL FLOOR FINISH TO 500mm ABOVE SUSPENDED CEILING CONSTRUCTED FROM 2 LAYERS WALLBOARD EACH SIDE OF 40mm BOXED STUD TO OVERALL THICKNESS 100mm
- G PANELED WALL WITH APPLIED MAGNETIC WALL FINISH FRAMEWORK TO LEVEL OF EXISTING BOILING OUT

GENERAL NOTES:-

1. ALL INFORMATION CONTAINED WITHIN THIS DRAWING IS TO BE CHECKED ON SITE PRIOR TO COMMENCING WORK.
2. SUSPENDED CEILING GENERALLY AS EXISTING ALL NEW WORKS AS INDICATED ON CEILING DRAWINGS AND DETAILS.
3. ALL ROOMS USED AS OFFICES UNLESS OTHERWISE STATED.
4. ALL AREAS PROVIDED WITH ESCAPE LIGHTING WHERE REQUIRED, TO B.S.5266, PART 1.

SYMBOLS:—

- NEW DOOR WITH 30 MINUTE FIRE RATING AND SELF CLOSING DEVICE TO B.S.689 PART 1**
REF: HOWDENS JOINERY F30 F303
44mm THICK 2040x725mm OR TO FIT EXISTING FRAME
- 30 MINUTE FIRE DOOR WITH SELF CLOSING DEVICE, WITH CLEAR GLASS VISION PANEL AT EYE LEVEL**
TO B.S.689 PART 1
REF: HOWDENS JOINERY F30 F303
44MM THICK 2040x725mm OR TO FIT EXISTING FRAME
- NEW DOOR TO EXISTING FRAME**
REF: HOWDENS PLYWOOD LIPPED
40mm THICK 2040x725mm OR TO FIT EXISTING FRAME

-  EXISTING DOORSET TO BE RETAINED
 NEW DOORSET
 ROOM NUMBER

Client

FRESH CREATIVE
SERVICES LTD

Project

97 CHARLOTTE STREET
LONDON W1

Title

PARTITION LAYOUT
LEVELS THREE AND FOUR

Scale

1:50

Date
09.01.03

Drawing No.

Revision

FRESH/CS03/GA/400

B

Drawn by

Checked by _____

CAD file reference

XXga40003.shT