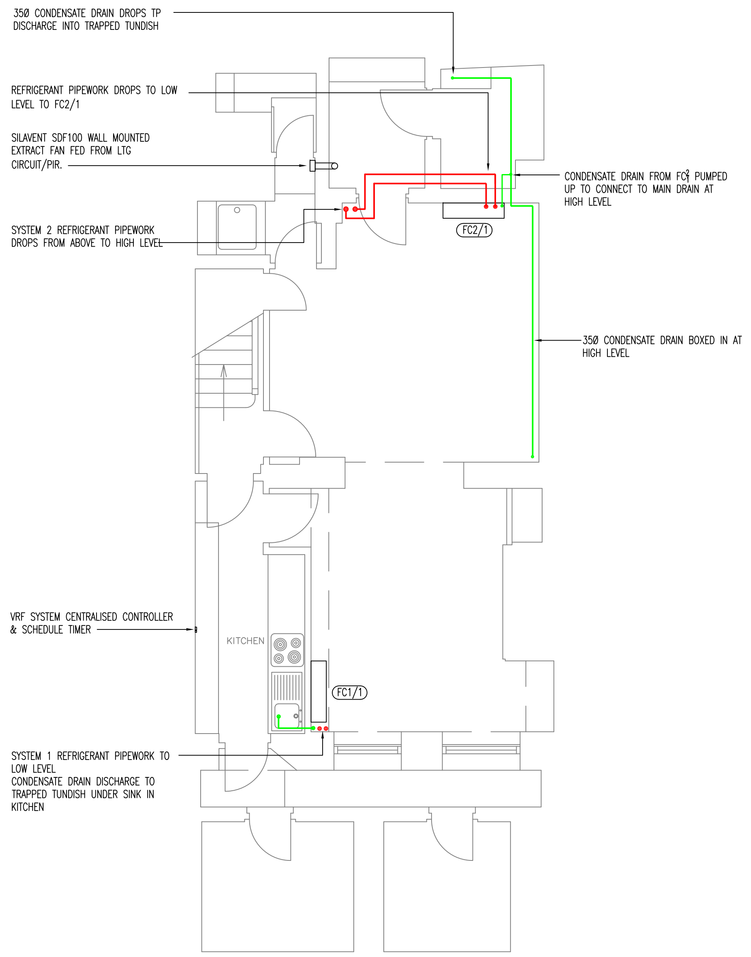

BASEMENT FLOOR PLAN

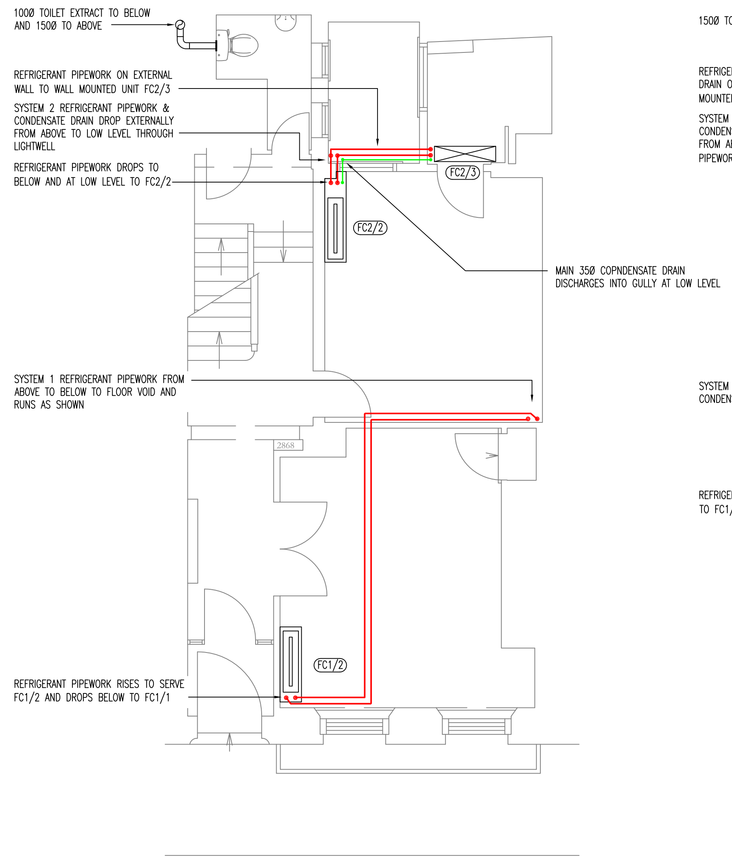

GROUND FLOOR PLAN

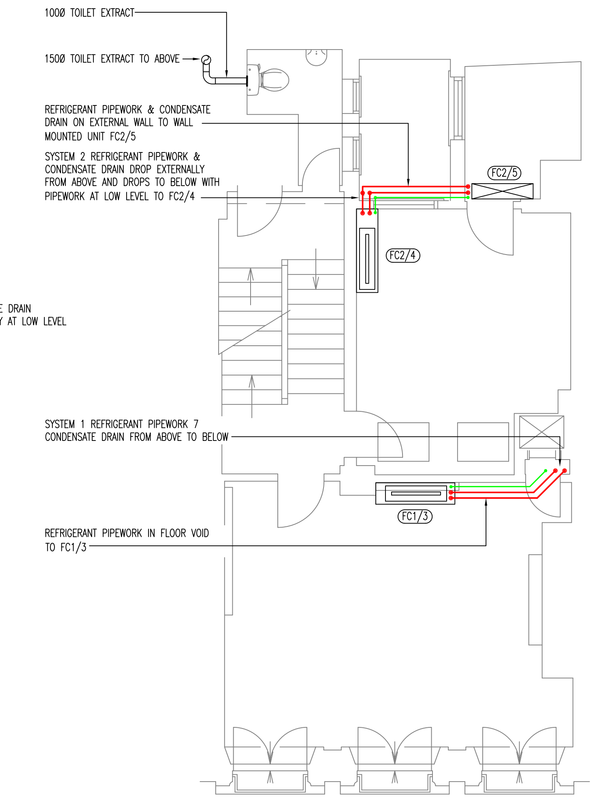

1ST FLOOR PLAN

revisions

	AS INSTALLED	TD	21/08/14

SYSTEM 1						
REF	LOCATION	MODEL	COOLING	HEATING	FAN COIL UNIT TYPE	CONDENSING UNIT
FC1/1	BASEMENT FRONT OFFICE	S-22MR1E5	2200W	2500W	FLOOR STANDING	U-6LE1E8
FC1/2	GROUND FLOOR FRONT OFFICE	S-28MR1E5	2800W	3200W	CONCEALED FLOOR	
FC1/3	FIRST FLOOR FRONT OFFICE	S-45MR1E5	4500W	5000W	CONCEALED FLOOR	
FC1/4	SECOND FLOOR FRONT OFFICE	S-36MR1E5	3600W	4200W	CONCEALED FLOOR	
FC1/5	THIRD FLOOR FRONT OFFICE	S-36MR1E5	3600W	4200W	CONCEALED FLOOR	
FC1/6	FOURTH FLOOR FRONT OFFICE	S-28MR1E5	2800W	3200W	CONCEALED FLOOR	

SYSTEM 2						
REF	LOCATION	MODEL	COOLING	HEATING	FAN COIL UNIT TYPE	
FC2/1	BASEMENT REAR OFFICE	S-22MR1E5	2200W	2500W	FLOOR STANDING	
FC2/2	GROUND FLOOR REAR OFFICE 1	S-22MR1E5	2200W	2500W	CONCEALED FLOOR	
FC2/3	GROUND FLOOR REAR OFFICE 2	S-22MK1E5	2200W	2500W	WALL MOUNTED	
FC2/4	FIRST FLOOR REAR OFFICE 1	S-22MR1E5	2200W	2500W	CONCEALED FLOOR	
FC2/5	FIRST FLOOR REAR OFFICE 2	S-22MK1E5	2200W	2500W	WALL MOUNTED	U-6LE1E8
FC2/6	SECOND FLOOR REAR OFFICE 1	S-22MR1E5	2200W	2500W	CONCEALED FLOOR	
FC2/7	SECOND FLOOR REAR OFFICE 2	S-22MK1E5	2200W	2500W	WALL MOUNTED	
FC2/8	THIRD FLOOR REAR OFFICE 1	S-22MR1E5	2200W	2500W	CONCEALED FLOOR	
FC2/9	FOURTH FLOOR REAR OFFICE 1	S-22MR1E5	2200W	2500W	CONCEALED FLOOR	

EACH INDOOR FAN COIL UNIT IS CONTROLLED BY A CZ-RTC2 WIRED REMOTE CONTROLLER WHICH IS LOCALLY POSITIONED
IN ADDITION A CZ-64ESMC2 CENTRALISED CONTROLLER AND A CZ-ESWC2 SCHEDULE TIMER ARE POSITIONED WITHIN THE BASEMENT ELECTRICAL CUPBOARD

LEGEND

- FAN COIL IN ARCHITECTURAL CASING
- FLOOR MOUNTED CASED FAN COIL
- WALL MOUNTED ABOVE DOOR HEAD FAN COIL

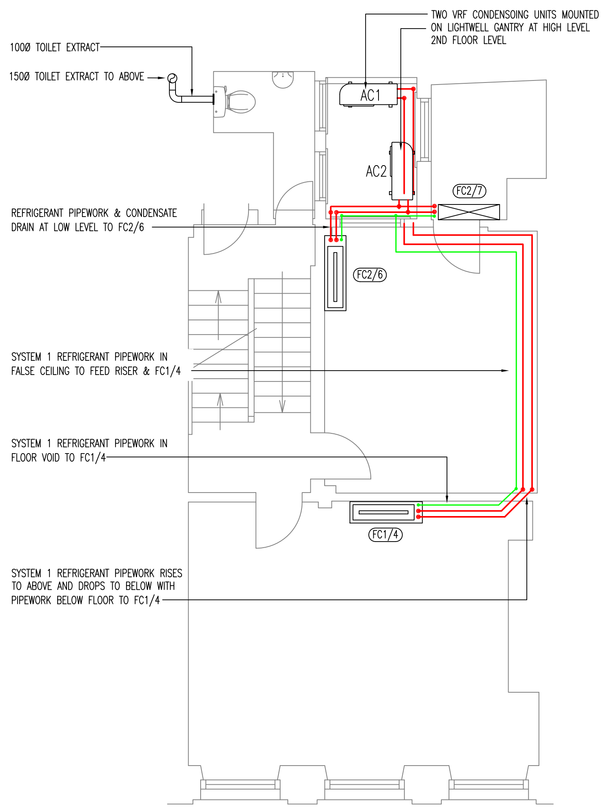

2ND FLOOR PLAN

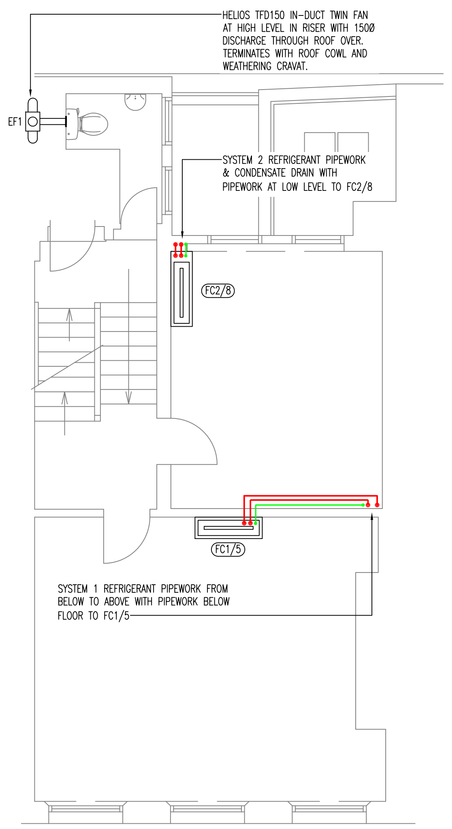

3RD FLOOR PLAN

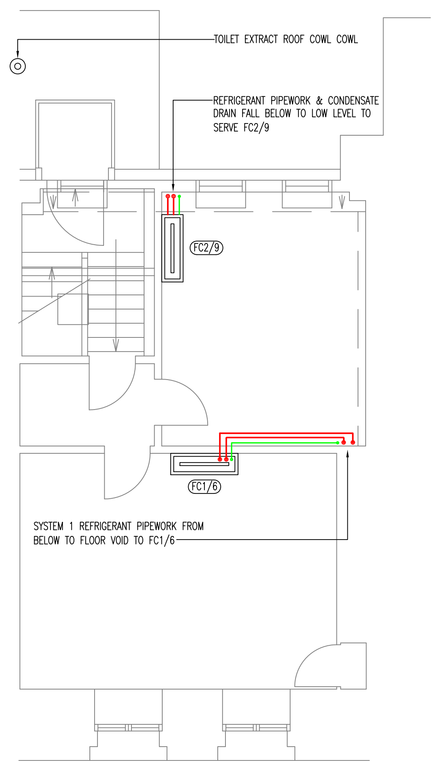

4TH FLOOR PLAN

AS INSTALLED

MSS

SPACE 200 LTD

8 ST JAMES'S PLACE
LONDON
SW1A 1NP

AIR-CONDITIONING & TOILET VENTILATION SERVICES

1:50 @ A0

MSS/1031/001

Mechanical Services Solutions Ltd
Quarry Mews
South Street
Dorking
Surrey RH4 2JX
tel: 01306 741144
fax: 01306 741155