


FIRE SAFETY NOTE

59 PEOPLE MAXIMUM
OCCUPANCY LIMIT PER FLOOR
(10 sq m per person)

ACCOMMODATION SCHEDULE		QTY
Fixed Desk Positions (1200 x 800mm)		54
Total Occupancy		54
Occupancy Ratio	1 person per	11 sq m


Occupancy & density calculations above exclude meeting rooms, quiet zones & collaboration areas - these are intended for internal use only

ROOM SCHEDULE	QTY
Quiet Working Zone	1
Agile Work Points	20
Phone Booths	2
Teapoint	1
Lounge	1
Breakout	3
Meeting Room (3-4 Seat)	1
Meeting Room (5-6 Seat)	3
Meeting Room (8-10 Seat)	1
Wellness Room	0
Store	1
Comms Room	1

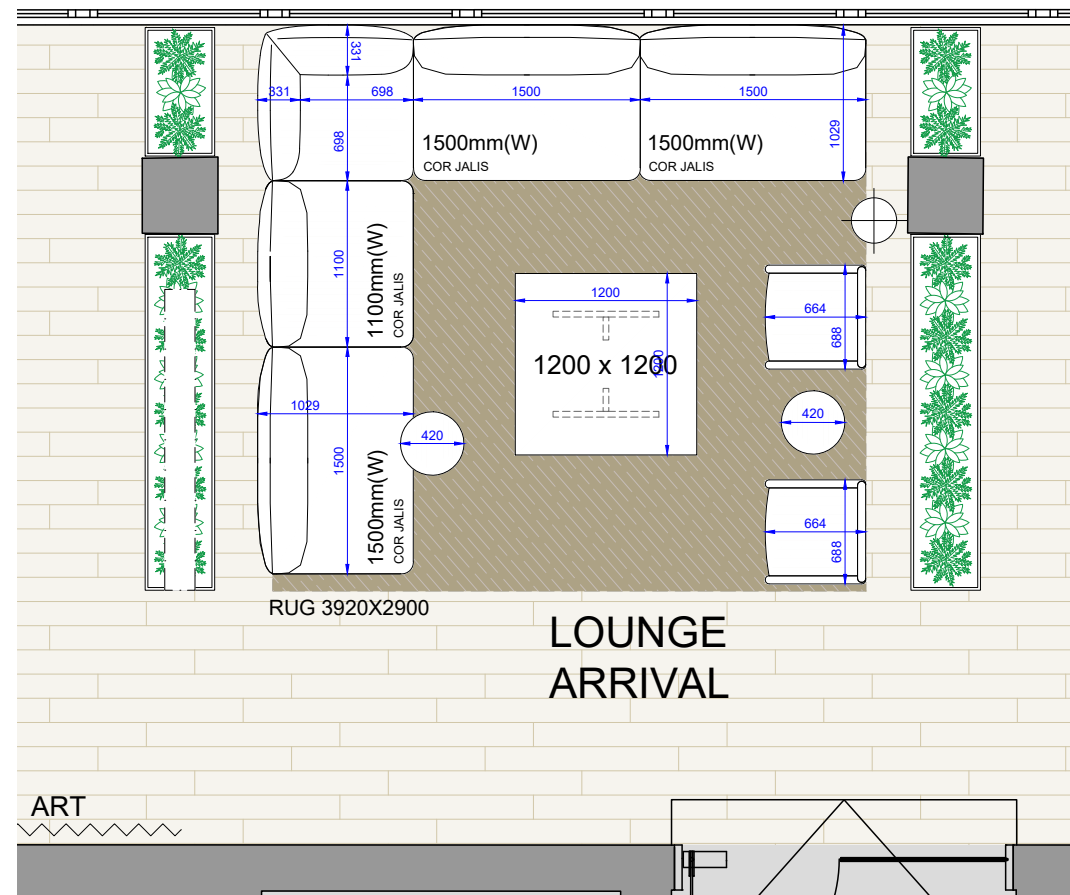


A DEMISE A - LOUNGE ARRIVAL

102 SCALE 1:50 @ A1

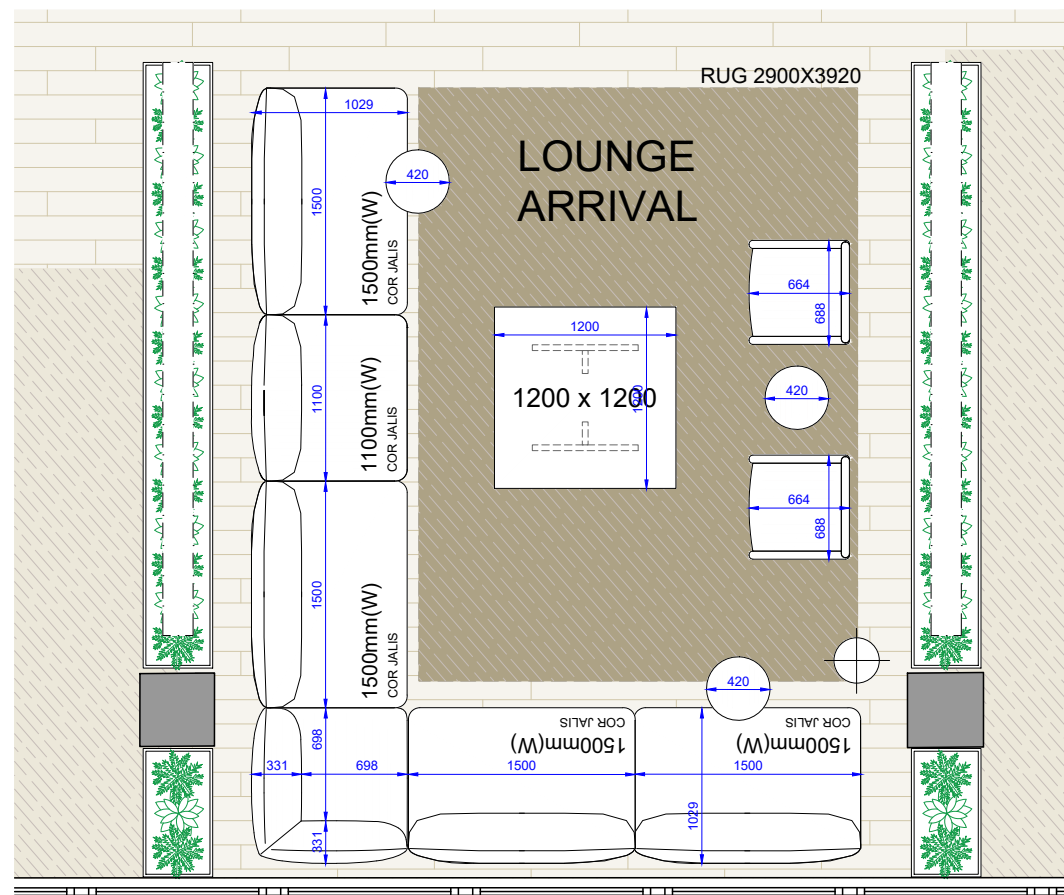


B DEMISE B - LOUNGE ARRIVAL
102 SCALE 1:50 @ A1

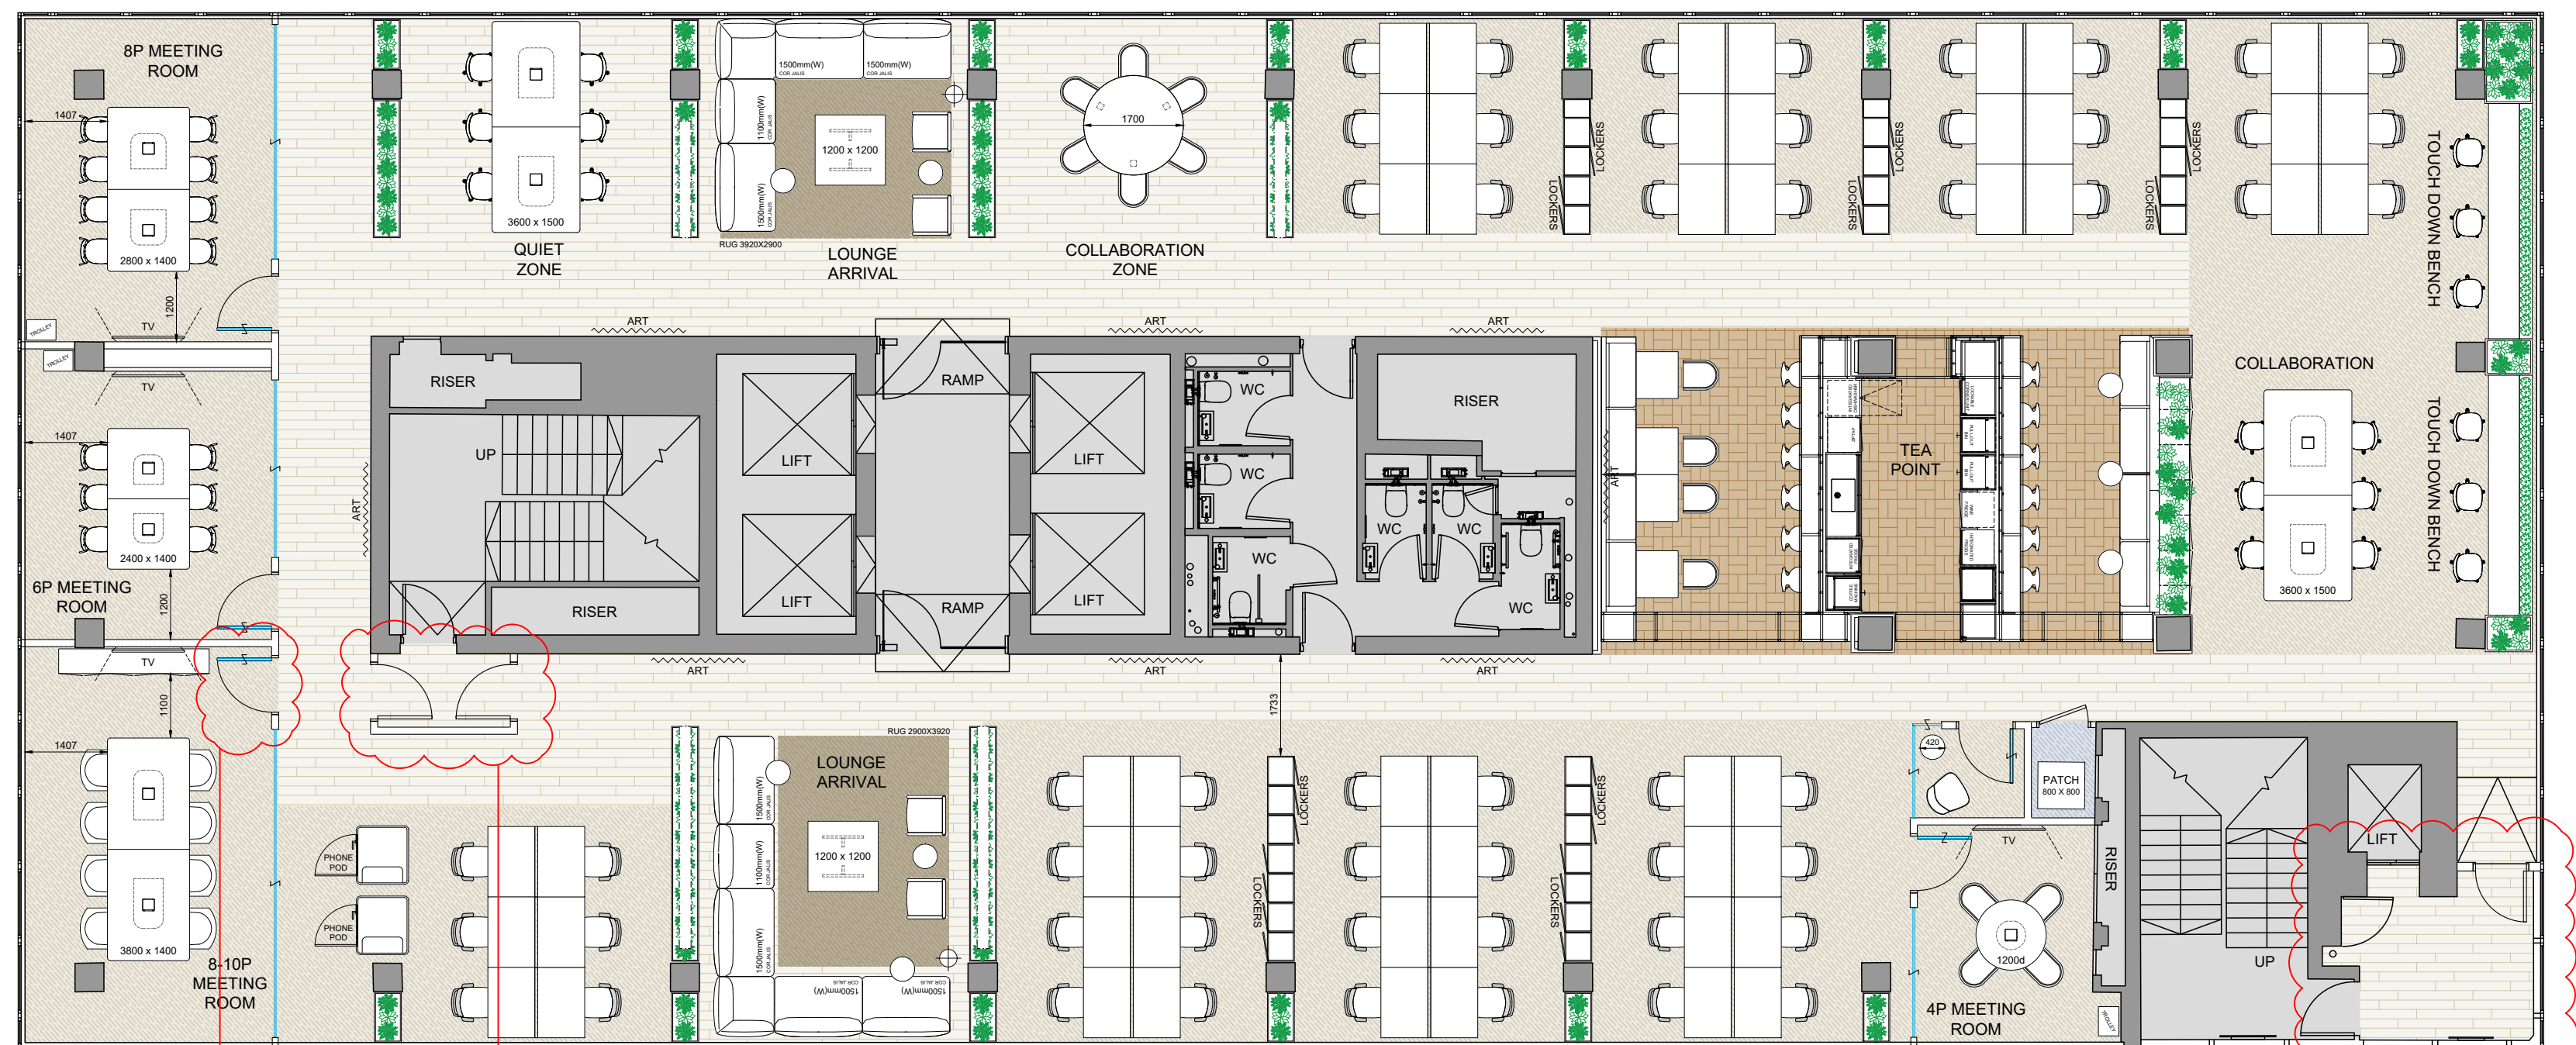

C5
ADJUSTED DOOR POSITION

C4
POST CONTRACT VARIATION
NOT YET INSTRUCTED
NEW PROTECTED STAIR LOBBY.
TIMBER FLOOR FINISH TO CONTINUE INTO PROTECTED STAIR LOBBY.

C4
POST CONTRACT VARIATION
NOT YET INSTRUCTED
PROTECTED STAIR LOBBY MADE GOOD WITH NEW
PARTITIONING & DOOR.
TIMBER FLOOR FINISH TO CONTINUE INTO PROTECTED
STAIR LOBBY.

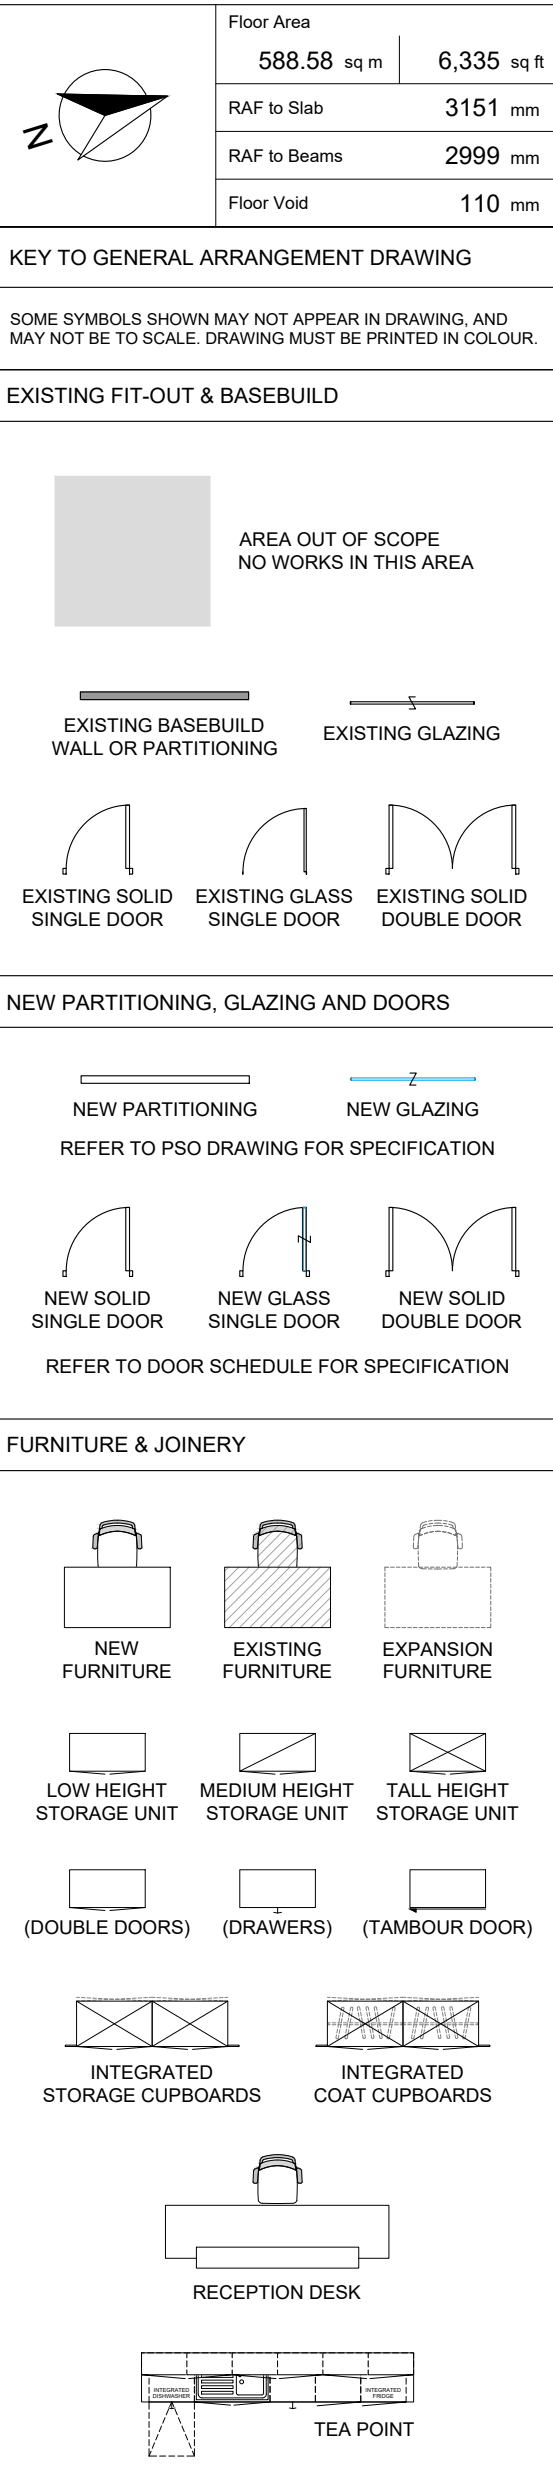

C6	PARTITION NIBS AMENDED	HW	ASD	05.12.24
C5	ADJUSTED DOOR POSITION	HW	ASD	25.11.24
C4	NEW PROTECTED STAIR LOBBIES	HW	ASD	18.11.24
C3	DRAWING UPDATED	HW	ASD	12.11.24
C2	PLANTERS UPDATED	HW	ASD	01.11.24
C1	FIRST ISSUE FOR CONSTRUCTION	HW	ASD	14.10.24
REV	DESCRIPTION	BY	QC	DATE

CONSTRUCTION

Morgan Lovell

morganlovell.com
contact@morganlovell.com
020 7734 4466
16 Noel Street, London, W1F 8DA

Project

Site Address
CITY TOWER
40 BASINGHALL STREET
LONDON, EC2V 5DE

Drawing Title

NINTH FLOOR
GENERAL ARRANGEMENT

Drawing Scale	Drawing Date	BY	QC
1:100 @ A1	05.08.24	HW	ASD

Drawing Number			ML5946-09.dwg
Project No.	Floor	Series	Rev
ML5946	09	102	C6

NINTH FLOOR - GENERAL ARRANGEMENT

