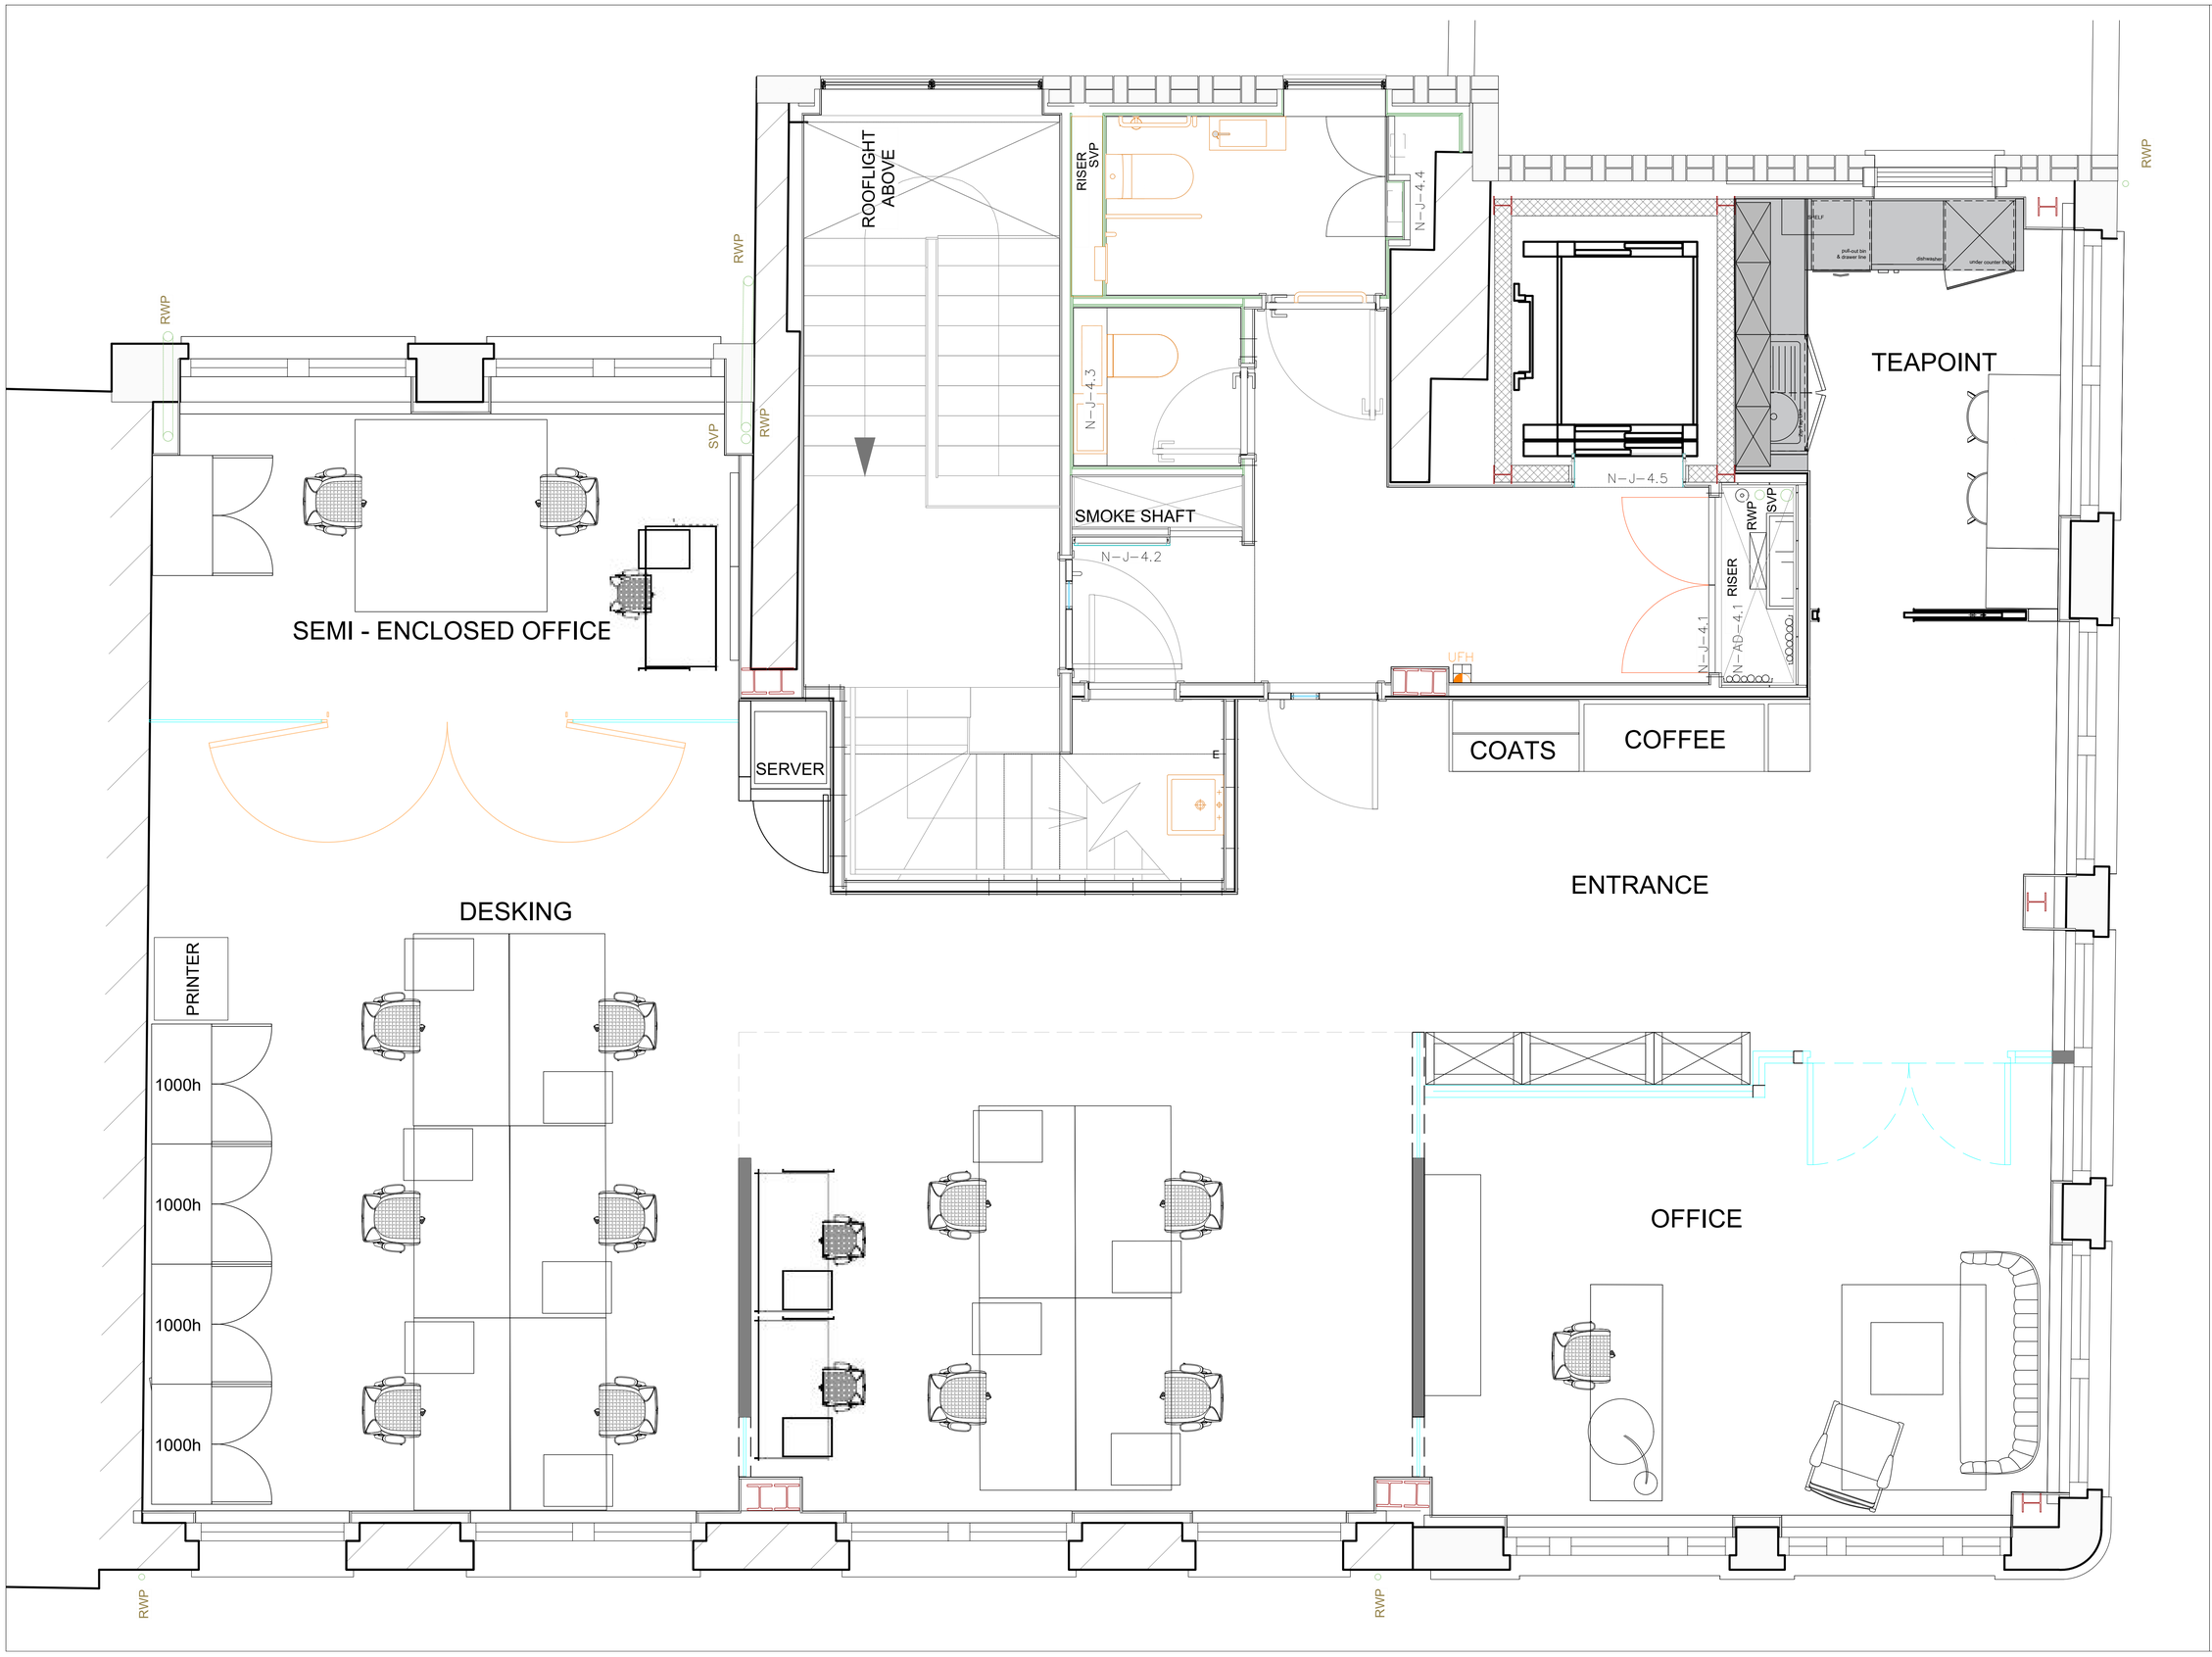

DO NOT SCALE FROM THIS DRAWING

All dimensions to be verified on site any discrepancies are to be reported in Estilo Interiors before proceeding with work.

All area dimensions are approximate and can only be verified by a detailed survey. Any decisions to be made on the basis of area information shown on this drawing should include allowances for increases and decreases inherent in the design and building process

NOTES:

REV	DESCRIPTION	DATE	DRAWN / CHECK

CLIENT
ESO CAPITAL - MATTER REAL ESTATE

SITE ADDRESS
FOURTH FLOOR
BERWICK WORKS
BERWICK ST, LONDON

ESTILO

DRAWING TITLE
MATTER REAL ESTATE
LEVEL 4
GENERAL ARRANGEMENT

STATUS
AS BUILT

SCALE@A1	DATE	AUTHOR
1:25	05-05-23	AM

DRAWING NUMBER	REV
1930-04-110	/