


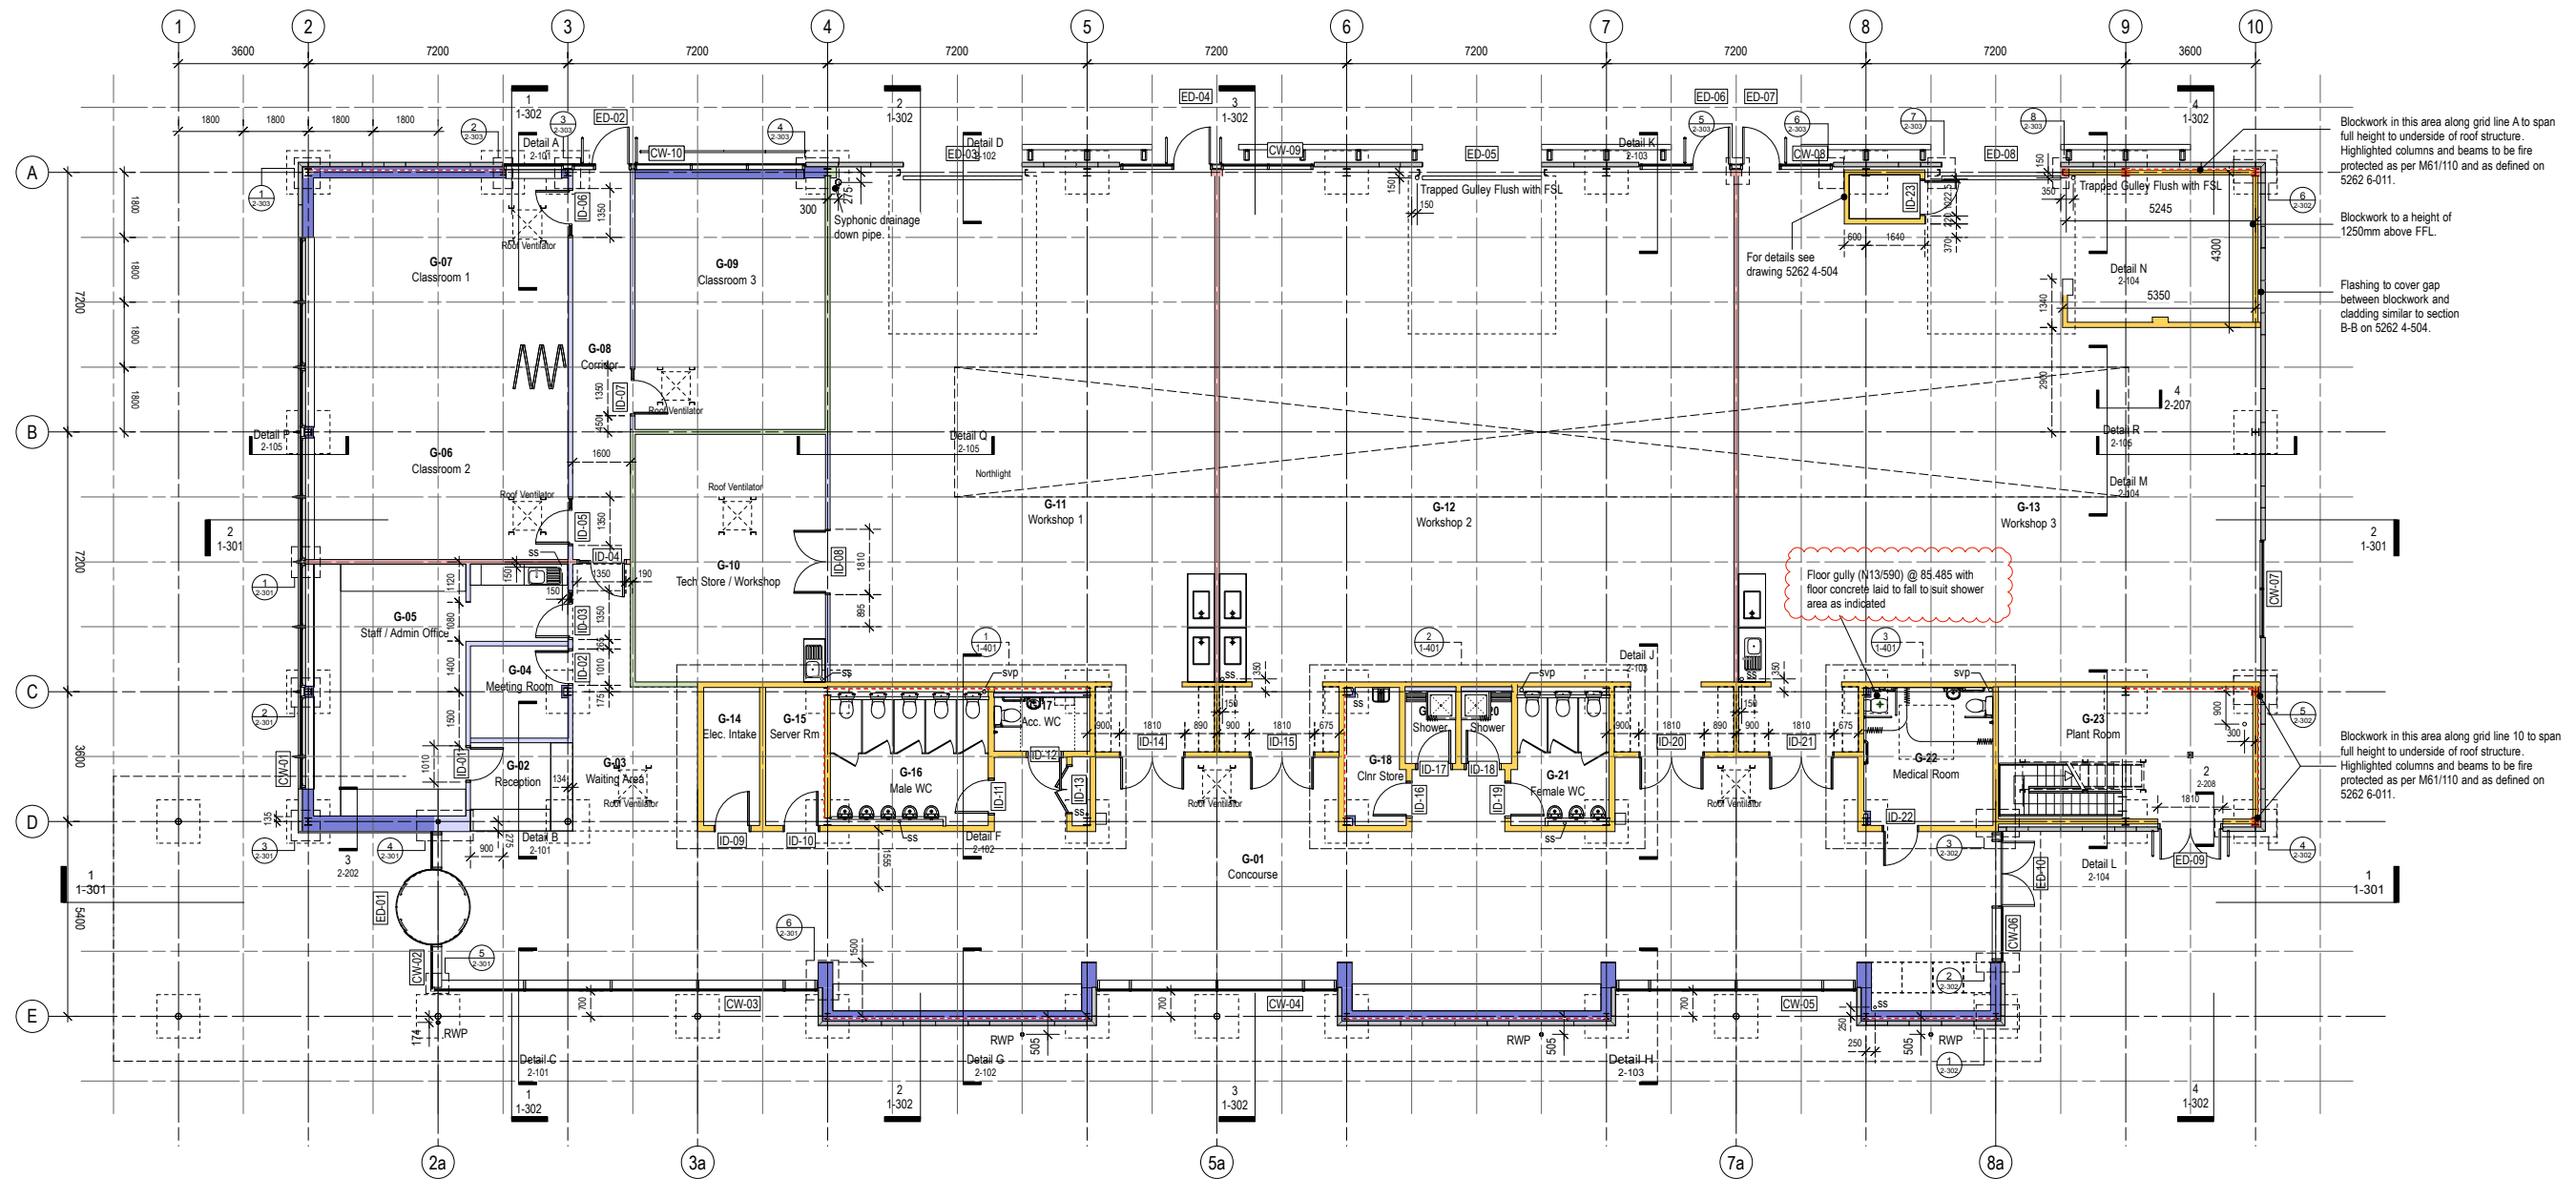

rev	date	description	drw	chkd
P3	18/12/15	2No. roof ventilators removed from Concourse. Lining shown to back of showers.	MD	NJC
P4	11/01/16	Overhead sectional doors reduced in width to 3300mm. 2No. roof ventilators reinstated. Detail ref. added.	MD	NJC
P5	15/02/16	Vehicle barriers updated. Railing added in front of Class 3. Fire protected steel highlighted, note updated. ss and svp shown.	MD	NJC
P6	14/04/16	Gully notes updated. Partition types highlighted. Cross bracing shown.	MD	NJC
C1	29/04/16	Detail ref added. Dims updated. Construction Issue.	MD	NJC
C2	24/05/16	Note added.	MD	NJC

General Notes

1. To be read in conjunction with all other architect's, structural and service engineers' drawings, schedules and specifications.

Partition Types

- Concrete Block Wall F10/255 for extent of plaster finishes, refer finishes schedule.
- Metal Stud Partition (Rw 52dB) K10/125B
- Metal Stud Partition (Rw 50dB) K10/130B
- Metal Stud Partition (Rw 55dB) K10/132B
- External Wall Lining K10/155B

----- Denotes location of cross bracing



Interserve Construction Limited
George Road, Erdington, Birmingham, B23 7RZ
Tel: 0121 344 4888, Fax: 0121 344 4801
E-mail: mail@interserveprojects.com



Perkins Ogden Architects

01962 735155 www.perkinsogden.com
Construct House Winchester Road Alresford SO24 9EZ

SHEET CONTENTS

Hampshire County Council, Whitehill and Bordon Future Skills Centre, Louisburg Barracks
Ground Floor Plan

SCALE	CREATED	DRAWN	DRAWING NO.	REVISION
1:100 @ A1 1:200 @ A3	10/2015	MD	5262/1-101	C2