





Existing Front Elevation
Scale 1/100




Existing Rear Elevation
Scale 1/100

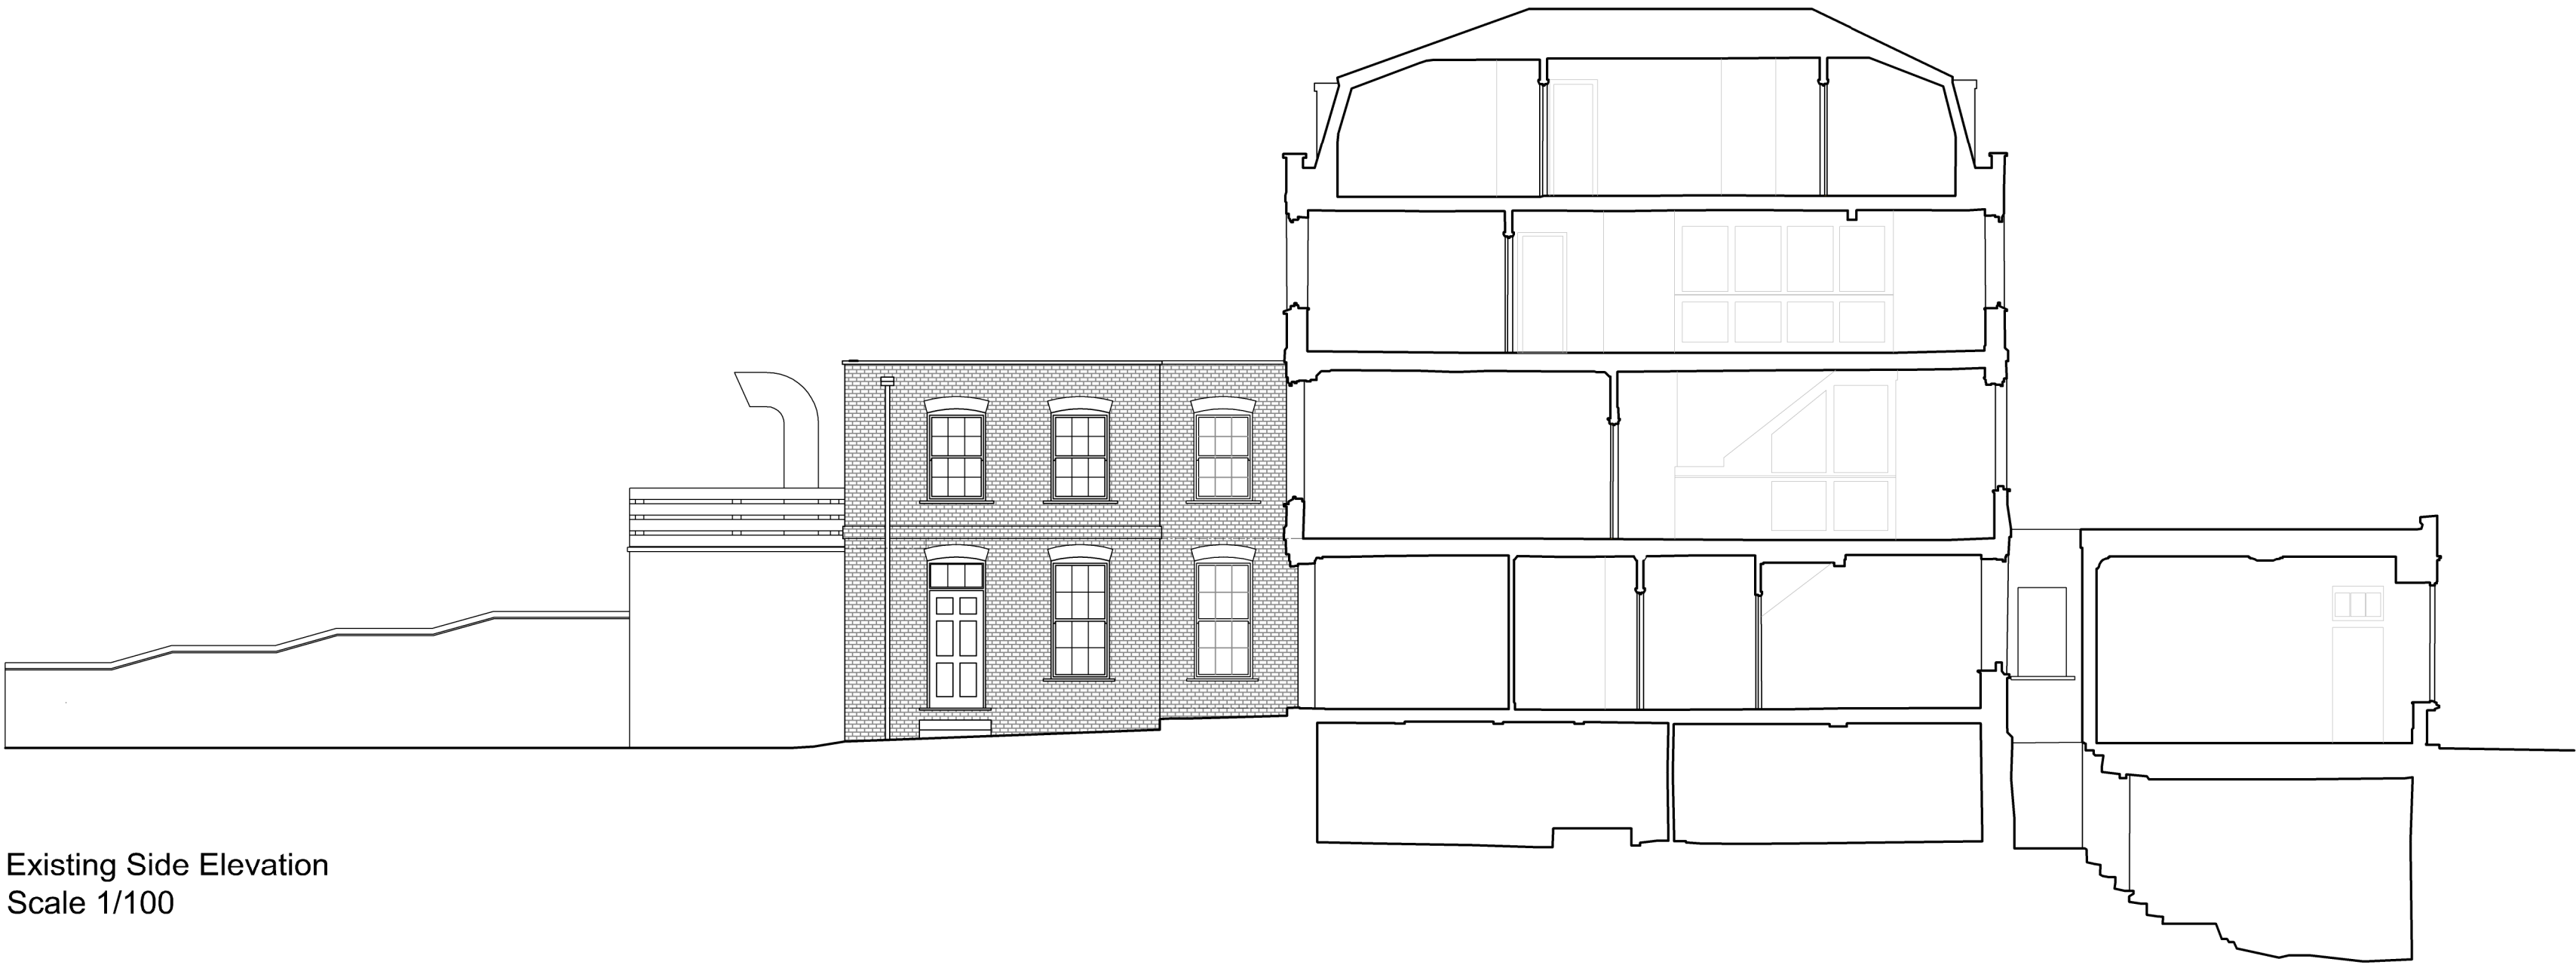


Existing Side Elevation
Scale 1/100

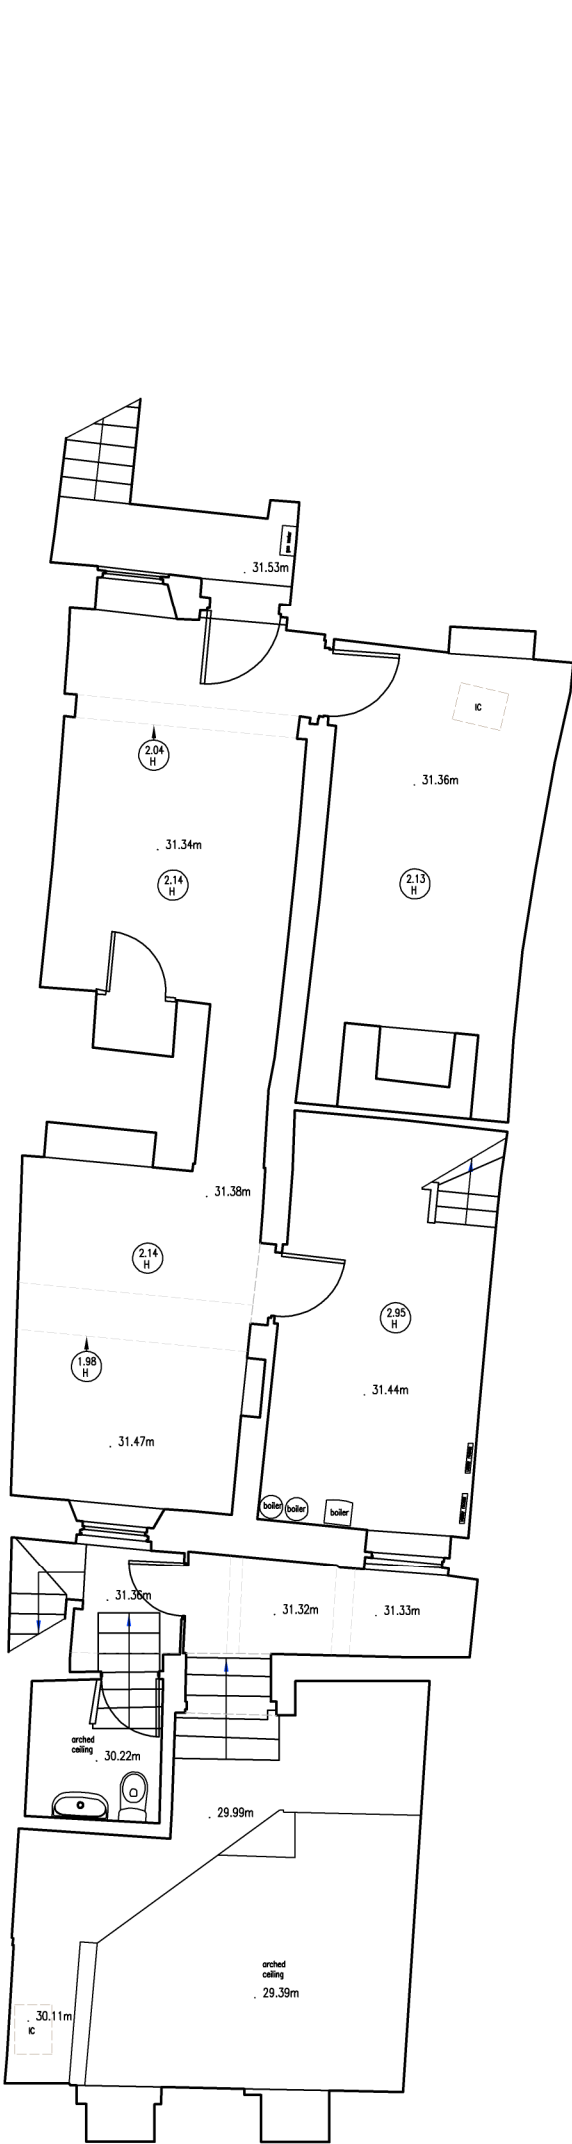


Existing Basement Level
Scale 1/100

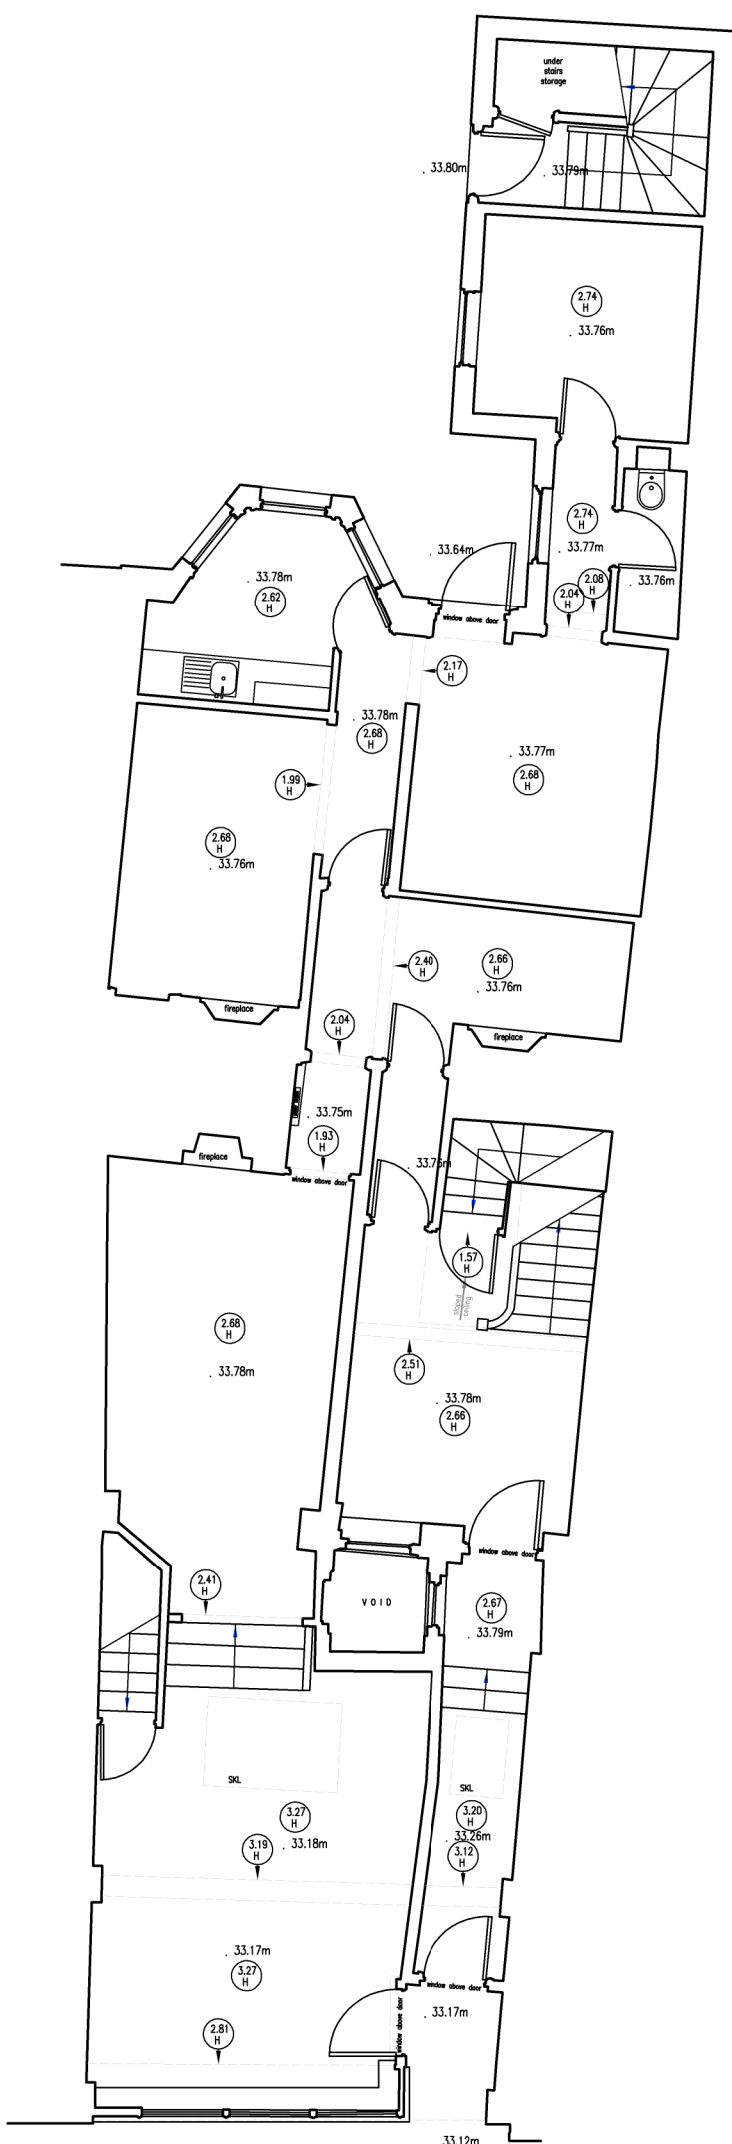


Existing Ground Floor Level
Scale 1/100

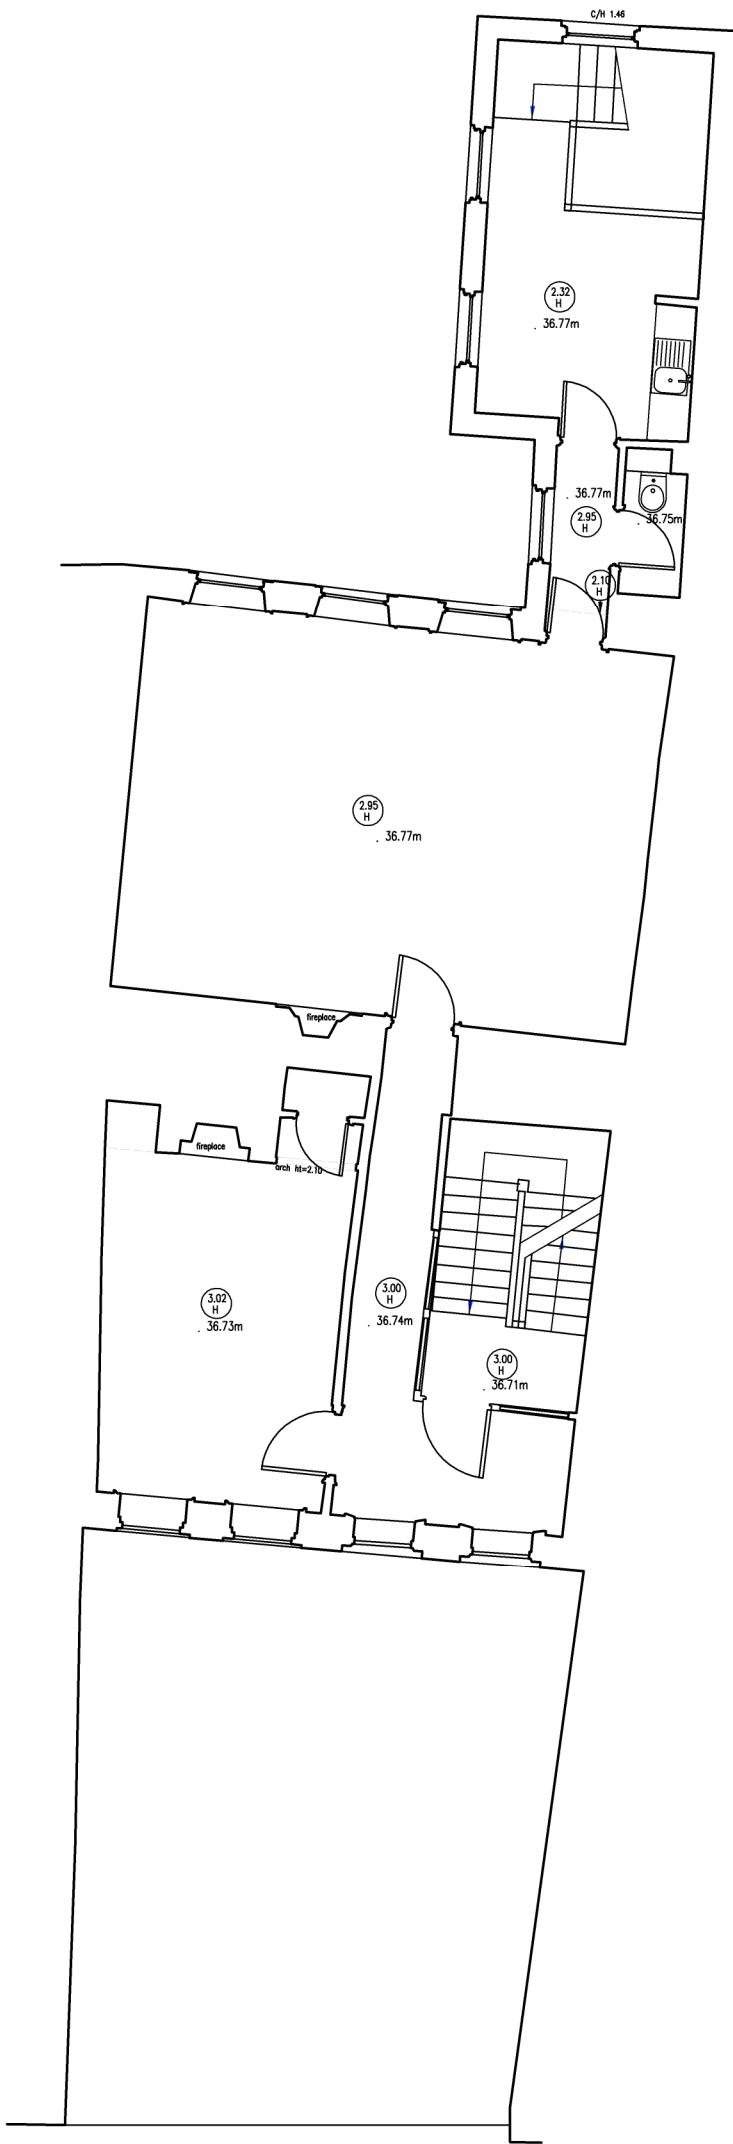

Existing First Floor Level
Scale 1/100

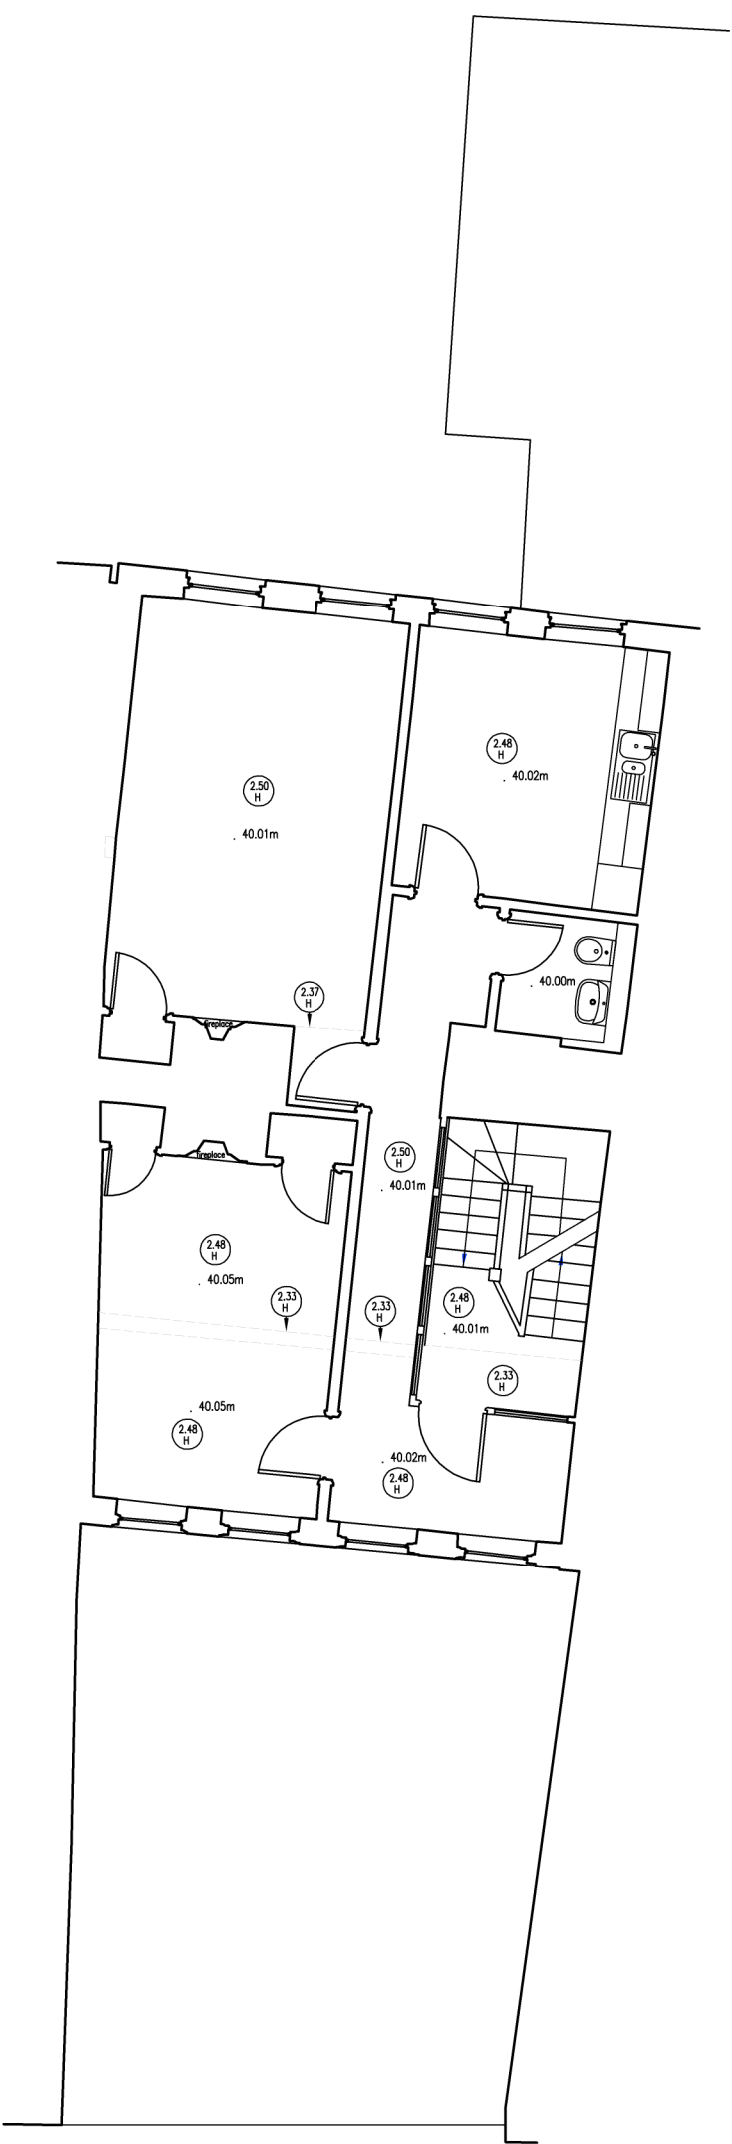

Existing Second Floor Level
Scale 1/100

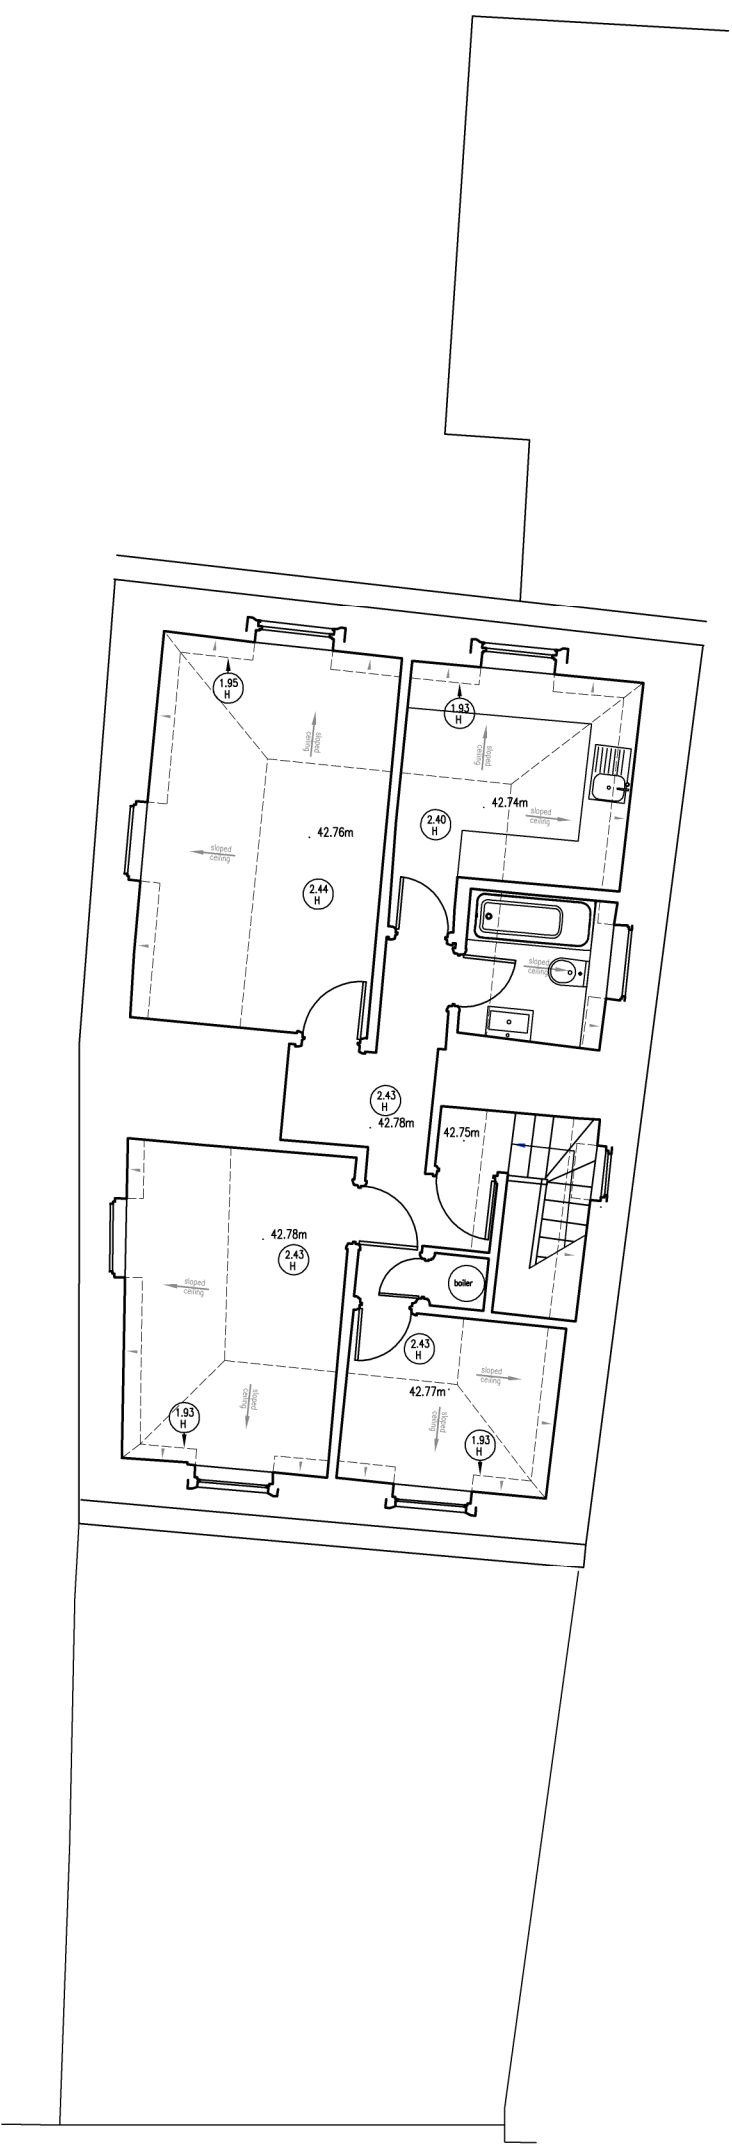

Existing Third Floor Level
Scale 1/100

Revisions			
Rev	Date	Notes	Drawn

Project		Drawing	
Client:	Tenergy Group	Title:	Existing Floor Layouts & Elevations
Address:	8a High Street, Windsor SL4 1LD	Drawn By:	gs
Stage:	Existing	Date:	Jul22
		Scale:	1/100@A1
		Dwg No.:	2022-019-02
		Rev:	