

DO NOT SCALE THIS DRAWING

Contractors are to check all dimensions prior to commencement on site and notify the architect of any errors, omissions, or discrepancies.

TateHindle Limited retain copyright of this drawing. It may not be copied, altered or reproduced in any way without their written authority.




KEY:

- Scope Boundary
- Office space within scope
- Office space removed from scope
- Landlord space
- External Balcony

NOTE:

Retain all existing access controls to doors

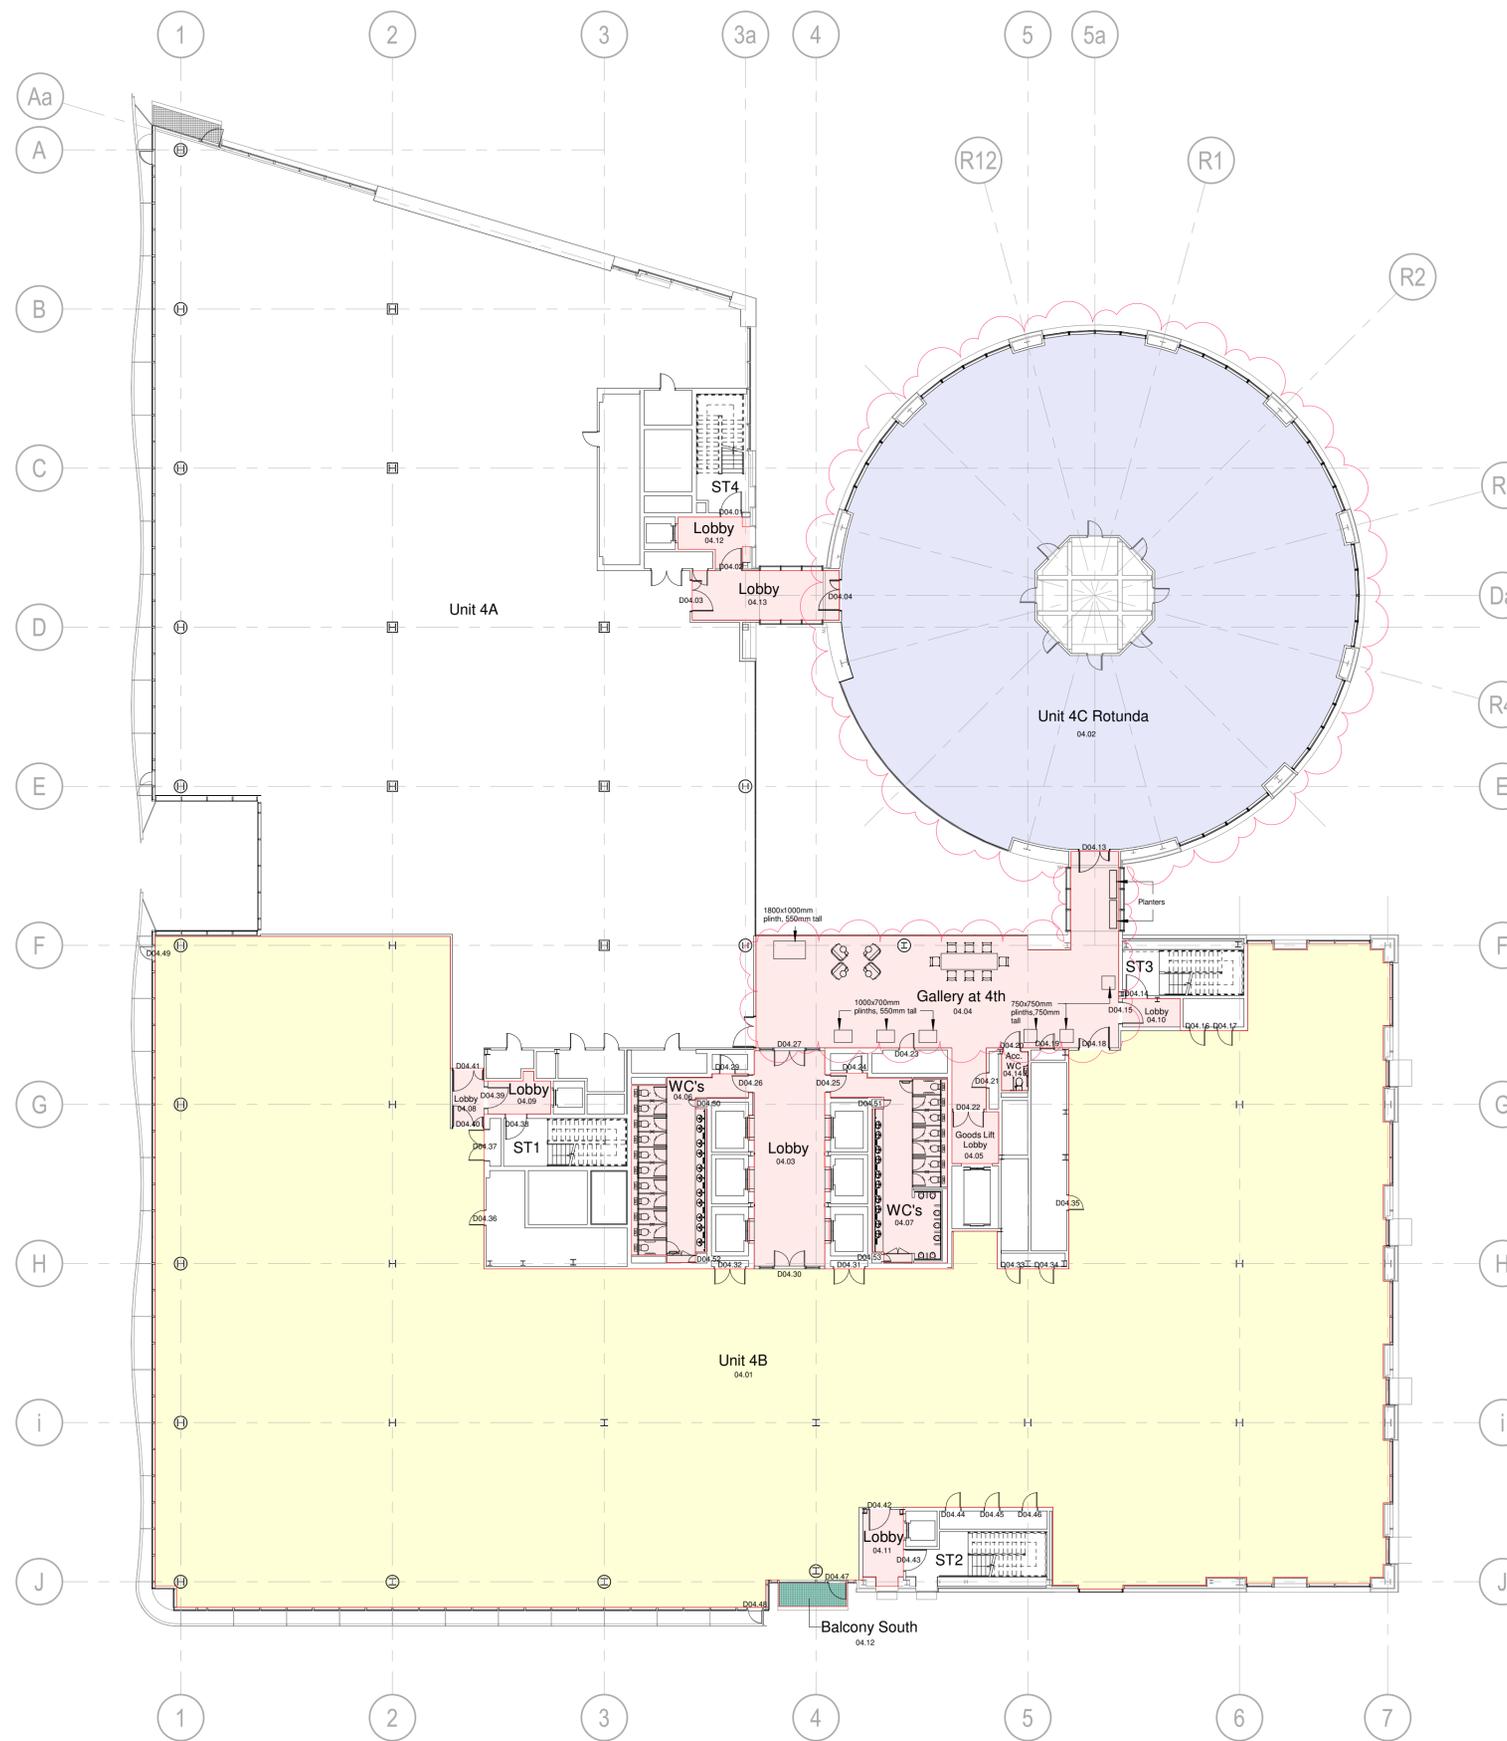

**1 Proposed Fourth Floor Plan**  
1 : 200

11	Rotunda Omission Issue	17/08/23	HEG
10	Rotunda Omission Draft	08/08/23	KF
9	Rotunda Omission Draft For Comment	04/08/23	KF
8	For Contract	07/07/23	HEG
7	Issued for Tender	28/04/23	SB
6	Issued for Information	14/04/23	NC
5	Stage 3 Issue	24/02/23	TS
4	Issued to MEP	22/02/23	TS
3	Issued to Building Control	28/01/23	NC
2	Issued for Information	20/01/23	NC
1	Issued for Information	02/12/22	TS

Rev	Description	Date	Checked
-----	-------------	------	---------

Status

**FOR INFORMATION**

Client

DekaBank Deutsche Girozentrale

Project

Kings Place, London N1

Drawing

Proposed Fourth Floor Plan

Project no.	Scale	Drawn	Checked	North
15565	1:200 @ A1	A1 NC	TS	

Dr	Revision
A-(03) - 104	11

TateHindle  
168 Shoreditch High Street  
London E1 6HU

T 020 7332 4850  
mail@tatehindle.co.uk  
www.tatehindle.co.uk

