

Contractors are to check all dimensions prior to commencement on site and notify the architect of any errors, omissions, or discrepancies.

TateHindle Limited retain copyright of this drawing. It may not be copied, altered or reproduced in any way without their written authority.




KEY:

- Scope Boundary
- Office space within scope
- Office space removed from scope
- Landlord space
- External Balcony

NOTE:

Retain all existing access controls to doors

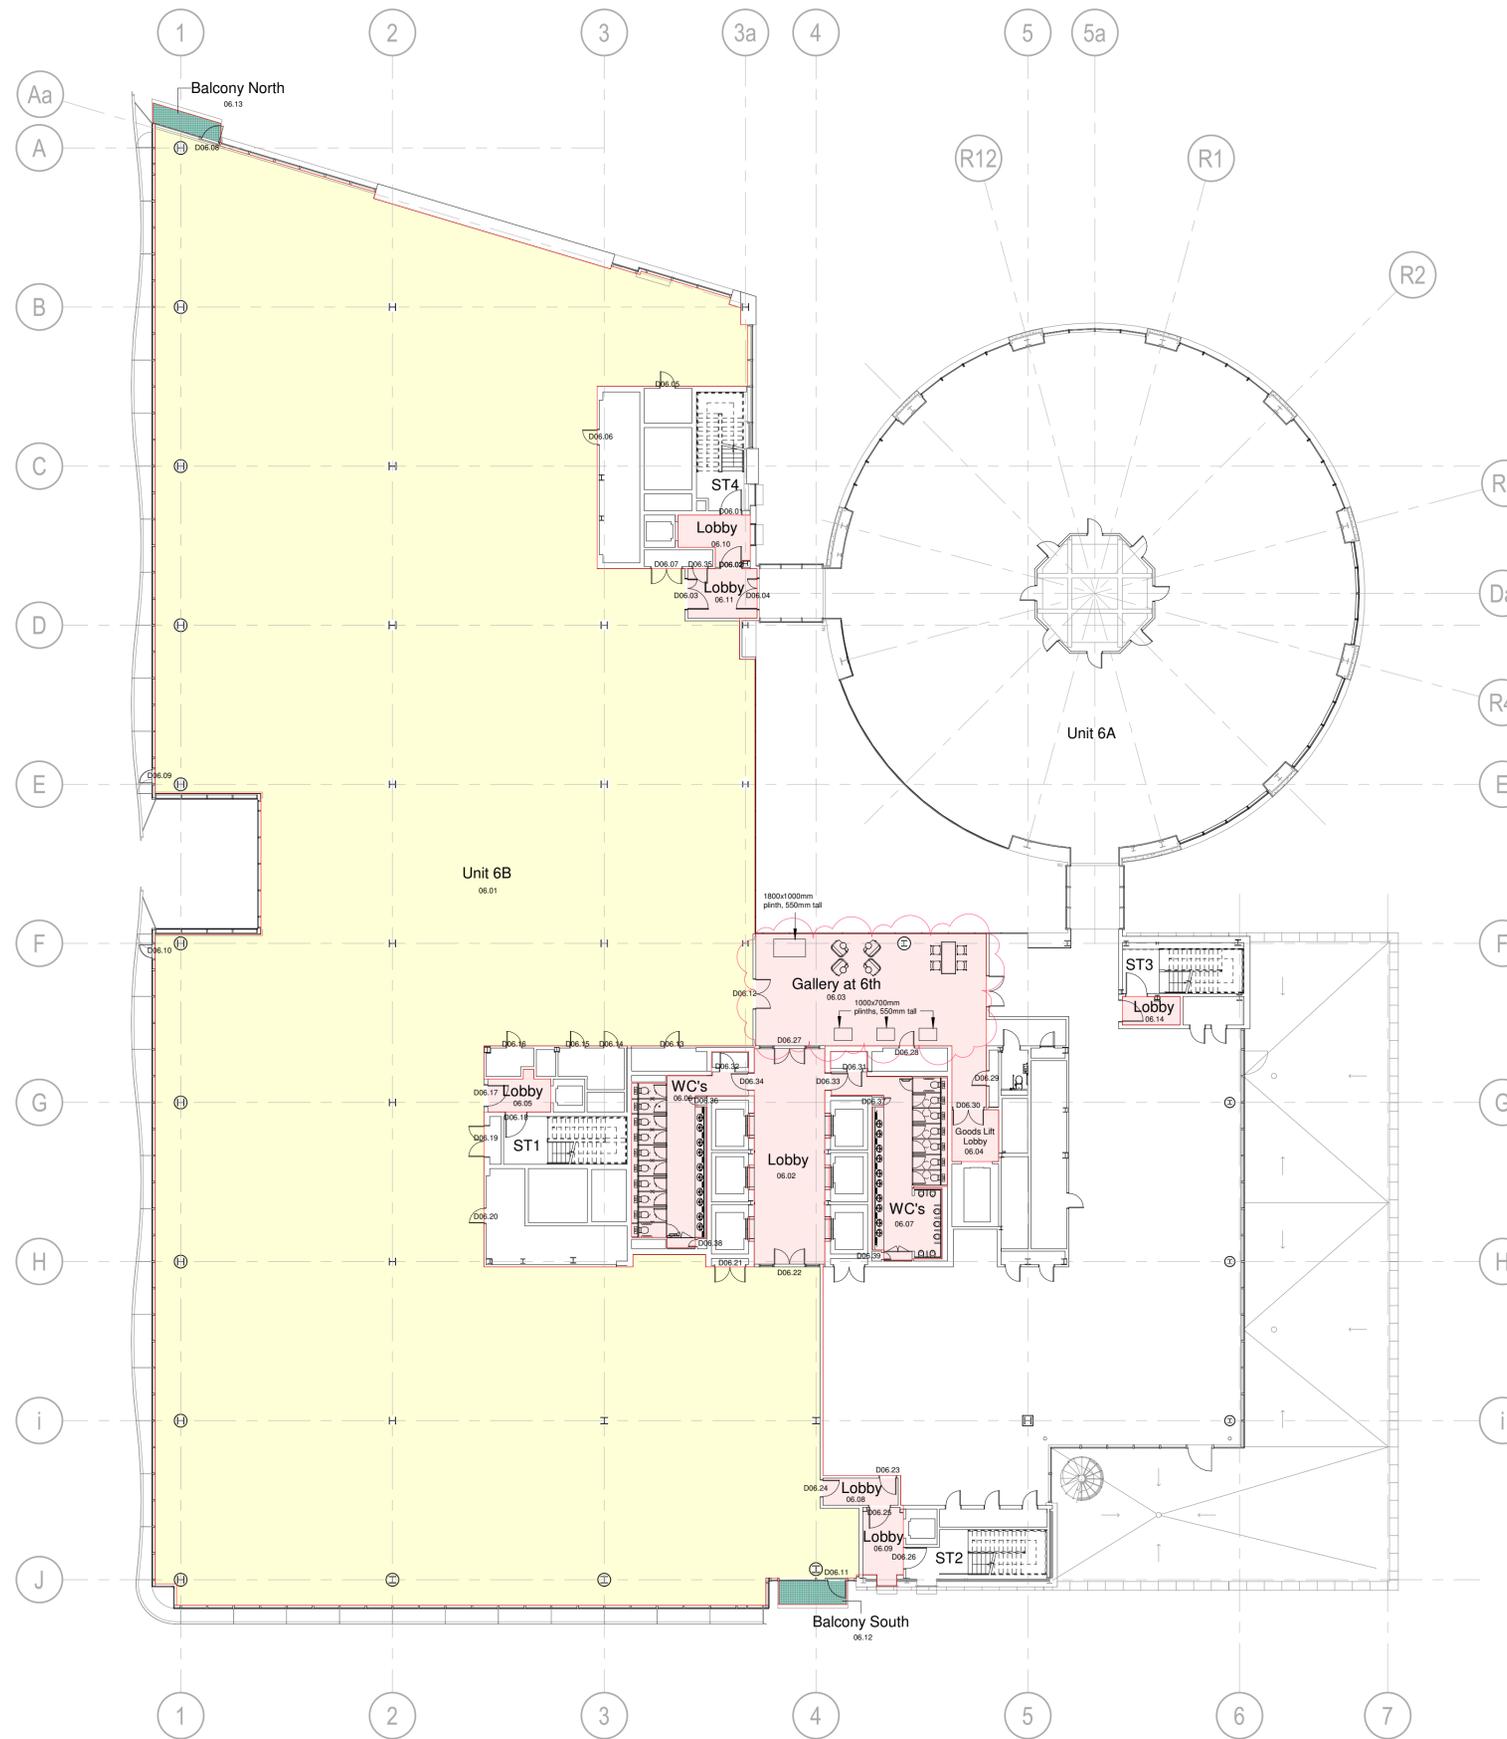

1 Proposed Sixth Floor Plan
1 : 200

Rev	Description	Date	Checked
9	Rotunda Omission Issue	17/08/23	HEG
8	For Contract	07/07/23	HEG
7	Issued for Tender	28/04/23	SB
6	Issued for Information	14/04/23	NC
5	Stage 3 Issue	24/02/23	TS
4	Issued to MEP	22/02/23	TS
3	Issued to Building Control	28/01/23	NC
2	Issued for Information	20/01/23	NC
1	Issued for Information	02/12/22	TS


FOR INFORMATION

Client
DekaBank Deutsche Girozentrale

Project
Kings Place, London N1

Drawing
Proposed Sixth Floor Plan

Project no.	Scale	Drawn	Checked	North
15565	As indicated @ A1	NC	TS	
Drg				Revision
A-(03) - 106				9

TateHindle
168 Shoreditch High Street
London E1 6HU

T 020 7332 4850
mail@tatehindle.co.uk
www.tatehindle.co.uk