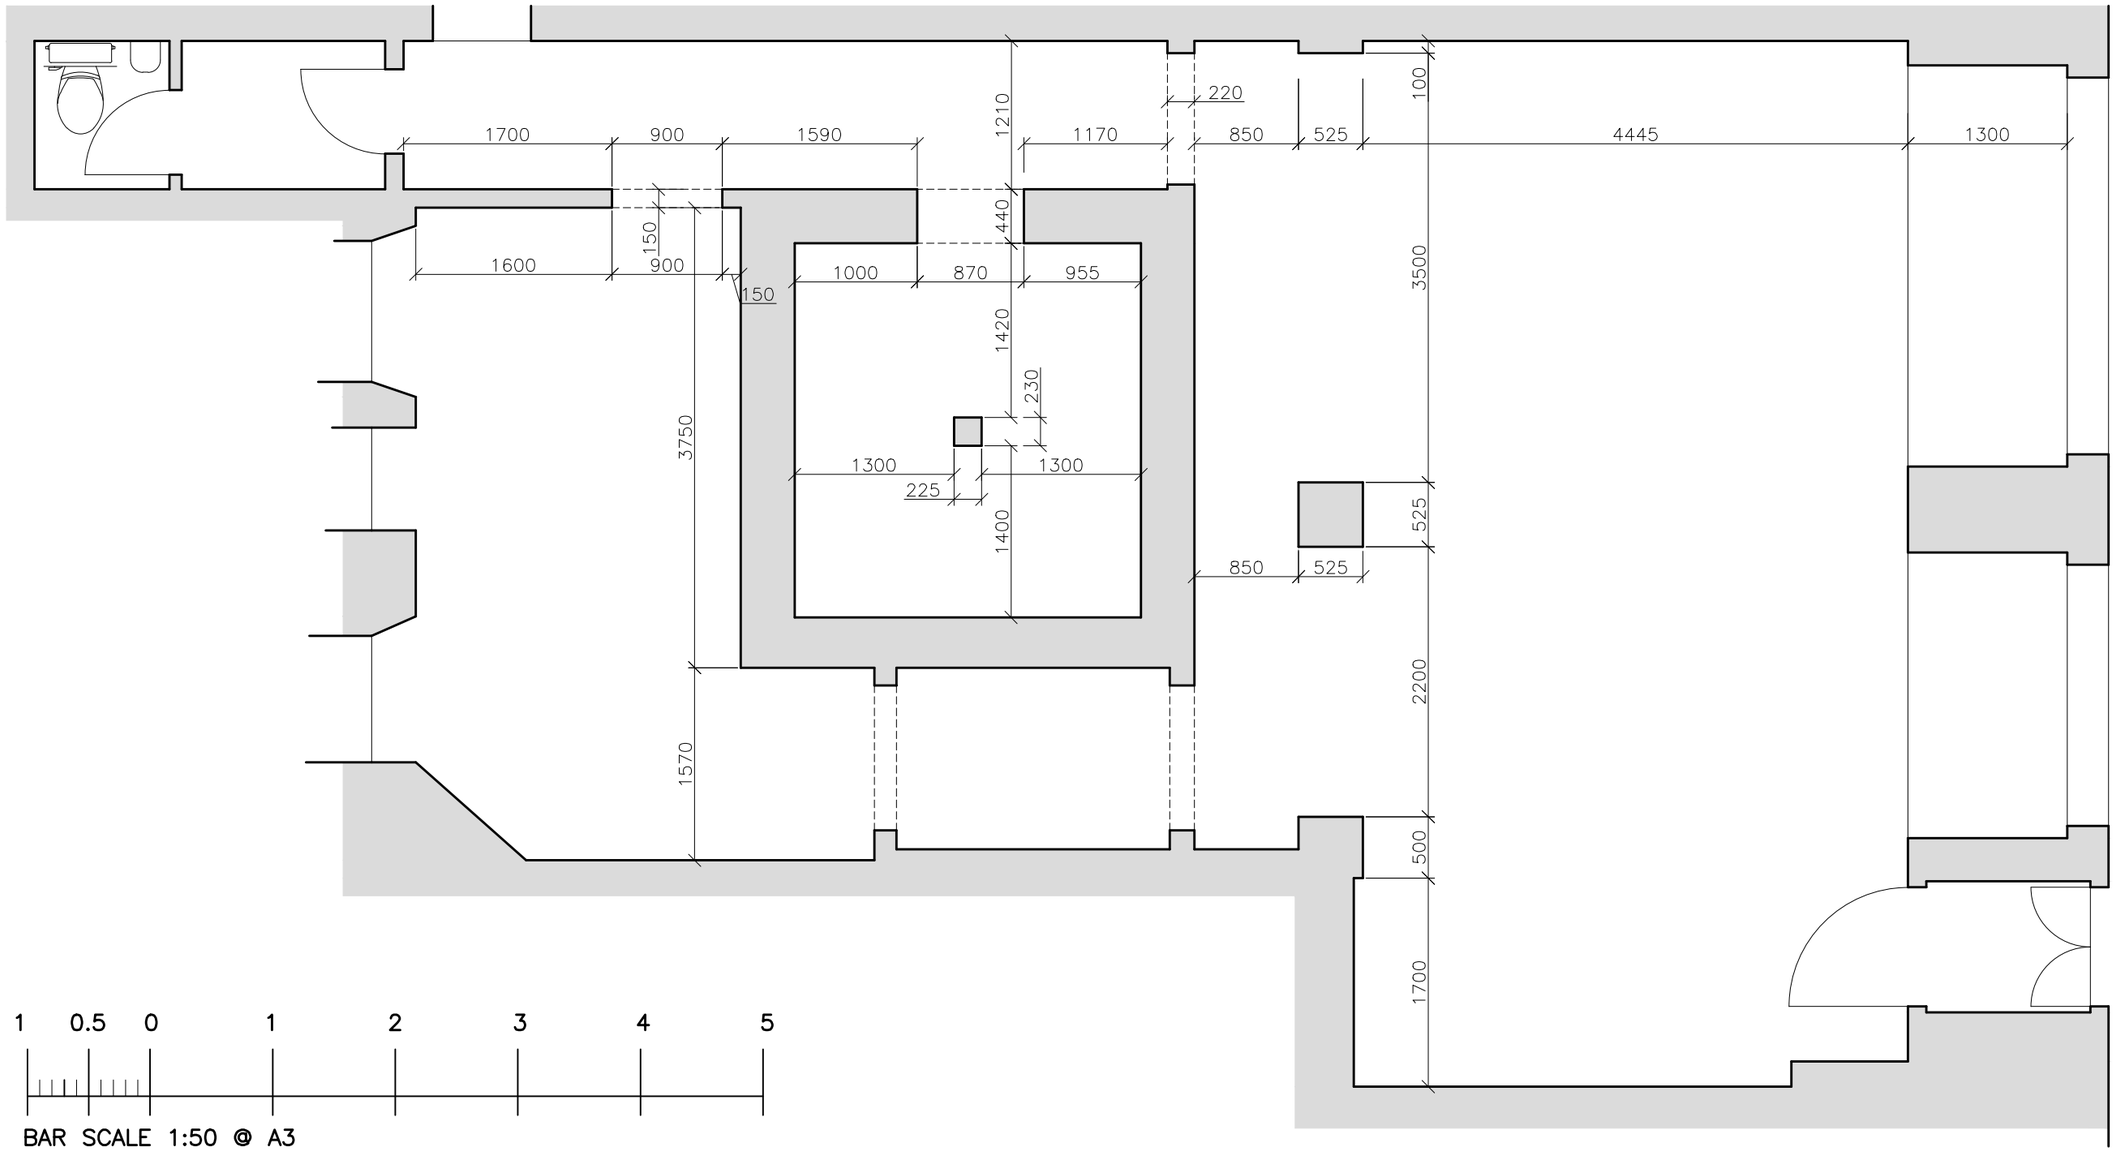

Brian McDonald MCIAT
Chartered Architectural Technologist

12, Lee Crescent,
Portobello, Edinburgh EH15 1LW

Mobile 07538874095
email bwmcd12@gmail.com

Chartered Institute of Architectural Technologists
Registered Practice

PROJECT
ACANTHUS
EDINBURGH

DRAWING TITLE
PLAN AS EXISTING

STATUS
SKETCH

SCALE
1:50@A3

DRAWING NUMBER
AC(BW) 001

REVISION

DATE
JULY 2018