




# SAFESCAPE SERVICES LIMITED

EMERGENCY LIGHTING, FIRE ALARM  
& SECURITY SPECIALISTS

Endeavour House  
259 Forstal Road  
Aylesford Kent ME20 7AQ  
Tel: +44 (0) 1622 882 282  
Fax: 01622 331066  
Mob: 07973 194109

E Mail [nicholas.holness@btinternet.com](mailto:nicholas.holness@btinternet.com)

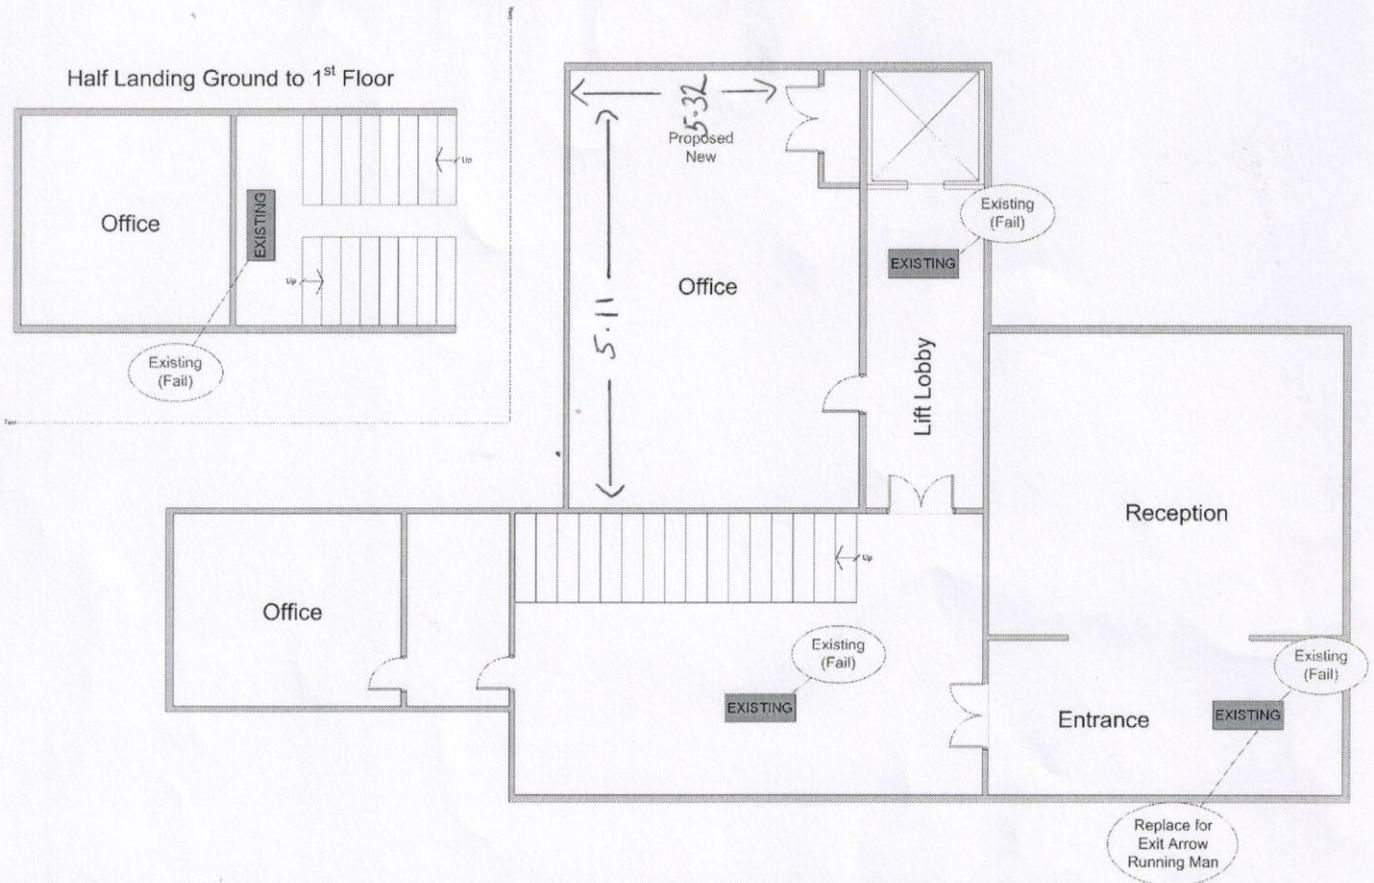

	<b>Project</b> Risimenda, 4 Hill Street, London W1	<b>Title</b> Ground Floor Emergency Lighting Proposal to BS5266	<b>Key</b> Proposed New 8 Watt 3 Hour Emergency Light Fitting Existing Emergency Light Fitting
	<b>Date</b> 22 <sup>nd</sup> May 2008	<b>Drawing Number</b> NH/SA/GF001	