



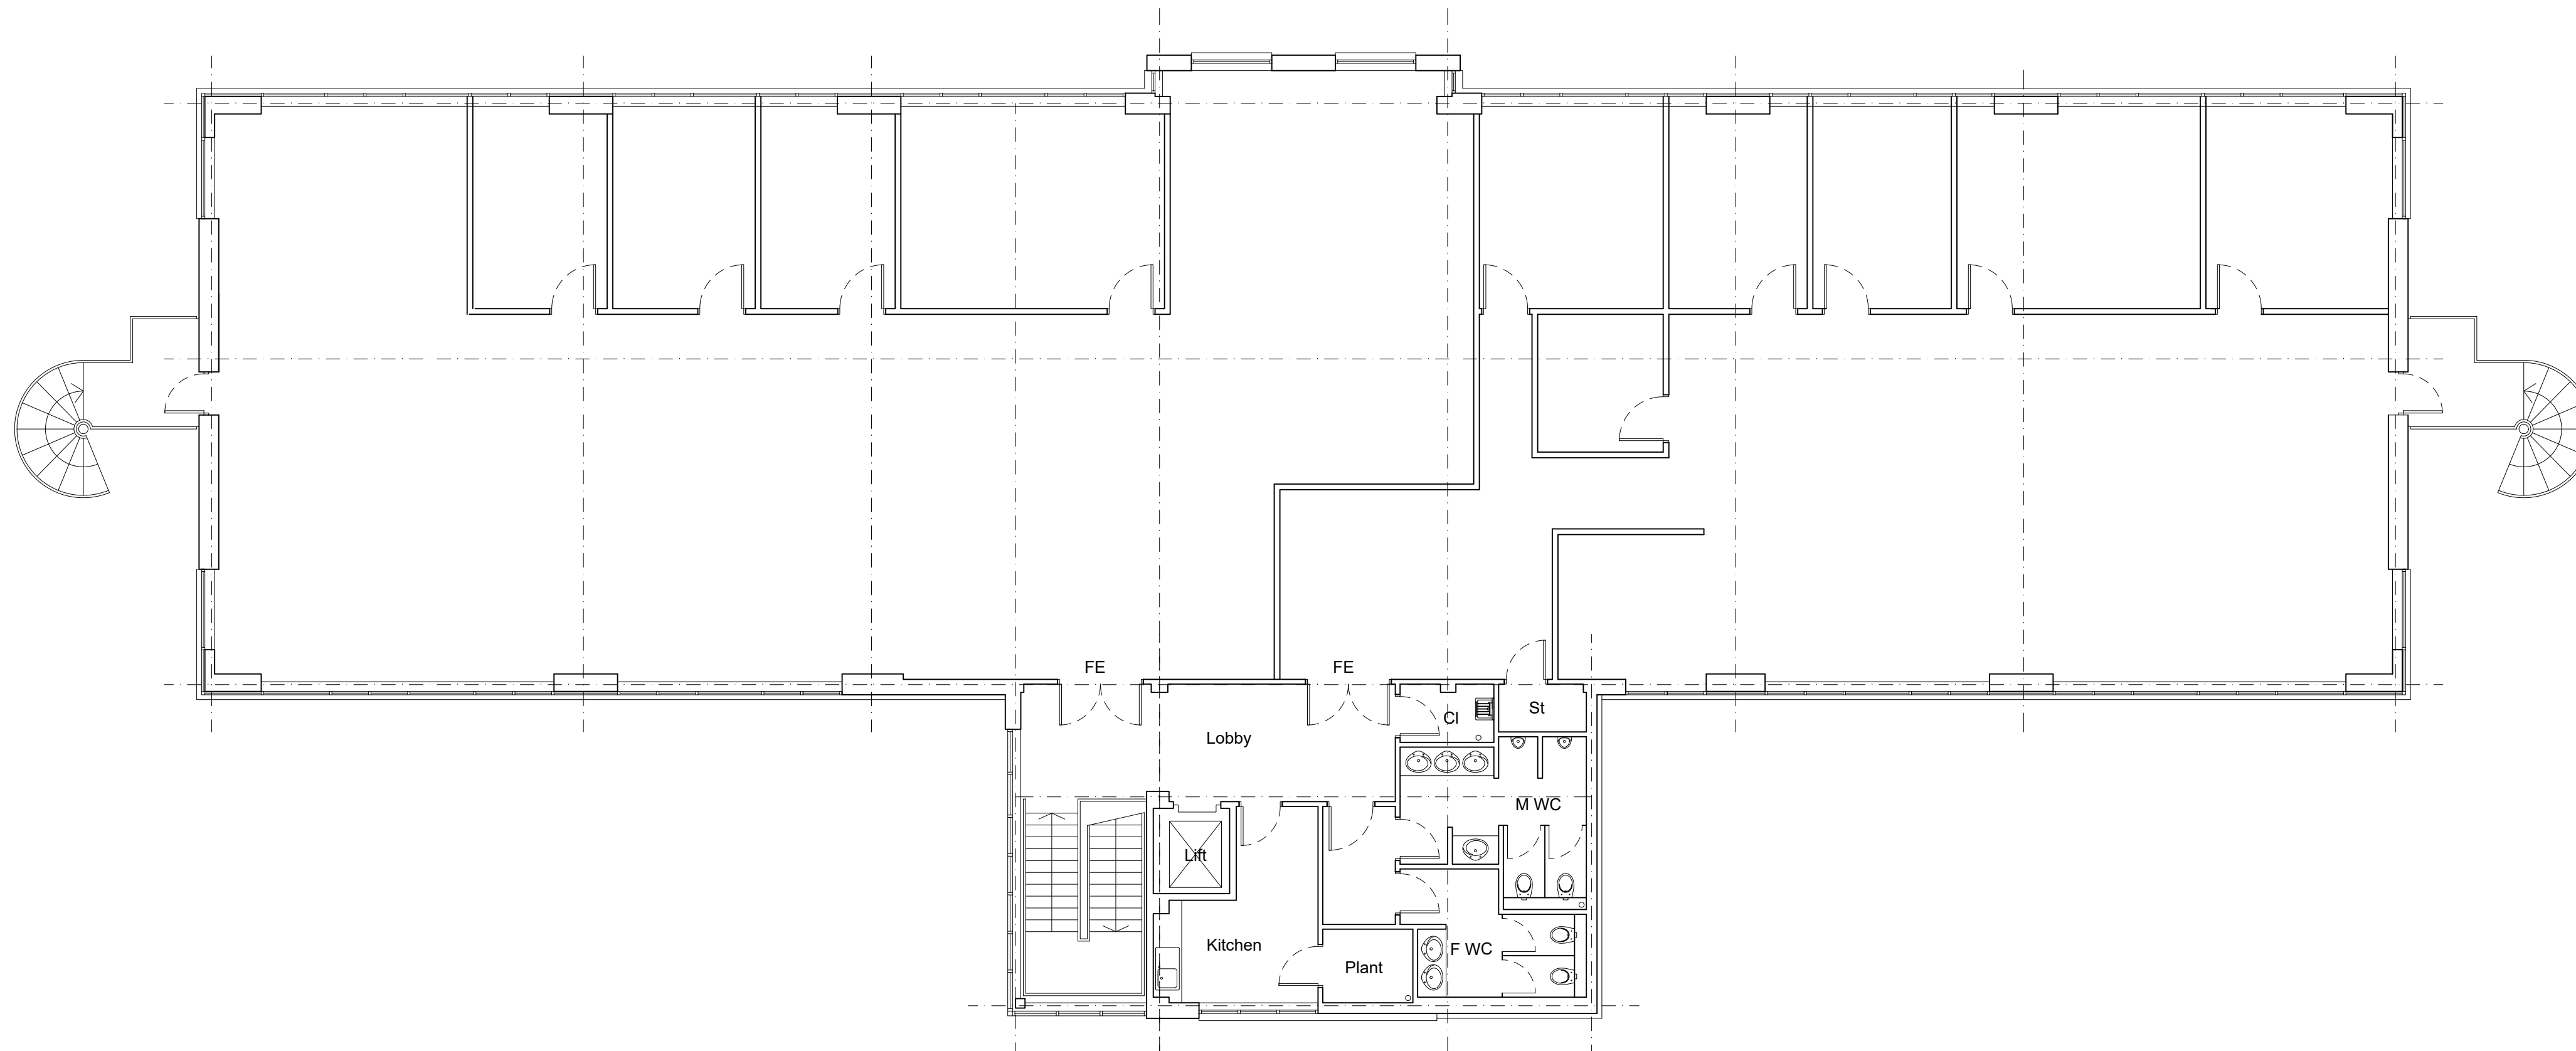

First Floor Plan (No Change)

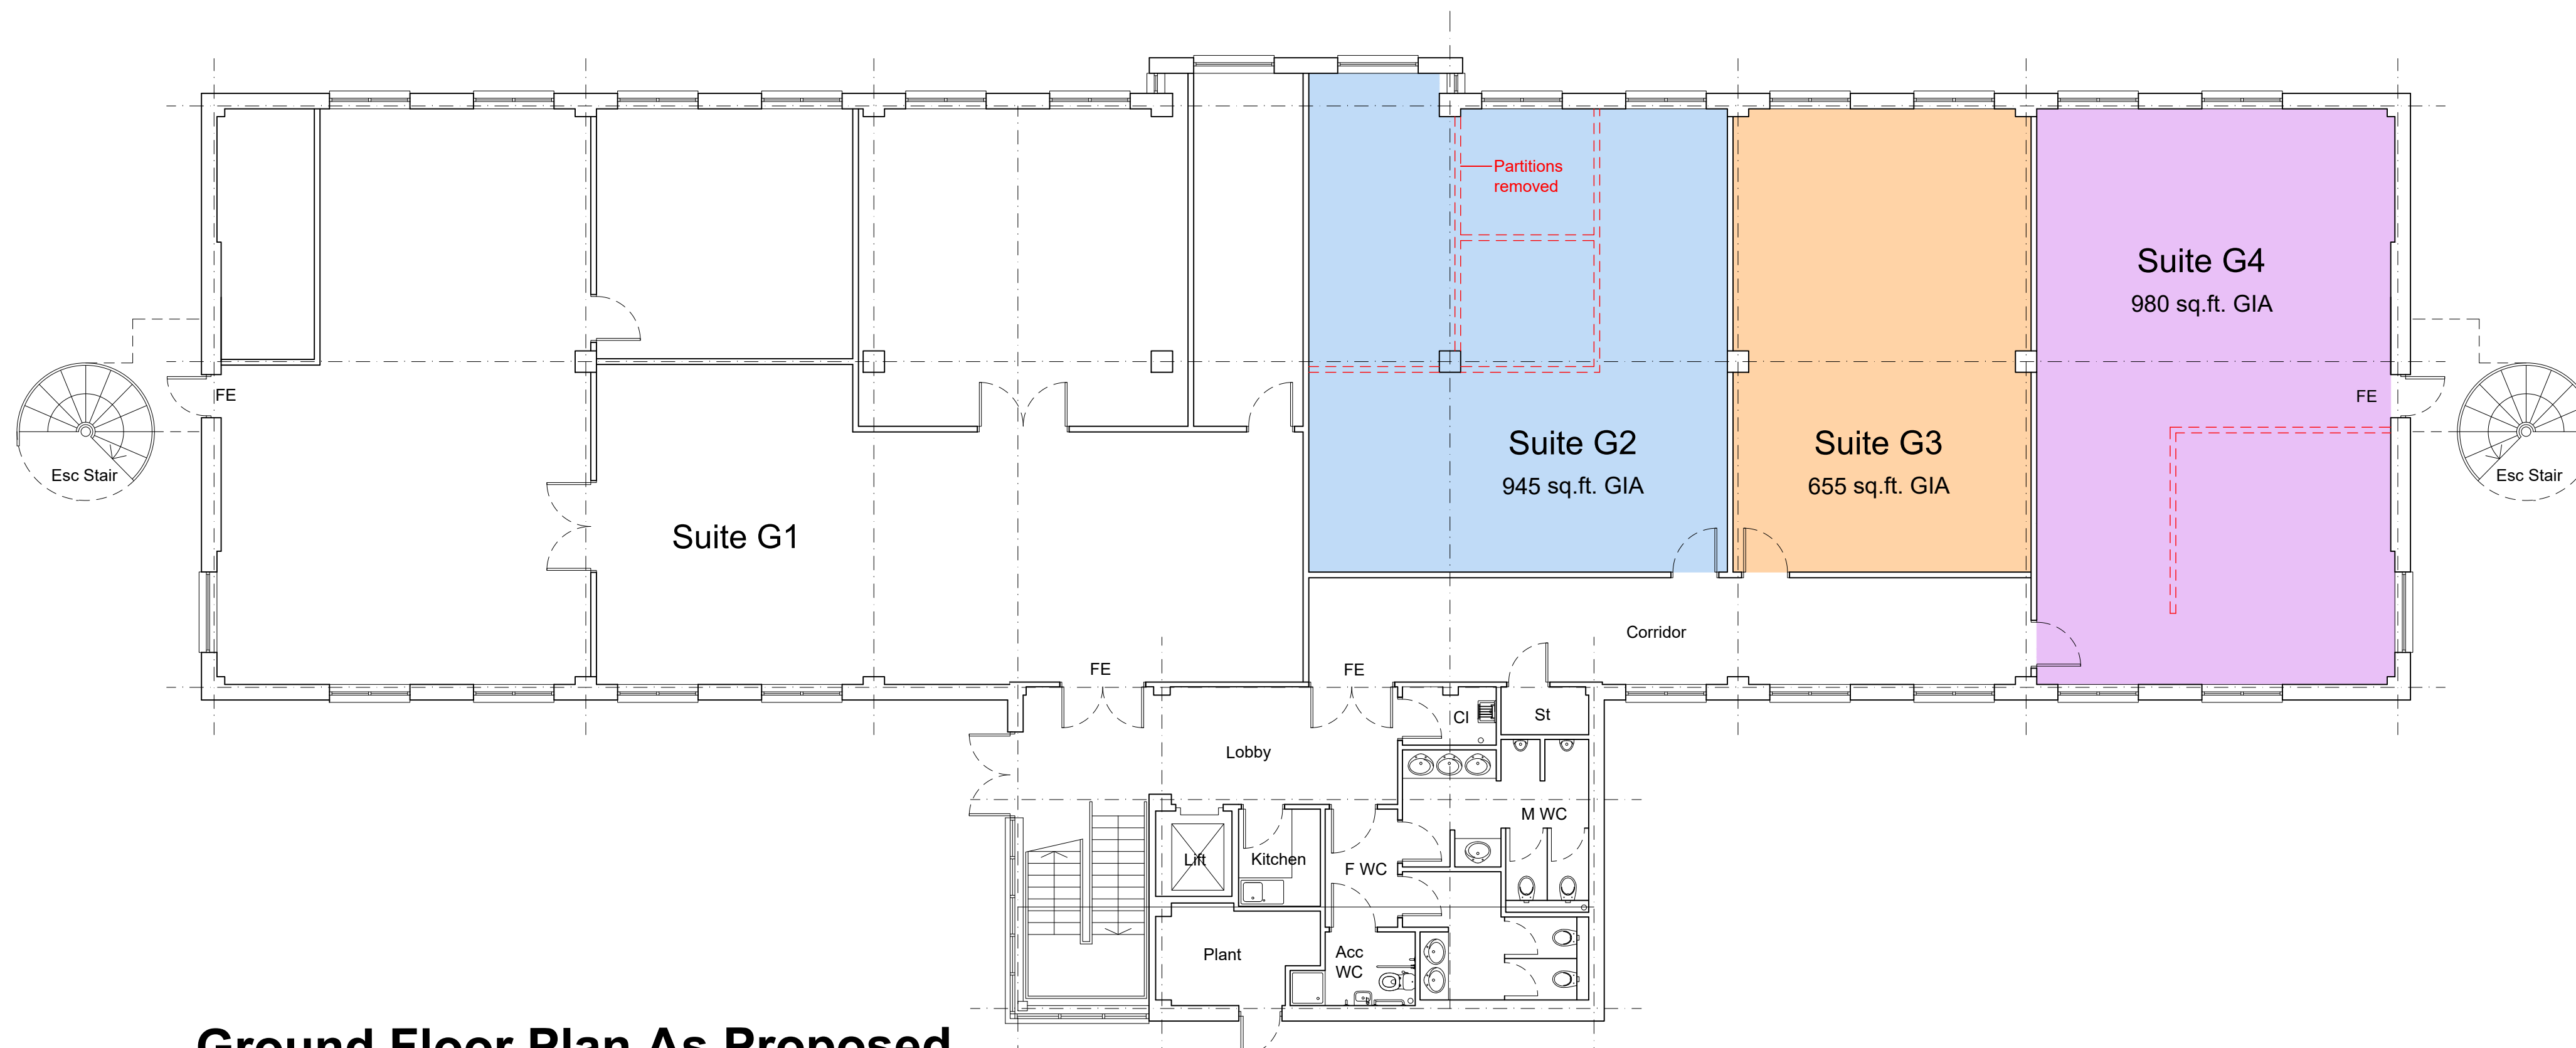

Ground Floor Plan As Proposed

Scale bar (m) 1:100

