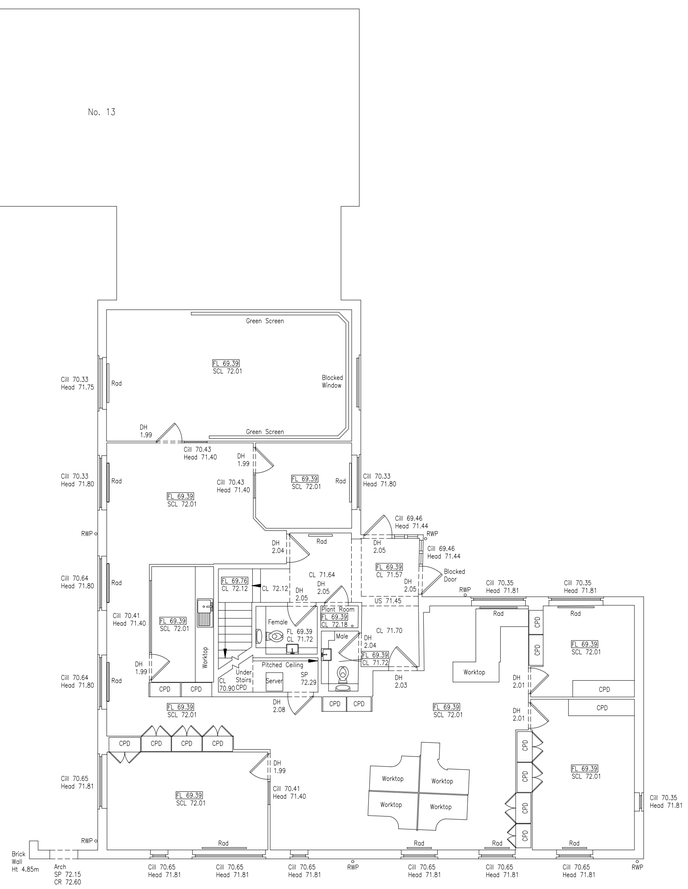

GROUND FLOOR PLAN

Scale Bar : Metres

Legend:

Abbreviated Features:

AB	Air Brick	Lt	Light
B	Bollard	O/F	Overflow Pipe
C/B	Close Boarded	P	Post
C-H	Cill to Head	P/C	Pitched Ceiling
C/L	Chain Link	PE	Pipe
CL	Ceiling Level	P/R	Pitched Roof
CPD	Cupboard	P/W	Post & Wire
CR	Crown Point Level	RD	Roller Door
DH	Door Height	RE	Radding Eye
Dr	Drain	RWP	Rainwater Pipe
FE	Fire Exit	SD	Sliding Doors
F-C	Floor to Cill	SCL	Suspended Ceiling Level
FL	Floor Level	SP	Spring Point Level
FW	Foul Water	SVP	Soil & Vent Pipe
MH	Manhole	SW	Surface Water
G	Gully	US	Underside
IC	Inspection Chamber	UTL	Unable To Lift
IL	Invert Level	VP	Vent Pipe
I/R	Iron Railings	Vt	Vent

Symbols:

Radiator
Light
Emergency Light
Strip Light
Wall Mounted Light
Mains Point
Blank Plate
Light Switch
Pendant Switch
Isolator Switch
Alarm Bell
Fire Alarm Push
Smoke Detector
Alarm Panel
Thermostat
Modem
Fuse Box
ElectriCill Box
Heater
Water Stop Tap
Overhead Features

Plan Coordinate Control:-

Plan Coordinates relate to National Grid OSGB36 using GPS

Level Datum:-

All Levels relate to OSGB36 using GPS

Key:

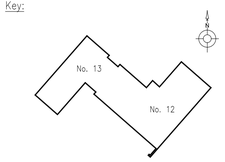

Notes:

REV NO	REV NOTE	DATE	SIGNED

RICS
THE SURVEY ASSOCIATION
chartered ices
CHAS
smas* safety | management | advisory | services

GLOBAL SURVEYS
3 Brookfield, Duncan Close,
Moulton Park, Northampton, NN3 6WL
Tel: 01604 491543
Email: info@globalsurveys.co.uk

Site:	12G Warren Yard Milton Keynes MK12 5NW
Client:	The Parks Trust
Survey Title:	Measured Building Survey Ground Floor Plan

Date	April 2025	Scale	1/100 @ A1
Dwg No.	24911-MBS	Surveyor	JAM
Sheet	1 of 1	Checked	SJH