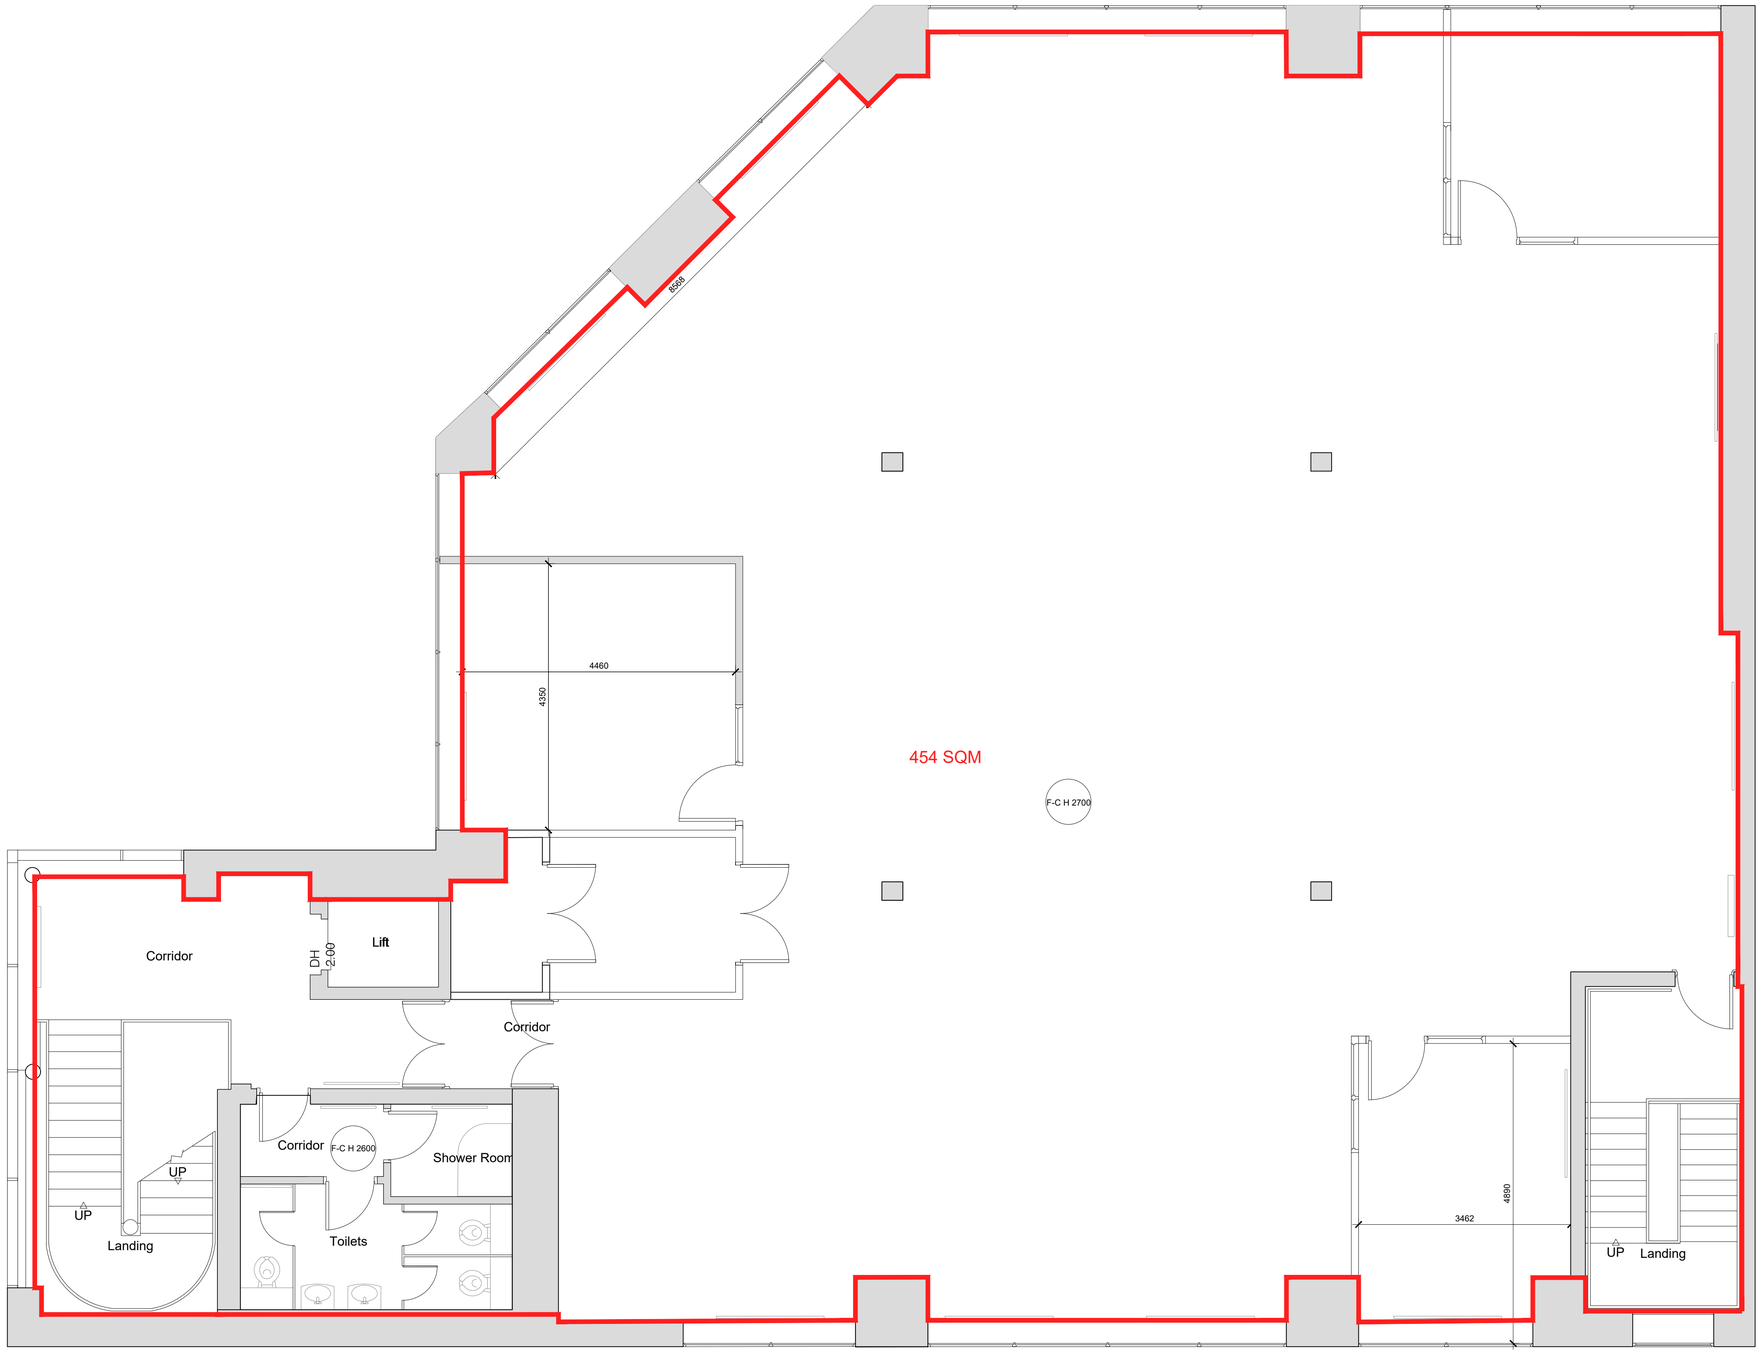

FIRST FLOOR - G.A LAYOUT

GROSS AREA: 454 SQM

Notes:

- - -	Rev: -	Date: - - -

THE BUILDING CONSULTANCY

PROJECT CONSULTANCY · BUILDING CONSULTANCY · DESIGN CONSULTANCY · COST CONSULTANCY · M&E CONSULTANCY · BER CONSULTANCY

23 FREDERICK STREET SOUTH DUBLIN 2 IRELAND
thebuildingconsultancy.ie
T: +353 1 6341000

Client: DLEDT HOLDINGS		Dwg No: AB002	Rev:
Project: WESTLAND HOUSE		Status: AS BUILT	
Title: FIRST FLOOR PLAN		Scale: 1:50 @ A1	Date: 28 FEB 23
Project Number: 23177		Drawn: EG	Checked: KOD

All dimensions are in millimetres unless otherwise stated. Dimensions to be verified on site. Do not scale. Copyright of The Building Consultancy. All rights reserved. Drawing not to be reproduced without permission.