


This drawing is not to be scaled or manipulated in any way. Any errors or discrepancies should be reported to SDA Architecture.
 Work to given dimensions only which the contractor must check and confirm all dimensions on site.
 Copyright to remain with SDA Architecture and is not to be copied, lent or used by any third party without the express written permission of SDA Architecture.

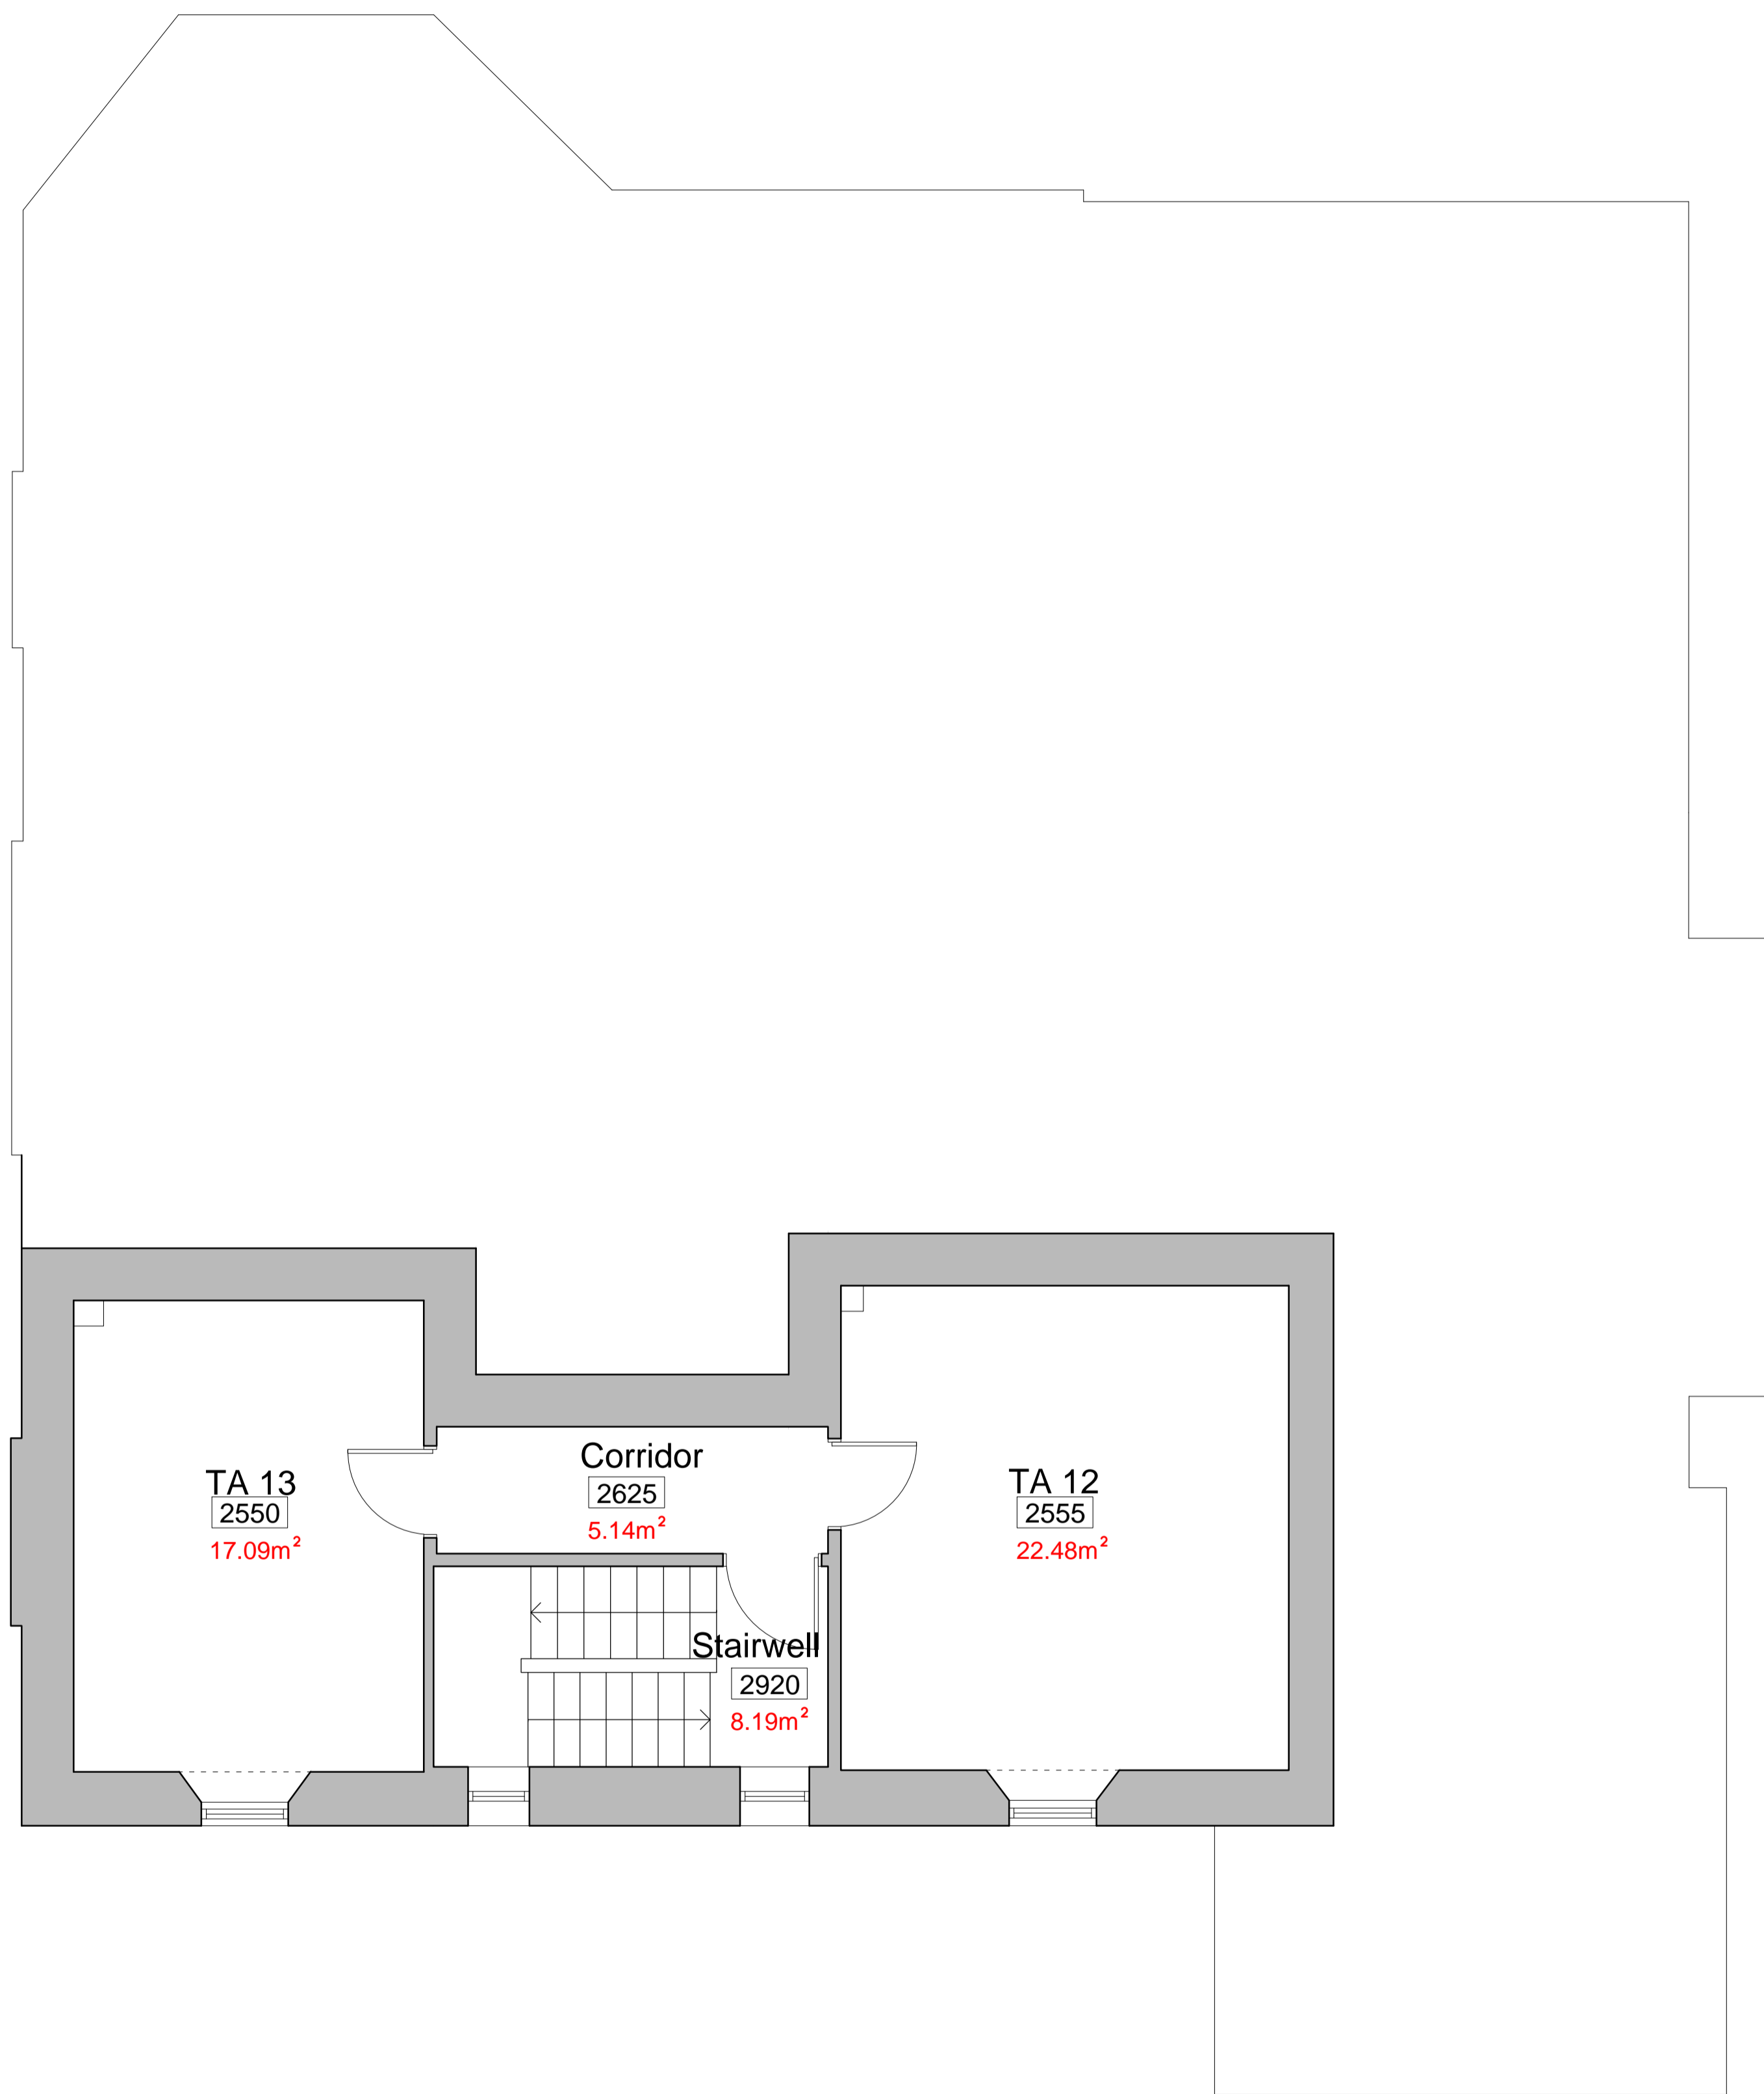

SECOND FLOOR PLAN
 GEA = 75.43m²



The Old Post Office
 34 Wellington Road
 Oxtou
 Wirral
 CH43 2JF
 Tel: 0151-651-1789
 e-mail: admin@sdaarchitecture.com
 Web: www.sdaarchitecture.com

PAIGNTON



Project Location	Project Description
9 Belle Vue Road Paignton TQ4 6ES	Measured Survey

Drawing Title
 Third Floor Plan

Drawn By:	Scale @ A1:
A Dore	1:50
Date:	Revision:
09.06.2016	--
Project Ref:	Drawing No:
96_2016	96_2016_10

