


**DRAWING NOTES**


This drawing (and associated documentation) is the copyright of UKBS LTD. The drawing (or any part thereof) may not be copied, transmitted or disclosed to any third party or unauthorised person without the prior written consent of the UK Building Surveys.

Under no circumstances should dimensions be scaled from this drawing, all dimensions and/or levels are to be checked on-site prior to the commencement of any work. Any discrepancies to be reported to the UKBS Offices or representative thereof immediately. 'IF IN DOUBT ASK'.

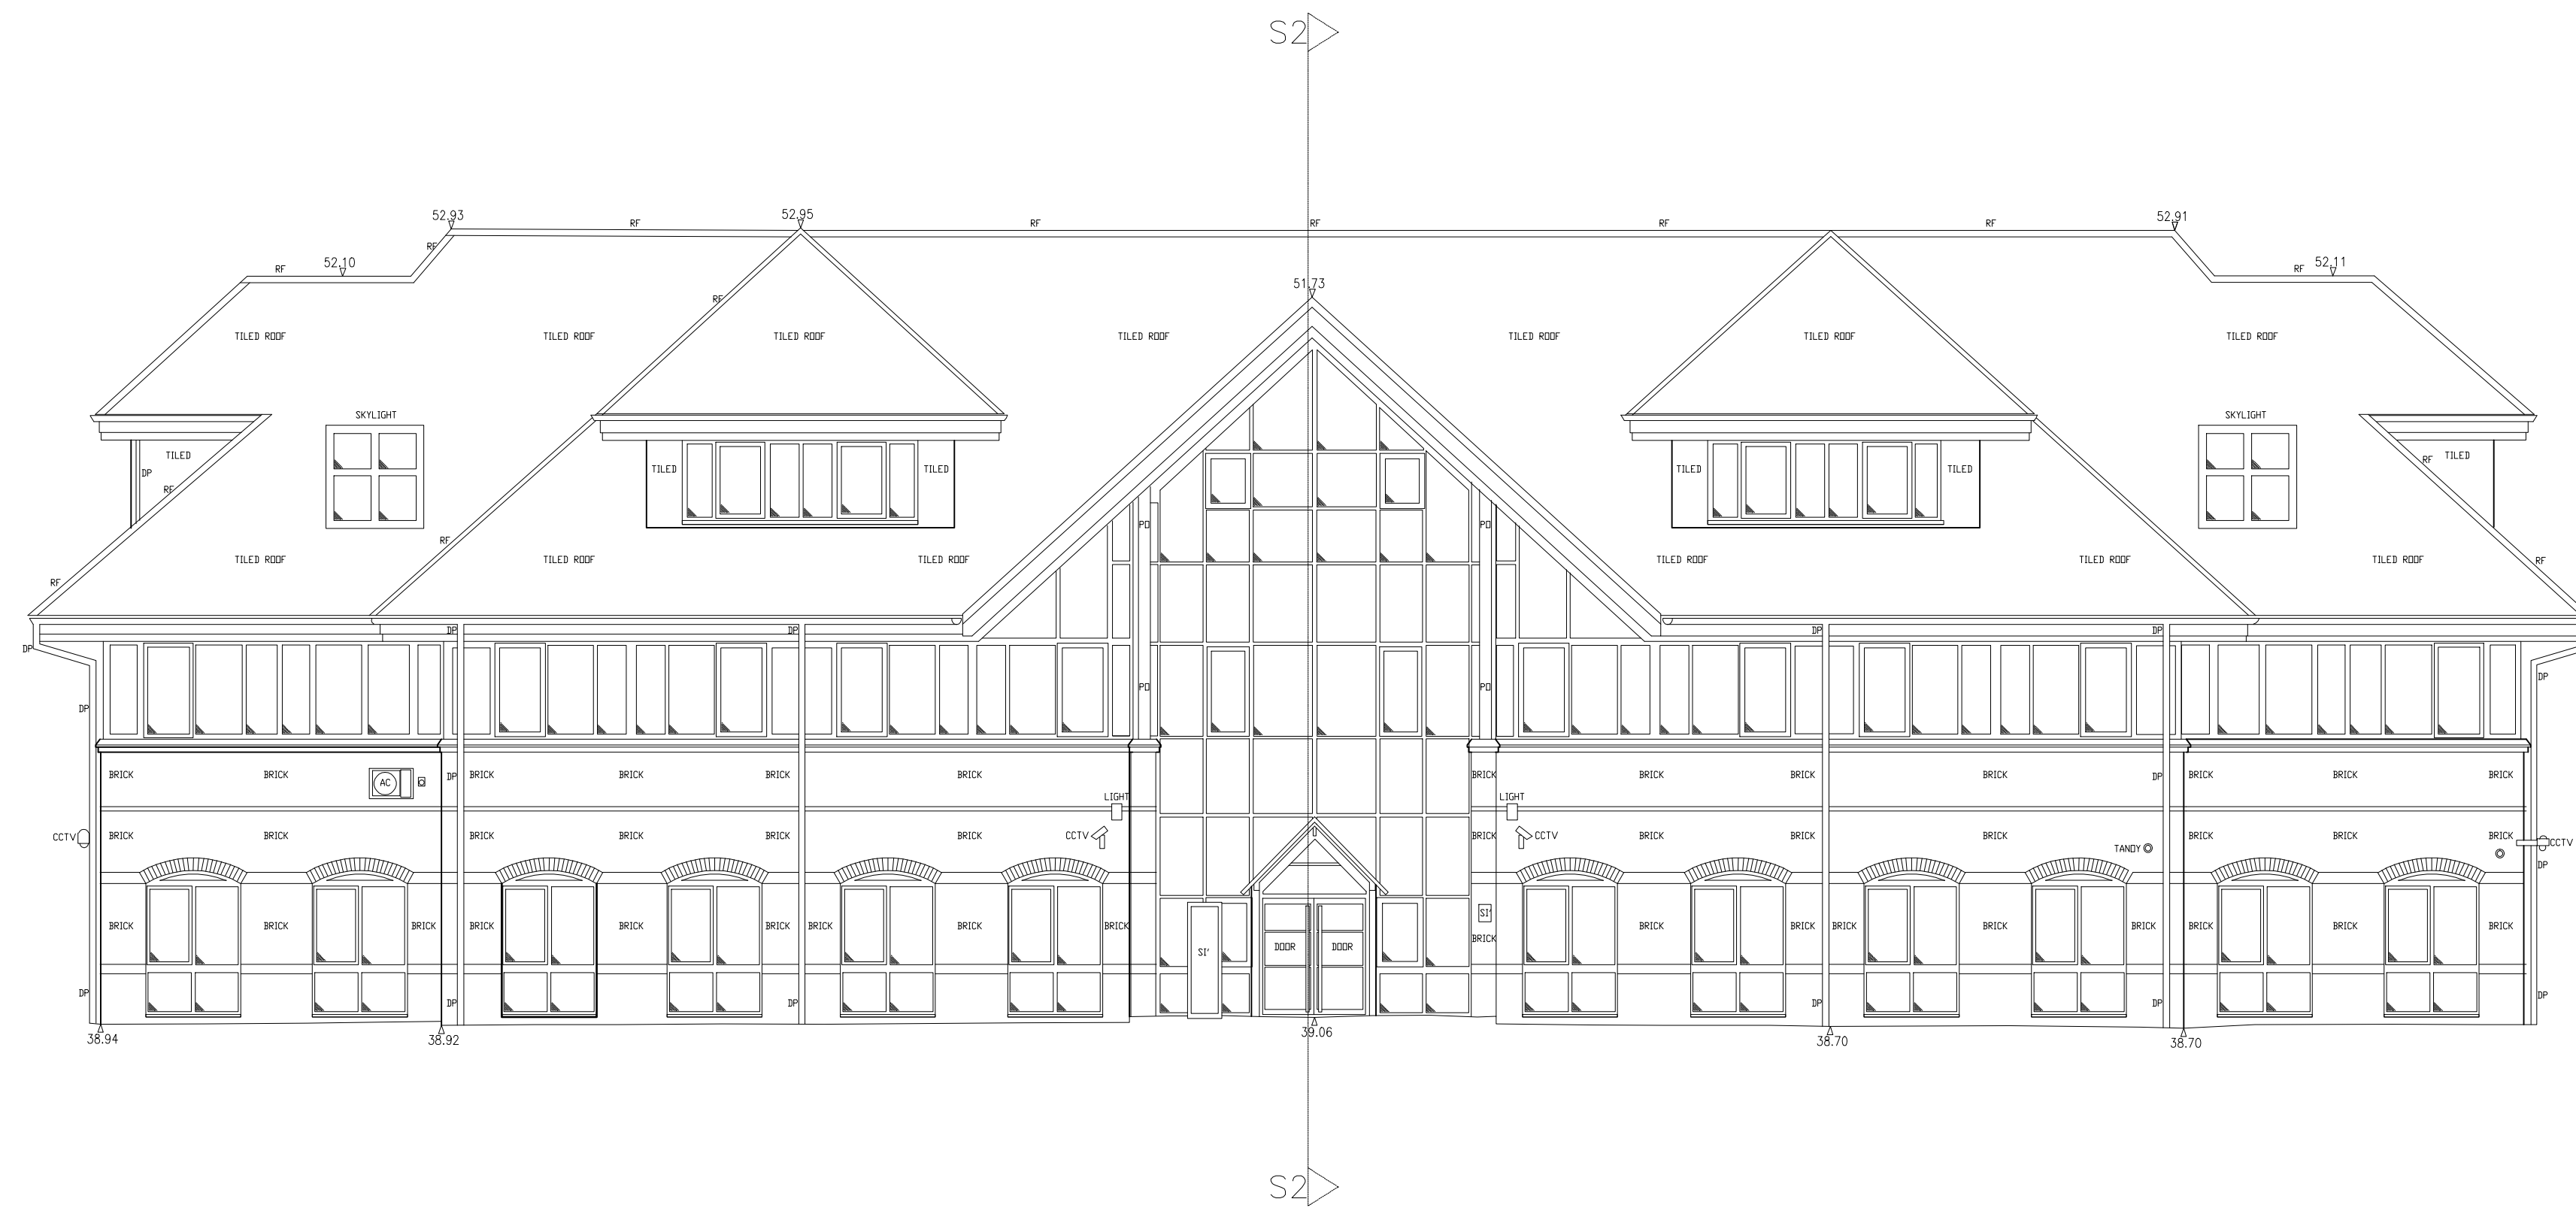

Datum 35M

ELEVATION 1

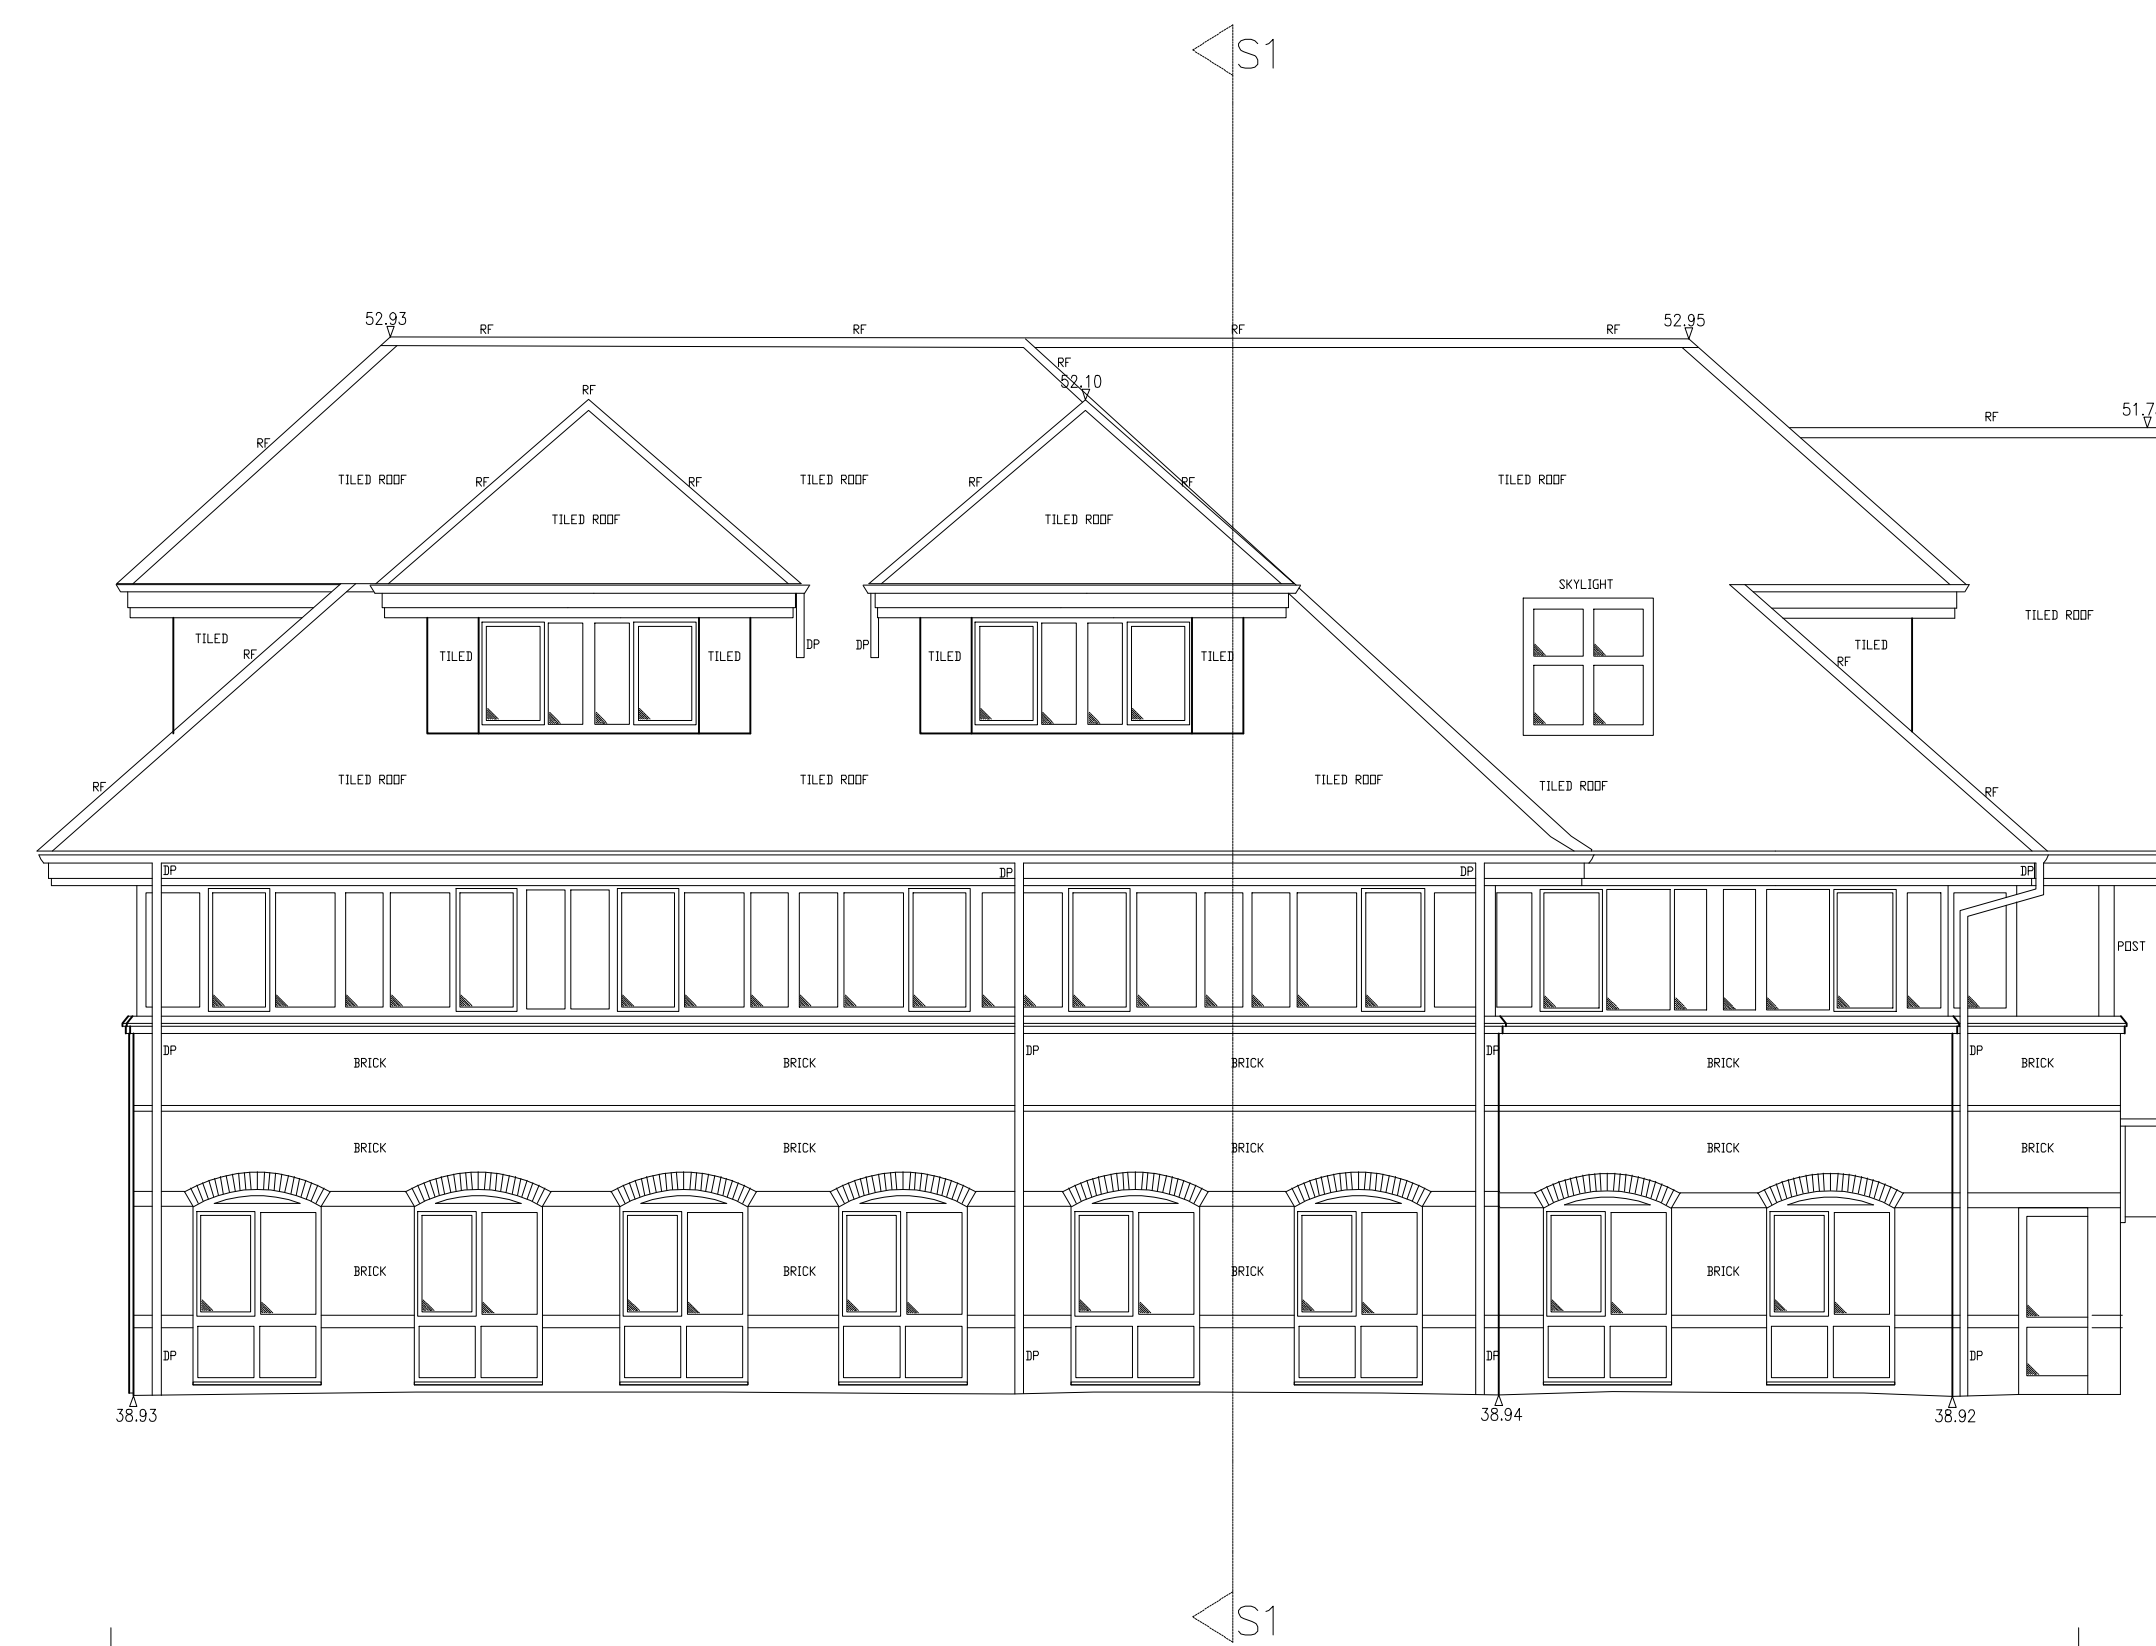

Datum 35M

ELEVATION 2



Rev	Description	Drawn	Date	Ch'kd	App'd
AMENDMENTS					

**UK Building Surveys**  
 15 Broughton Close  
 Grappenhall Heys  
 Warrington  
 Cheshire WA4 3DR  
 Telephone 01925 962048  
 Mobile 07791 393 837  
 E-mail: mark.kidd@ukbuildingsurveys.co.uk

**Site**  
 Title  
**Dorset House,  
 Regents Park,  
 Leatherhead,  
 KT22 7PL**

Surveyed By	MAS	Checked By	HJH	Status	Original
Designed by		Approved By	MAS		
Scale	1:100	Sheet Size	A1	CAD File	UKBS-9311
				Date	10/01/2023
				Existing Elevation 1 & 2	

Drawing No **UKBS-9311** Rev