


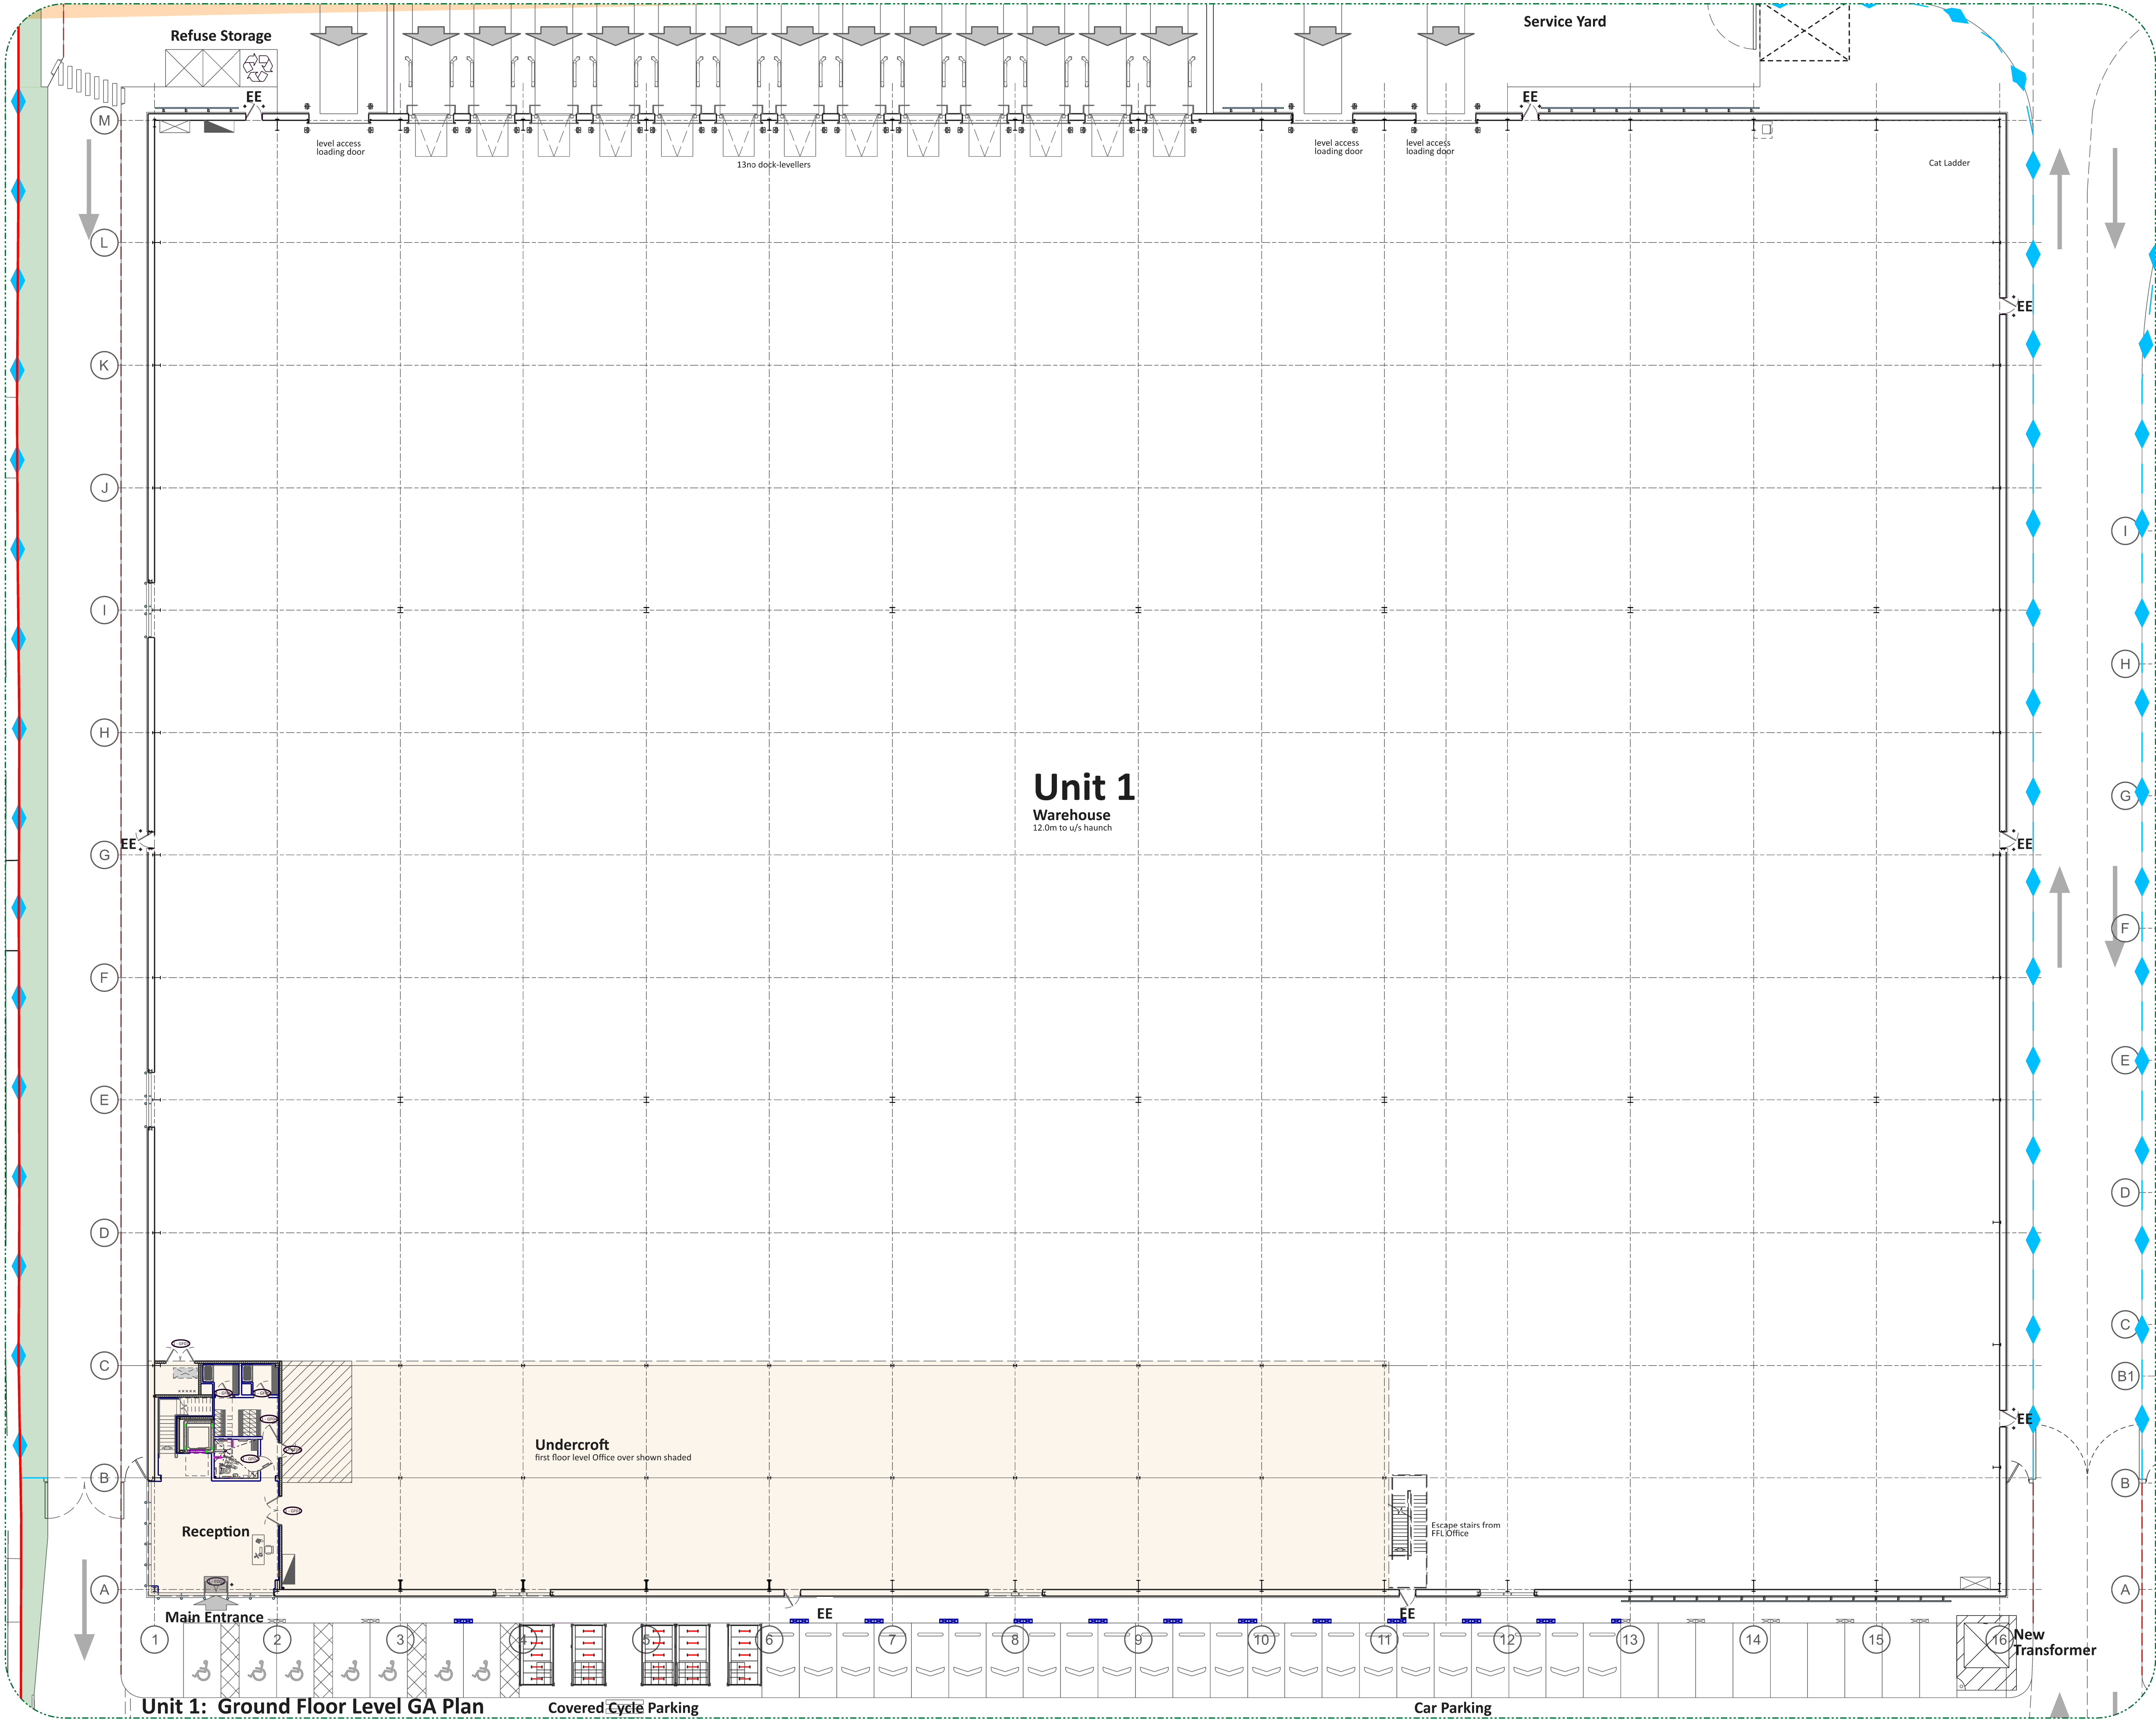

Scale Bar - metres:
0 2 4 6 8 16

N

Proposed tree

Existing Tree
Canopy Spread
RPA shown in pink outline

2.4m Palladin Fence

Timber Knee Rail Fence

Electric charging pedestal

Passive electric charging provision

Protection Barriers (Armco & Bollards)

Note: This drawing incorporates the information last issued for construction under the building contract. This drawing has not been verified by dimensional survey and allowable construction tolerances may have resulted in differences between this drawing and the finished building.

Rev AB1: FINAL AMENDMENT ISSUE
Drawing Status: AS BUILT

Client
TSL

Project
Project Bolt, Fleming Way, Crawley

Title
Unit 01.
Ground Floor Level GA Plan

Scale
1:200@A1

Drawn
HM

Date
22.08.2022

Revision
AB1

Org No.
C227/ 6101

This drawing is copyright. Do not scale from drawing. Subject to accurate site survey.