




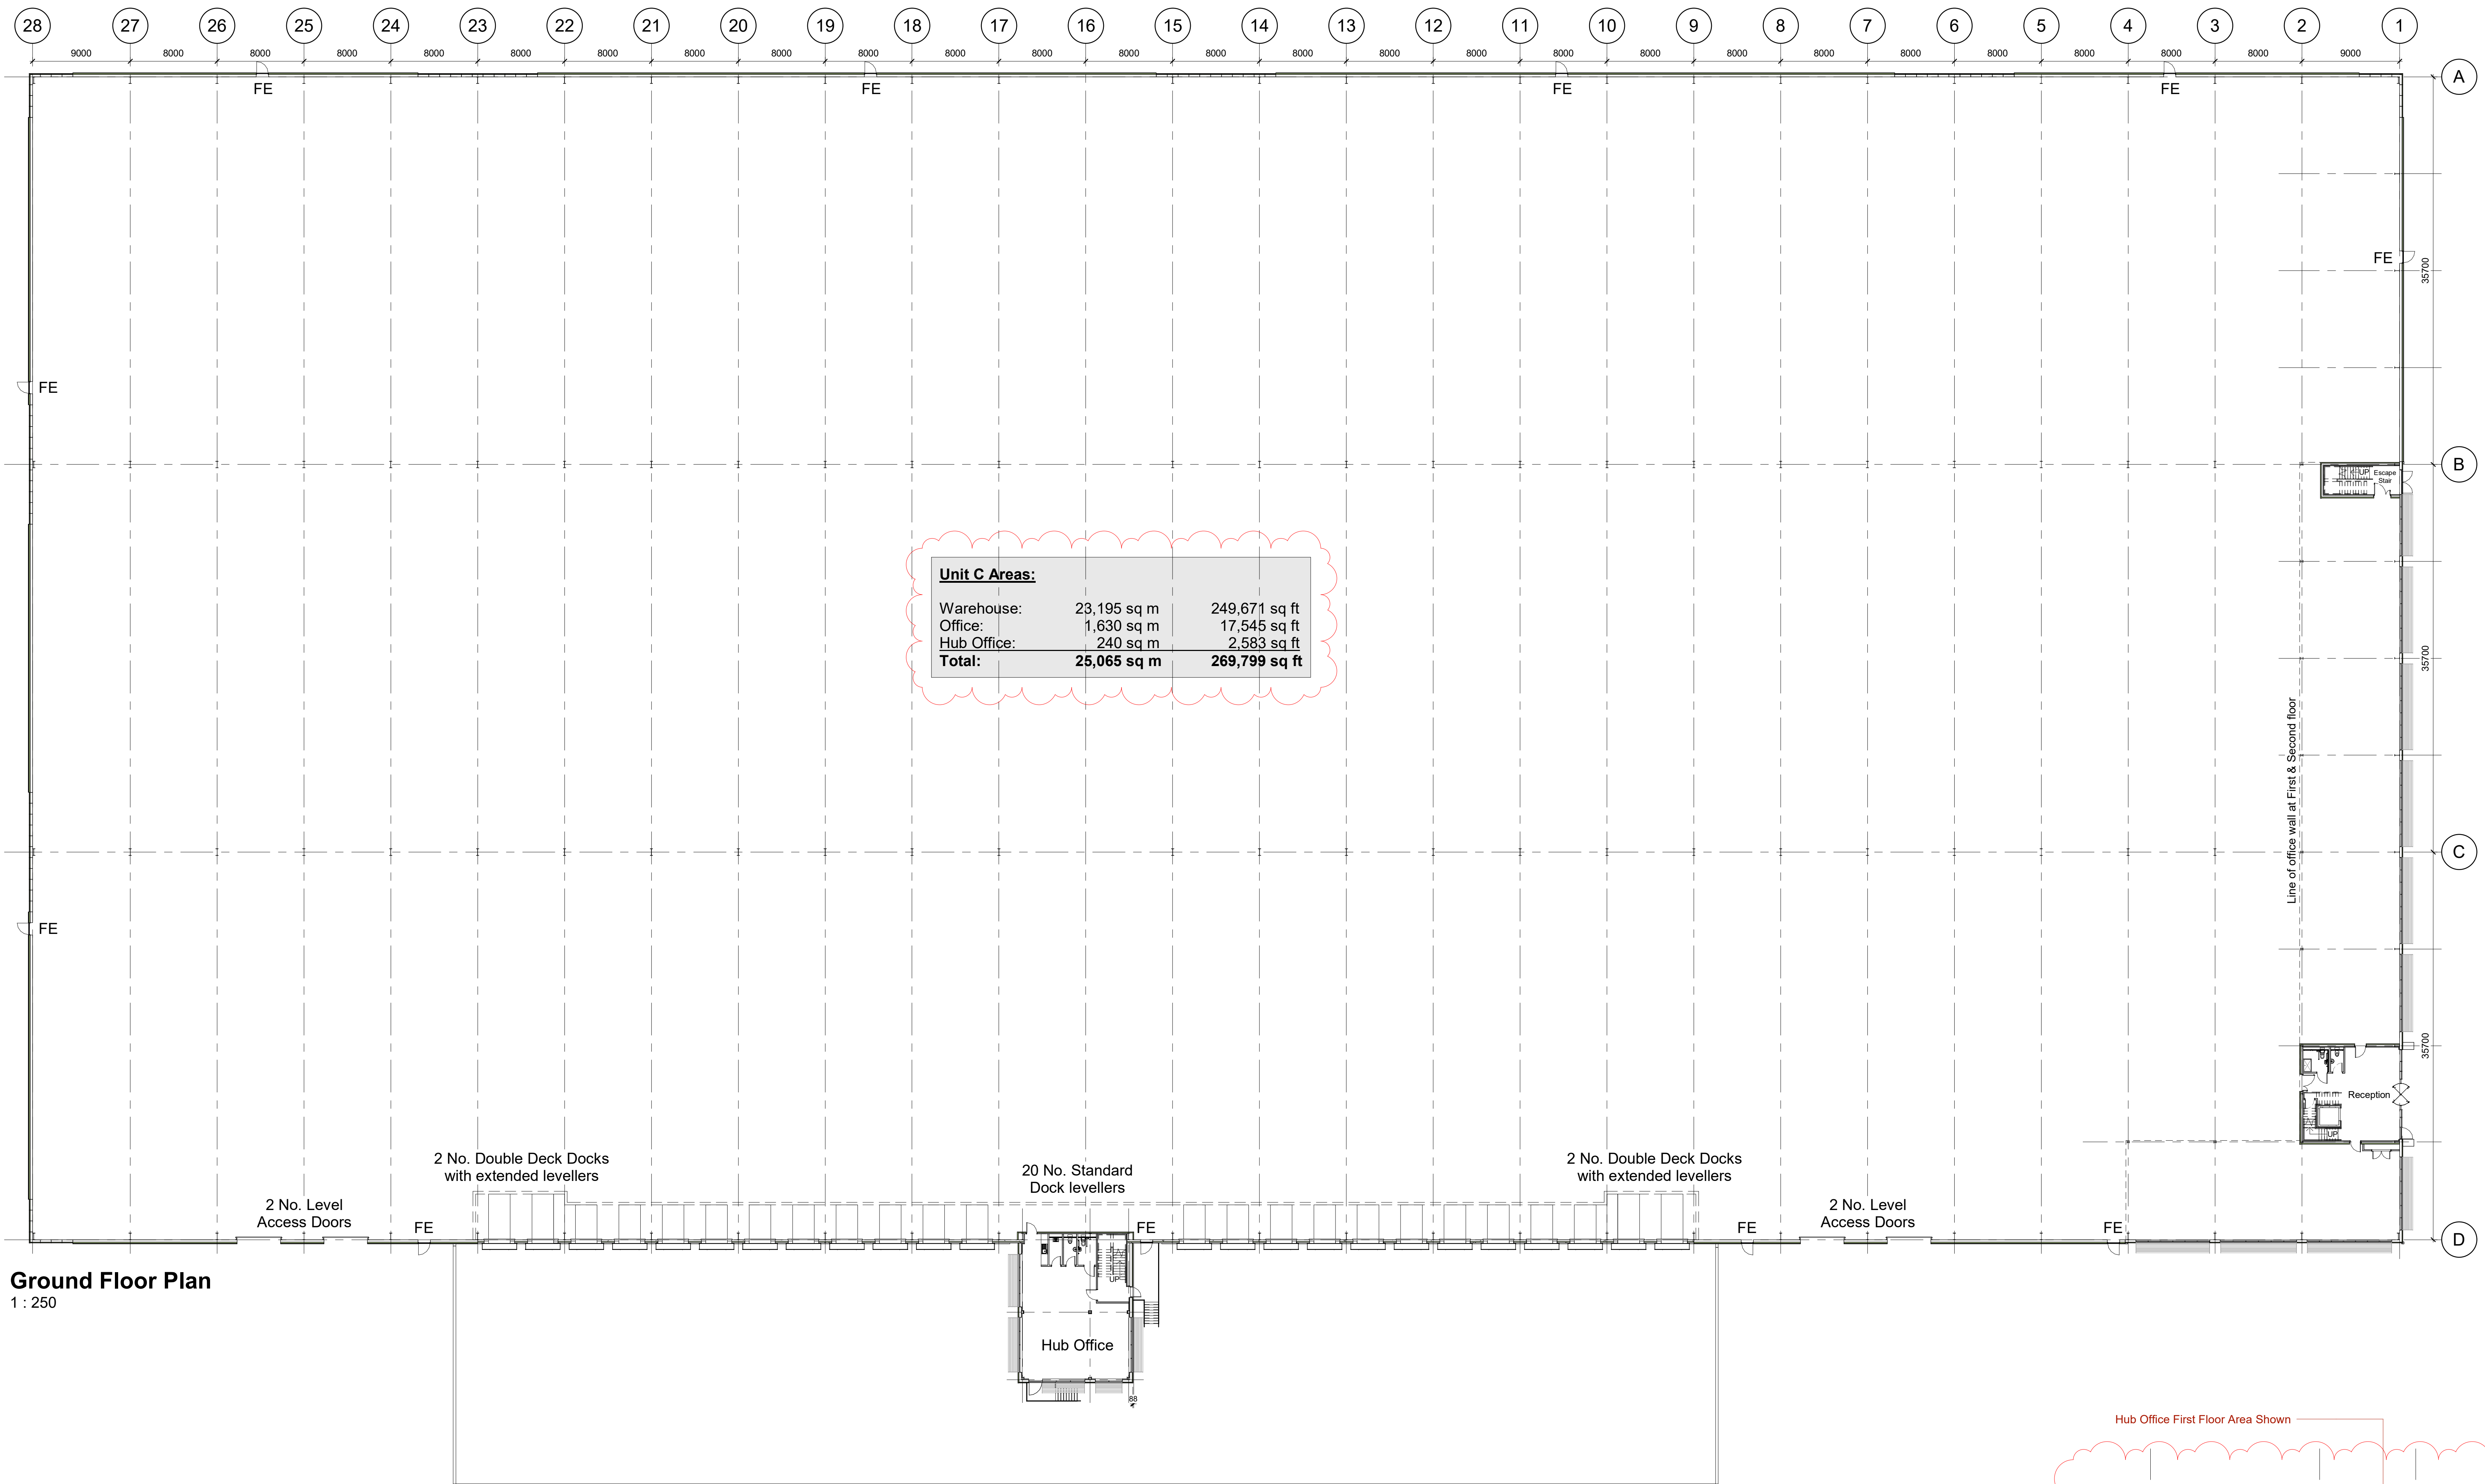


Ground Floor Plan
1 : 250

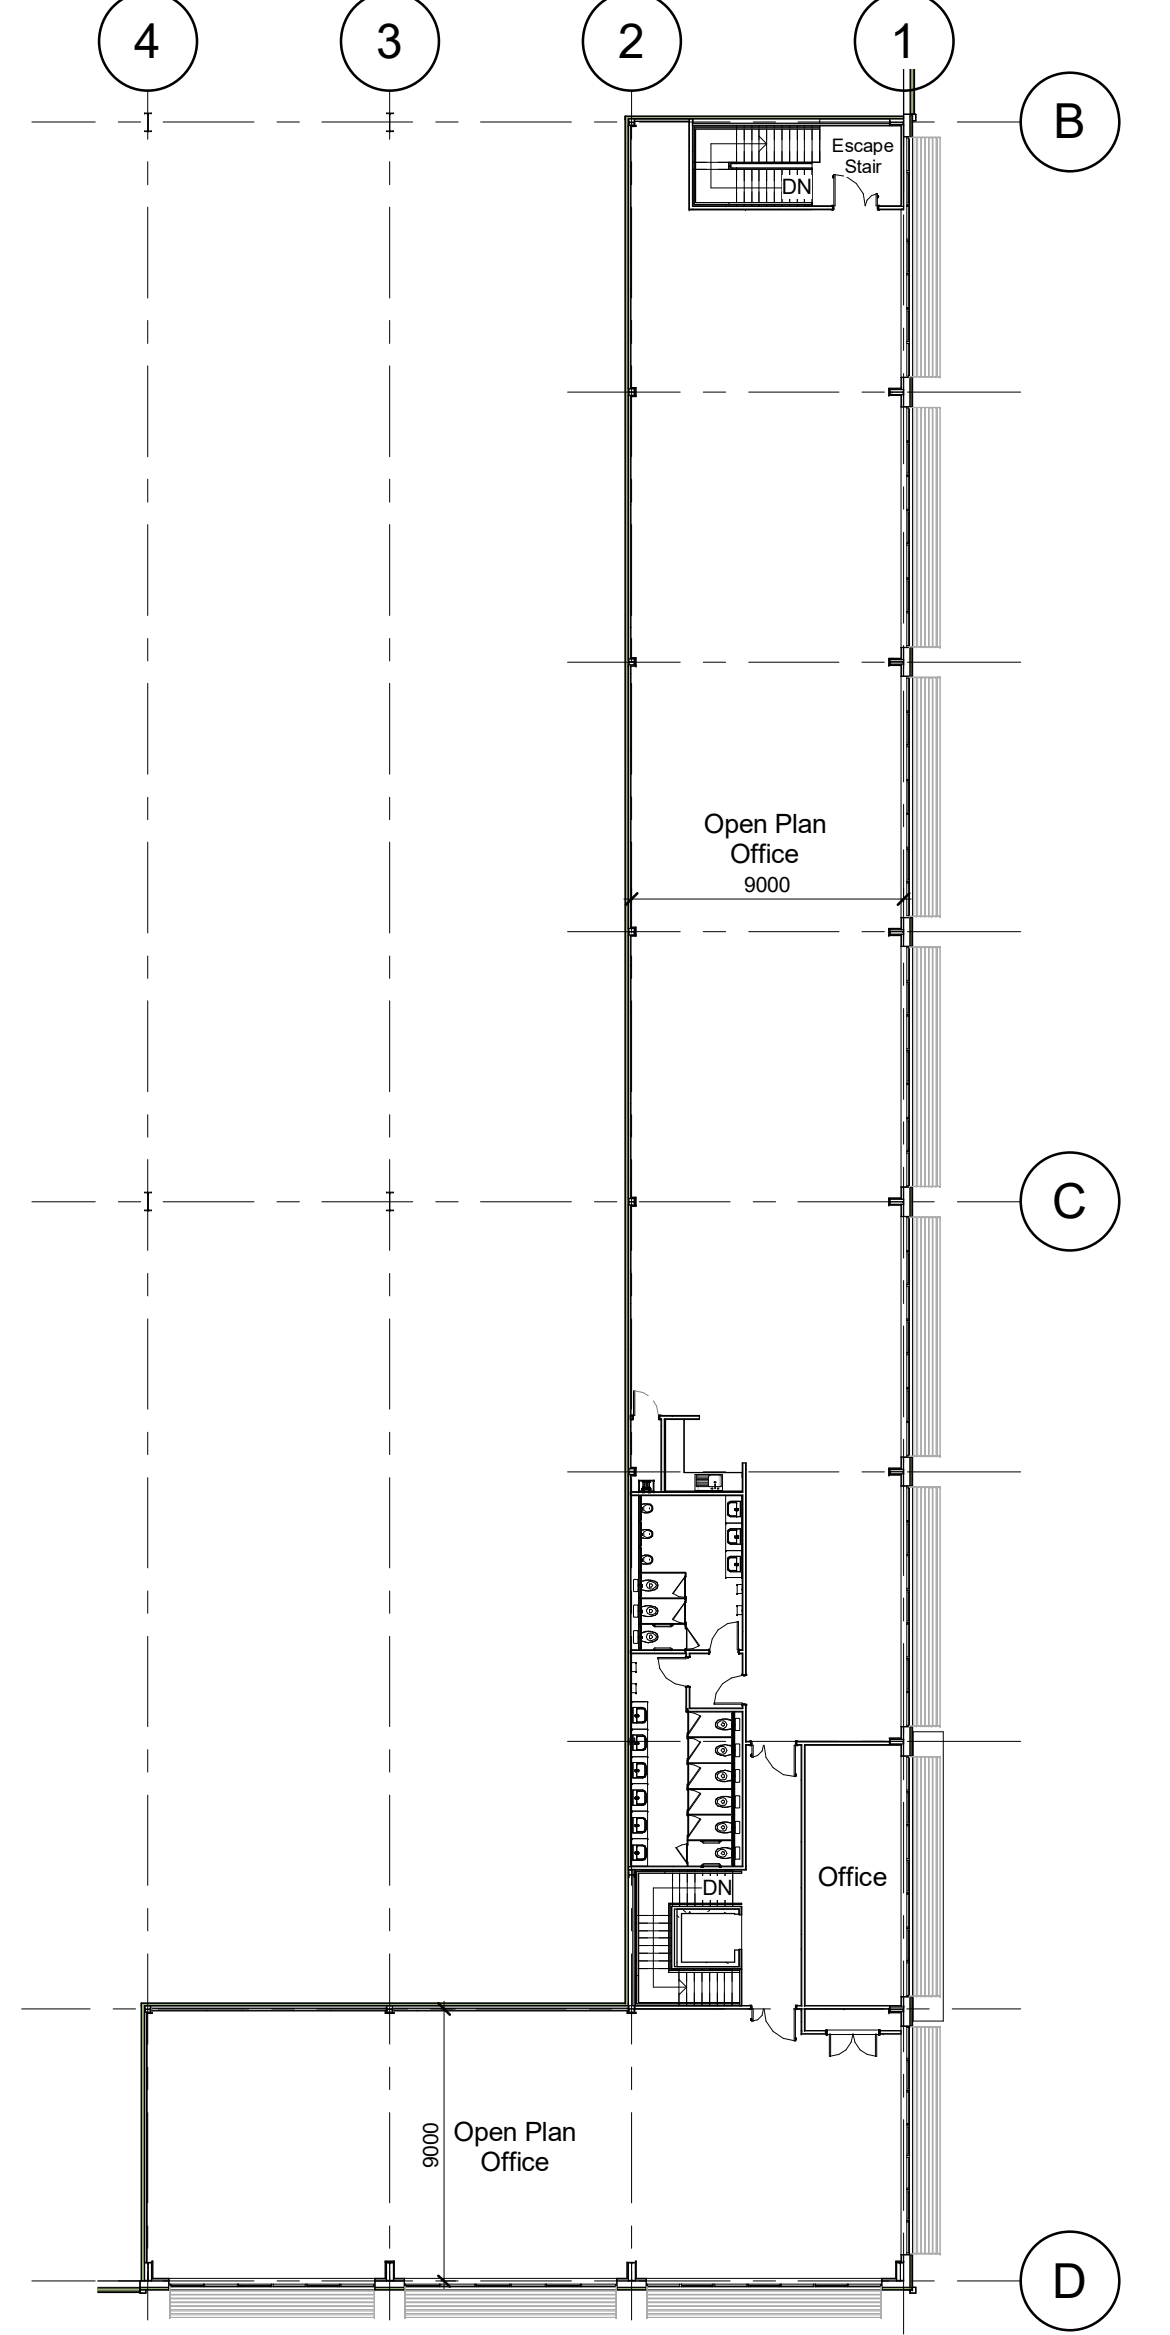

Second Floor Plan
1 : 250

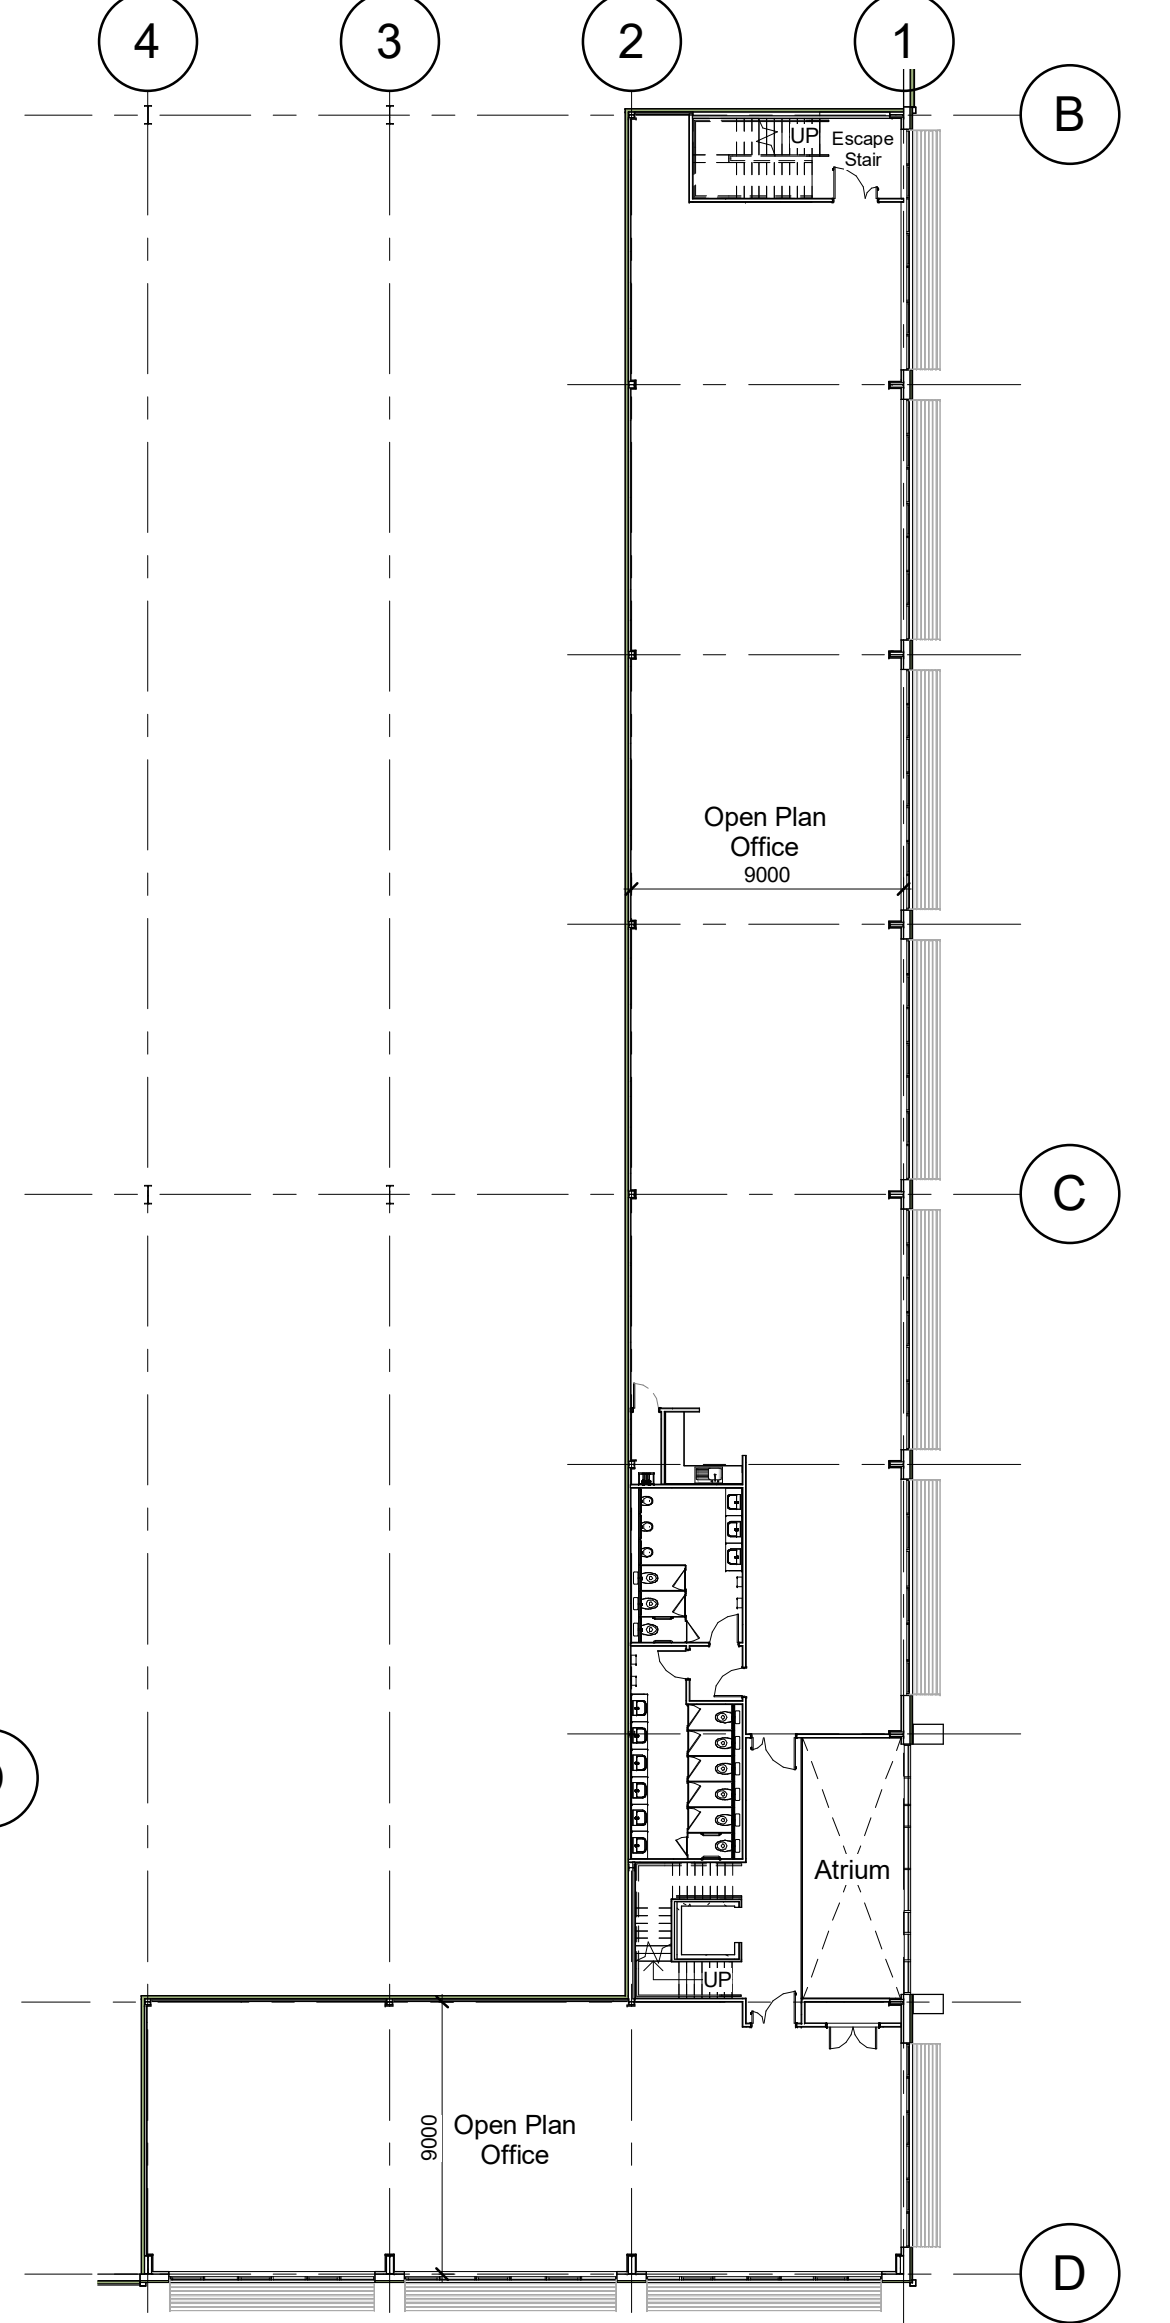


First Floor Plan
1 : 250

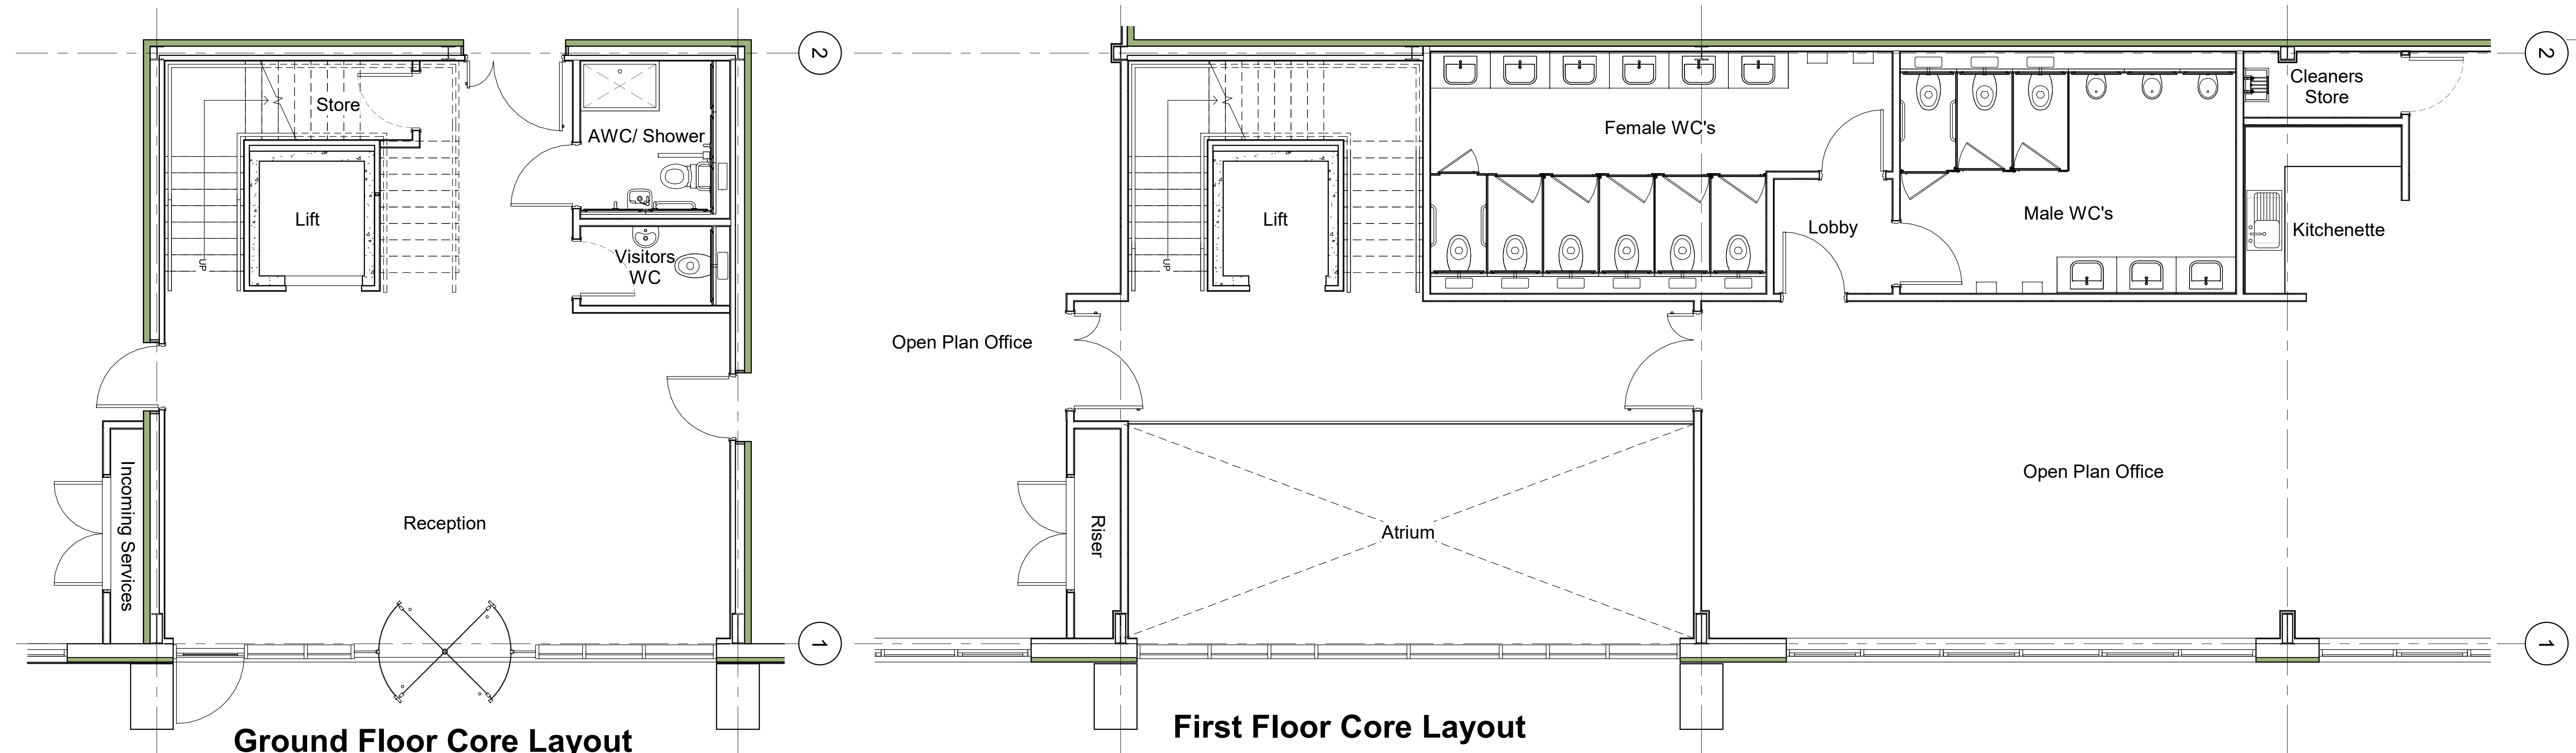


Ground Floor Core Layout
1 : 50

First Floor Core Layout
1 : 50

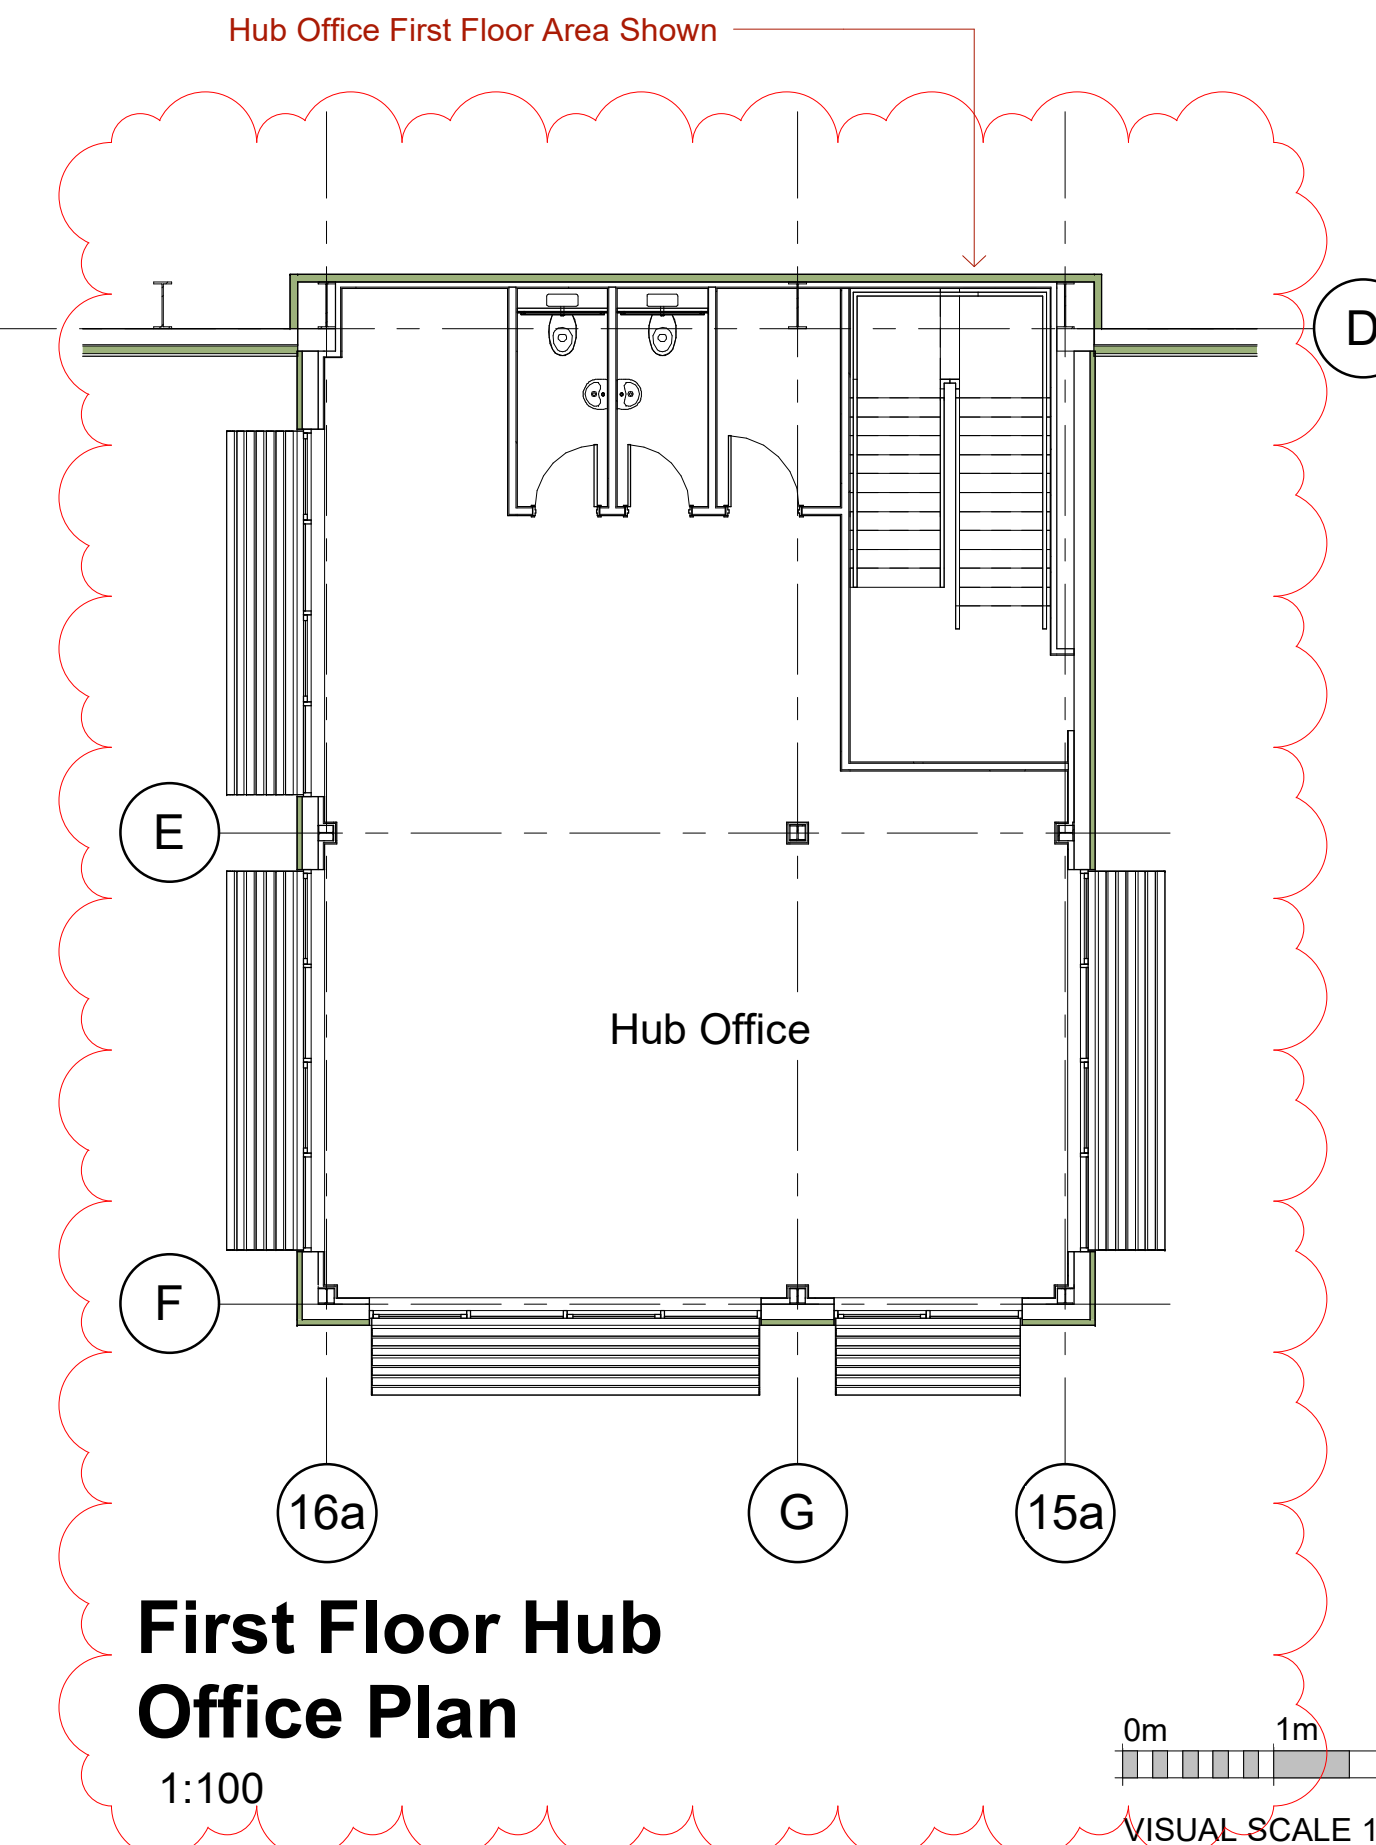

First Floor Hub Office Plan
1:100

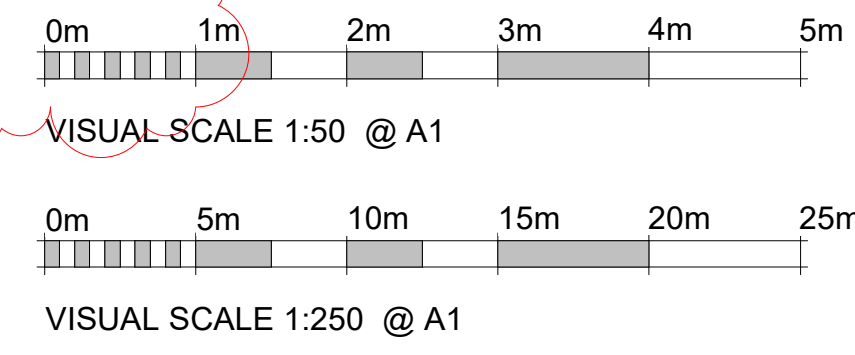

Rev. 04.02.22 DM
P1: Added median chords to First floor Hub Office Plan
P2: Added Hub Office First Floor Plan corrected
P3: Office corner elevation updated as per basement spec. 2
P4: additional vertical bands added along East Elevation and
drawing updated to planning level

06.03.21 MJ

TRITAX SYMMETRY
A TRITAX BIG BOX COMPANY

Rev. 04.02.22 DM
P1: The Old Rectory Rectory Lane Milton Masor
NORTHAMPTON N 7.7 J A Q
t: +44 (0)1604 859916 f: +44 (0)1604 859123
www.peter-haddon.com

Tritax Symmetry
PLOT C - OPTION 1
A41, BICESTER

G.A. FLOOR PLANS

Status MU Checked SH
Date MARCH 2021

4036-C03-006 **P4**

Scale @ A0 As indicated

Copyright reserved. Dimensions to be checked on site.
Discrepancies to be reported before proceeding.