

SIDE ELEVATION SCALE 1:100

FRONT ELEVATION SCALE 1:100

REAR ELEVATION SCALE 1:100

SIDE ELEVATION SCALE 1:100




PLAN SCALE 1:100

ROOF PLAN SCALE 1:100



PRECEDENT IMAGES OF INTERIOR

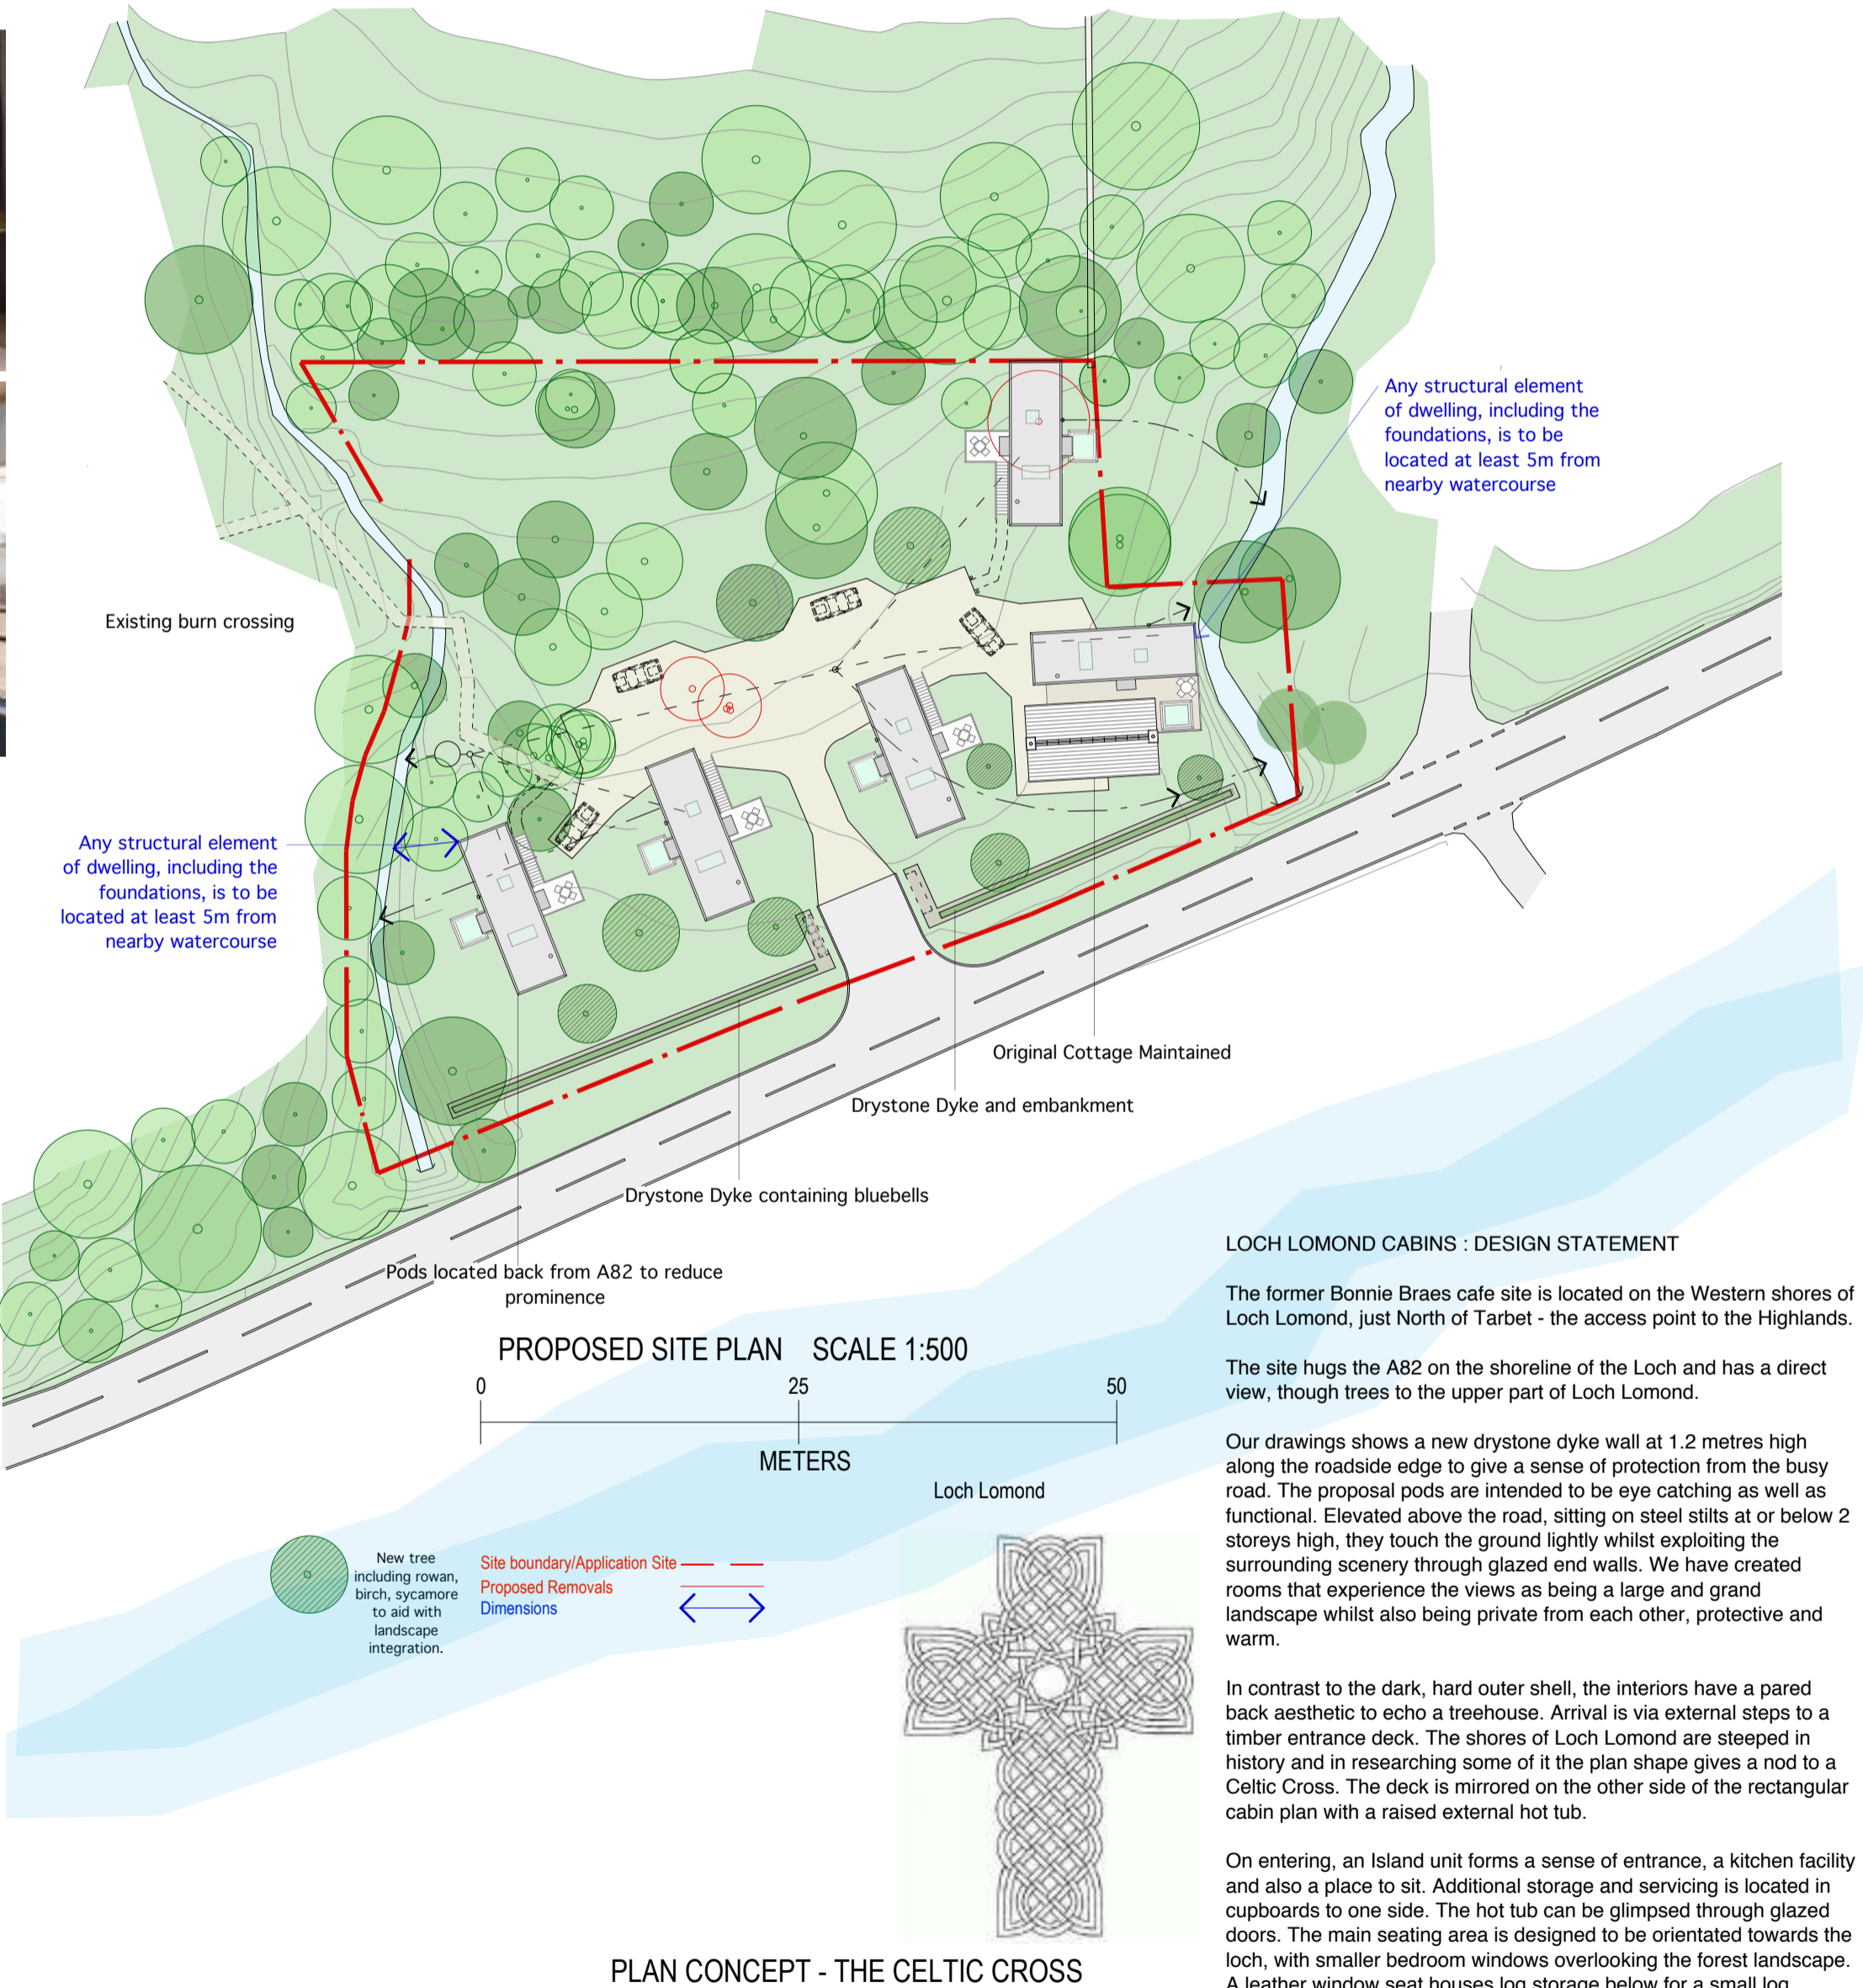

PLAN CONCEPT - THE CELTIC CROSS



IMAGES FROM MODEL

PRECEDENT IMAGES OF VARIOUS HIGH QUALITY 'PODS' SET IN A VARIETY OF NATURAL LANDSCAPES

