


NOTE: DOORS INDICATED IN BLUE TO BE
SPRAYED TO WHITE TO MATCH EXISTING BASE
BUILD WALLS

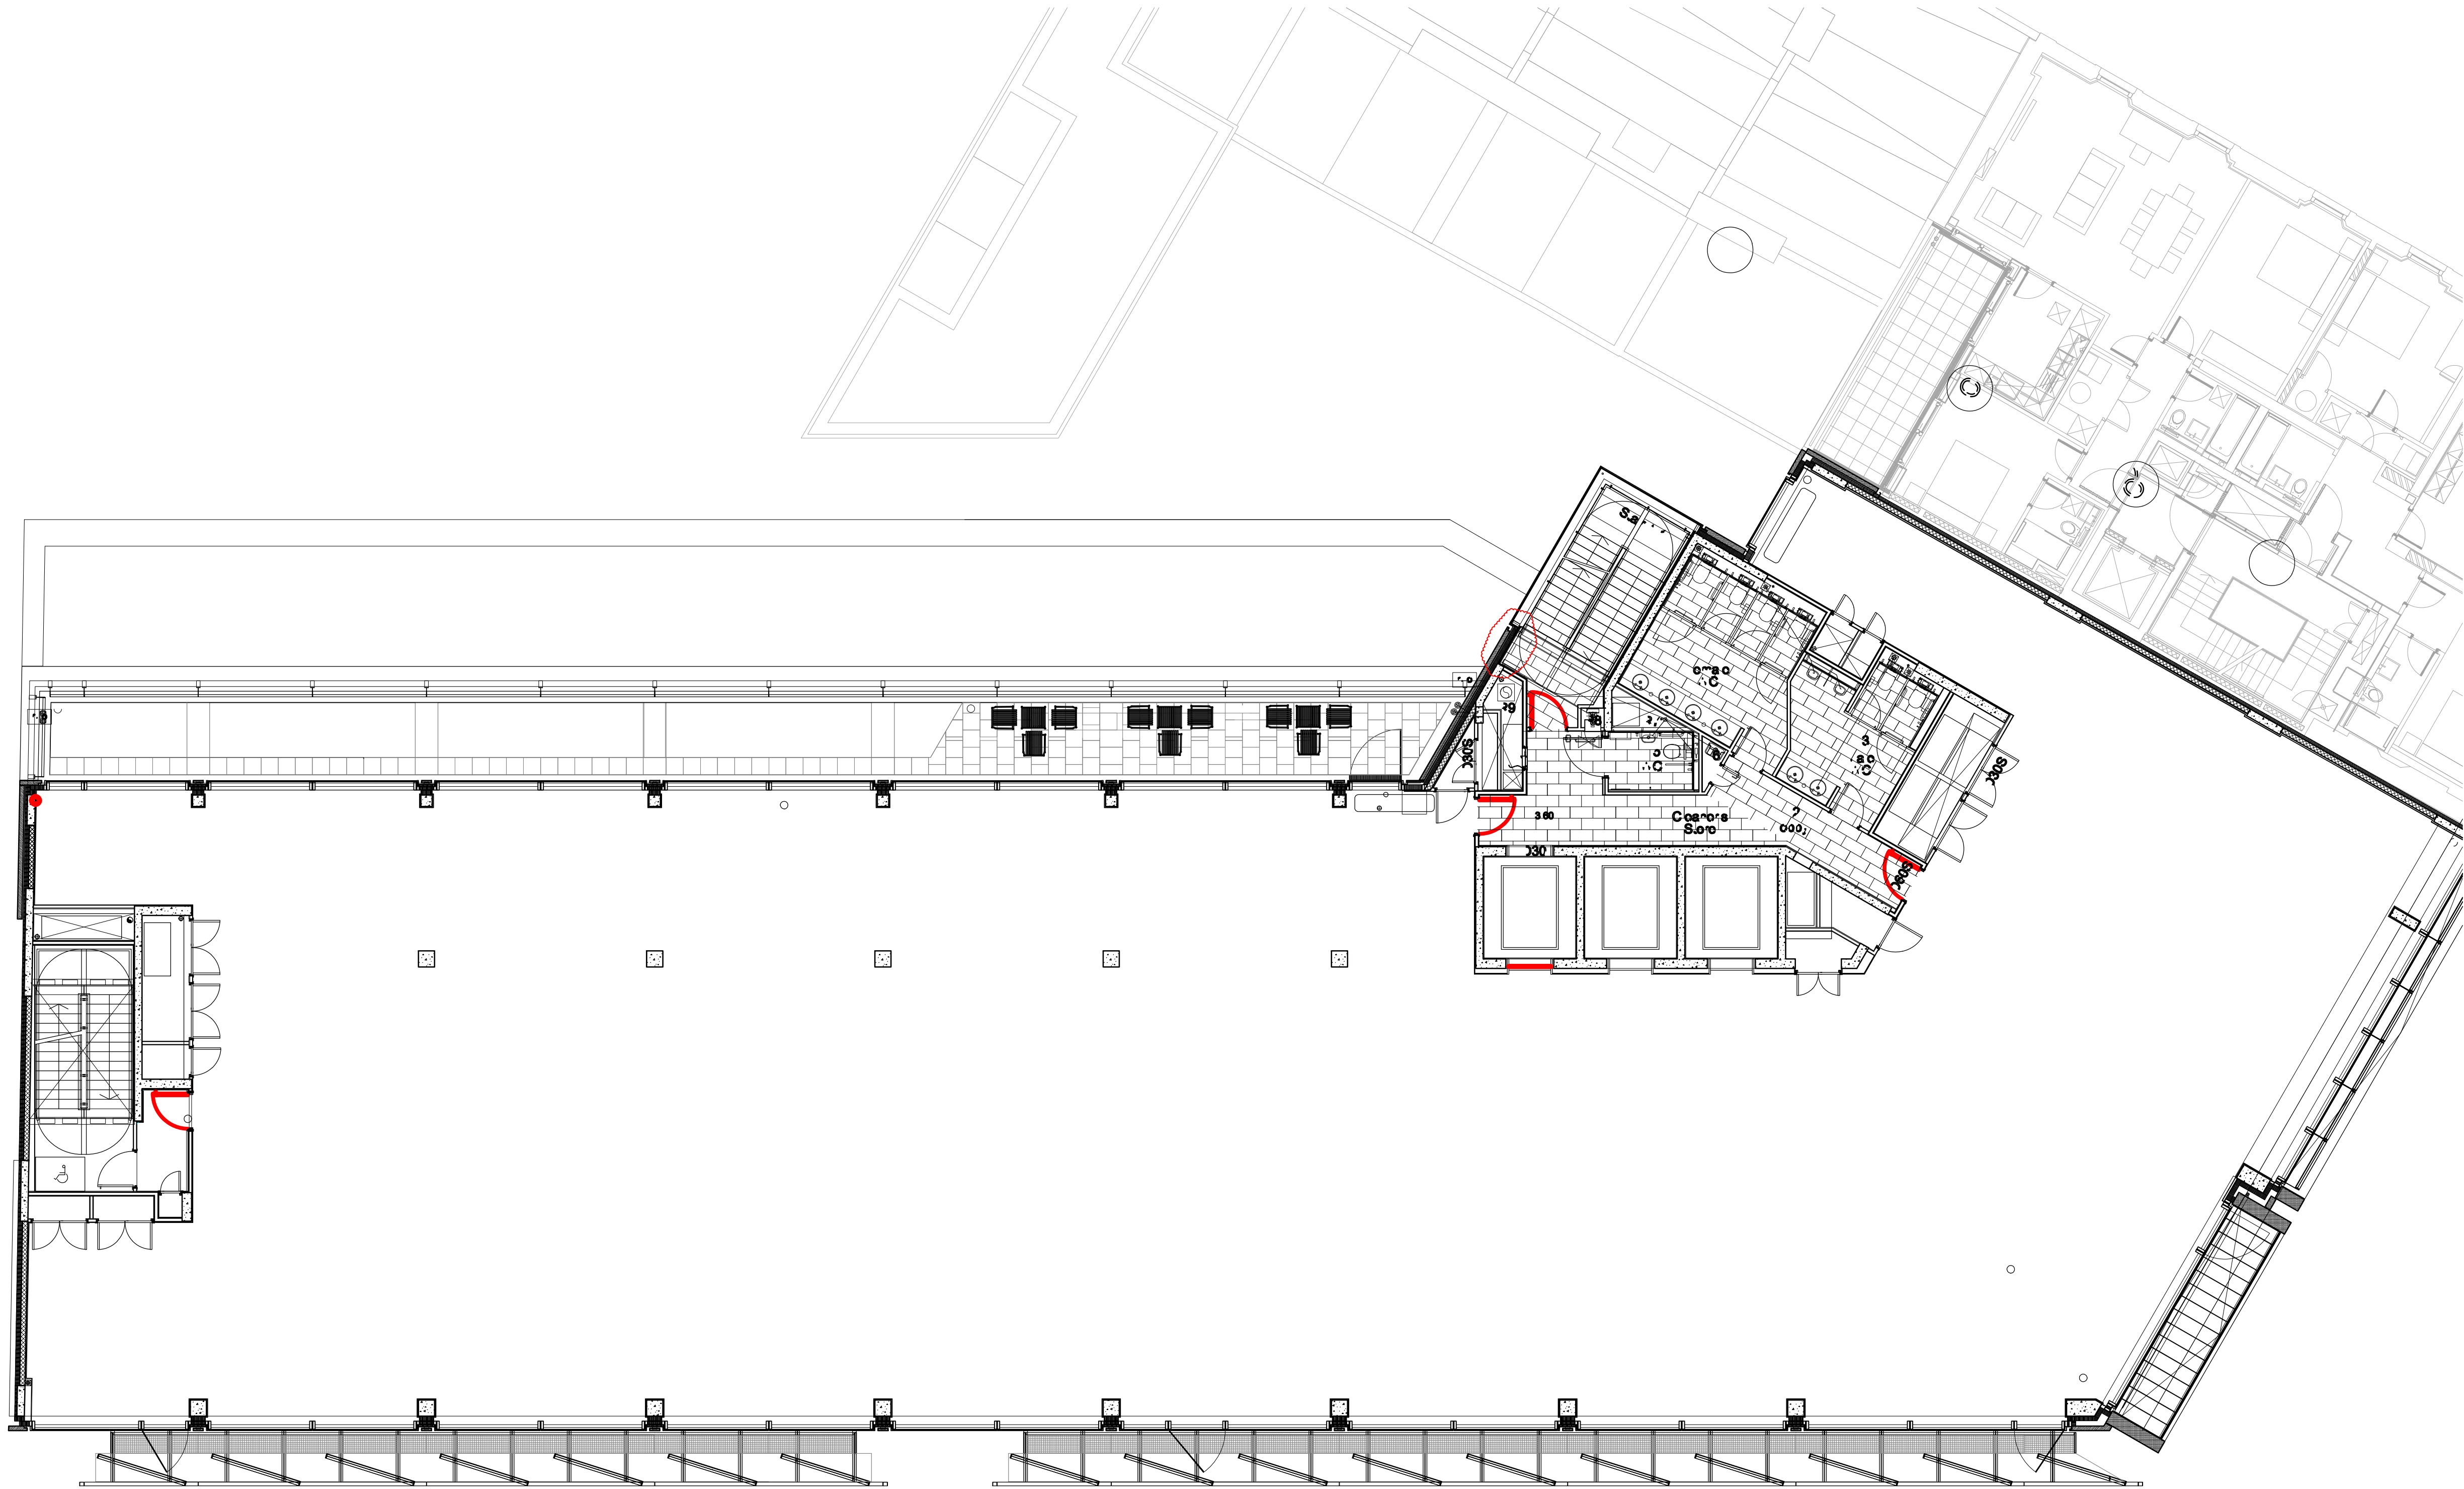

NOTES :
DO NOT SCALE FROM THIS DRAWING. ALL
MEASUREMENTS MUST BE SITE CHECKED BEFORE
THE COMMENCEMENT OF ANY WORK.

IF APPLICABLE:	
DESK SIZE :XX	mm
DESK QTY: XX	desks
SQFT :	

C03	12/10/23			
C02	11/10/23		—	—
C01	01/08/23	DECKING REMOVED	—	—
REV	DATE	ISSUE	BY	CH

STATUS:
FOR CONSTRUCTION



PROJECT :	MARBLE ARCH HOUSE – REFRESH
CLIENT :	BRITISH LAND
LEVEL :	LEVEL 04 CAT A
DESCRIPTION :	LEVEL 04 GENERAL ARRANGEMENT
SCALE :	1:100 @ A1
DRAWING No : J5009_CST_DR_A_04_100_0001	REVISION : C03