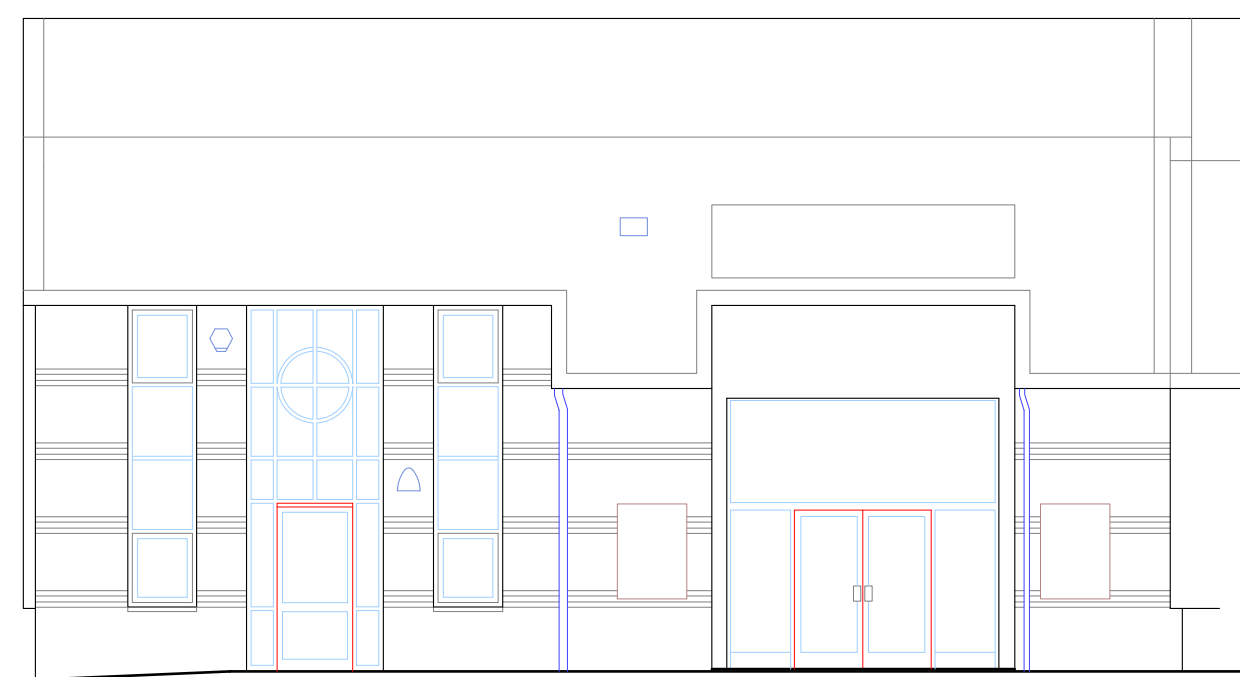


[illegible]


**OS Note:**

The Ordnance Survey file is to be used as a guide only.

OS Buildings  Surveyed Buildings 

This survey has been based on the Ordnance Survey (O.S.) National Grid OSG36(15) via Global Navigational Satellite Systems (GNSS) and the O.S. Active Network (OS Net).

A true OSG36 coordinate has been established near the station via a transformation from the OSTM15GB and OSGM15GB transformation models.


The survey has been correlated to this point and a further one more OSG36(15) points established to create a true O.S. bearing for angle orientation.

No scale factor has been applied to the survey therefore the coordinates shown are arbitrary & not true O.S. Coordinates which have a scale factor applied.

|   |                                                                             |
|---|-----------------------------------------------------------------------------|
| SHt. 1.00<br>HHt. 2.12                                                                              | Sill Height from FFL.<br>Head Height from FFL.                              |
| SL 51.03m<br>HL 52.82m                                                                              | Sill Level from defined datum.<br>Head Level from defined datum.            |
| Susp. CHt. 2.00<br>Struct. CHt. 3.00                                                                | Suspended Ceiling Height from FFL.<br>Structural Ceiling Height from FFL.   |
| Susp. Ceil. 30.00m<br>Struct. Ceil. 31.00m                                                          | Suspended Ceiling Level from datum.<br>Structural Ceiling Level from datum. |
| IFL: 100.00m<br>+100.00m                                                                            | Internal Floor Level (General).<br>Internal Floor Level (Specific).         |
|  Insertion Point | Insertion Point for overlay drawings<br>of other floors or details.         |

[illegible]

\_\_\_\_\_

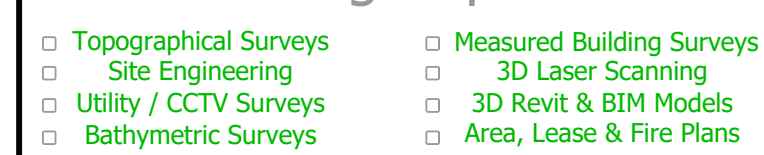

|   |   |   |
|---|---|---|
| www.greenhatch-group.co.uk                                                                                     |   |   |
| St Albans<br>Unit 8, The Courtyard<br>Alban Park<br>St Albans<br>Hertfordshire<br>AL4 0LA<br>t. (01727) 854481 | Newcastle<br>24 Riverside Studios<br>Amethyst Road<br>Newcastle Bus. Park<br>Newcastle-U-Tyne<br>NE4 7YL<br>t. (01912) 736391 | Central London<br>27 Cornwall Terrace Mews<br>Regents Park<br>London<br>NW1 5LL<br>t. (0207) 2241806 |

**The Milton Group**

**Dundee Wa  
Enfield  
EN3 7SX**

|            |          |
|------------|----------|
| SCALE      | DATE     |
| A0@ 1: 100 | Nov 2024 |

|                    |                  |
|--------------------|------------------|
| <i>Level datum</i> | <i>Arbitrary</i> |
|--------------------|------------------|

|              |      |
|--------------|------|
| Drawing No.  | Rev. |
| 52685 02 PES | 0    |

*All dimensions should be checked on site prior to design and construction.*

*Some services may have been omitted due to parked vehicles.*

*Drainage information (where applicable) has been visually inspected from the surface and therefore should be treated as approximate only.*

Notes: