



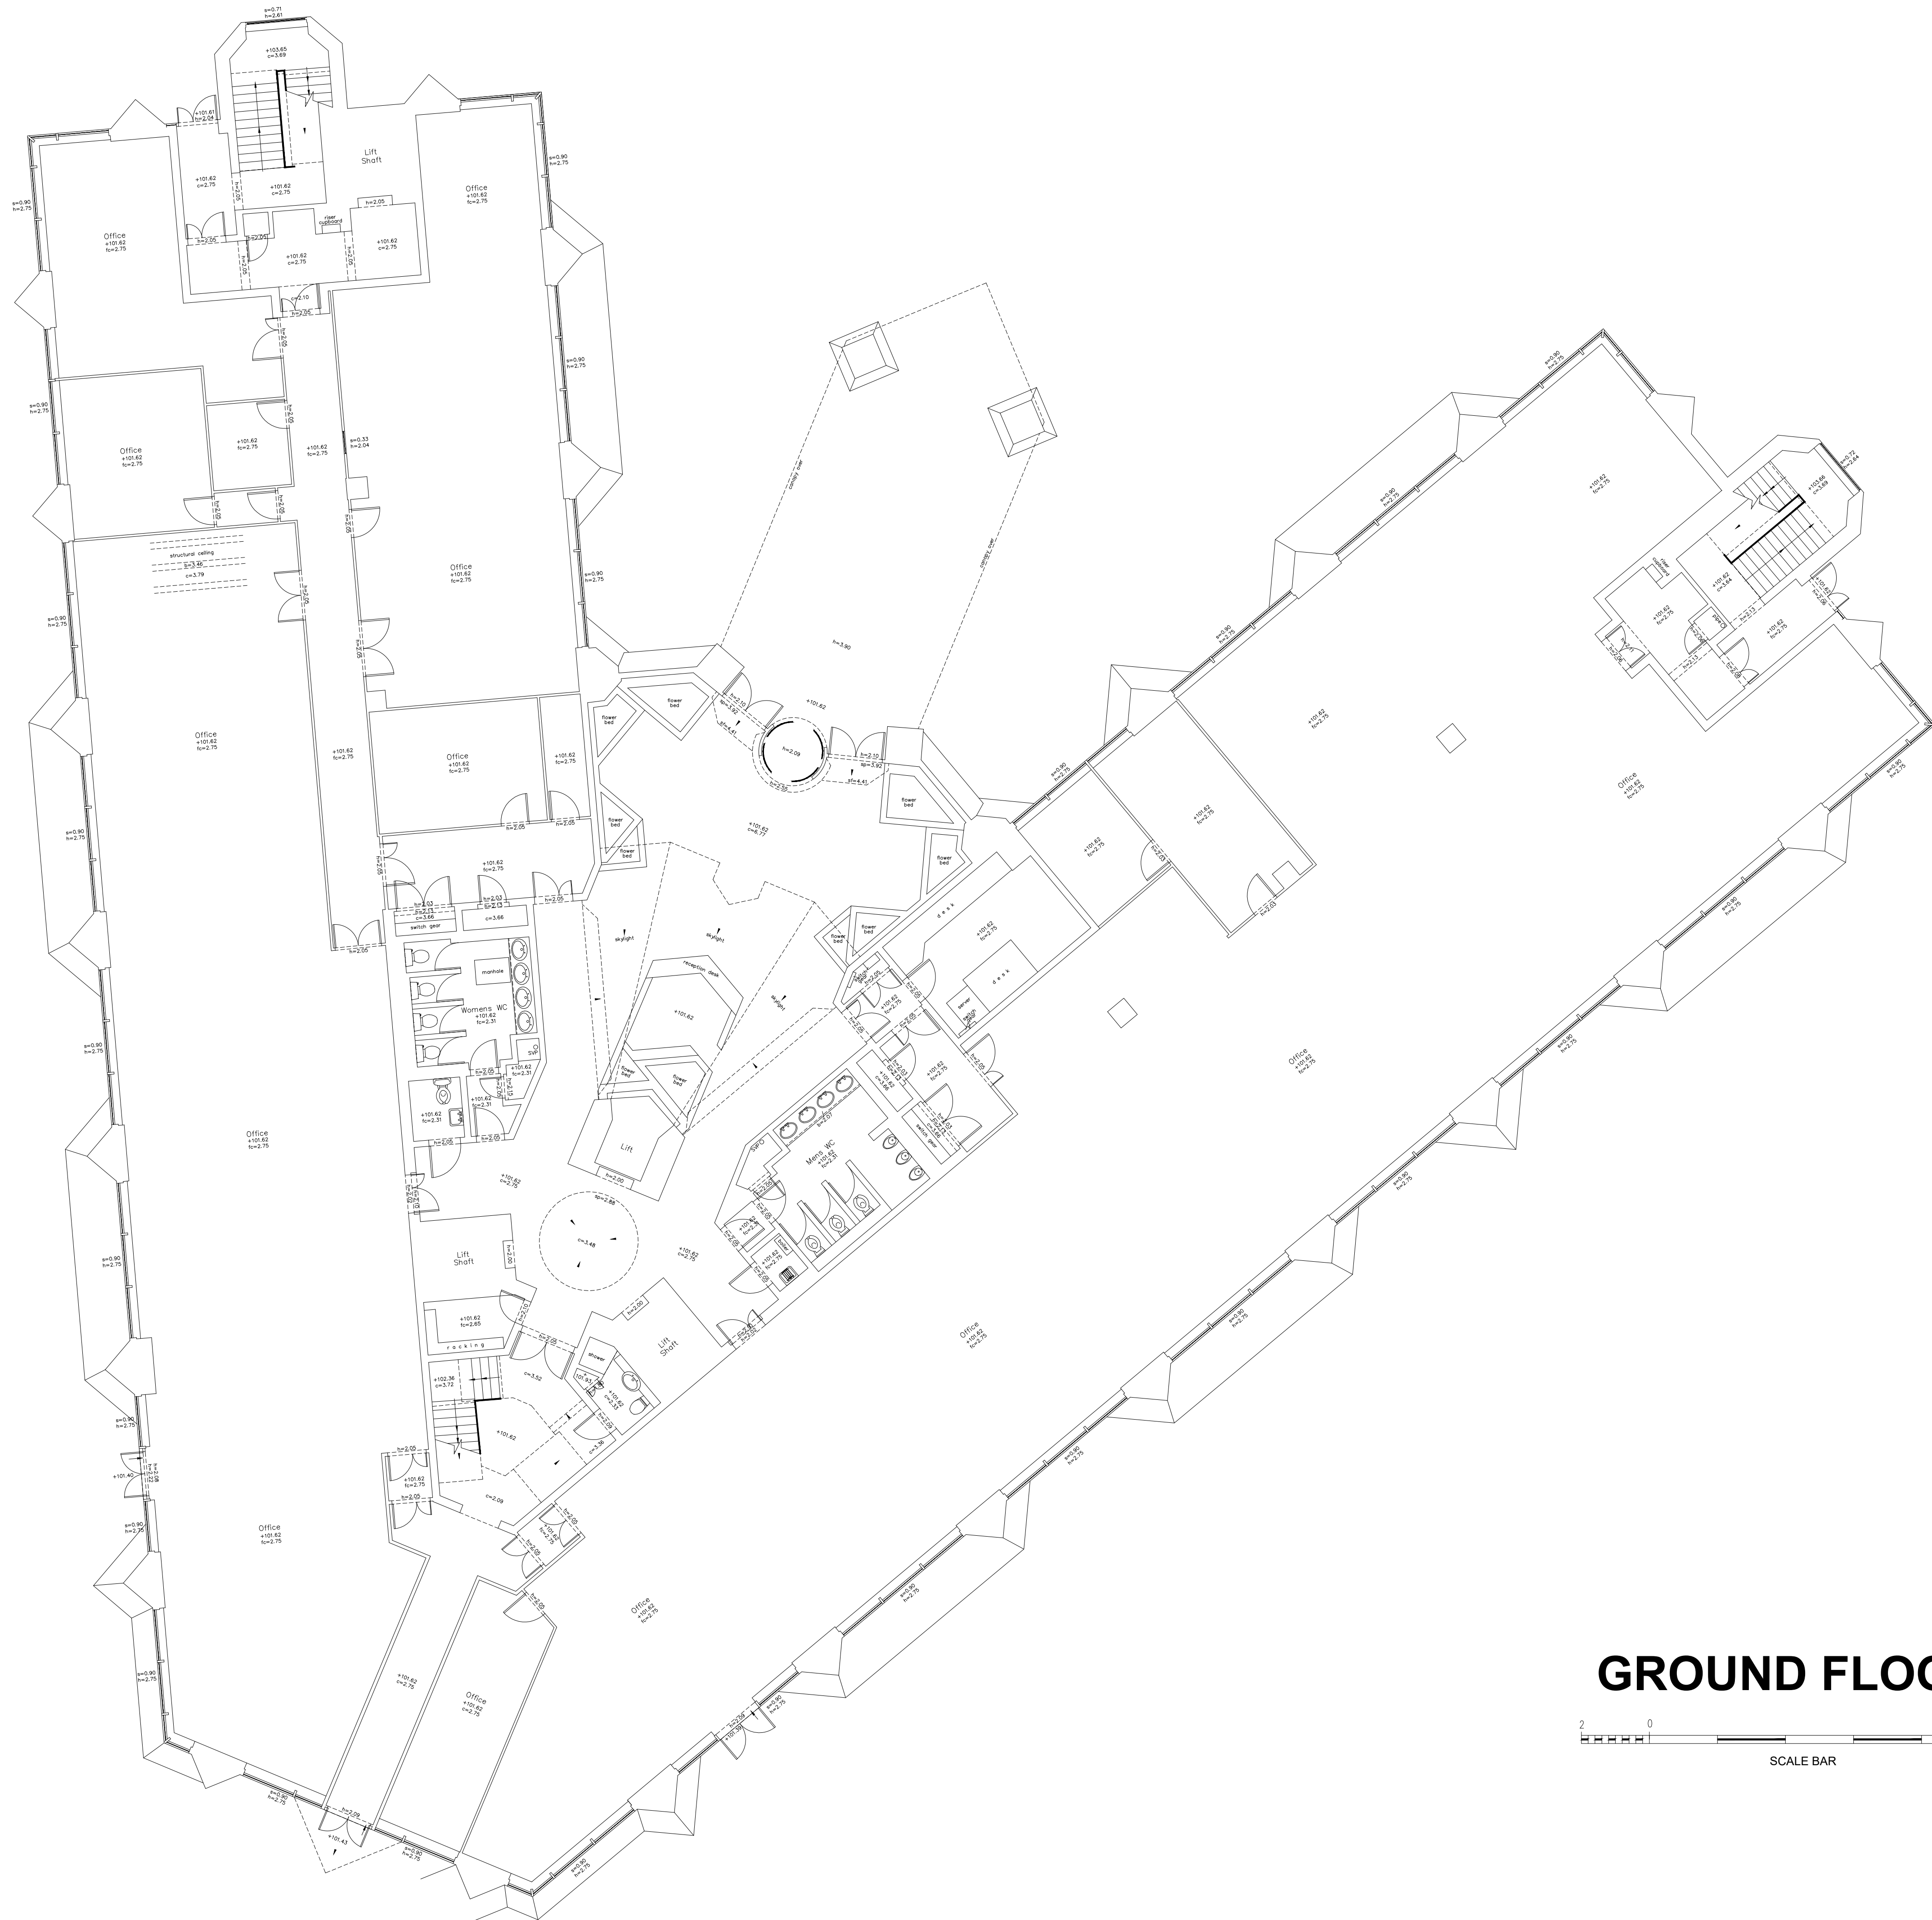

© COPYRIGHT RESERVED
Do Not Scale From Paper Copies

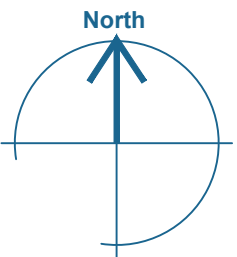

All levels related to Ordnance Survey active GPS network, at survey station S3.

KEY

Section Line

Box partition

Step/Ramp up

Stair cut line

Overhead Feature

Fit Mark

Radiator

Slope up

Elevation Location

Approximate/Assumed Position

ABBREVIATIONS

p = Plinth Height
s = Sill Height
h = Head Height
c = Ceiling Height
b = Beam Height
sp = Spring Point Height
fc = False Ceiling Height
sc = Structural Ceiling Height
sf = Soffit Height

RL = Ridge Level
EL = Eaves Level
RFL = Roof Level
SFL = Soffit Level
THL = Threshold Level
FFL = Finished Floor Level
PWL = Parapet Wall Level
+35.20 = Levels
+52.76 = Elevation level
JB = Junction Box
RSJ = Rolled Steel Joist
WT = Worktop

AB = Air Brick
AHU = Air Handling Unit
AV = Air Vent
CB = Cupboard

Client
**PEGASUS PLANNING GROUP
(LONDON)**

Project
**ELSTREE TOWER, ELSTREE WAY,
BOREHAMWOOD, WD6 1SD**

Title
FLOOR PLAN

Drawing Number
TS22-292-ET-1

Revision	Description	Rev. By	Date

Scale	1:100@A1	Sheet	1 of 8
Drawn by	AB	Checked by	PG
		Date of Survey	JULY 2022


 **TERRAIN
SURVEYS**

Tel: 01438 841300
www.terrain-surveys.co.uk
enquiries@terrain-surveys.co.uk


Accreditations:



© COPYRIGHT RESERVED
Do Not Scale From Paper Copies

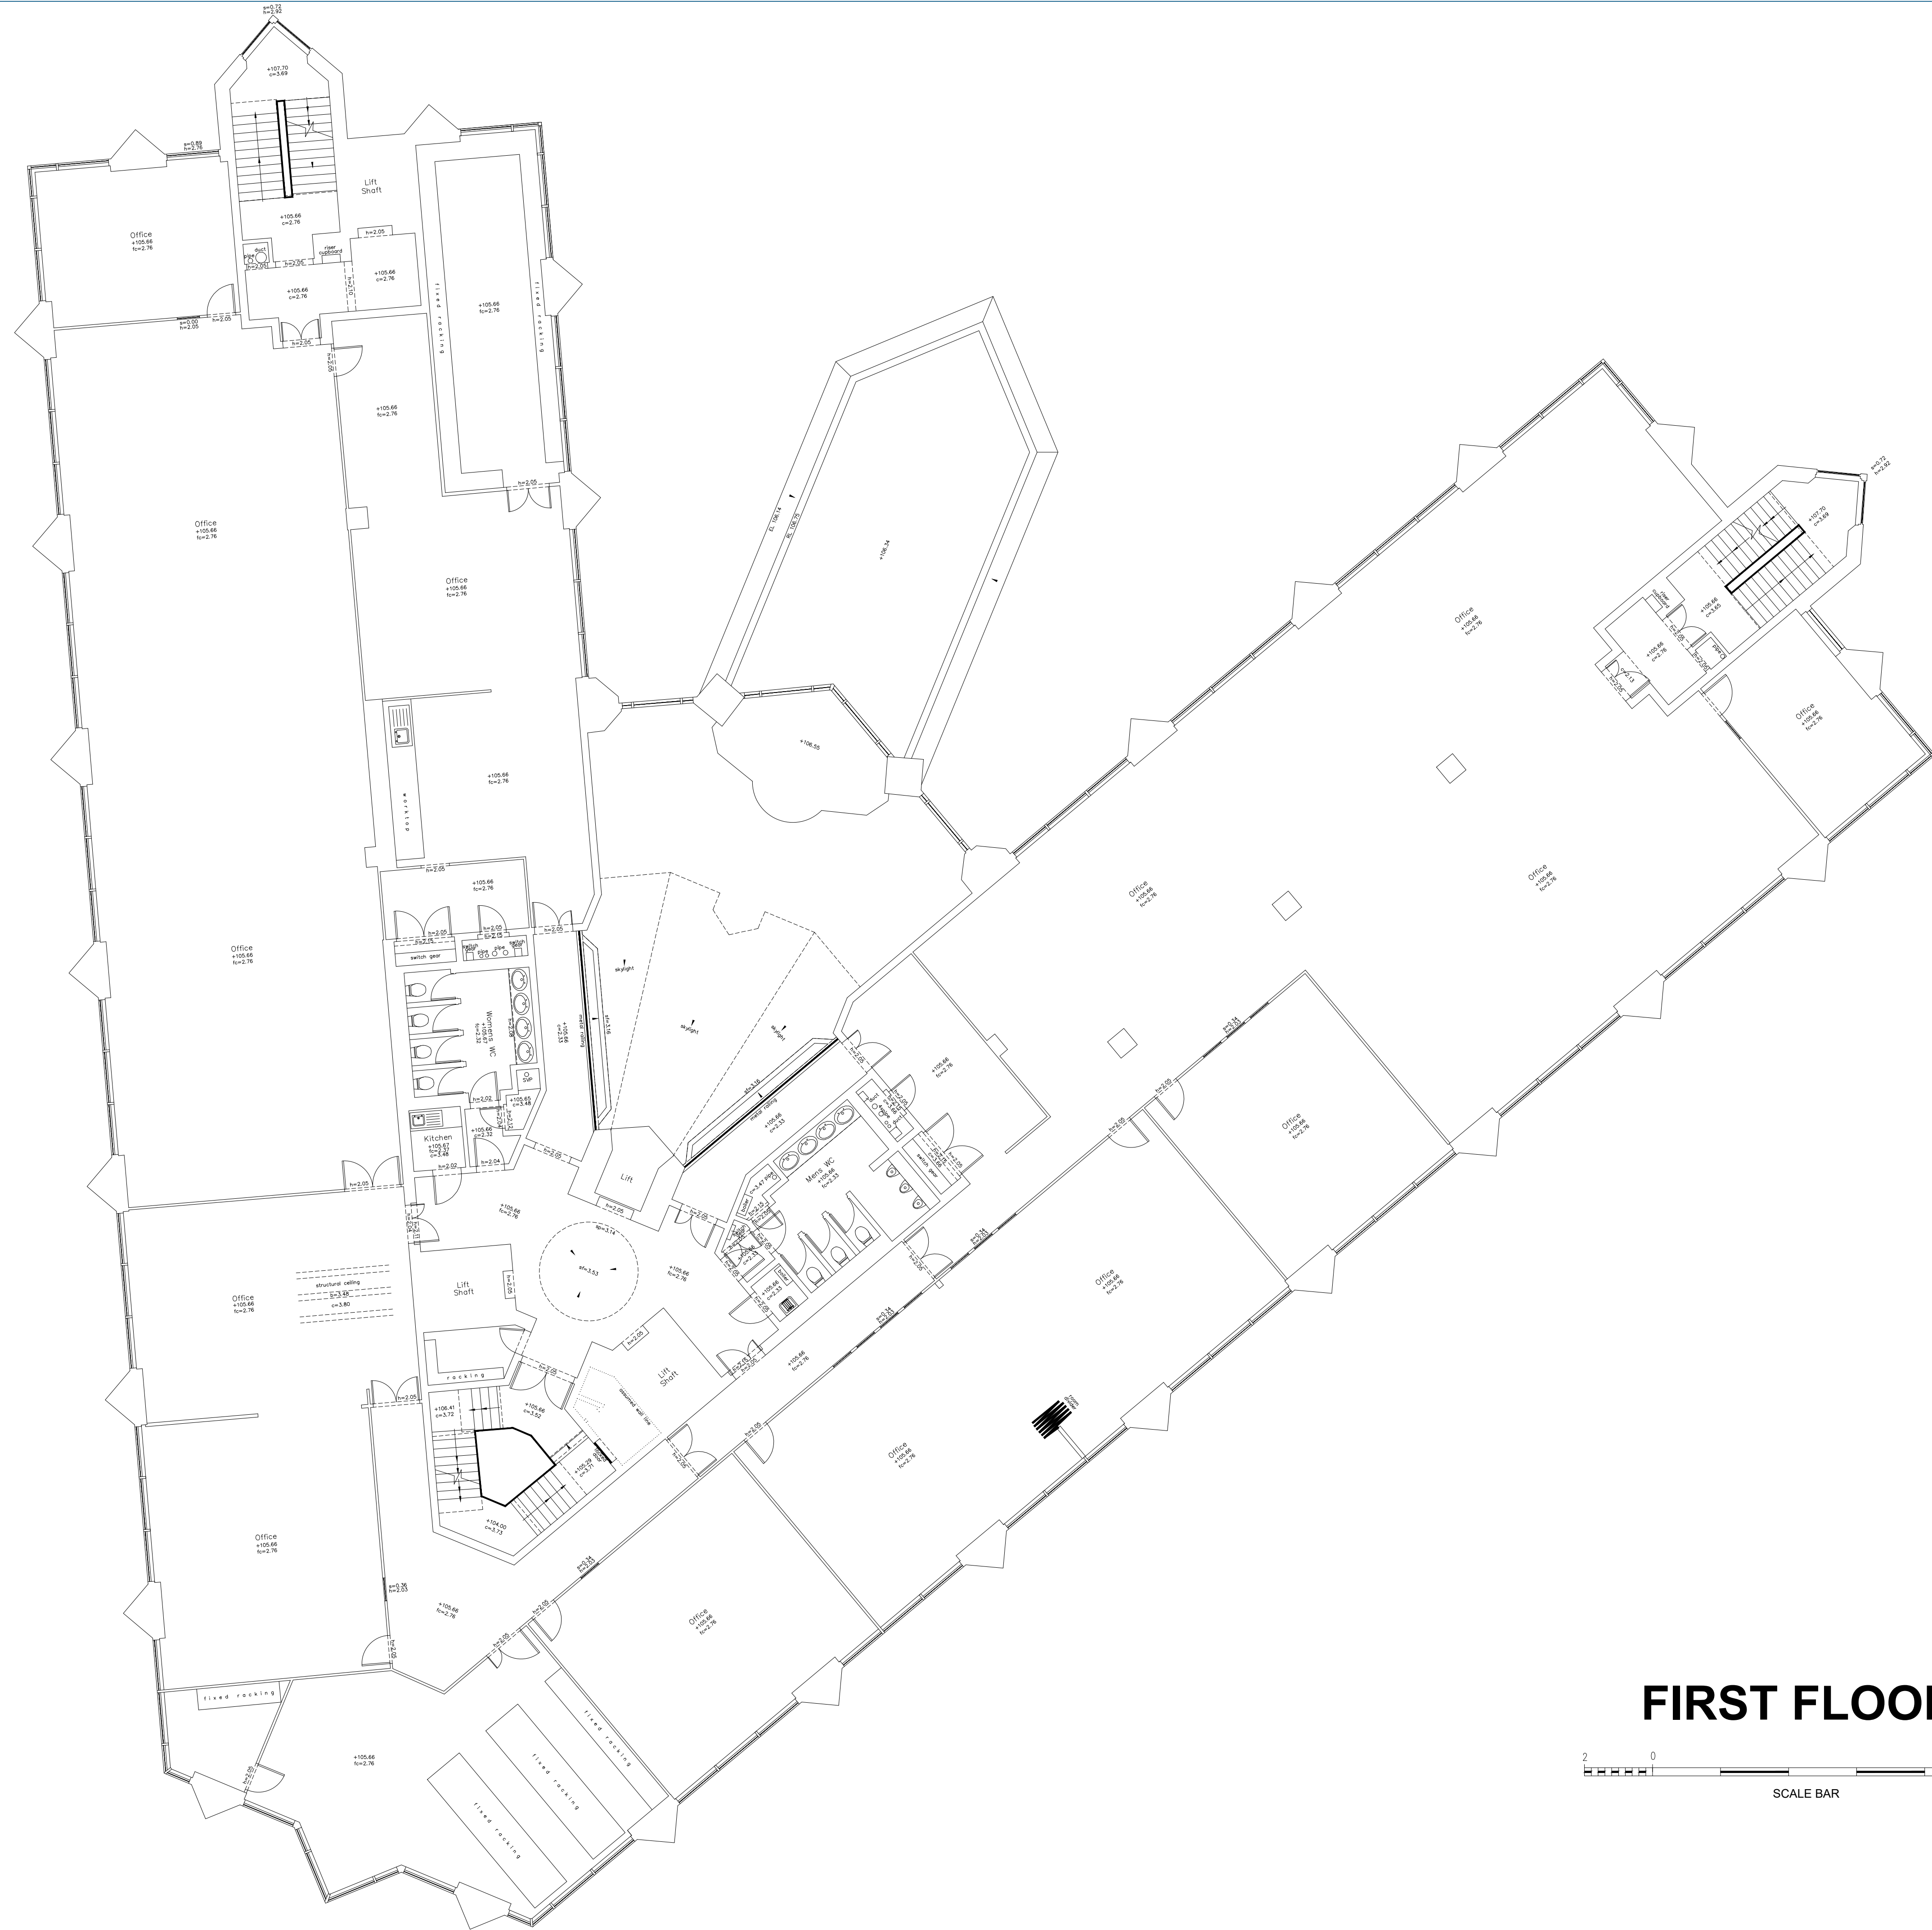

All levels related to Ordnance Survey active GPS network, at survey station S3.

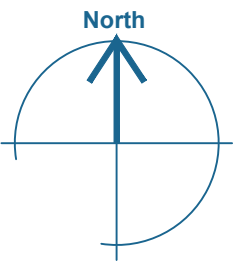KEY

Section Line

Box partition

Step/Ramp up

Stair cut line

Overhead Feature

Fit Mark

Radiator

Slope up

Elevation Location

Approximate/Assumed Position

ABBREVIATIONS

p = Plinth Height
s = Sill Height
h = Head Height
c = Ceiling Height
b = Beam Height
sp = Spring Point Height
fc = False Ceiling Height
sc = Structural Ceiling Height
sf = Soffit Height

RL = Ridge Level
EL = Eaves Level
RFL = Roof Level
SFL = Soffit Level
THL = Threshold Level
FFL = Finished Floor Level
PWL = Parapet Wall Level
+35.20 = Levels
+52.76 = Elevation level

AB = Air Brick
AHU = Air Handling Unit
AV = Air Vent
CB = Cupboard

JB = Junction Box
RSJ = Rolled Steel Joist
WT = Worktop

Client
**PEGASUS PLANNING GROUP
(LONDON)**

Project
**ELSTREE TOWER, ELSTREE WAY,
BOREHAMWOOD, WD6 1SD**

Title
FLOOR PLAN

Drawing Number
TS22-292-ET-2

Revision	Description	Rev. By	Date

Scale	1:100@A1	Sheet	2 of 8
Drawn by	AB	Checked by	PG
		Date of Survey	JULY 2022


 **TERRAIN
SURVEYS**

Tel: 01438 841300
www.terrain-surveys.co.uk
enquiries@terrain-surveys.co.uk


Accreditations:



© COPYRIGHT RESERVED
Do Not Scale From Paper Copies

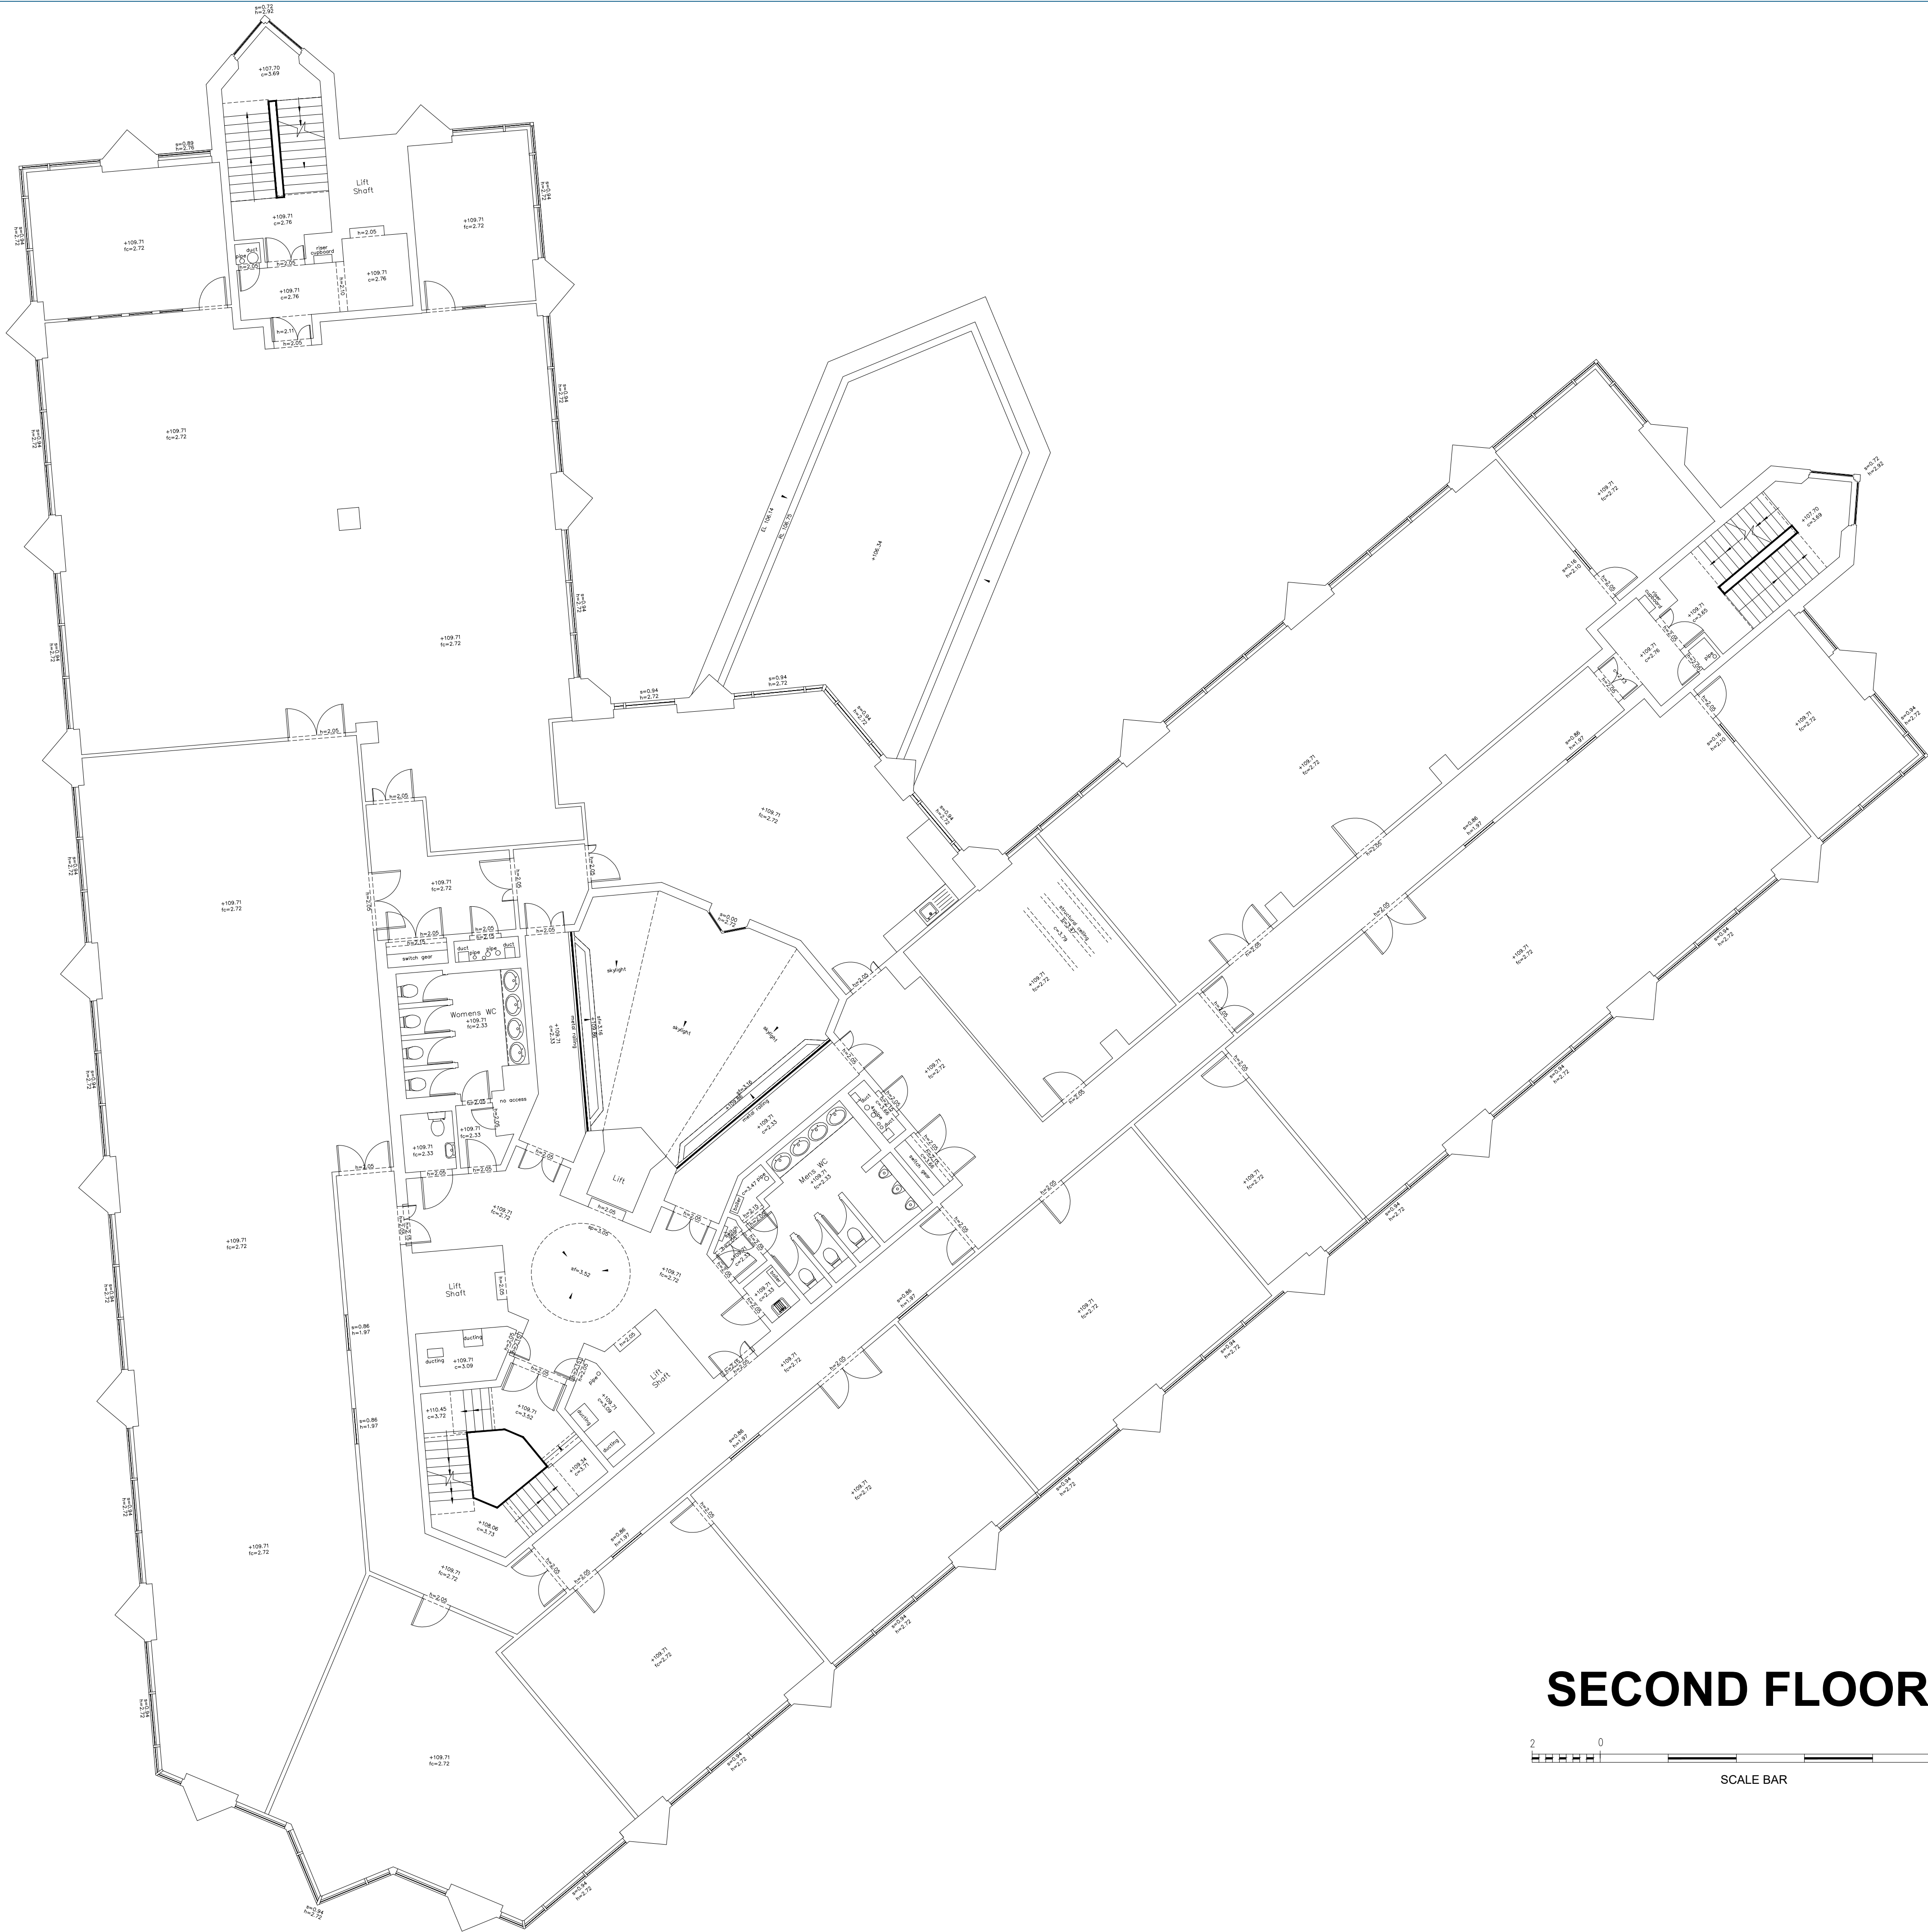

All levels related to Ordnance Survey active GPS network, at survey station S3.

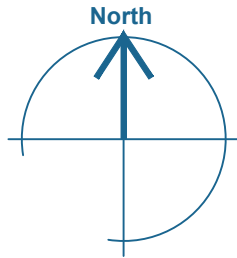KEY

Section Line

Box partition

Step/Ramp up

Stair cut line

Overhead Feature

Fit Mark

Radiator

Slope up

Elevation Location

Approximate/ Assumed Position

ABBREVIATIONS

p = Plinth Height
s = Sill Height
h = Head Height
c = Ceiling Height
b = Beam Height
sp = Spring Point Height
fc = False Ceiling Height
sc = Structural Ceiling Height
sf = Soffit Height

RL = Ridge Level
EL = Eaves Level
RFL = Roof Level
SFL = Soffit Level
THL = Threshold Level
FFL = Finished Floor Level
PWL = Parapet Wall Level
+35.20 = Levels
+52.76 = Elevation level

AB = Air Brick
AHU = Air Handling Unit
AV = Air Vent
CB = Cupboard

JB = Junction Box
RSJ = Rolled Steel Joist
WT = Worktop

Client
**PEGASUS PLANNING GROUP
(LONDON)**

Project
**ELSTREE TOWER, ELSTREE WAY,
BOREHAMWOOD, WD6 1SD**

Title
FLOOR PLAN

Drawing Number
TS22-292-ET-3

Revision	Description	Rev. By	Date

Scale 1:100@A1 Sheet 3 of 8

Drawn by AB	Checked by PG	Date of Survey JULY 2022
----------------	------------------	-----------------------------

 **TERRAIN
SURVEYS**

Tel: 01438 841300
www.terrain-surveys.co.uk
enquiries@terrain-surveys.co.uk


Accreditations:


0028
Certificate Number 1798
ISO 9001


Gold Member
Accredited Contractor
CHAS.co.uk



© COPYRIGHT RESERVED
Do Not Scale From Paper Copies

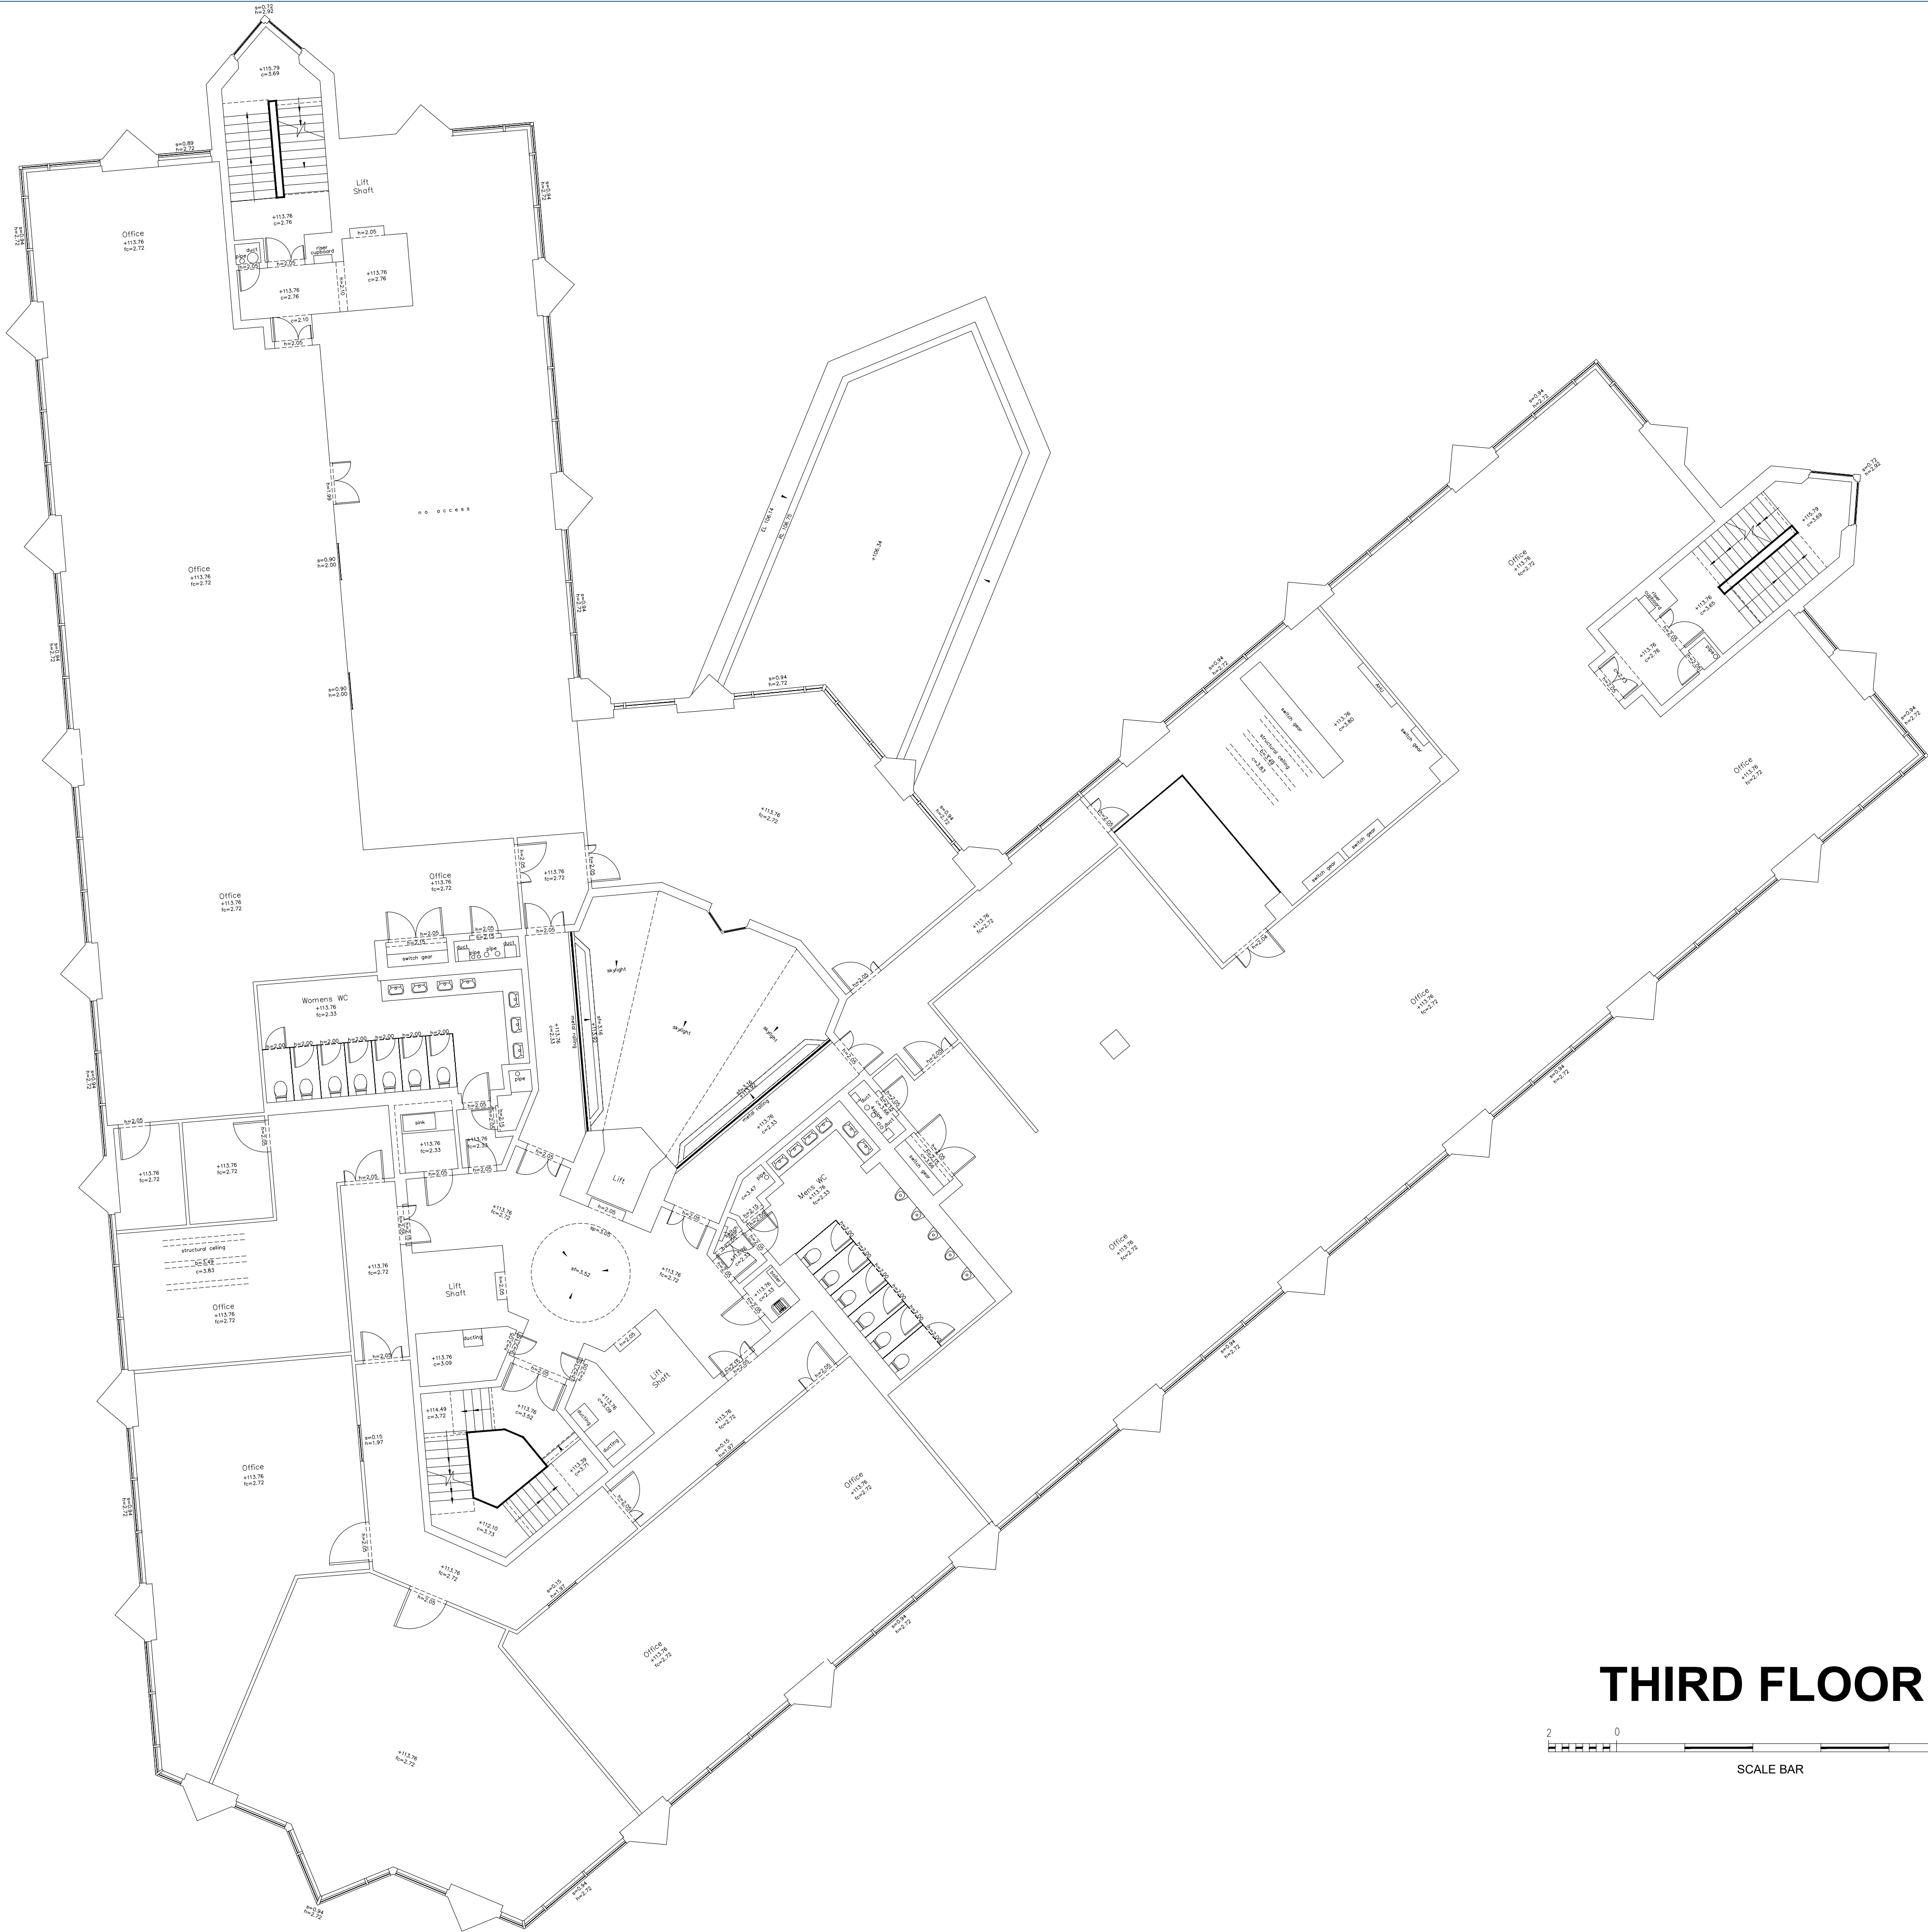

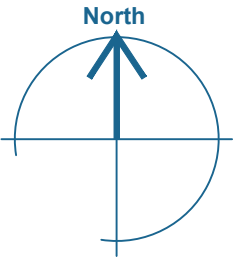KEY

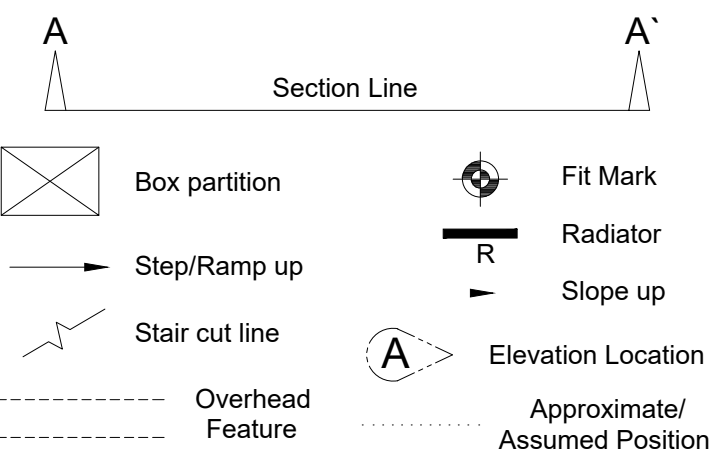

ABBREVIATIONS

p = Plinth Height
s = Sill Height
h = Head Height
c = Ceiling Height
b = Beam Height
sp = Spring Point Height
fc = False Ceiling Height
sc = Structural Ceiling Height
sf = Soffit Height
RL = Ridge Level
EL = Eaves Level
RFL = Roof Level
SFL = Soffit Level
THL = Threshold Level
FFL = Finished Floor Level
PWL = Parapet Wall Level
+35.20 = Levels
+52.76 = Elevation level
AB = Air Brick
AHU = Air Handling Unit
AV = Air Vent
CB = Cupboard
JB = Junction Box
RSJ = Rolled Steel Joist
WT = Worktop

Client
**PEGASUS PLANNING GROUP
(LONDON)**

Project
**ELSTREE TOWER, ELSTREE WAY,
BOREHAMWOOD, WD6 1SD**

Title
FLOOR PLAN

Drawing Number
TS22-292-ET-4

Revision	Description	Rev. By	Date


Scale	1:100@A1	Sheet	4 of 8
Drawn by	AB	Checked by	PG
		Date of Survey	JULY 2022




**TERRAIN
SURVEYS**

Tel: 01438 841300
www.terrain-surveys.co.uk
enquiries@terrain-surveys.co.uk



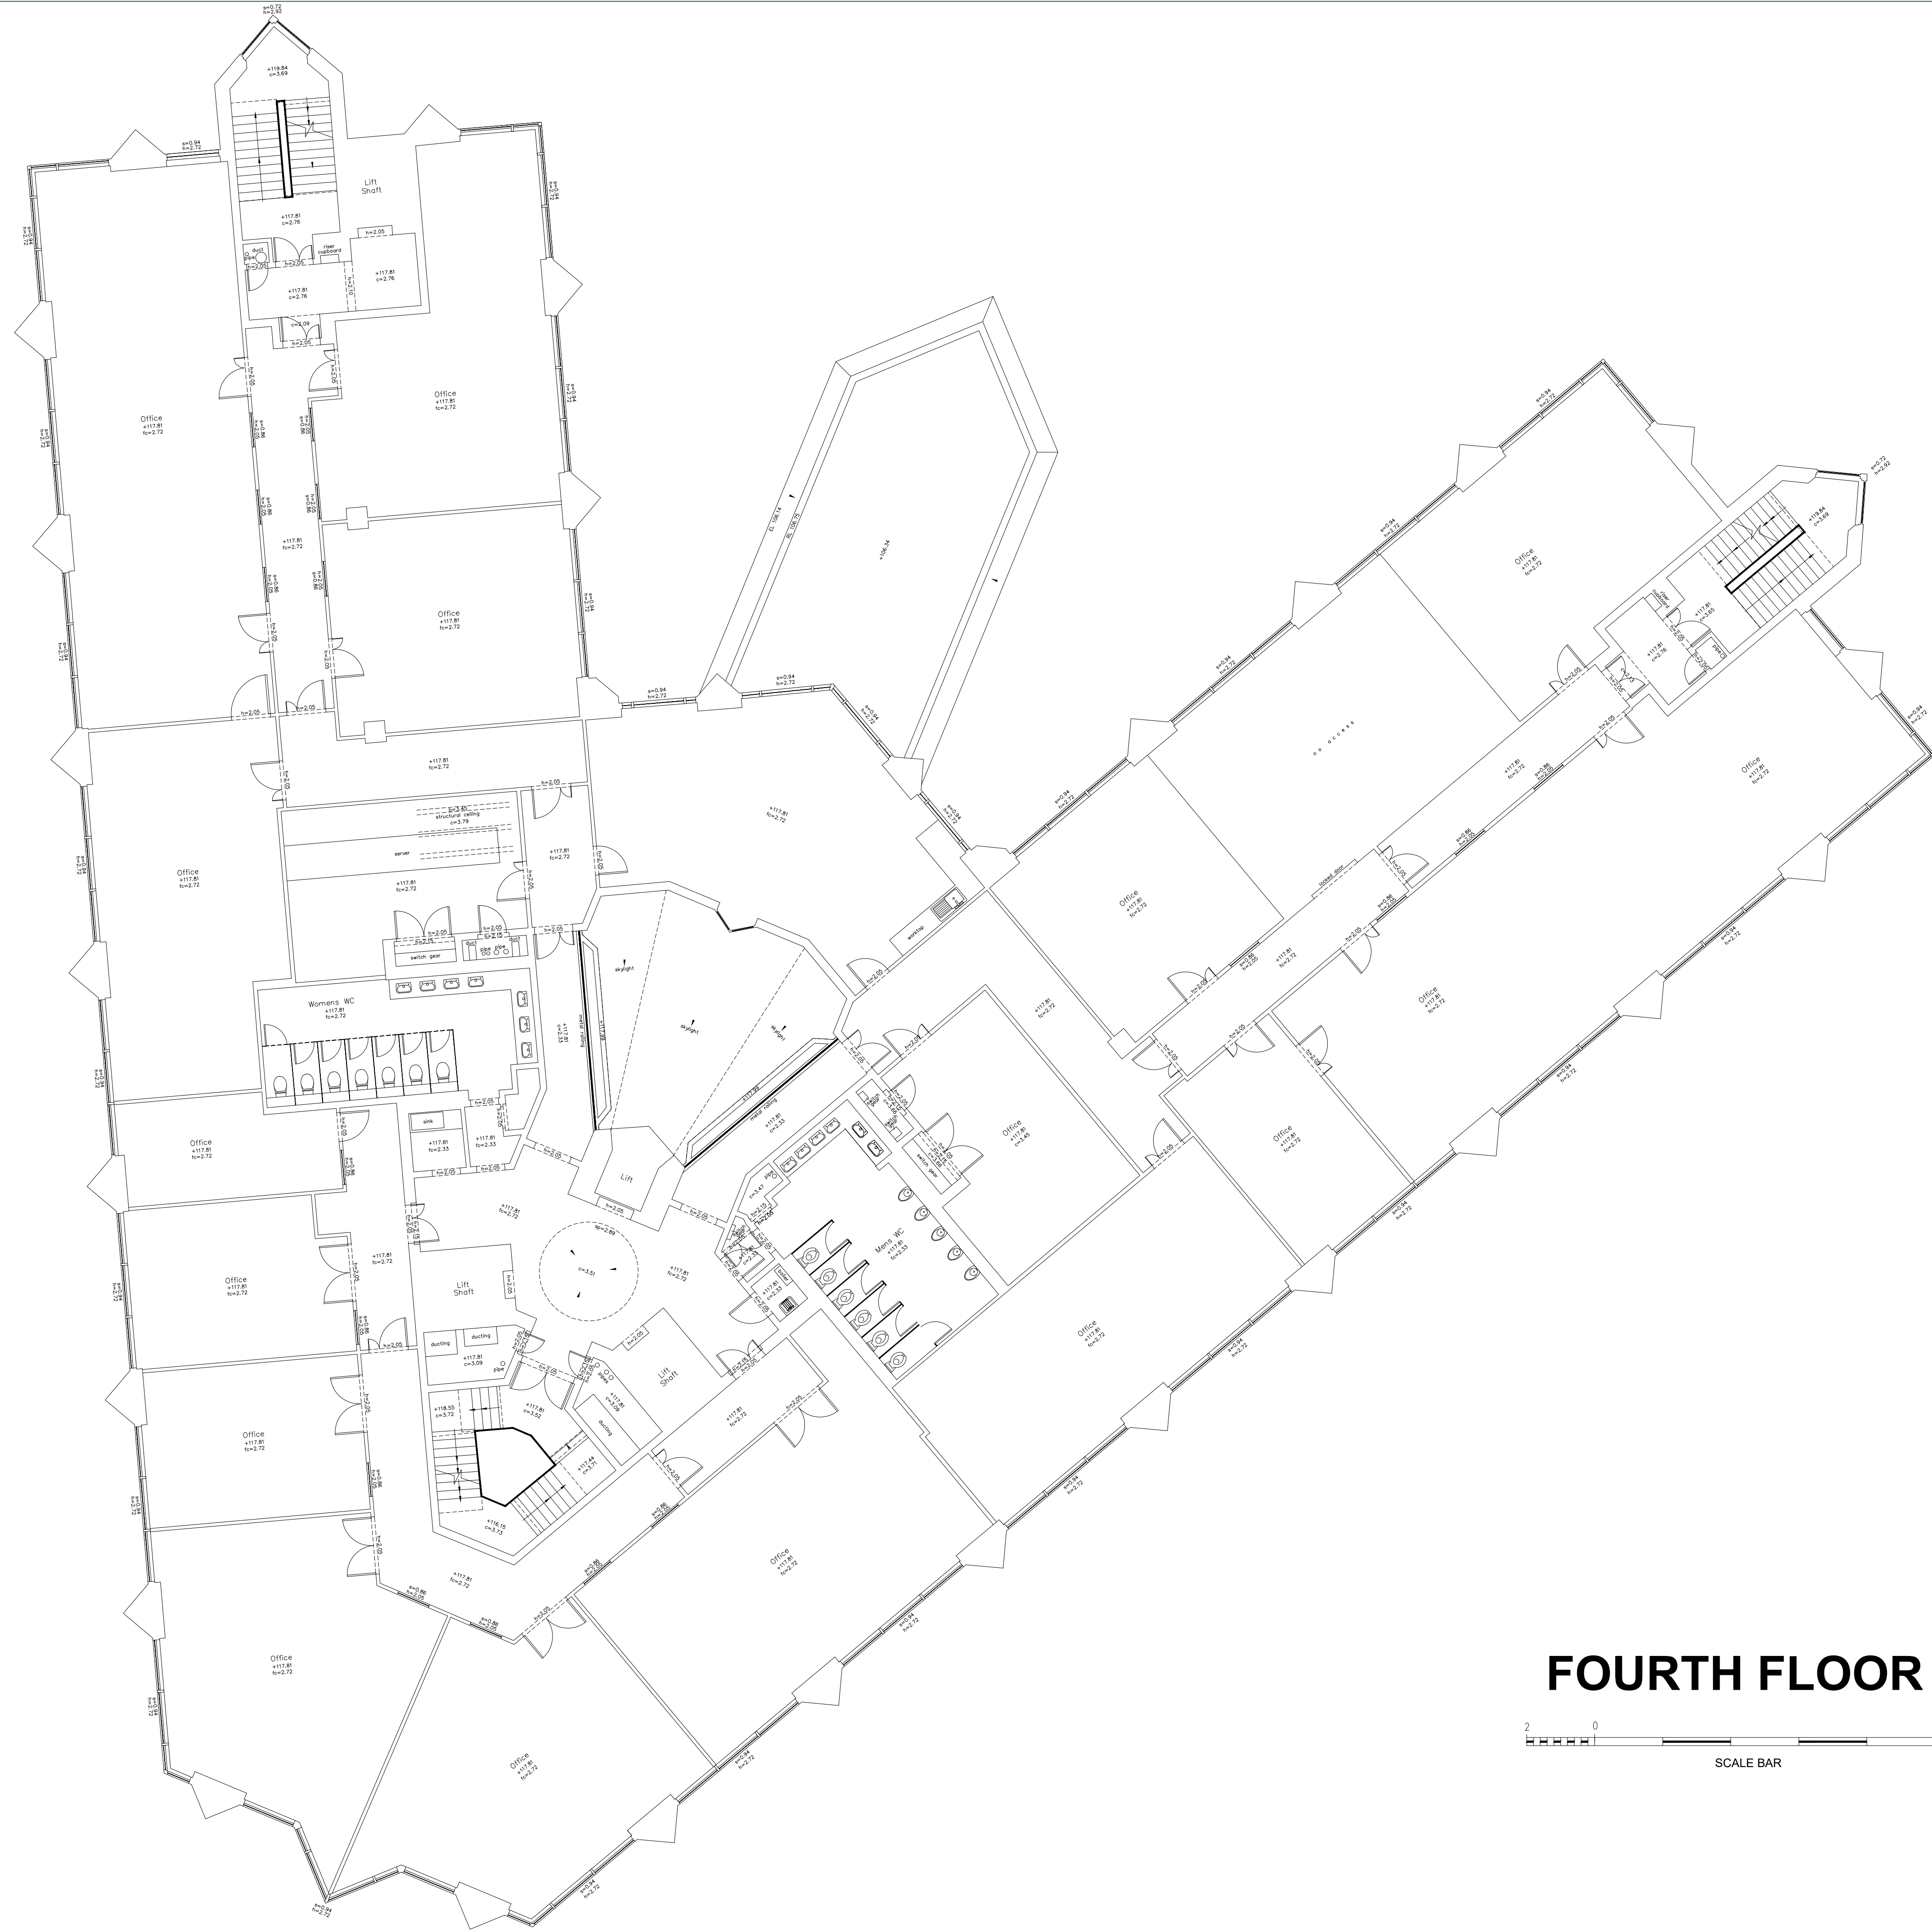

© COPYRIGHT RESERVED
Do Not Scale From Paper Copies

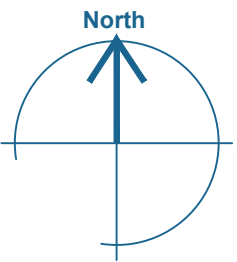

All levels related to Ordnance Survey active GPS network, at survey station S3.

KEY

Section Line

Box partition

Step/Ramp up

Stair cut line

Overhead Feature

Fit Mark

Radiator

Slope up

Elevation Location

Approximate/ Assumed Position

ABBREVIATIONS

p = Plinth Height
s = Sill Height
h = Head Height
c = Ceiling Height
b = Beam Height
sp = Spring Point Height
fc = False Ceiling Height
sc = Structural Ceiling Height
sf = Soffit Height

RL = Ridge Level
EL = Eaves Level
RFL = Roof Level
SFL = Soffit Level
THL = Threshold Level
FFL = Finished Floor Level
PWL = Parapet Wall Level
+35.20 = Levels
+52.76 = Elevation level

AB = Air Brick
AHU = Air Handling Unit
AV = Air Vent
CB = Cupboard

JB = Junction Box
RSJ = Rolled Steel Joist
WT = Worktop

Client
**PEGASUS PLANNING GROUP
(LONDON)**

Project
**ELSTREE TOWER, ELSTREE WAY,
BOREHAMWOOD, WD6 1SD**

Title
FLOOR PLAN

Drawing Number
TS22-292-ET-5

Revision	Description	Rev. By	Date

Scale	1:100@A1	Sheet	5 of 8
Drawn by	AB	Checked by	PG
		Date of Survey	JULY 2022

 **TERRAIN
SURVEYS**

Tel: 01438 841300
www.terrain-surveys.co.uk
enquiries@terrain-surveys.co.uk


Accreditations:


0028
Certificate Number 1798
ISO 9001


Gold Member
Accredited Contractor
CHAS.co.uk



© COPYRIGHT RESERVED
Do Not Scale From Paper Copies

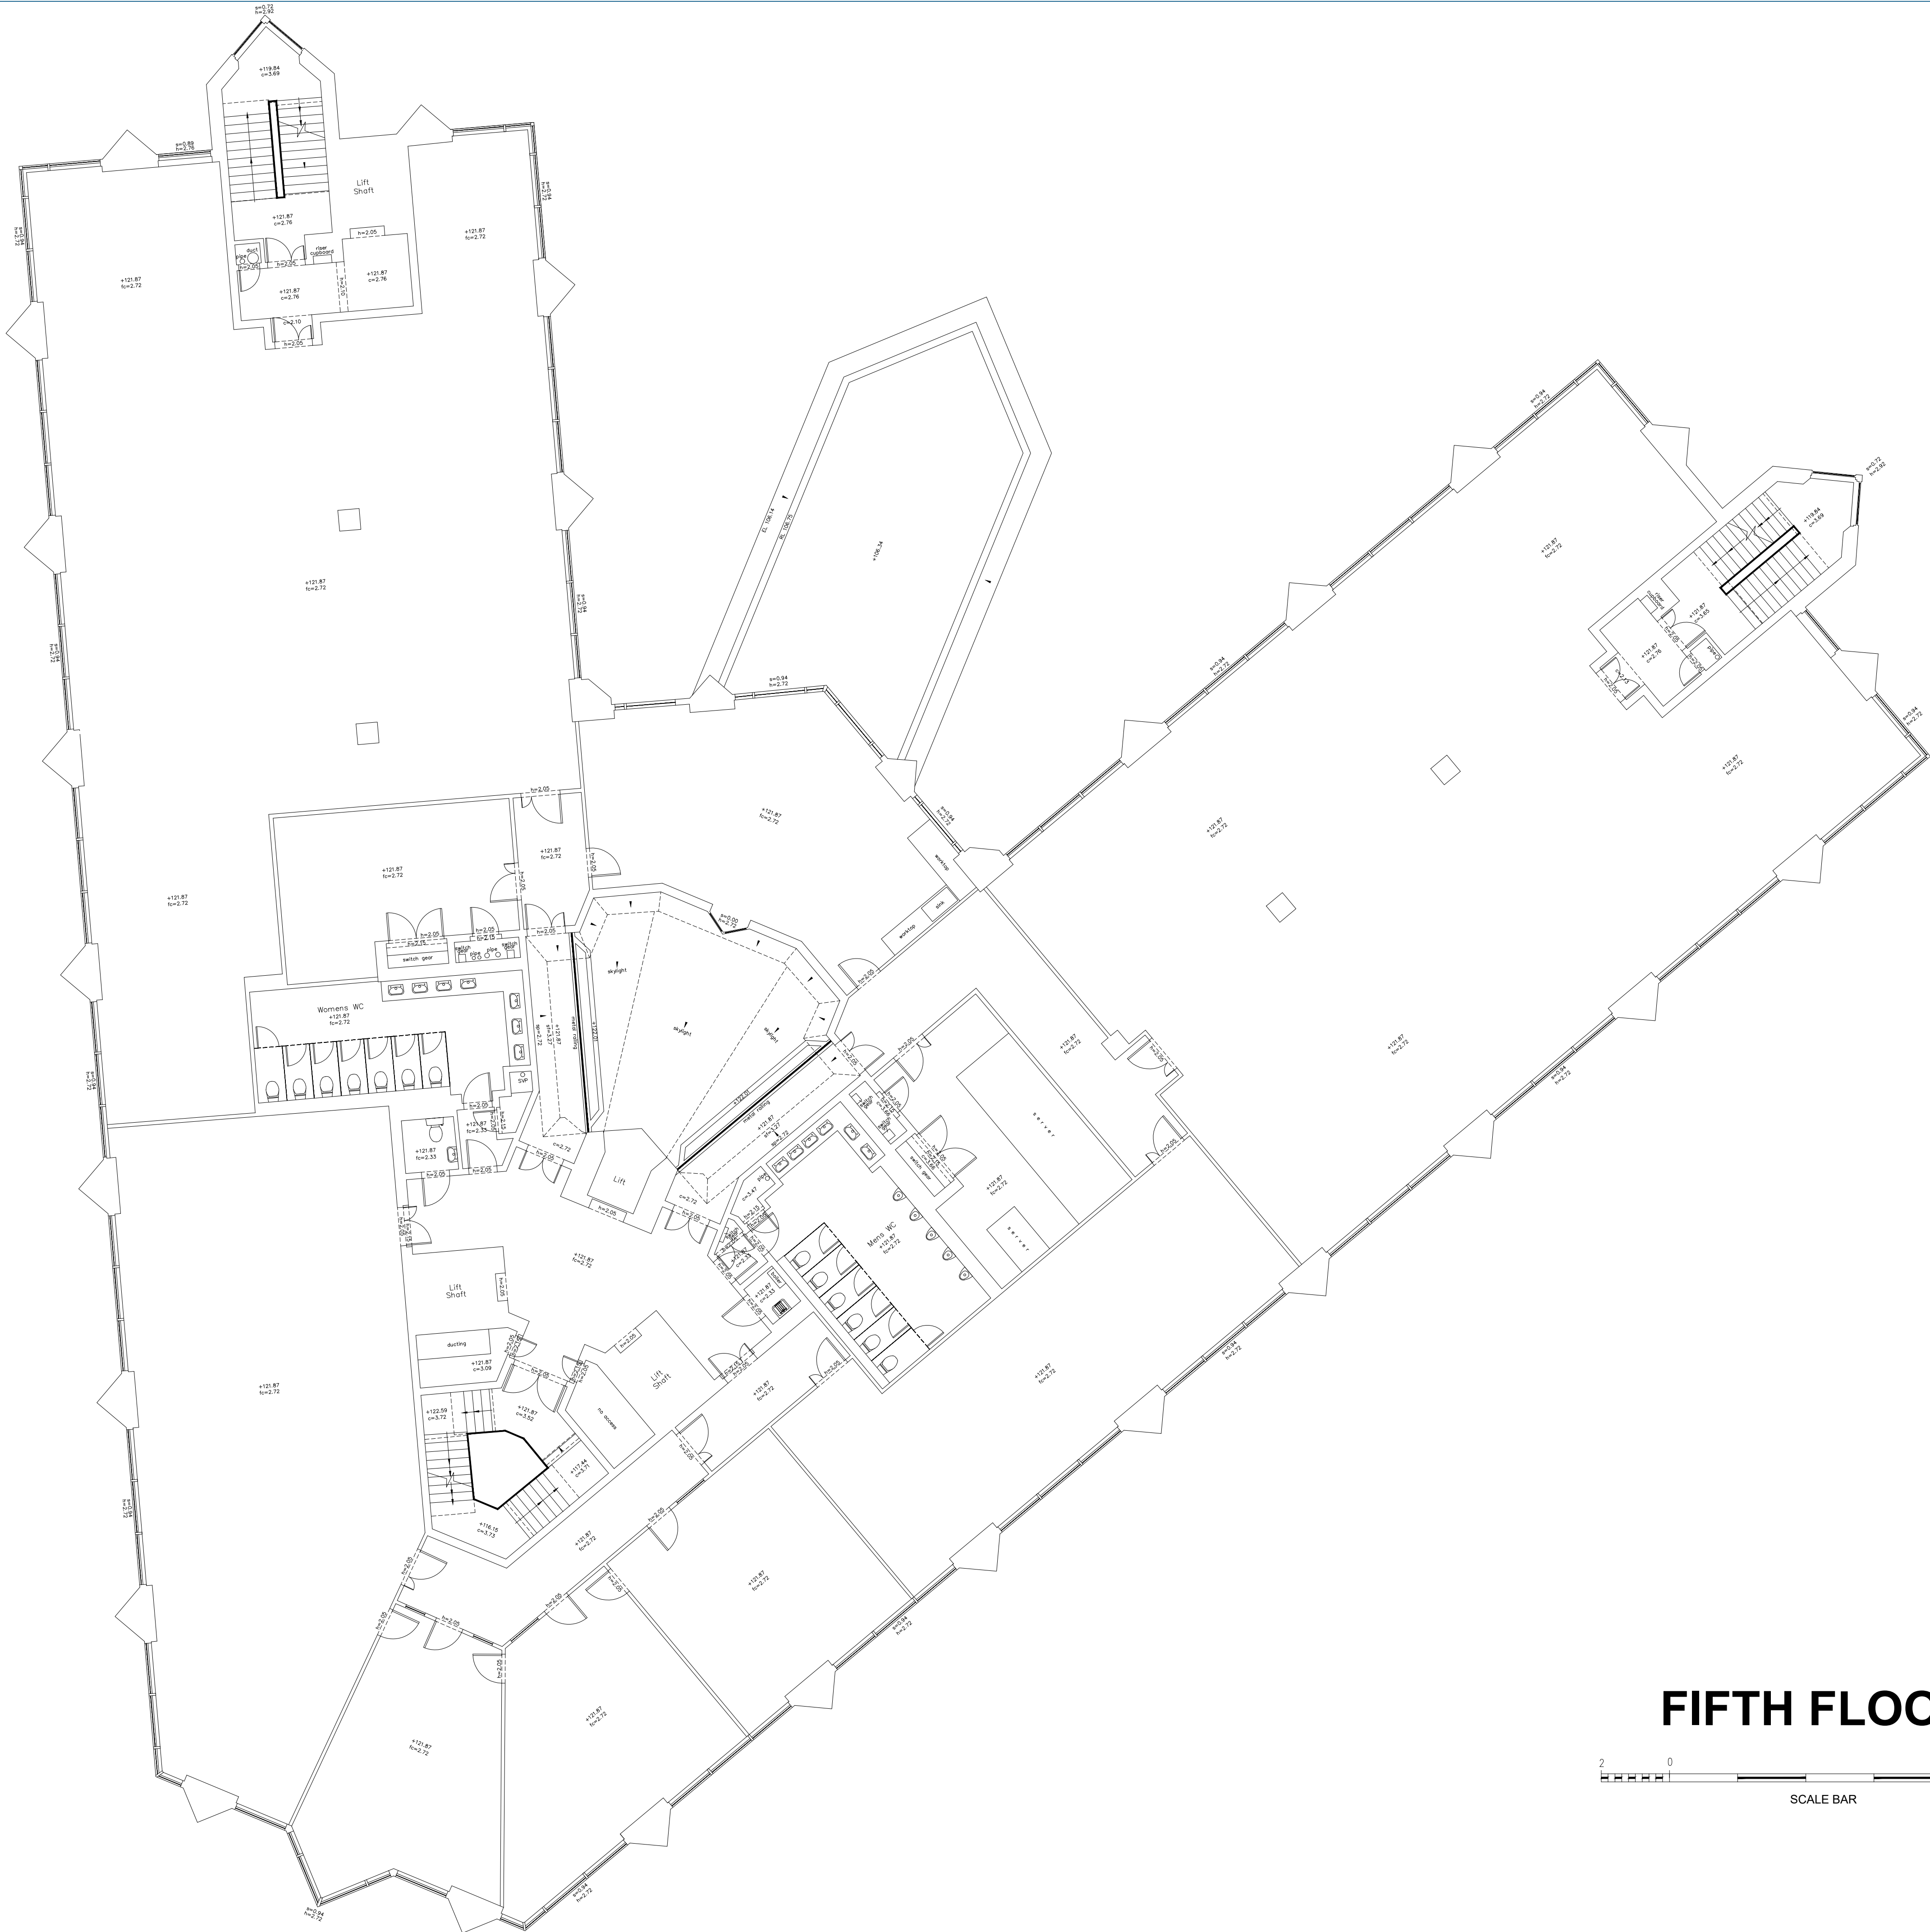

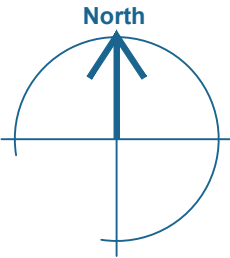KEY

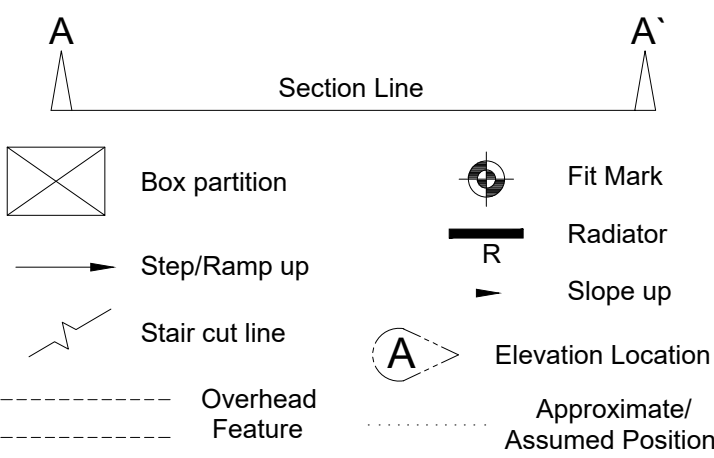

ABBREVIATIONS

p = Plinth Height
s = Sill Height
h = Head Height
c = Ceiling Height
b = Beam Height
sp = Spring Point Height
fc = False Ceiling Height
sc = Structural Ceiling Height
sf = Soffit Height
RL = Ridge Level
EL = Eaves Level
RFL = Roof Level
SFL = Soffit Level
THL = Threshold Level
FFL = Finished Floor Level
PWL = Parapet Wall Level
+35.20 = Levels
+52.76 = Elevation level
AB = Air Brick
AHU = Air Handling Unit
AV = Air Vent
CB = Cupboard
JB = Junction Box
RSJ = Rolled Steel Joist
WT = Worktop

Client
**PEGASUS PLANNING GROUP
(LONDON)**

Project
**ELSTREE TOWER, ELSTREE WAY,
BOREHAMWOOD, WD6 1SD**

Title
FLOOR PLAN

Drawing Number
TS22-292-ET-6

Revision	Description	Rev. By	Date

Scale	1:100@A1	Sheet	6 of 8
Drawn by	AB	Checked by	PG
		Date of Survey	JULY 2022




**TERRAIN
SURVEYS**

Tel: 01438 841300
www.terrain-surveys.co.uk
enquiries@terrain-surveys.co.uk

Accreditations:



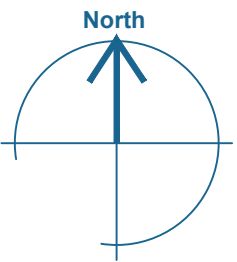

All levels related to Ordnance Survey active GPS network, at survey station S3.

KEY

Section Line

Box partition

Step/Ramp up

Stair cut line

Overhead Feature

Fit Mark

Radiator

Slope up

Elevation Location

Approximate/Assumed Position

ABBREVIATIONS

p = Plinth Height
s = Sill Height
h = Head Height
c = Ceiling Height
b = Beam Height
sp = Spring Point Height
fc = False Ceiling Height
sc = Structural Ceiling Height
sf = Soffit Height

AB = Air Brick
AHU = Air Handling Unit
AV = Air Vent
CB = Cupboard

RL = Ridge Level
EL = Eaves Level
RFL = Roof Level
SFL = Soffit Level
THL = Threshold Level
FFL = Finished Floor Level
PWL = Parapet Wall Level
+35.20 = Levels
+52.76 = Elevation level

JB = Junction Box
RSJ = Rolled Steel Joist
WT = Worktop

Client
**PEGASUS PLANNING GROUP
(LONDON)**

Project
**ELSTREE TOWER, ELSTREE WAY,
BOREHAMWOOD, WD6 1SD**

Title
FLOOR PLAN

Drawing Number
TS22-292-ET-7

Revision	Description	Rev. By	Date

Scale	1:100@A1	Sheet	7 of 8
Drawn by	PG	Checked by	LC
		Date of Survey	JULY 2022

**TERRAIN
SURVEYS**


Tel: 01438 841300
www.terrain-surveys.co.uk
enquiries@terrain-surveys.co.uk



Accreditations:

Constructionline Gold Member


Accredited Contractor CHAS.co.uk

SIXTH FLOOR

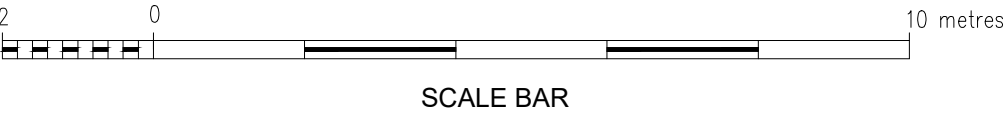


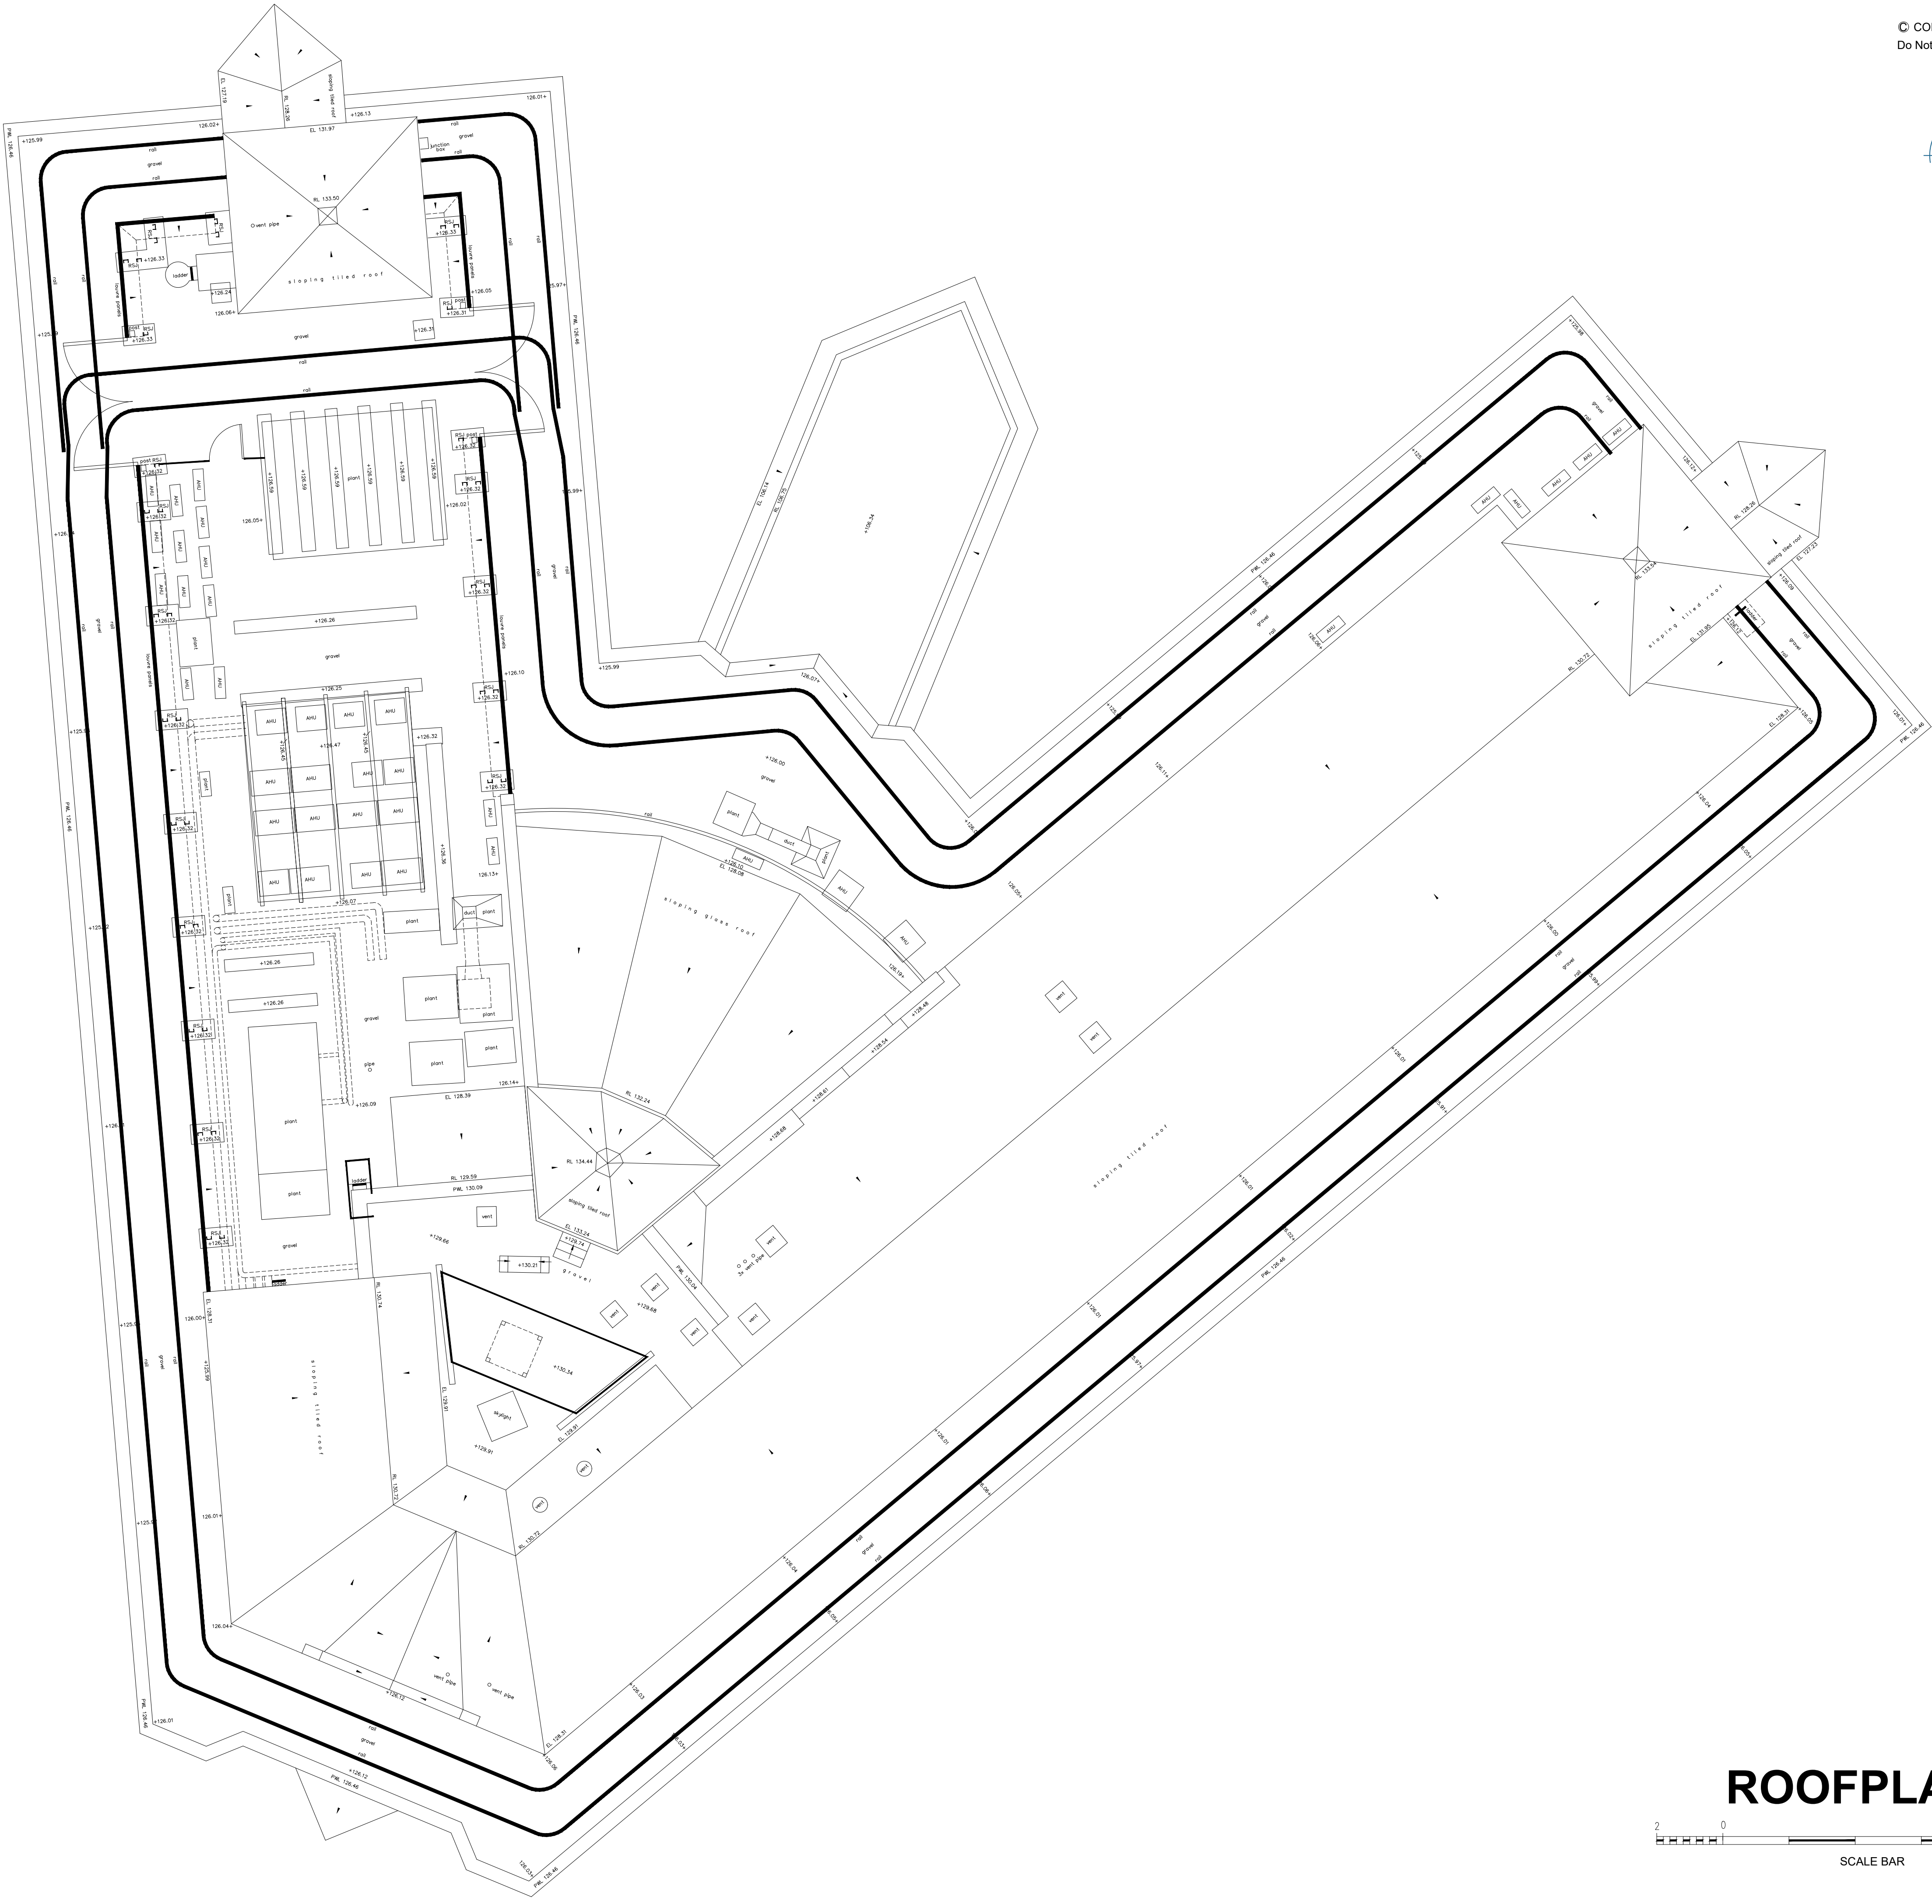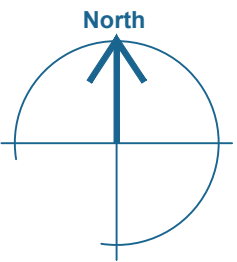

ROOFPLAN

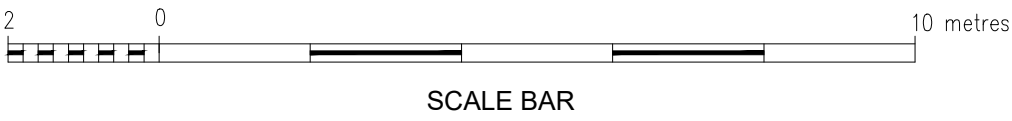

KEY

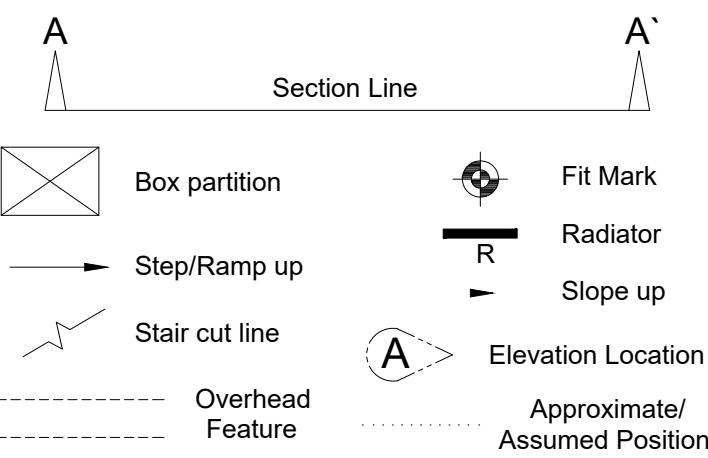

ABBREVIATIONS

p = Plinth Height
s = Sill Height
h = Head Height
c = Ceiling Height
b = Beam Height
sp = Spring Point Height
fc = False Ceiling Height
sc = Structural Ceiling Height
sf = Soffit Height
RL = Ridge Level
EL = Eaves Level
RFL = Roof Level
SFL = Soffit Level
THL = Threshold Level
FFL = Finished Floor Level
PWL = Parapet Wall Level
+35.20 = Levels
+52.76 = Elevation level
AB = Air Brick
AHU = Air Handling Unit
AV = Air Vent
CB = Cupboard
JB = Junction Box
RSJ = Rolled Steel Joist
WT = Worktop

Client
PEGASUS PLANNING GROUP

Project
**ELSTREE TOWER, ELSTREE WAY,
BOREHAMWOOD, WD6 1SD**

Title
FLOOR PLAN

Drawing Number
TS22-292-ET-8

Revision	Description	Rev. By	Date

Scale 1:100@A1 Sheet 8 of 8


Drawn by HB Checked by PG Date of Survey JULY 2022




**TERRAIN
SURVEYS**

Tel: 01438 841300
www.terrainsurveys.co.uk
enquiries@terrainsurveys.co.uk



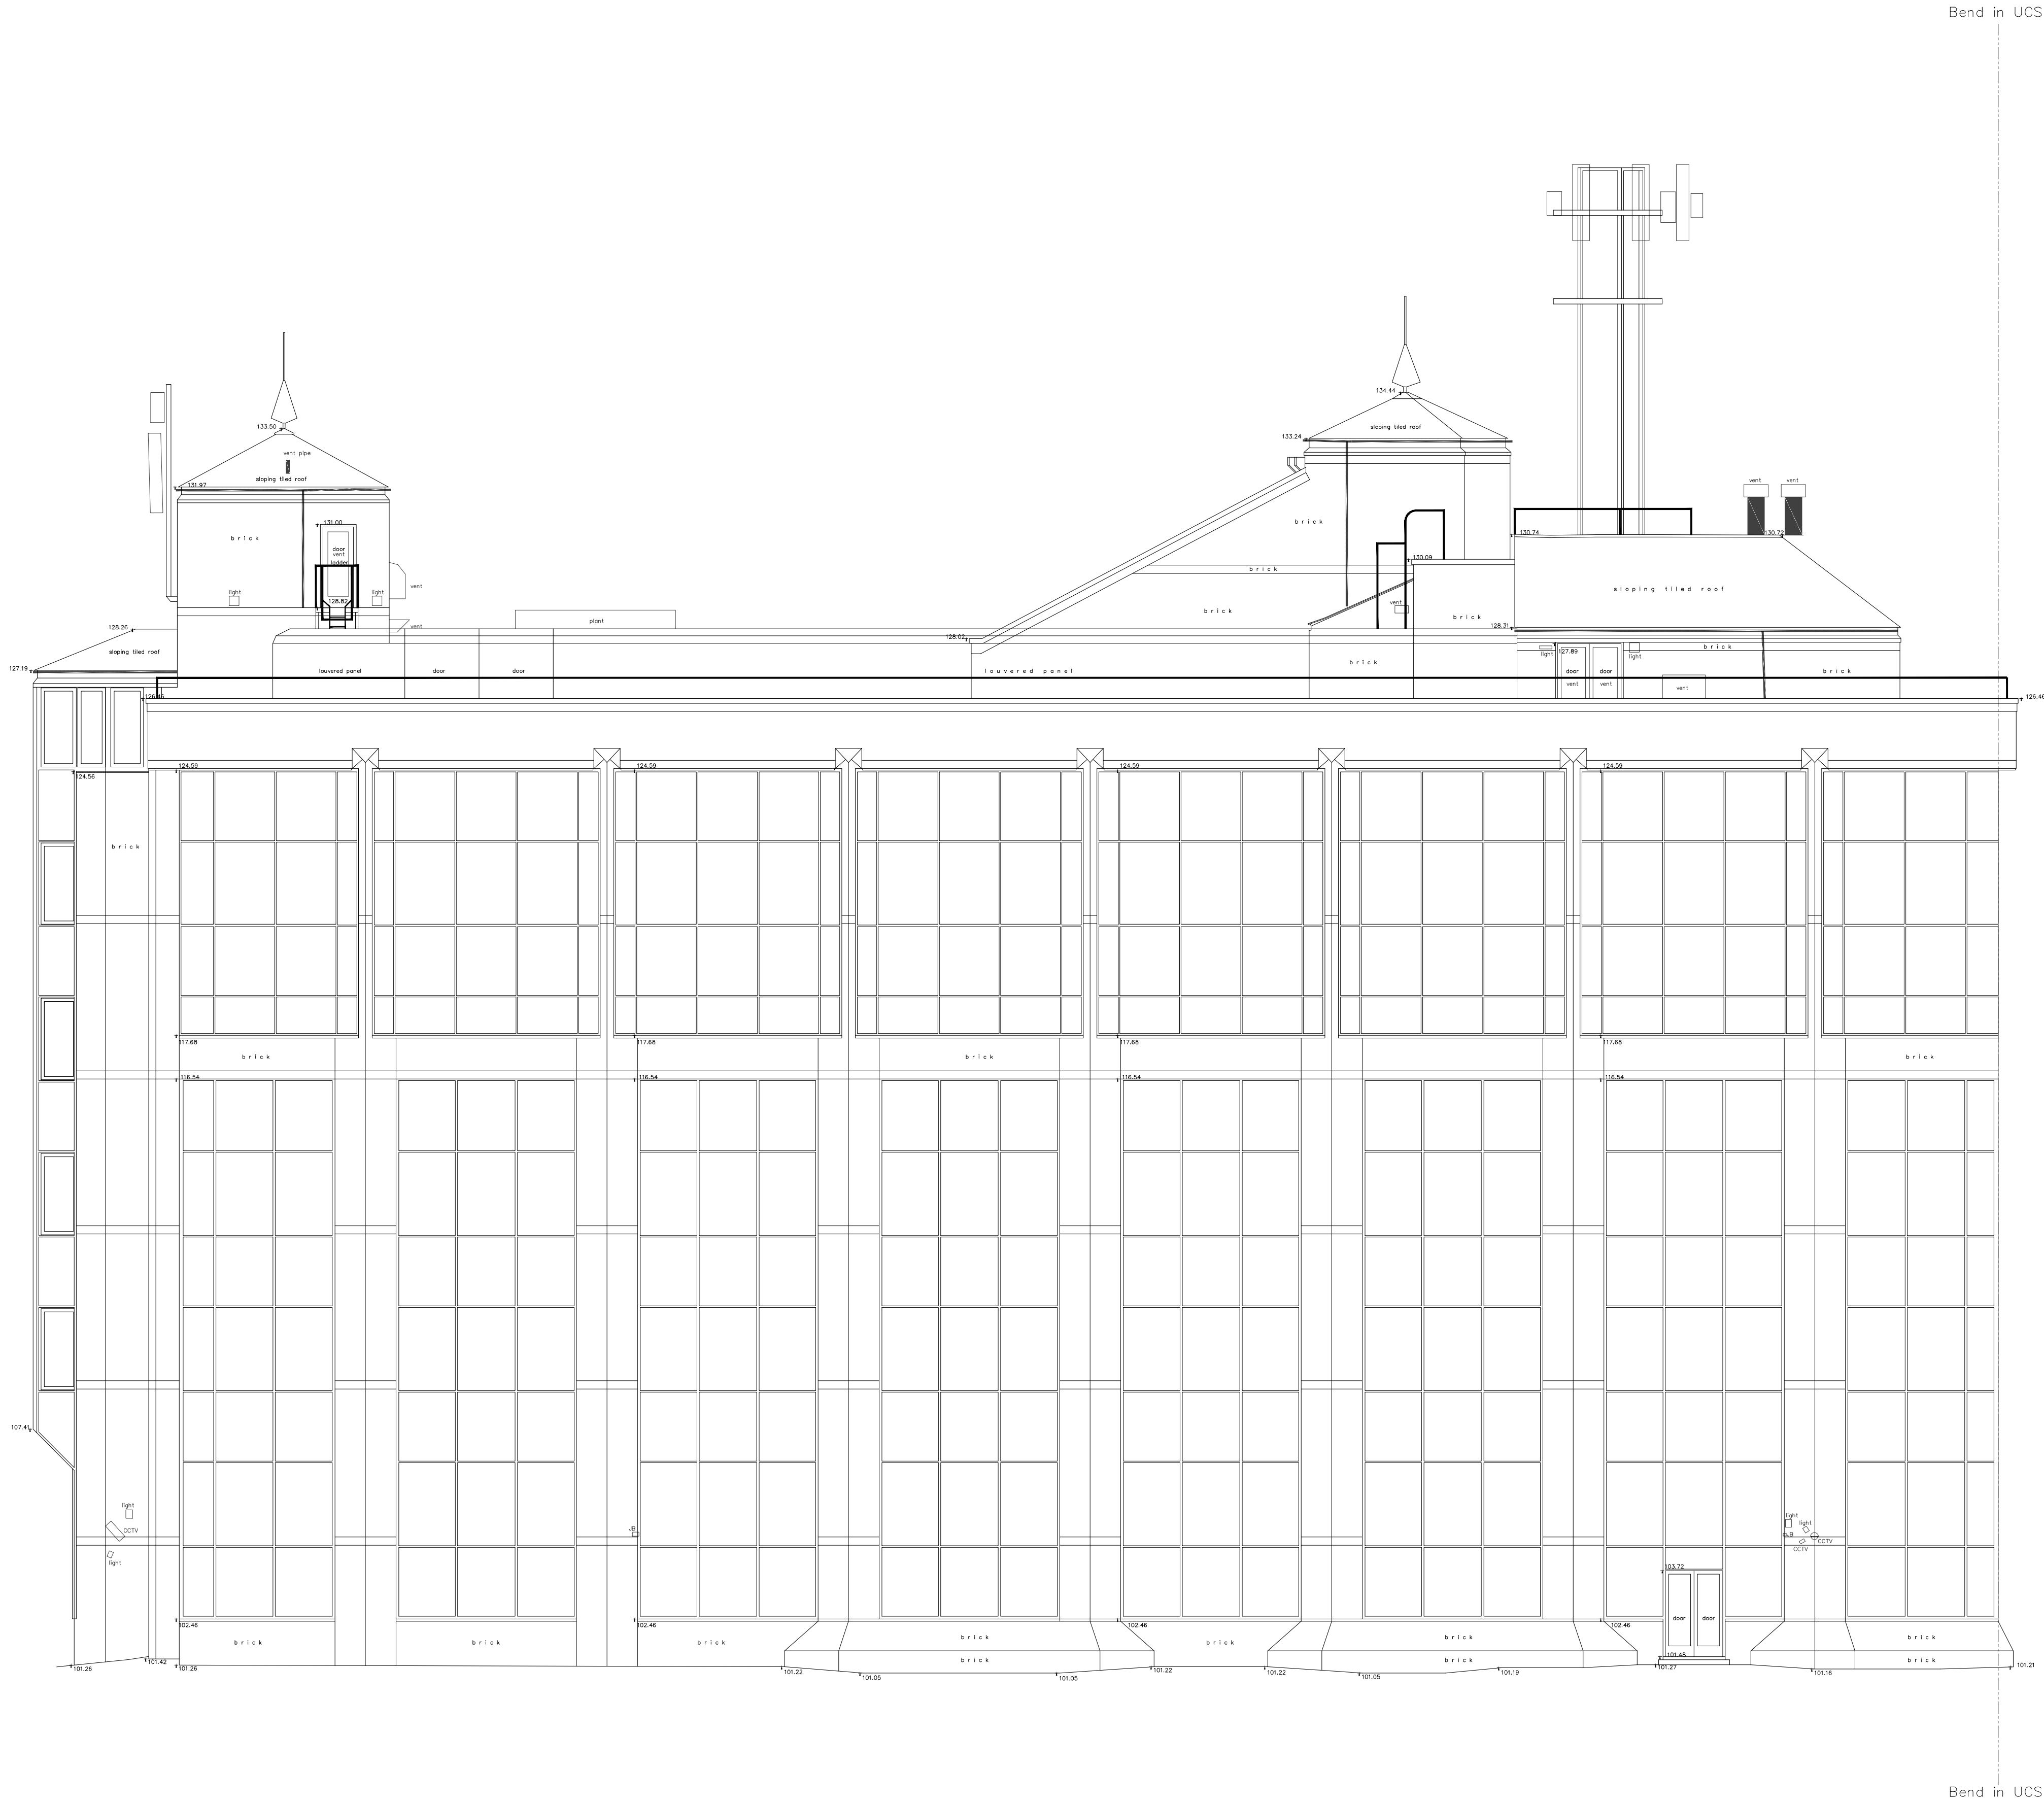


A-1

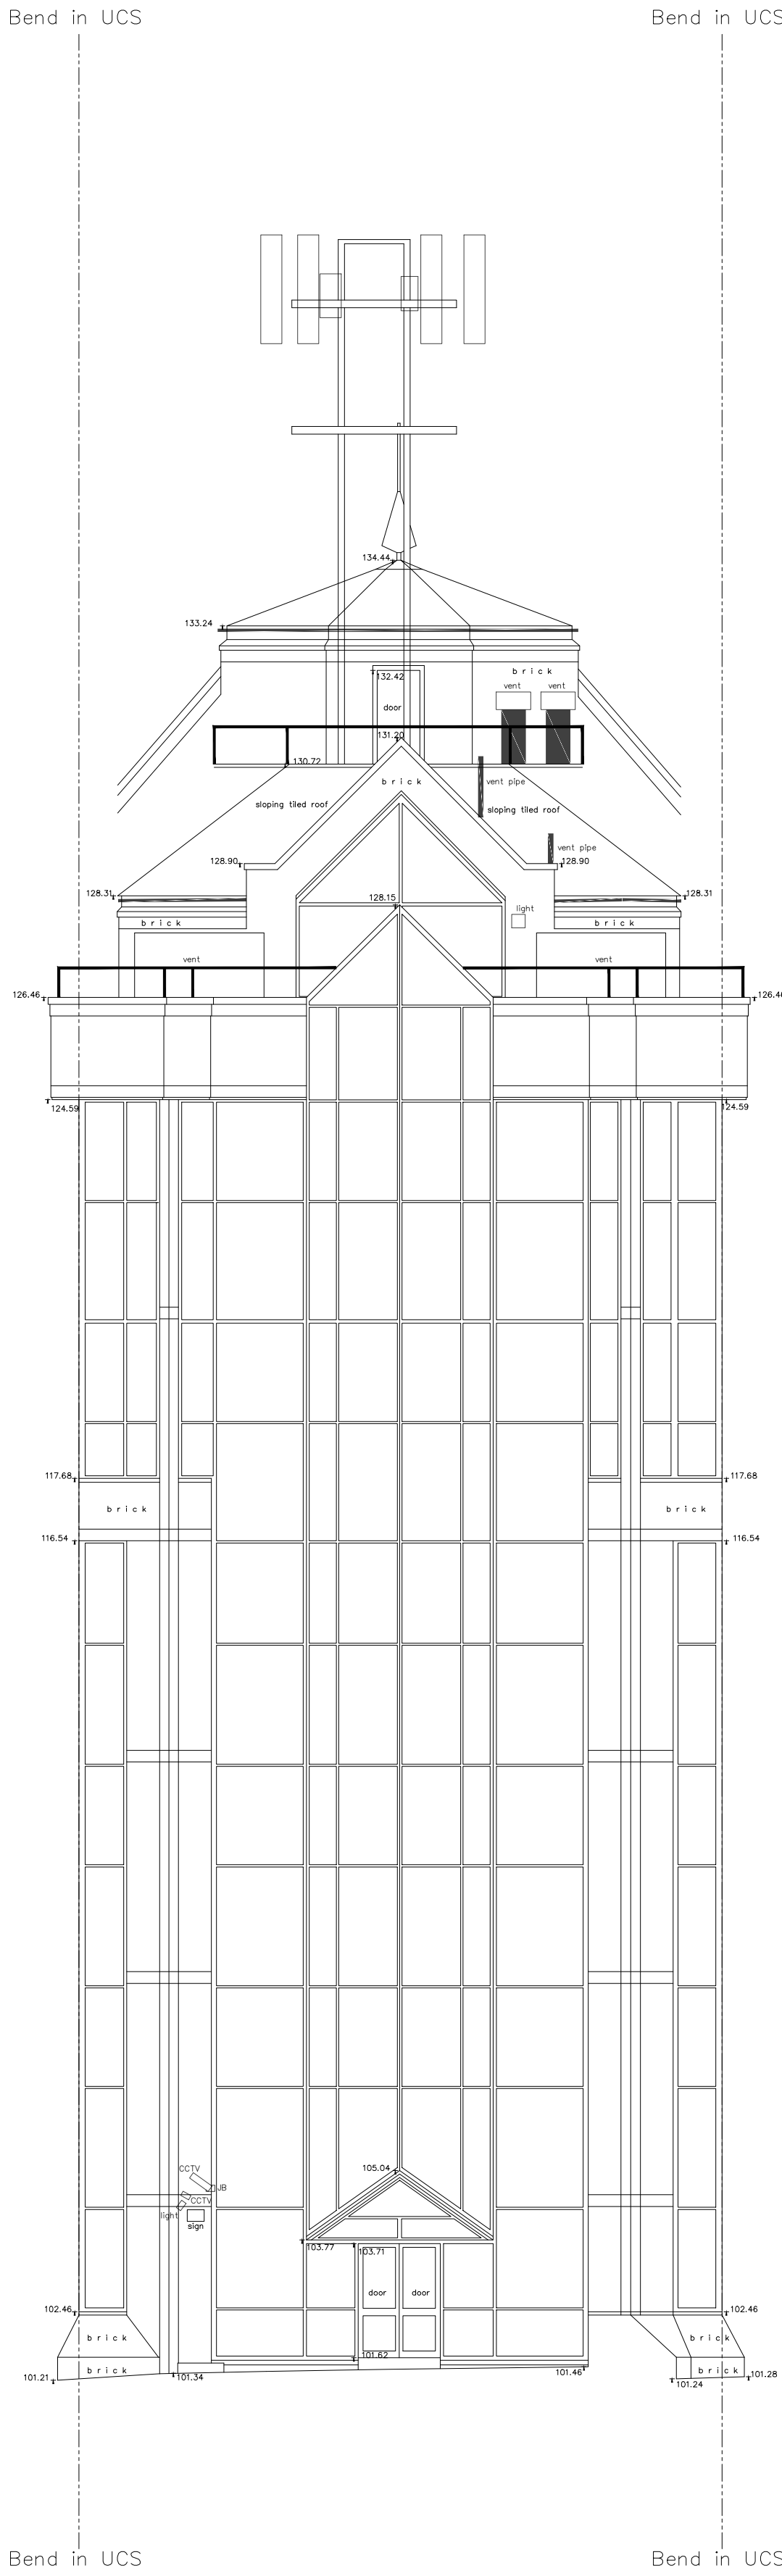


A-2

Datum: 95.00m

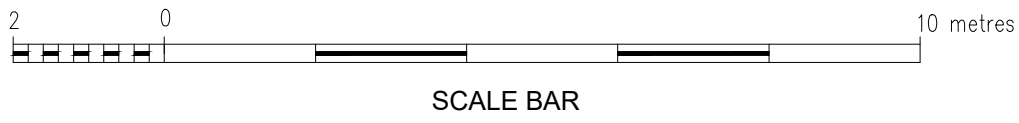

LOCATION PLAN
NOT TO SCALE

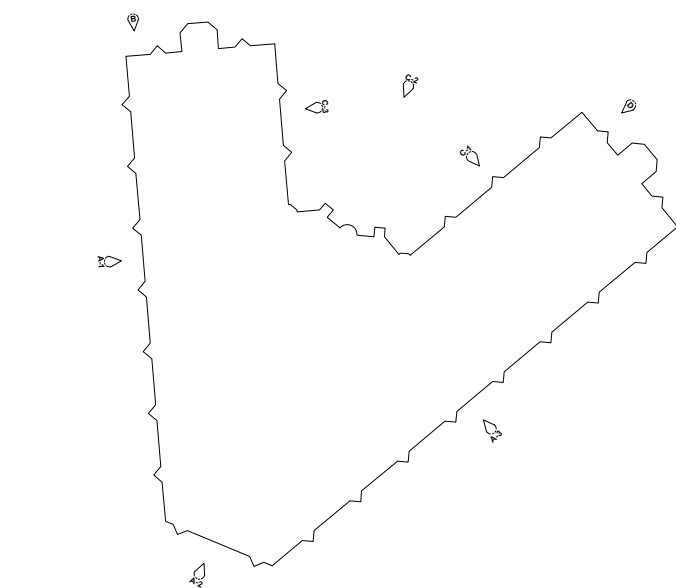

KEY	
	Box partition
	Step/Ramp up
	Stair cut line
	Overhead Feature
	Fit Mark
	Radiator
	Slope up
	Elevation Location
	Approximate/Assumed Position

ABBREVIATIONS	
p = Plinth Height	RL = Ridge Level
s = Sill Height	EL = Eaves Level
h = Head Height	RFL = Roof Level
c = Ceiling Height	SFL = Soffit Level
b = Beam Height	ThL = Threshold Level
sp = Spring Point Height	FFL = Finished Floor Level
fc = False Ceiling Height	PWL = Parapet Wall Level
sc = Structural Ceiling Height	+35.20 = Levels
sf = Soffit Height	+52.76 = Elevation level
AB = Air Brick	JB = Junction Box
AHU = Air Handling Unit	RSJ = Rolled Steel Joist
AV = Air Vent	WT = Worktop
CB = Cupboard	

Client
PEGASUS PLANNING GROUP

Project
**ELSTREE TOWER, ELSTREE WAY,
BOREHAMWOOD, WD6 1SD**

Title
ELEVATIONS


Drawing Number
TS22-292-ET-9

Revision	Description	Rev. By	Date

Scale	1:100@A0	Sheet	1 of 4
Drawn by	HB	Checked by	PG
		Date of Survey	JULY 2022



LOCATION PLAN
NOT TO SCALE

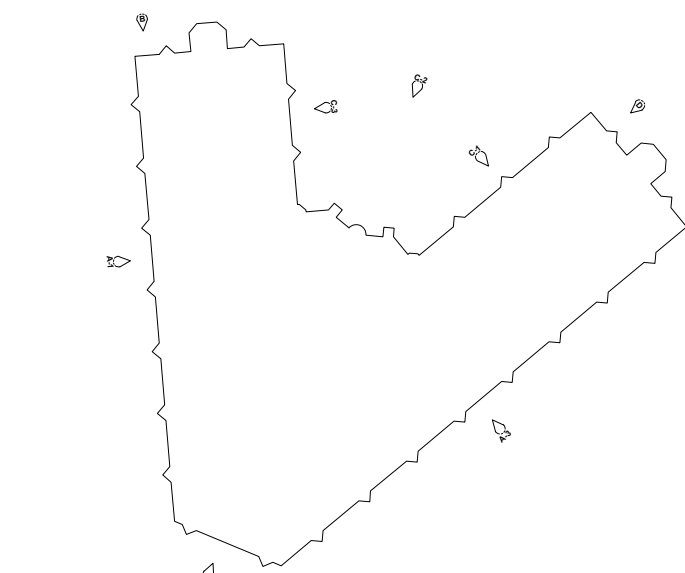

KEY	
	Box partition
	Step/Ramp up
	Stair cut line
	Overhead Feature
	Fit Mark
	Radiator
	Slope up
	Elevation Location
	Approximate/Assumed Position

ABBREVIATIONS	
p = Plinth Height	RL = Ridge Level
s = Sill Height	EL = Eaves Level
h = Head Height	RFL = Roof Level
c = Ceiling Height	SFL = Soffit Level
b = Beam Height	ThL = Threshold Level
sp = Spring Point Height	FFL = Finished Floor Level
fc = False Ceiling Height	PWL = Parapet Wall Level
sc = Structural Ceiling Height	+35.20 = Levels
sf = Soffit Height	+52.76 = Elevation level
AB = Air Brick	JB = Junction Box
AHU = Air Handling Unit	RSJ = Rolled Steel Joist
AV = Air Vent	WT = Worktop
CB = Cupboard	

Client
PEGASUS PLANNING GROUP

Project
**ELSTREE TOWER, ELSTREE WAY,
BOREHAMWOOD, WD6 1SD**

Title
ELEVATIONS

Drawing Number
TS22-292-ET-10


Revision	Description	Rev. By	Date

Scale 1:100@A0 Sheet 2 of 4

Drawn by HB Checked by PG Date of Survey JULY 2022




Bend in UCS

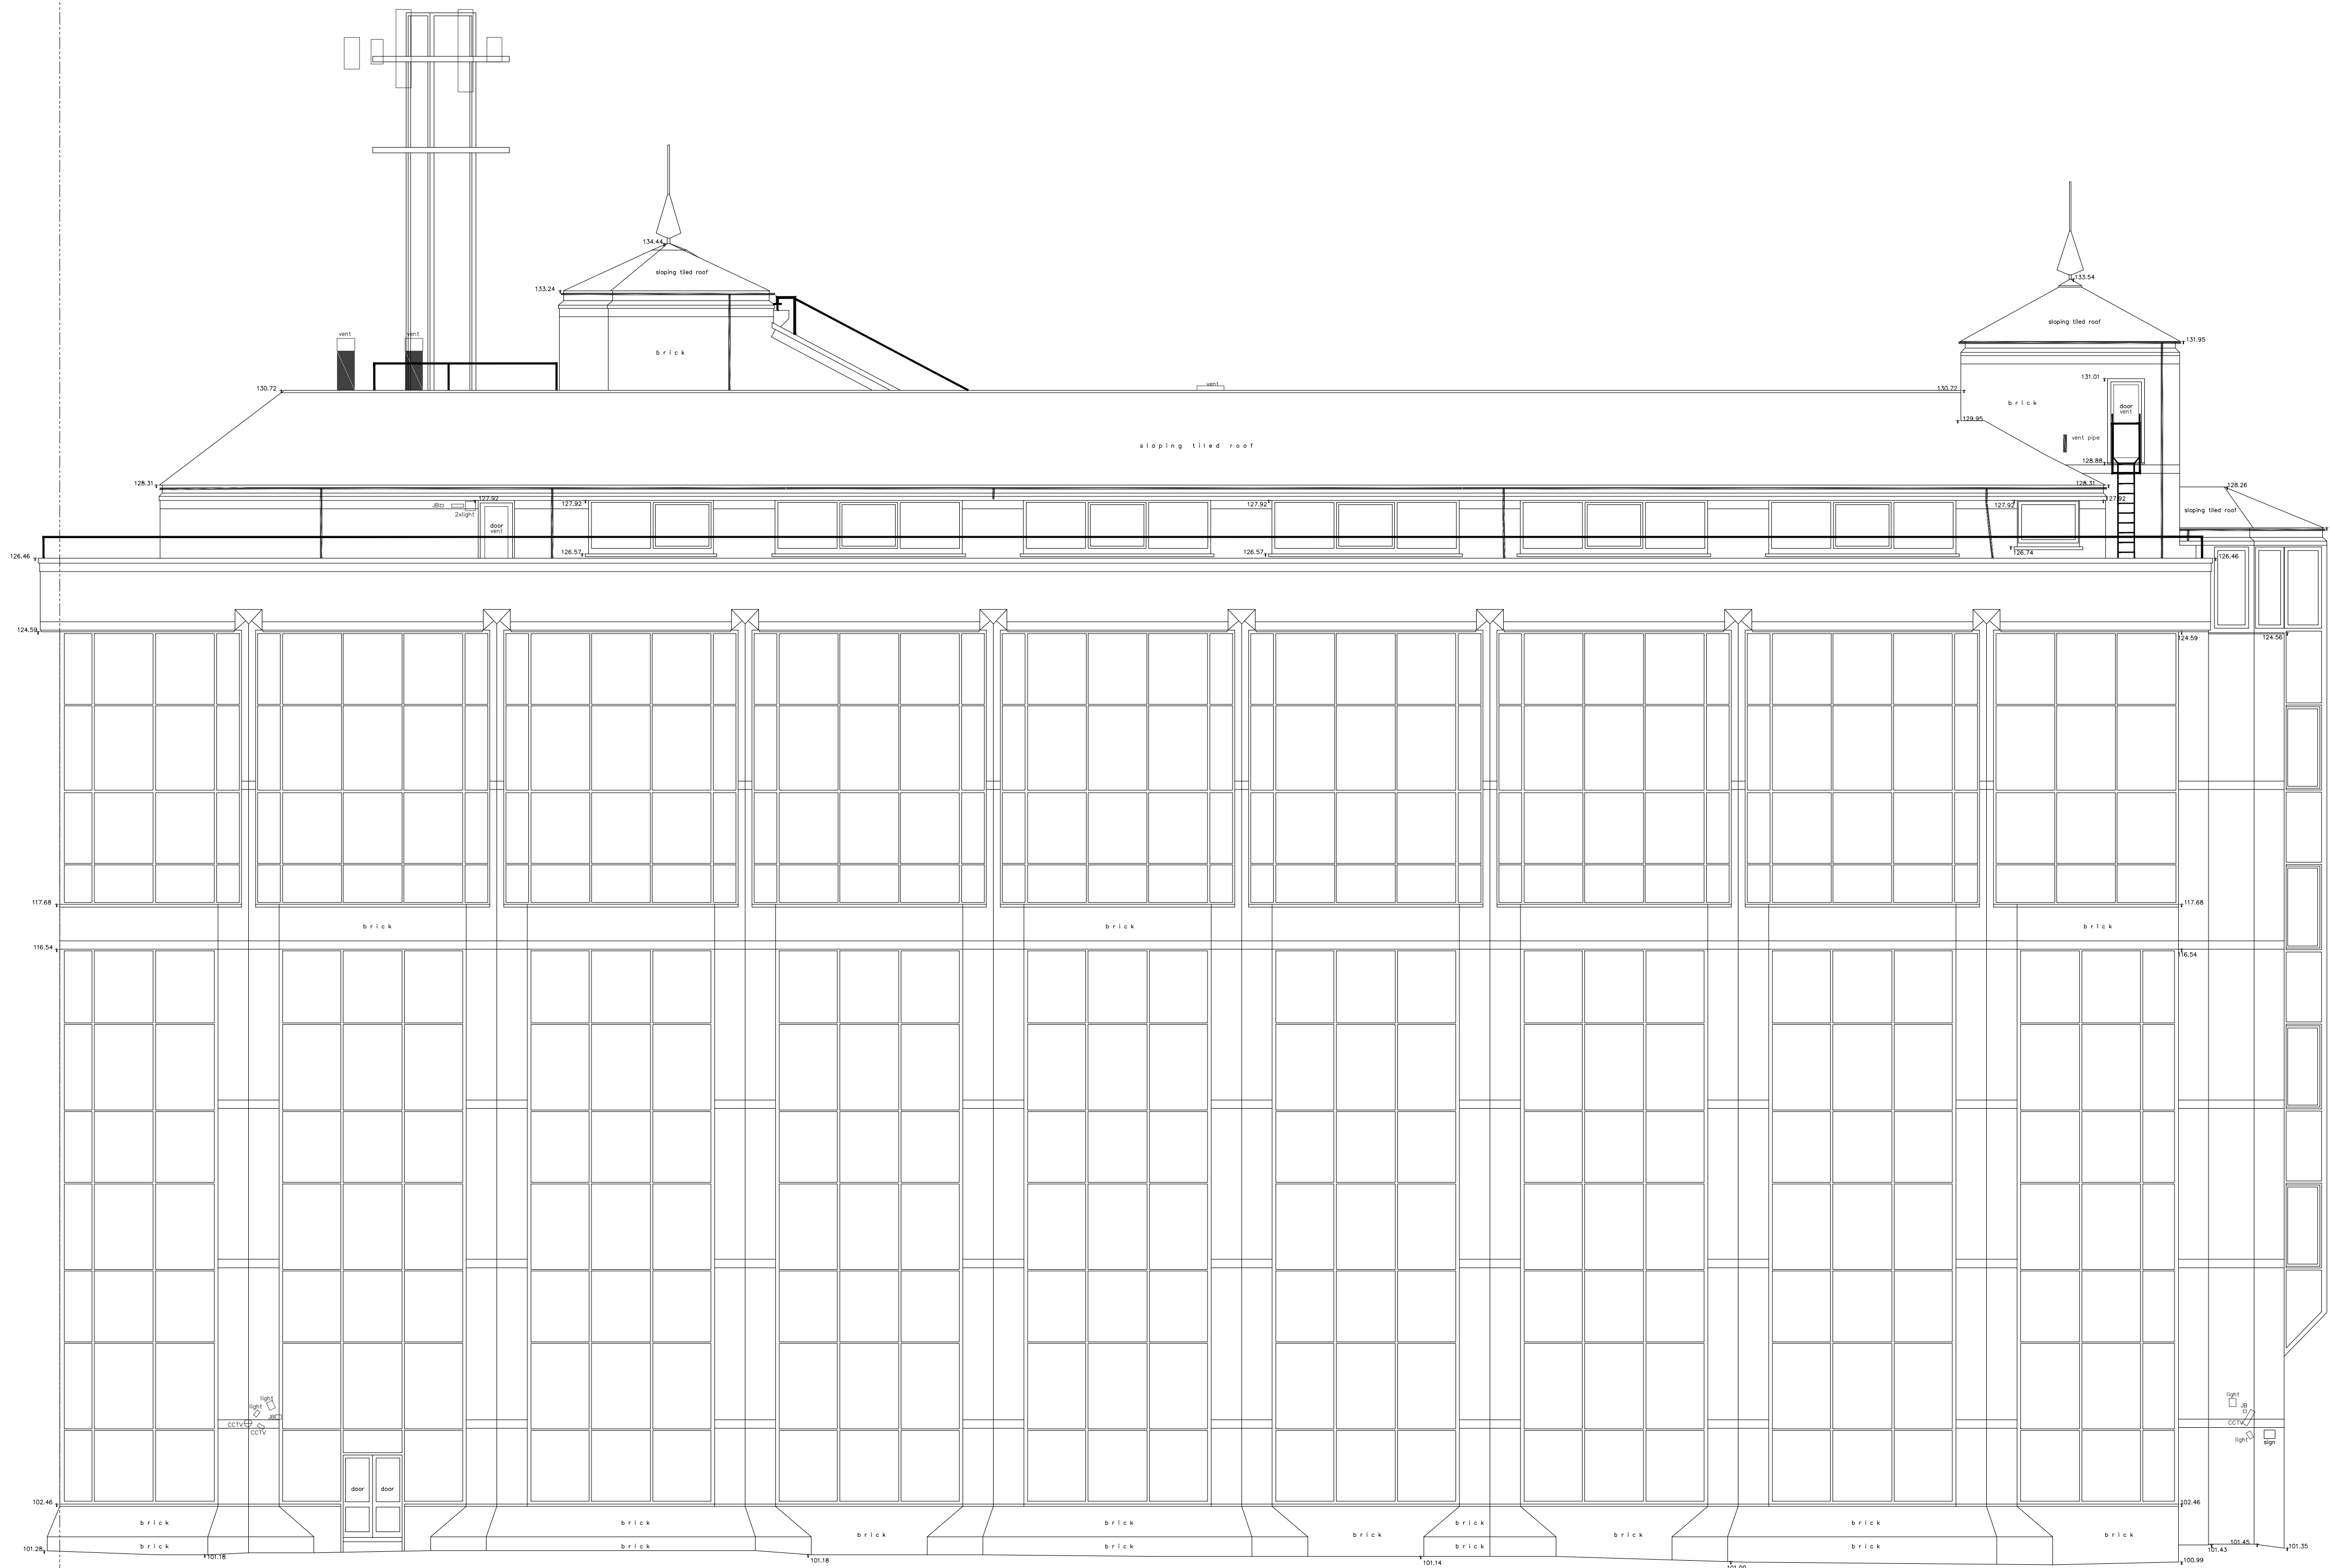


A-3

Bend in UCS

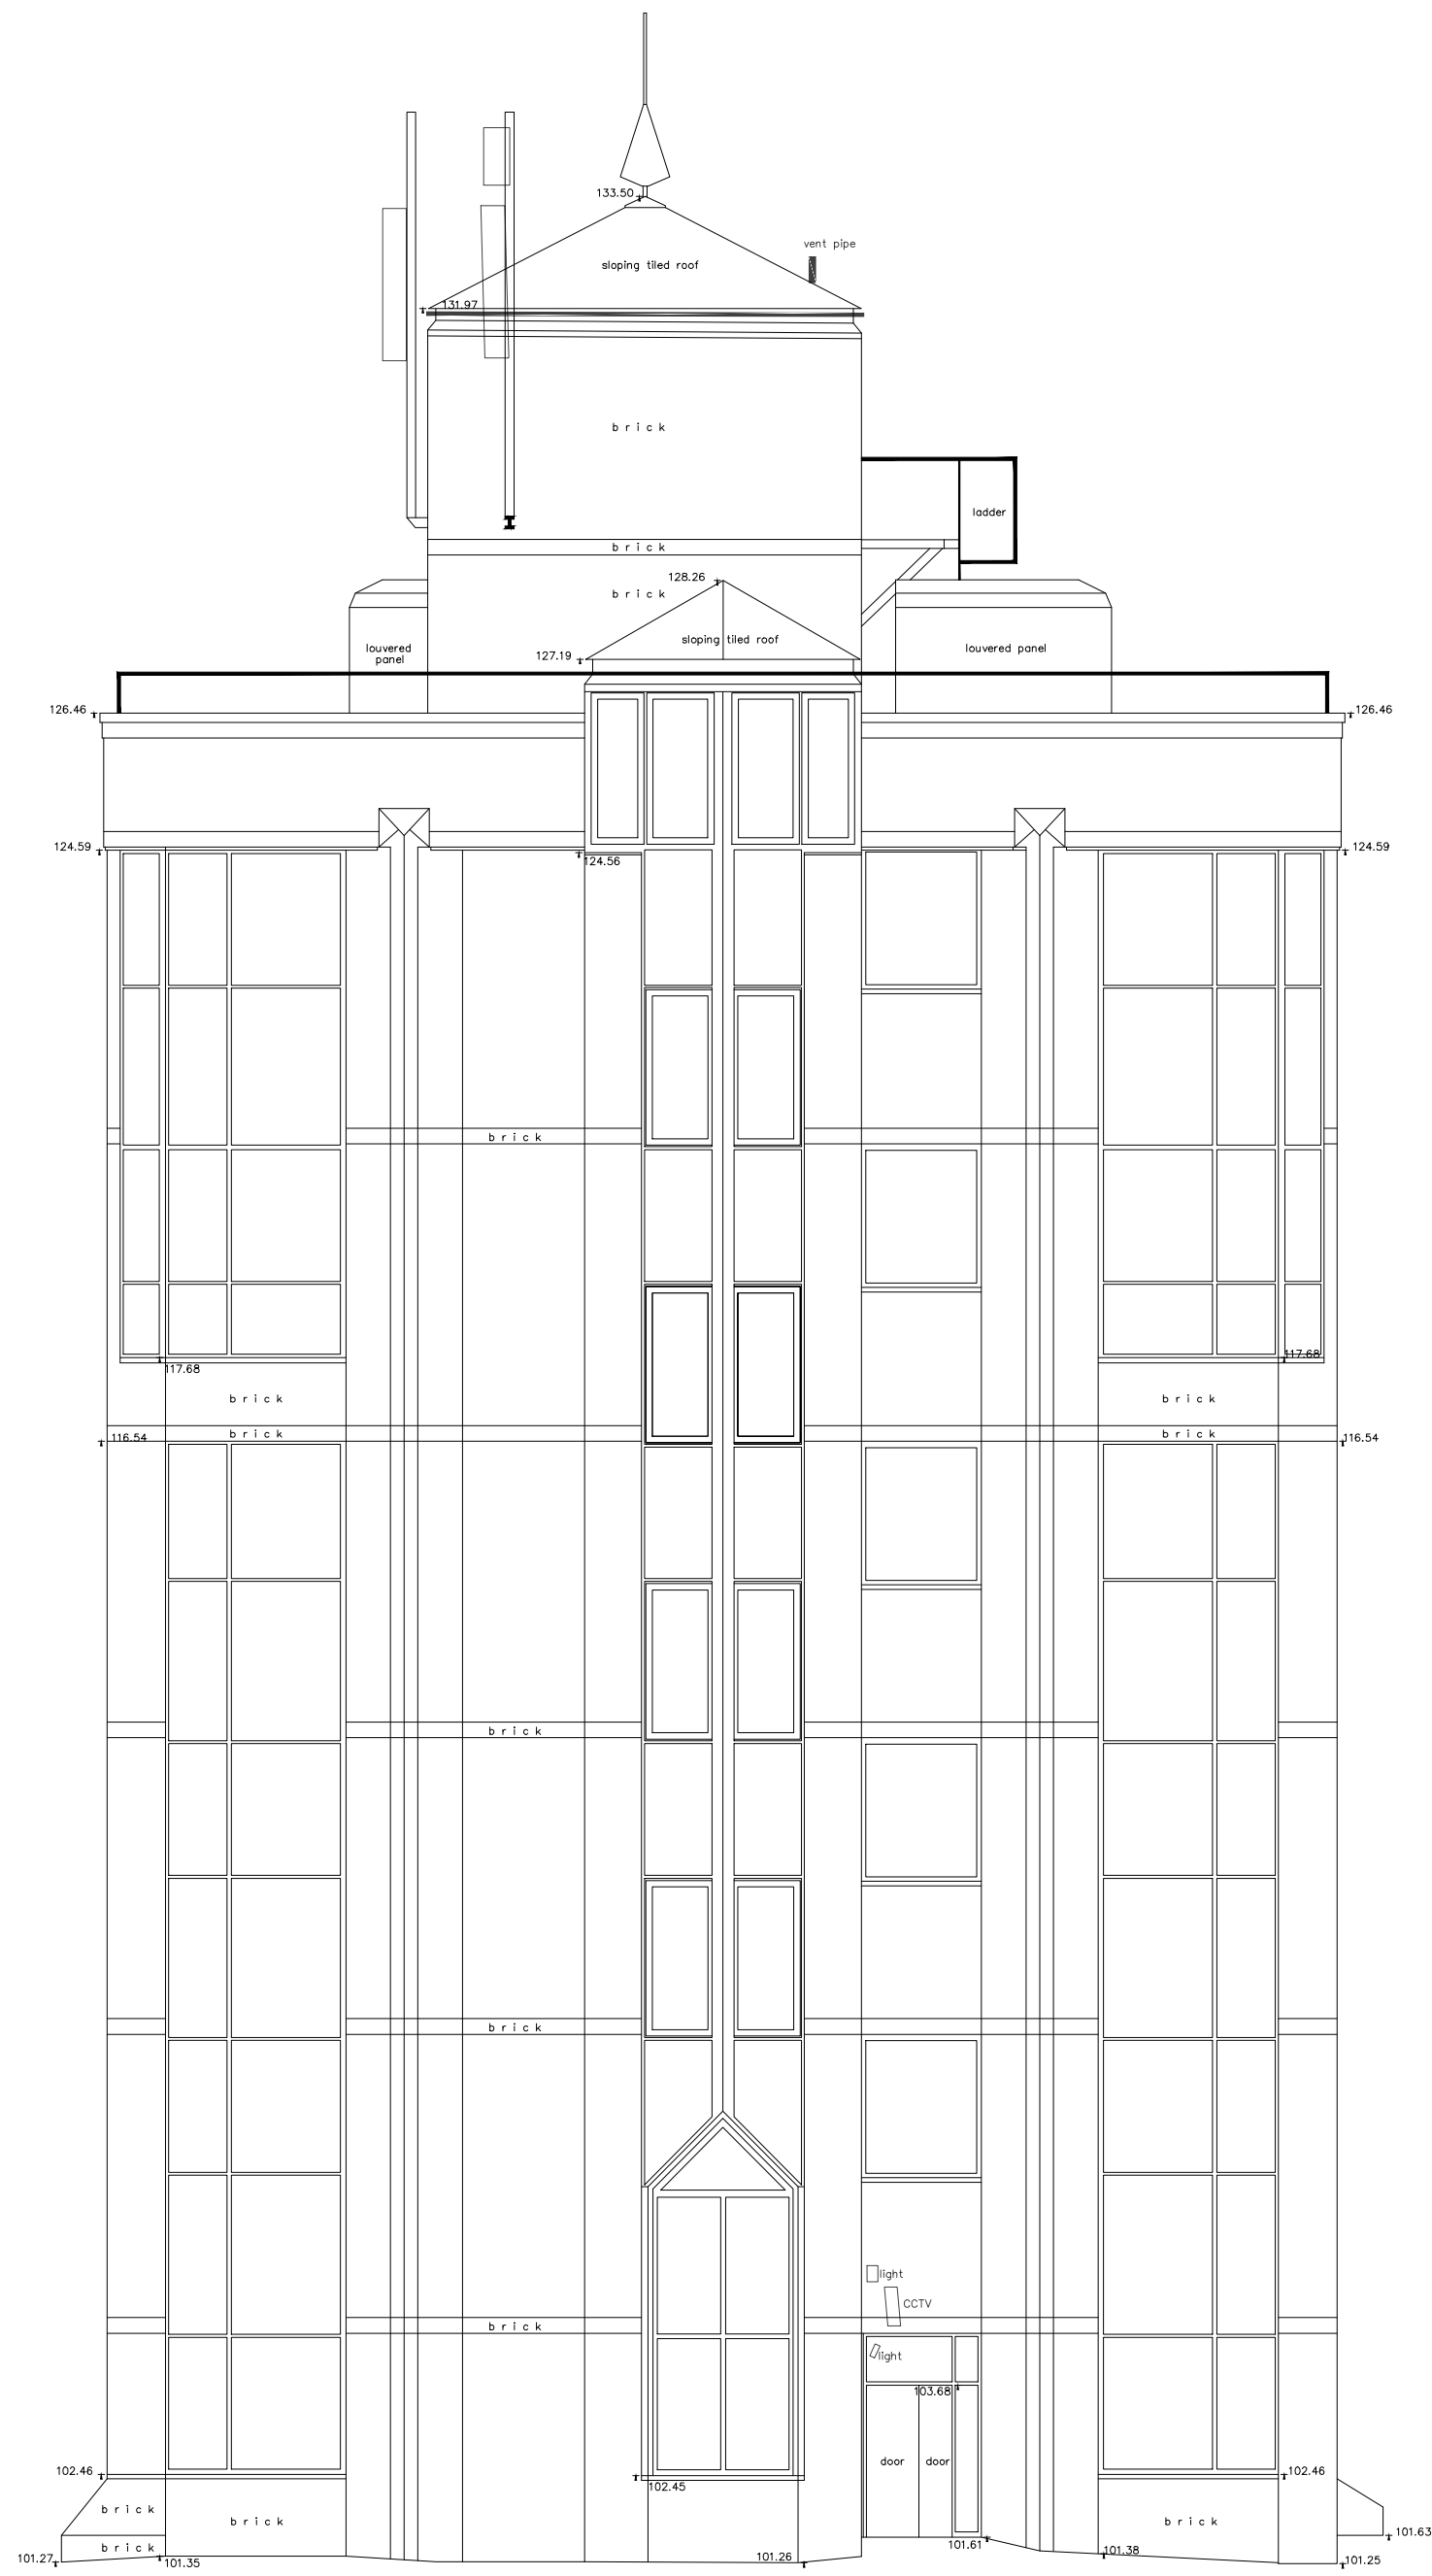


B


Datum: 95.00m

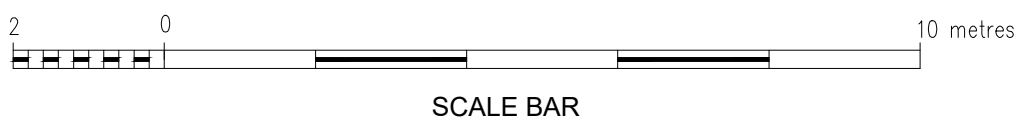

Datum: 95.00m

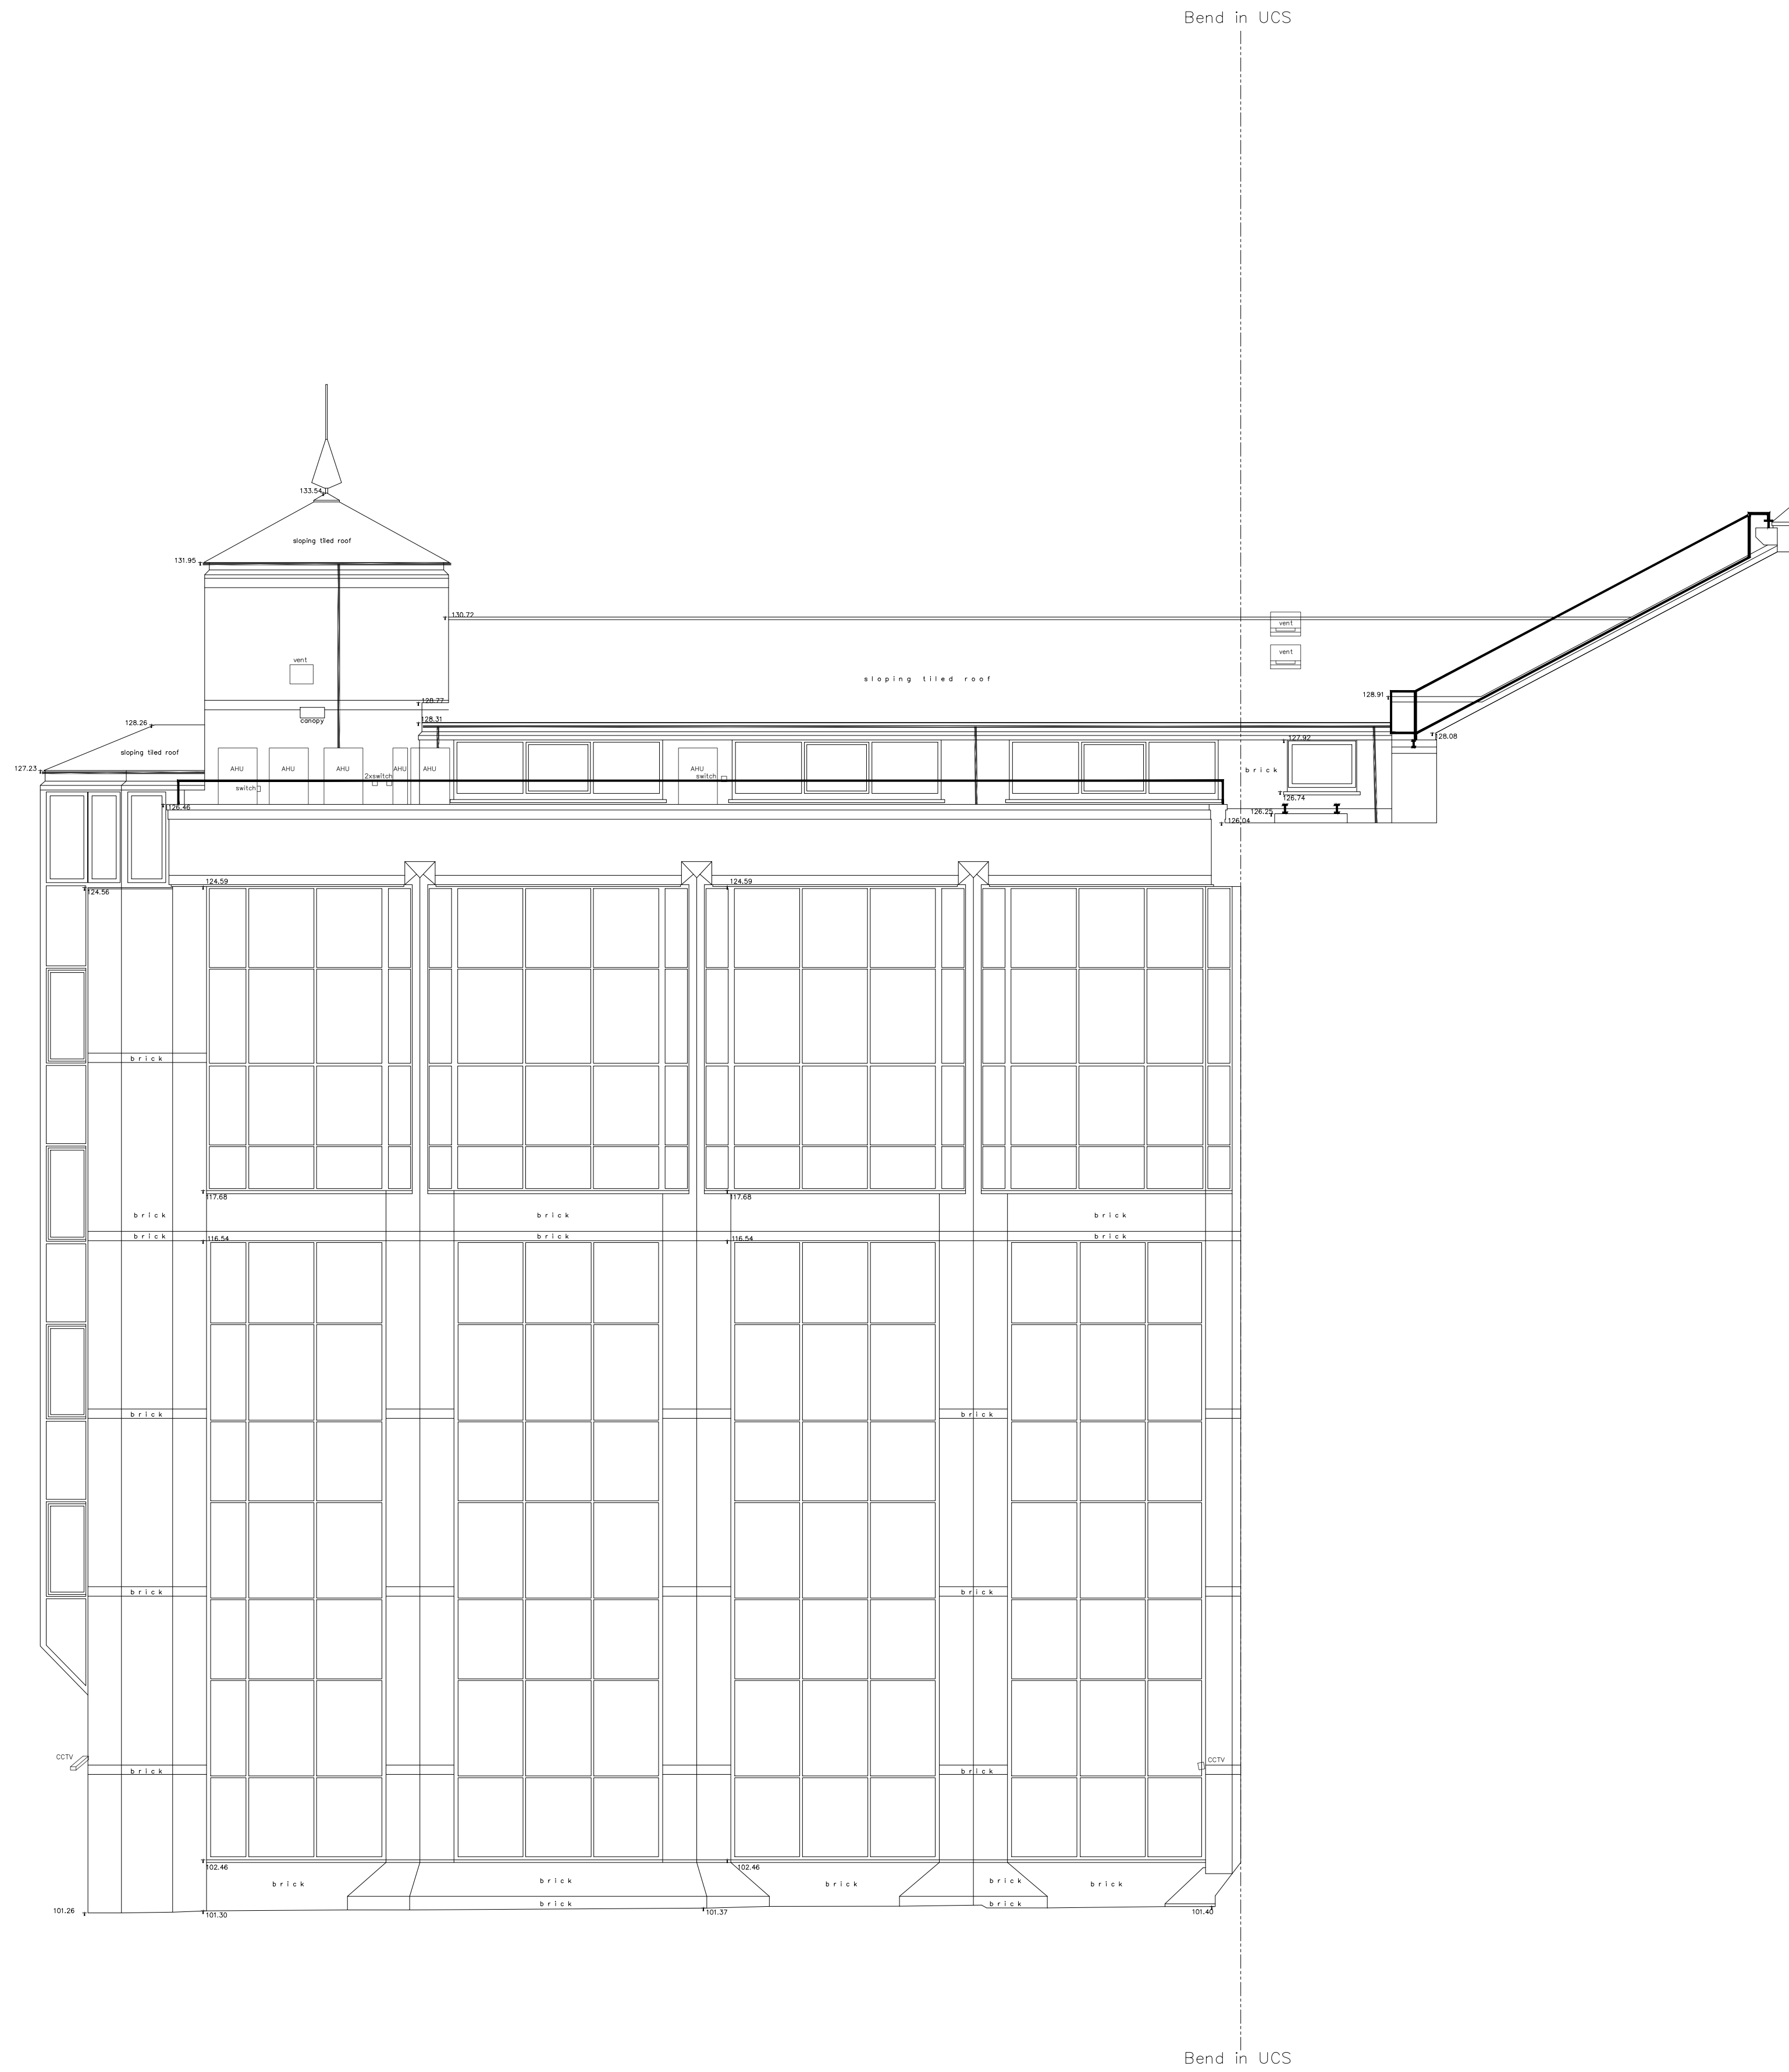

C-1

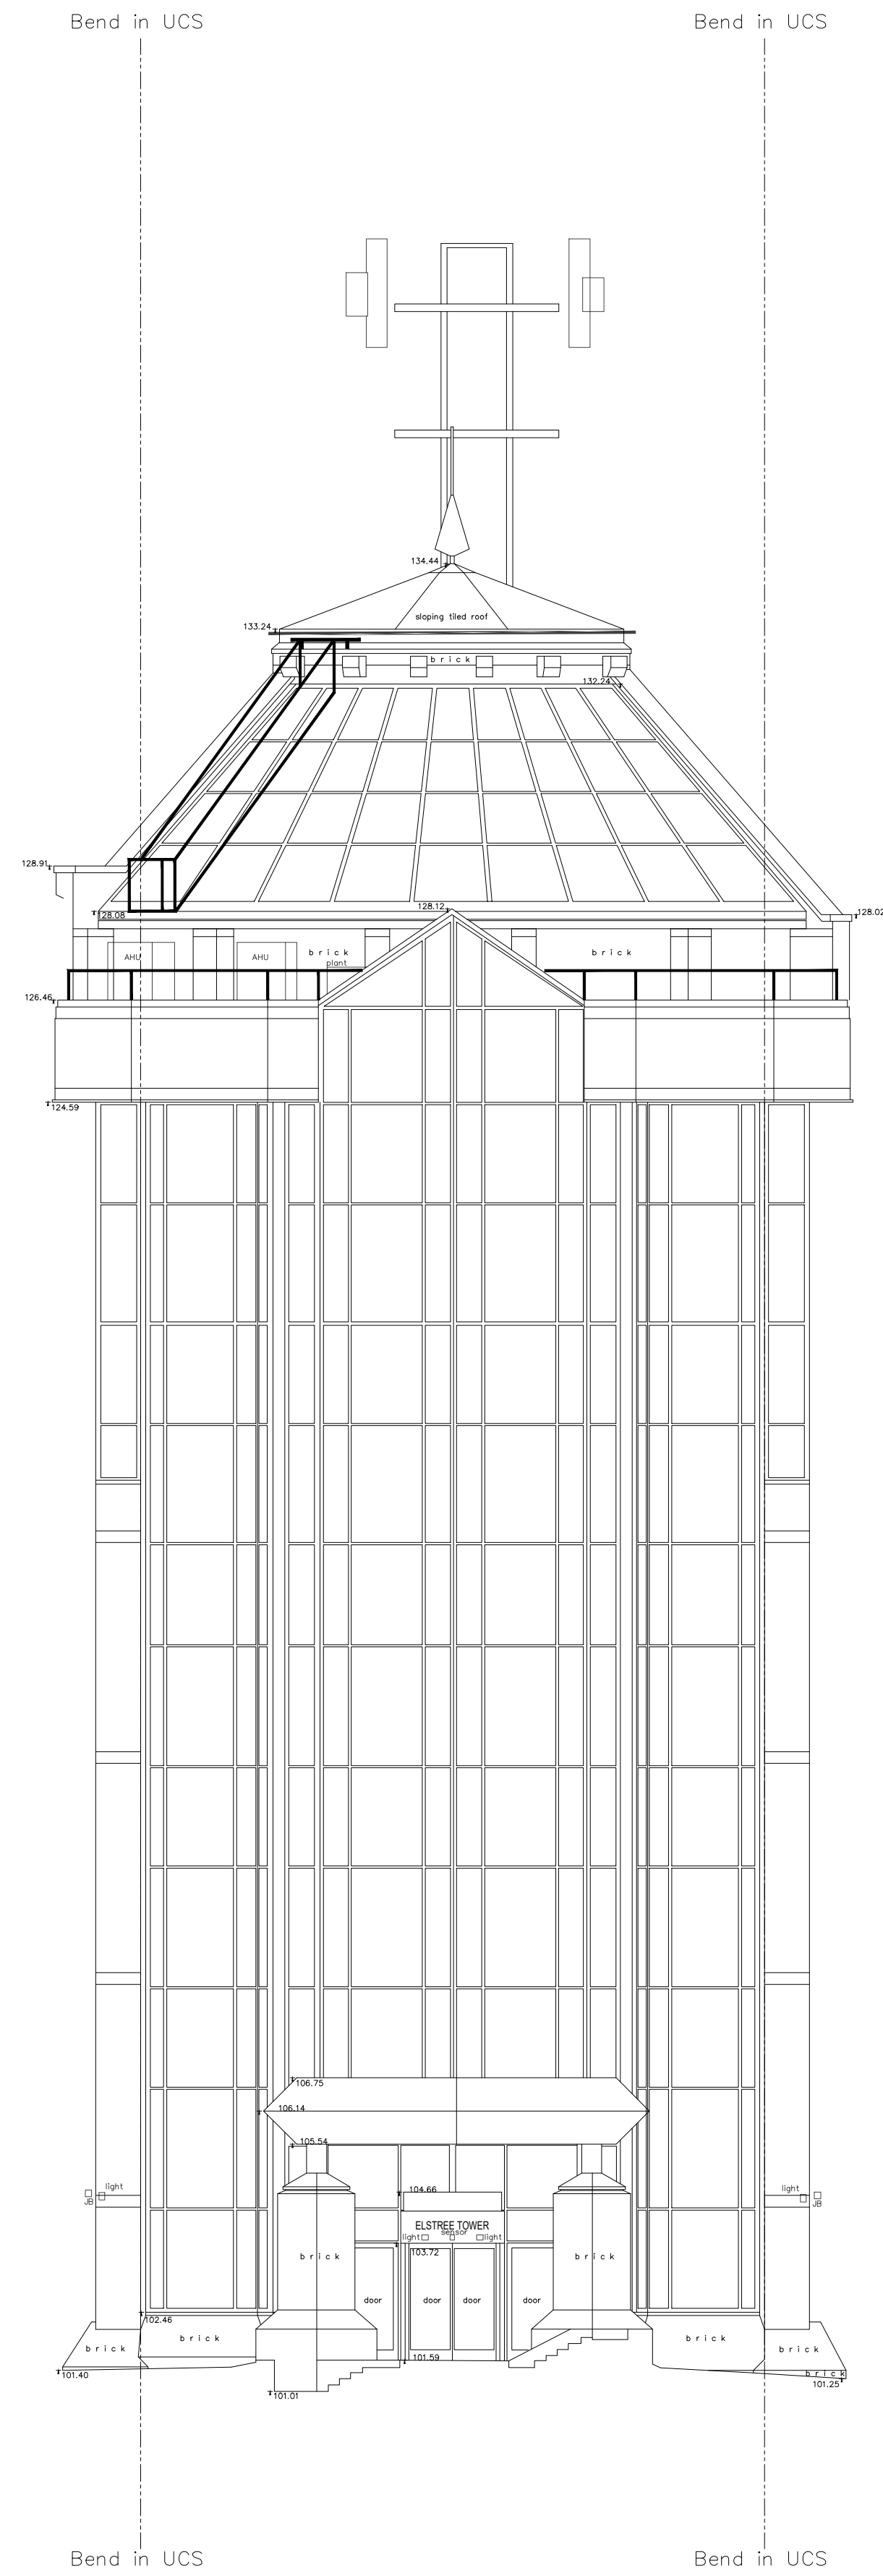


C-2

C COPYRIGHT RESERVED
Do Not Scale From Paper Copies


All levels related to Ordnance Survey active GPS network, at survey station 53.

LOCATION PLAN

NOT TO SCALE

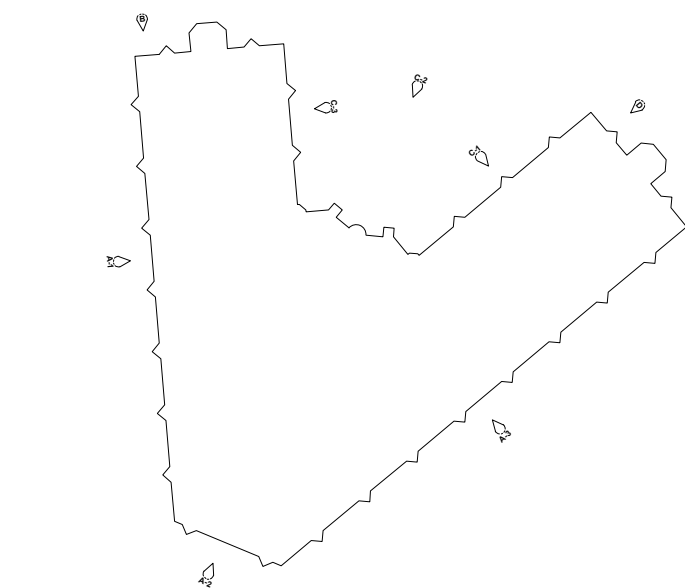

KEY

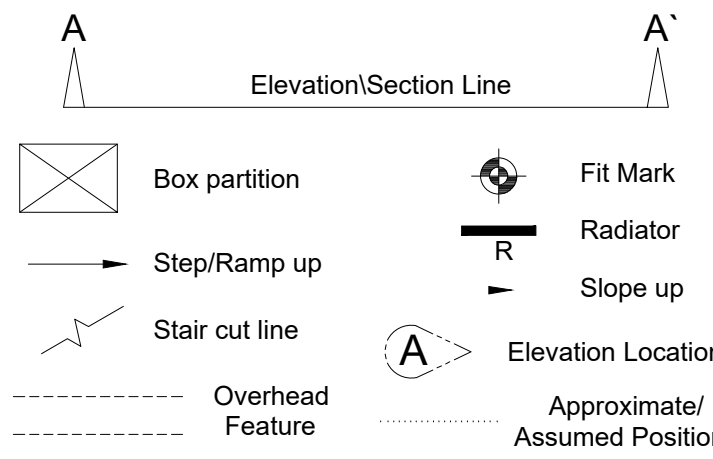

ABBREVIATIONS

p = Plinth Height
s = Sill Height
h = Head Height
c = Ceiling Height
b = Beam Height
sp = Spring Point Height
fc = False Ceiling Height
sc = Structural Ceiling Height
sf = Soffit Height
AB = Air Brick
AHU = Air Handling Unit
AV = Air Vent
CB = Cupboard
RL = Ridge Level
EL = Eaves Level
RFL = Roof Level
SFL = Soffit Level
TLL = Threshold Level
FFL = Finished Floor Level
PWL = Parapet Wall Level
+35.20 = Levels
+52.76 = Elevation level
JB = Junction Box
RSJ = Rolled Steel Joist
WT = Worktop

Client

PEGASUS PLANNING GROUP

Project

**ELSTREE TOWER, ELSTREE WAY,
BOREHAMWOOD, WD6 1SD**

Title

ELEVATIONS

Drawing Number

TS22-292-ET-11

Revision	Description	Rev. By	Date


Scale: 1:100@A0 Sheet 3 of 4

Drawn by HB	Checked by PG	Date of Survey JULY 2022
----------------	------------------	-----------------------------




Accreditations:




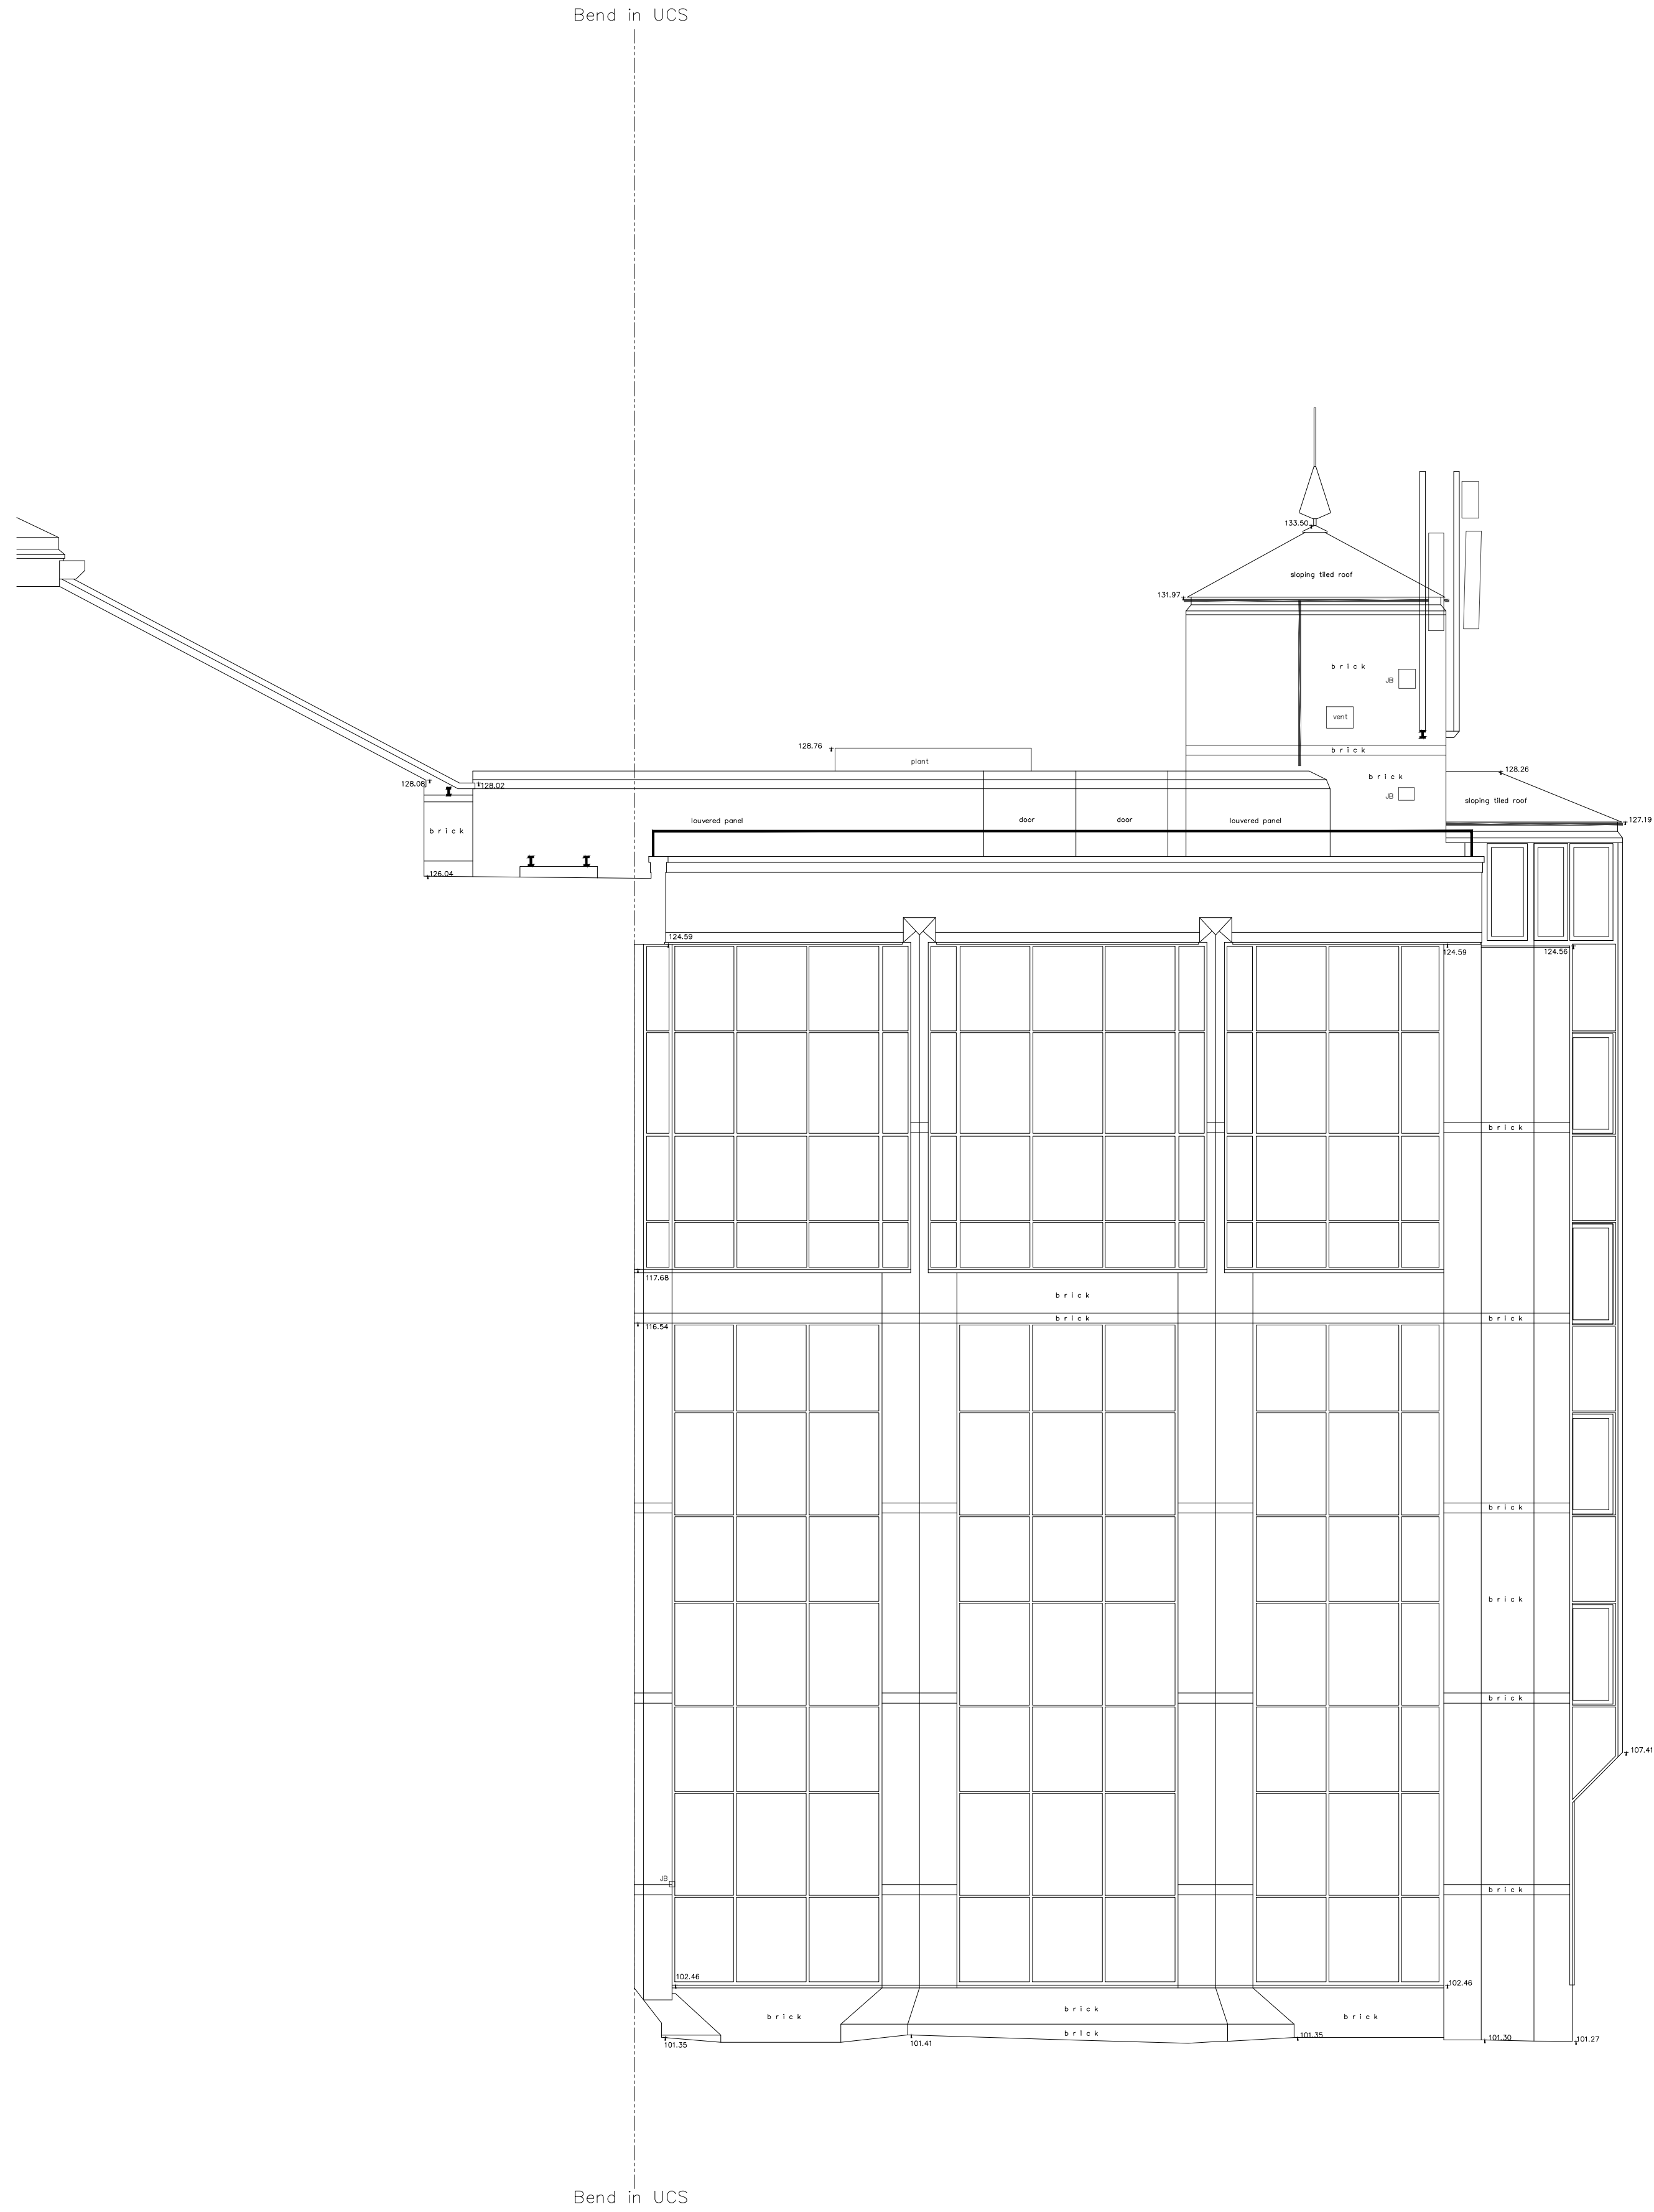

C-3

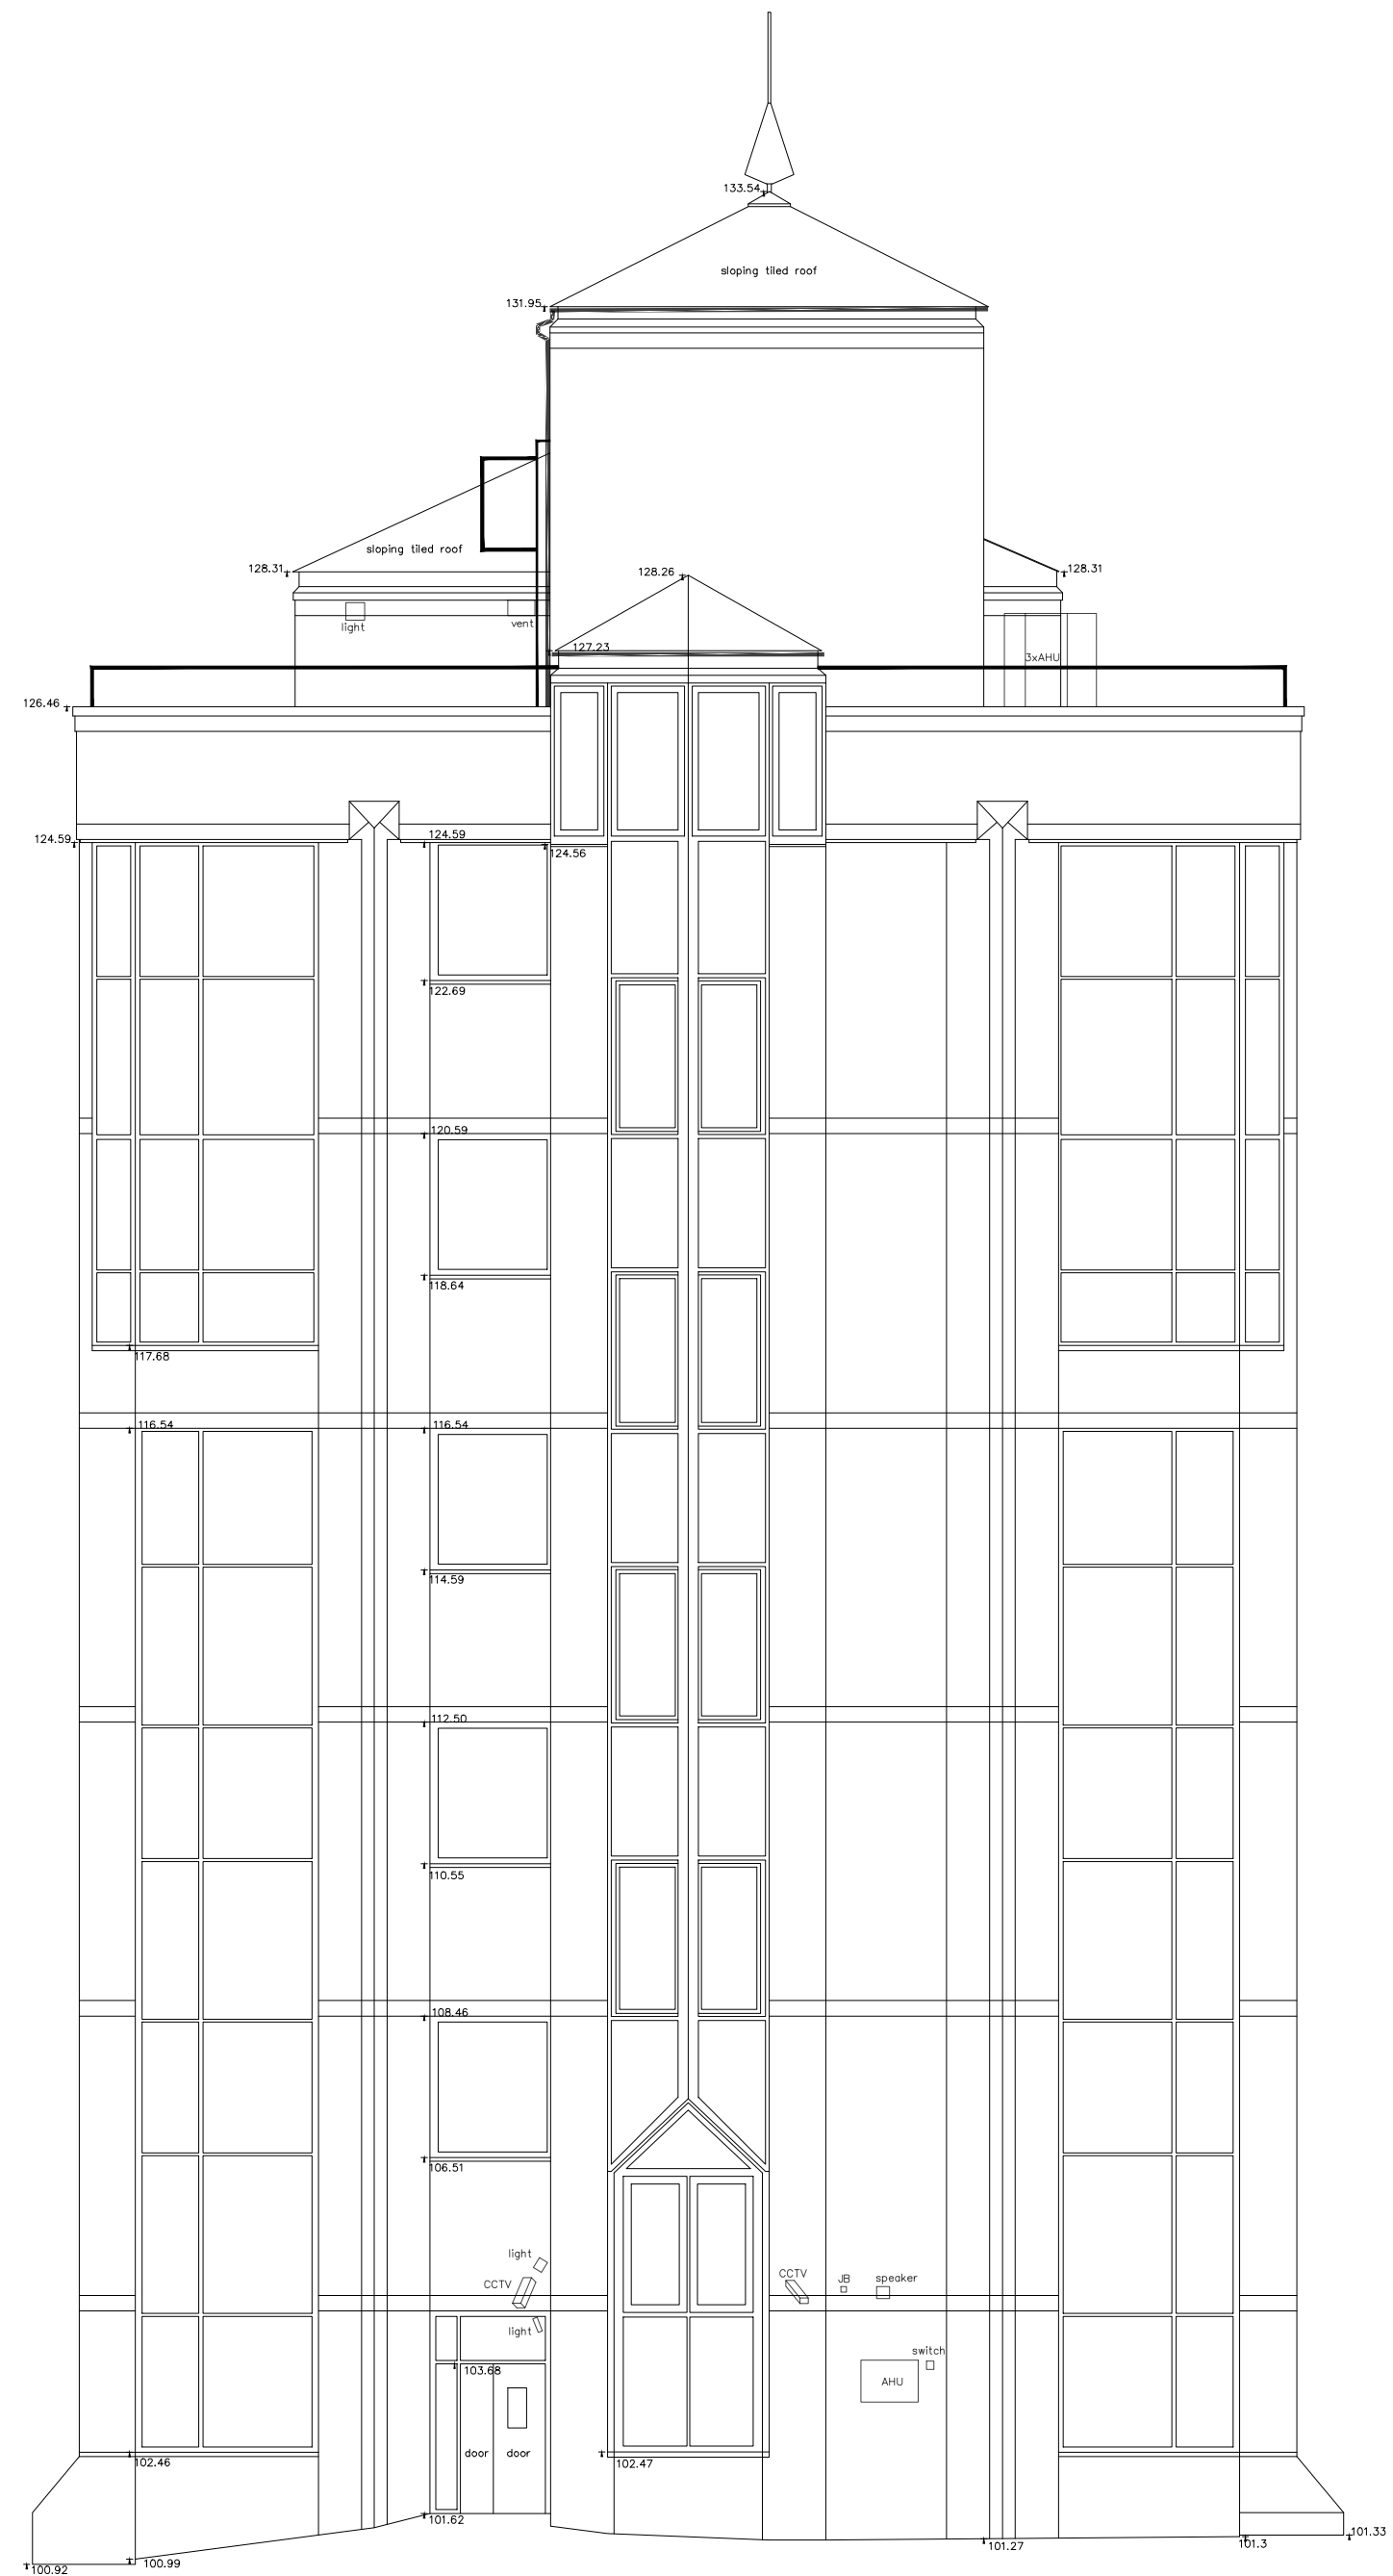

LOCATION PLAN
NOT TO SCALE

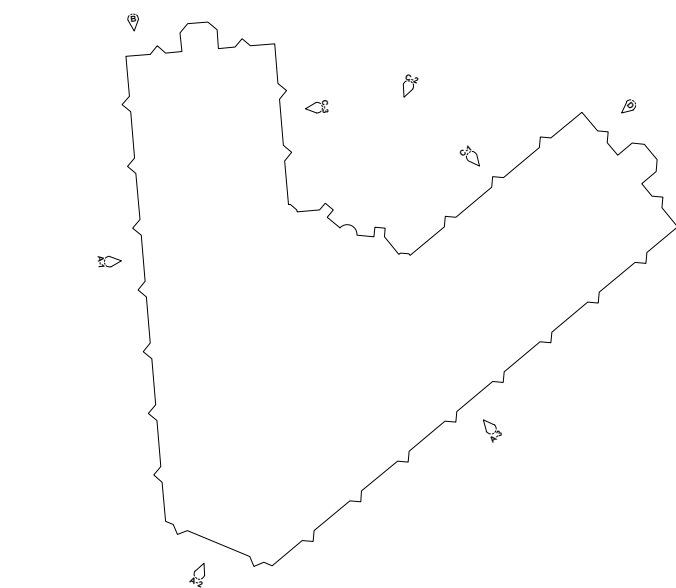

KEY	
	Box partition
	Step/Ramp up
	Stair cut line
	Overhead Feature
	Fit Mark
	Radiator
	Slope up
	Elevation Location
	Approximate/Assumed Position

ABBREVIATIONS	
p = Plinth Height	RL = Ridge Level
s = Sill Height	EL = Eaves Level
h = Head Height	RFL = Roof Level
c = Ceiling Height	SFL = Soffit Level
b = Beam Height	ThL = Threshold Level
sp = Spring Point Height	FFL = Finished Floor Level
fc = False Ceiling Height	PWL = Parapet Wall Level
sc = Structural Ceiling Height	+35.20 = Levels
sf = Soffit Height	+52.76 = Elevation level
AB = Air Brick	JB = Junction Box
AHU = Air Handling Unit	RSJ = Rolled Steel Joist
AV = Air Vent	WT = Worktop
CB = Cupboard	

Client
PEGASUS PLANNING GROUP

Project
**ELSTREE TOWER, ELSTREE WAY,
BOREHAMWOOD, WD6 1SD**

Title
ELEVATIONS

Drawing Number
TS22-292-ET-12


Revision	Description	Rev. By	Date

Scale	1:100@A0	Sheet	4 of 4
Drawn by	HB	Checked by	PG
		Date of Survey	JULY 2022



All levels related to Ordnance Survey active GPS network.

KEY

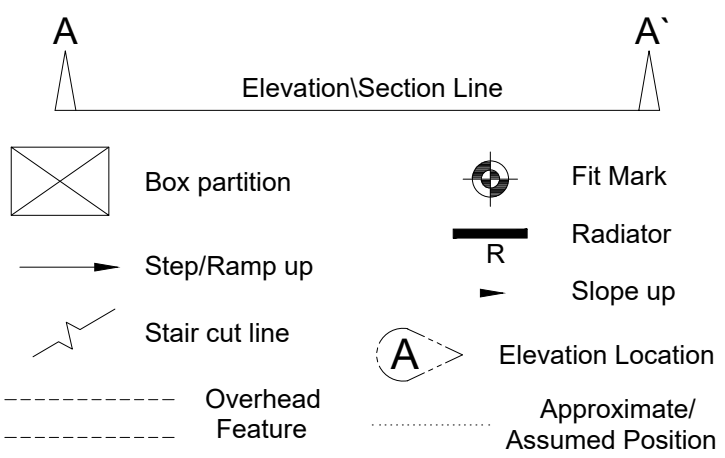

ABBREVIATIONS

p = Plinth Height
s = Sill Height
h = Head Height
c = Ceiling Height
b = Beam Height
sp = Spring Point Height
fc = False Ceiling Height
sc = Structural Ceiling Height
sf = Soffit Height

RL = Ridge Level
EL = Eaves Level
RFL = Roof Level
SFL = Soffit Level
THL = Threshold Level
FFL = Finished Floor Level
PWL = Parapet Wall Level
+35.20 = Levels
T 52.76 = Elevation level

AB = Air Brick
AHU = Air Handling Unit
AV = Air Vent
CB = Cupboard

JB = Junction Box
RSJ = Rolled Steel Joist
WT = Worktop

Client

**PEGASUS PLANNING GROUP
(LONDON)**

Project

**ELSTREE TOWER CAR PARK
ELSTREE WAY
BOREHAMWOOD**

Title

FLOOR PLANS

Drawing Number

TS22-292-CP-1

Revision	Description	Rev. By	Date

Scale	1:100@A1	Sheet	1	of	7
-------	----------	-------	---	----	---

Drawn by AB	Checked by LC	Date of Survey JULY 2022
----------------	------------------	-----------------------------




Tel: 01438 841300
www.terrainsurveys.co.uk
enquiries@terrainsurveys.co.uk


Accreditations:




BASEMENT

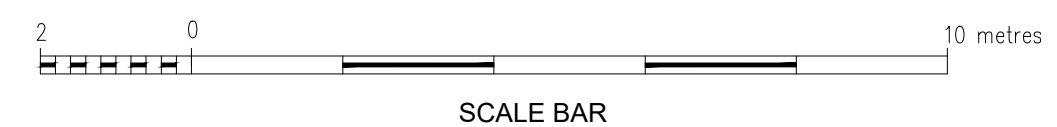

GROUND FLOOR

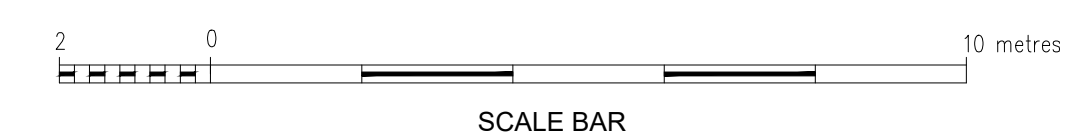

KEY

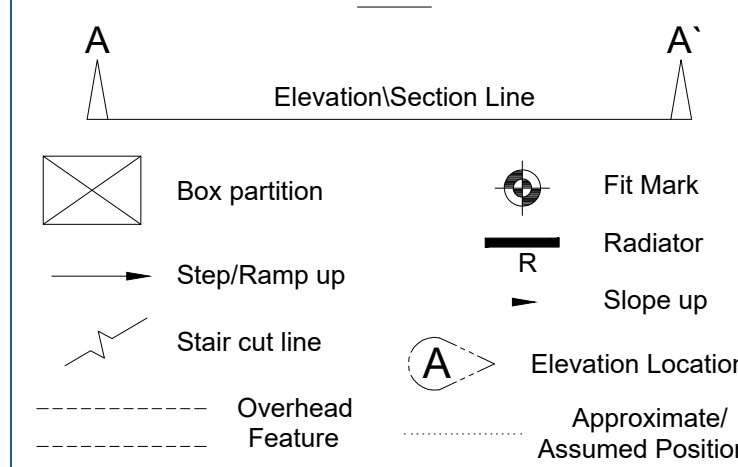

ABBREVIATIONS

p = Plinth Height
s = Sill Height
h = Head Height
c = Ceiling Height
b = Beam Height
sp = Spring Point Height
fc = False Ceiling Height
sc = Recessed Ceiling Height
sf = Soffit Height

AB = Air Brick
AHU = Air Handling Unit
AV = Air Vent
CB = Cupboard

RL = Ridge Level
EL = Eaves Level
RFL = Roof Level
SFL = Soffit Level
THL = Threshold Level
FHL = Finished Floor Level
PWL = Parapet Wall Level
+35.20 = Levels
52.76 = Elevation Level

JB = Junction Box
RSJ = Rolled Steel Joist
W = Worktop

Client	
--------	--

**PEGASUS PLANNING GROUP
(LONDON)**

Project	
---------	--

**ELSTREE TOWER CAR PARK
ELSTREE WAY
BOREHAMWOOD**

Title

FLOOR PLAN

Drawing Number

TS22-292-CP-2

Revision	Description	Rev. By	Date

Scale	1:100@A1	Sheet	2	of	7
-------	----------	-------	---	----	---


Drawn by AB	Checked by LC	Date of Survey JUNE 2022
----------------	------------------	-----------------------------




Tel: 01438 841300
www.terrainsurveys.co.uk
enquiries@terrainsurveys.co.uk

Accreditations:



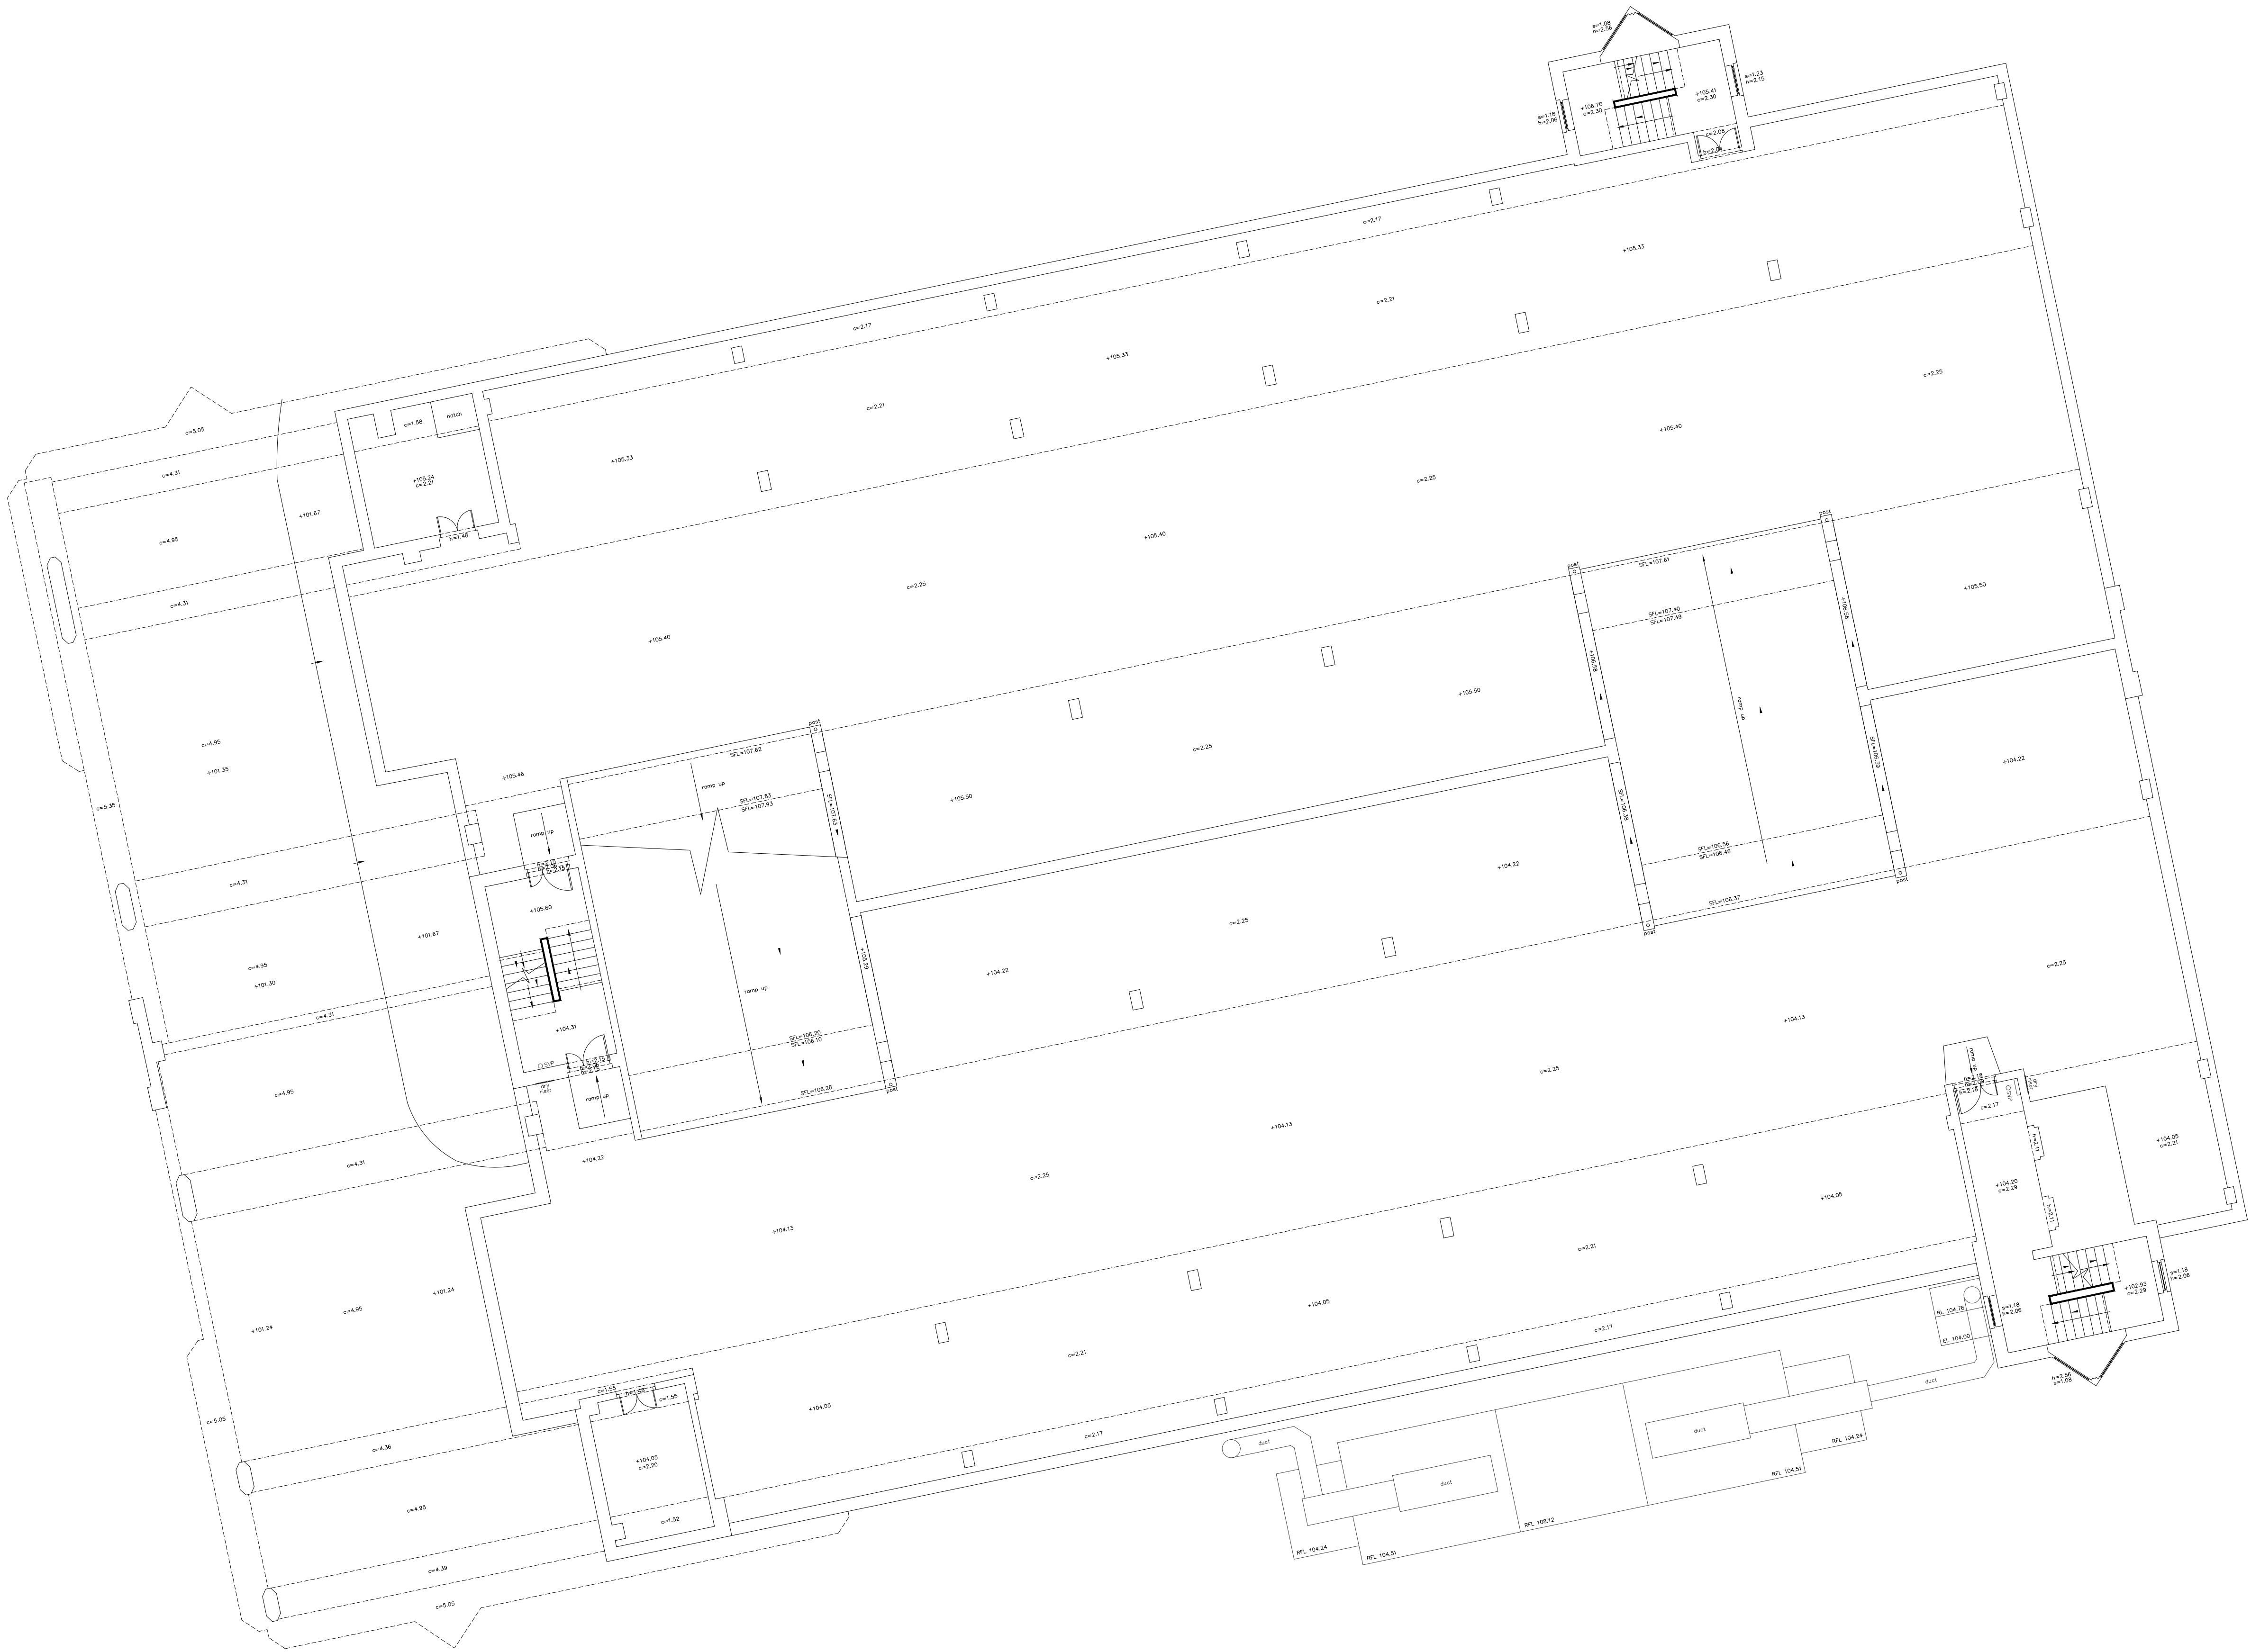

FIRST FLOOR

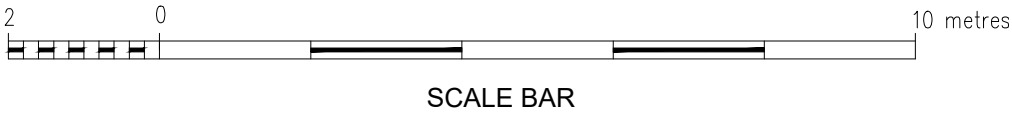

KEY

A ———— A'

Elevation/Section Line

Box partition

Step/Ramp up

Stair cut line

Overhead Feature

Fit Mark

Radiator

Slope up

Elevation Location

Approximate/Assumed Position

ABBREVIATIONS

p = Plinth Height
s = Sill Height
h = Head Height
c = Ceiling Height
b = Beam Height
sp = Spring Point Height
fc = False Ceiling Height
sc = Structural Ceiling Height
sf = Soffit Height

RL = Ridge Level
EL = Eaves Level
RFL = Roof Level
SFL = Soffit Level
THL = Threshold Level
FFL = Finished Floor Level
PWL = Parapet Wall Level
+35.20 = Levels
52.76 = Elevation level

AB = Air Brick
AHU = Air Handling Unit
AV = Air Vent
CB = Cupboard

JB = Junction Box
RSJ = Rolled Steel Joist
WT = Worktop

Client
**PEGASUS PLANNING GROUP
(LONDON)**

Project
**ELSTREE TOWER CAR PARK
ELSTREE WAY
BOREHAMWOOD**

Title
FLOOR PLAN

Drawing Number
TS22-292-CP-3

Revision	Description	Rev. By	Date

Scale	1:100@A1	Sheet	3 of 7
Drawn by	AB	Checked by	LC
Date of Survey	JUNE 2022		

TERRAIN SURVEYS

Tel: 01438 841300
www.terrain-surveys.co.uk
enquiries@terrain-surveys.co.uk

Accreditations:

chartered ices


THE SURVEY ASSOCIATION

ISOQAR


UKAS

0028
Certificate Number 1798
ISO 9001


CHAS
Accredited Contractor
CHAS.co.uk

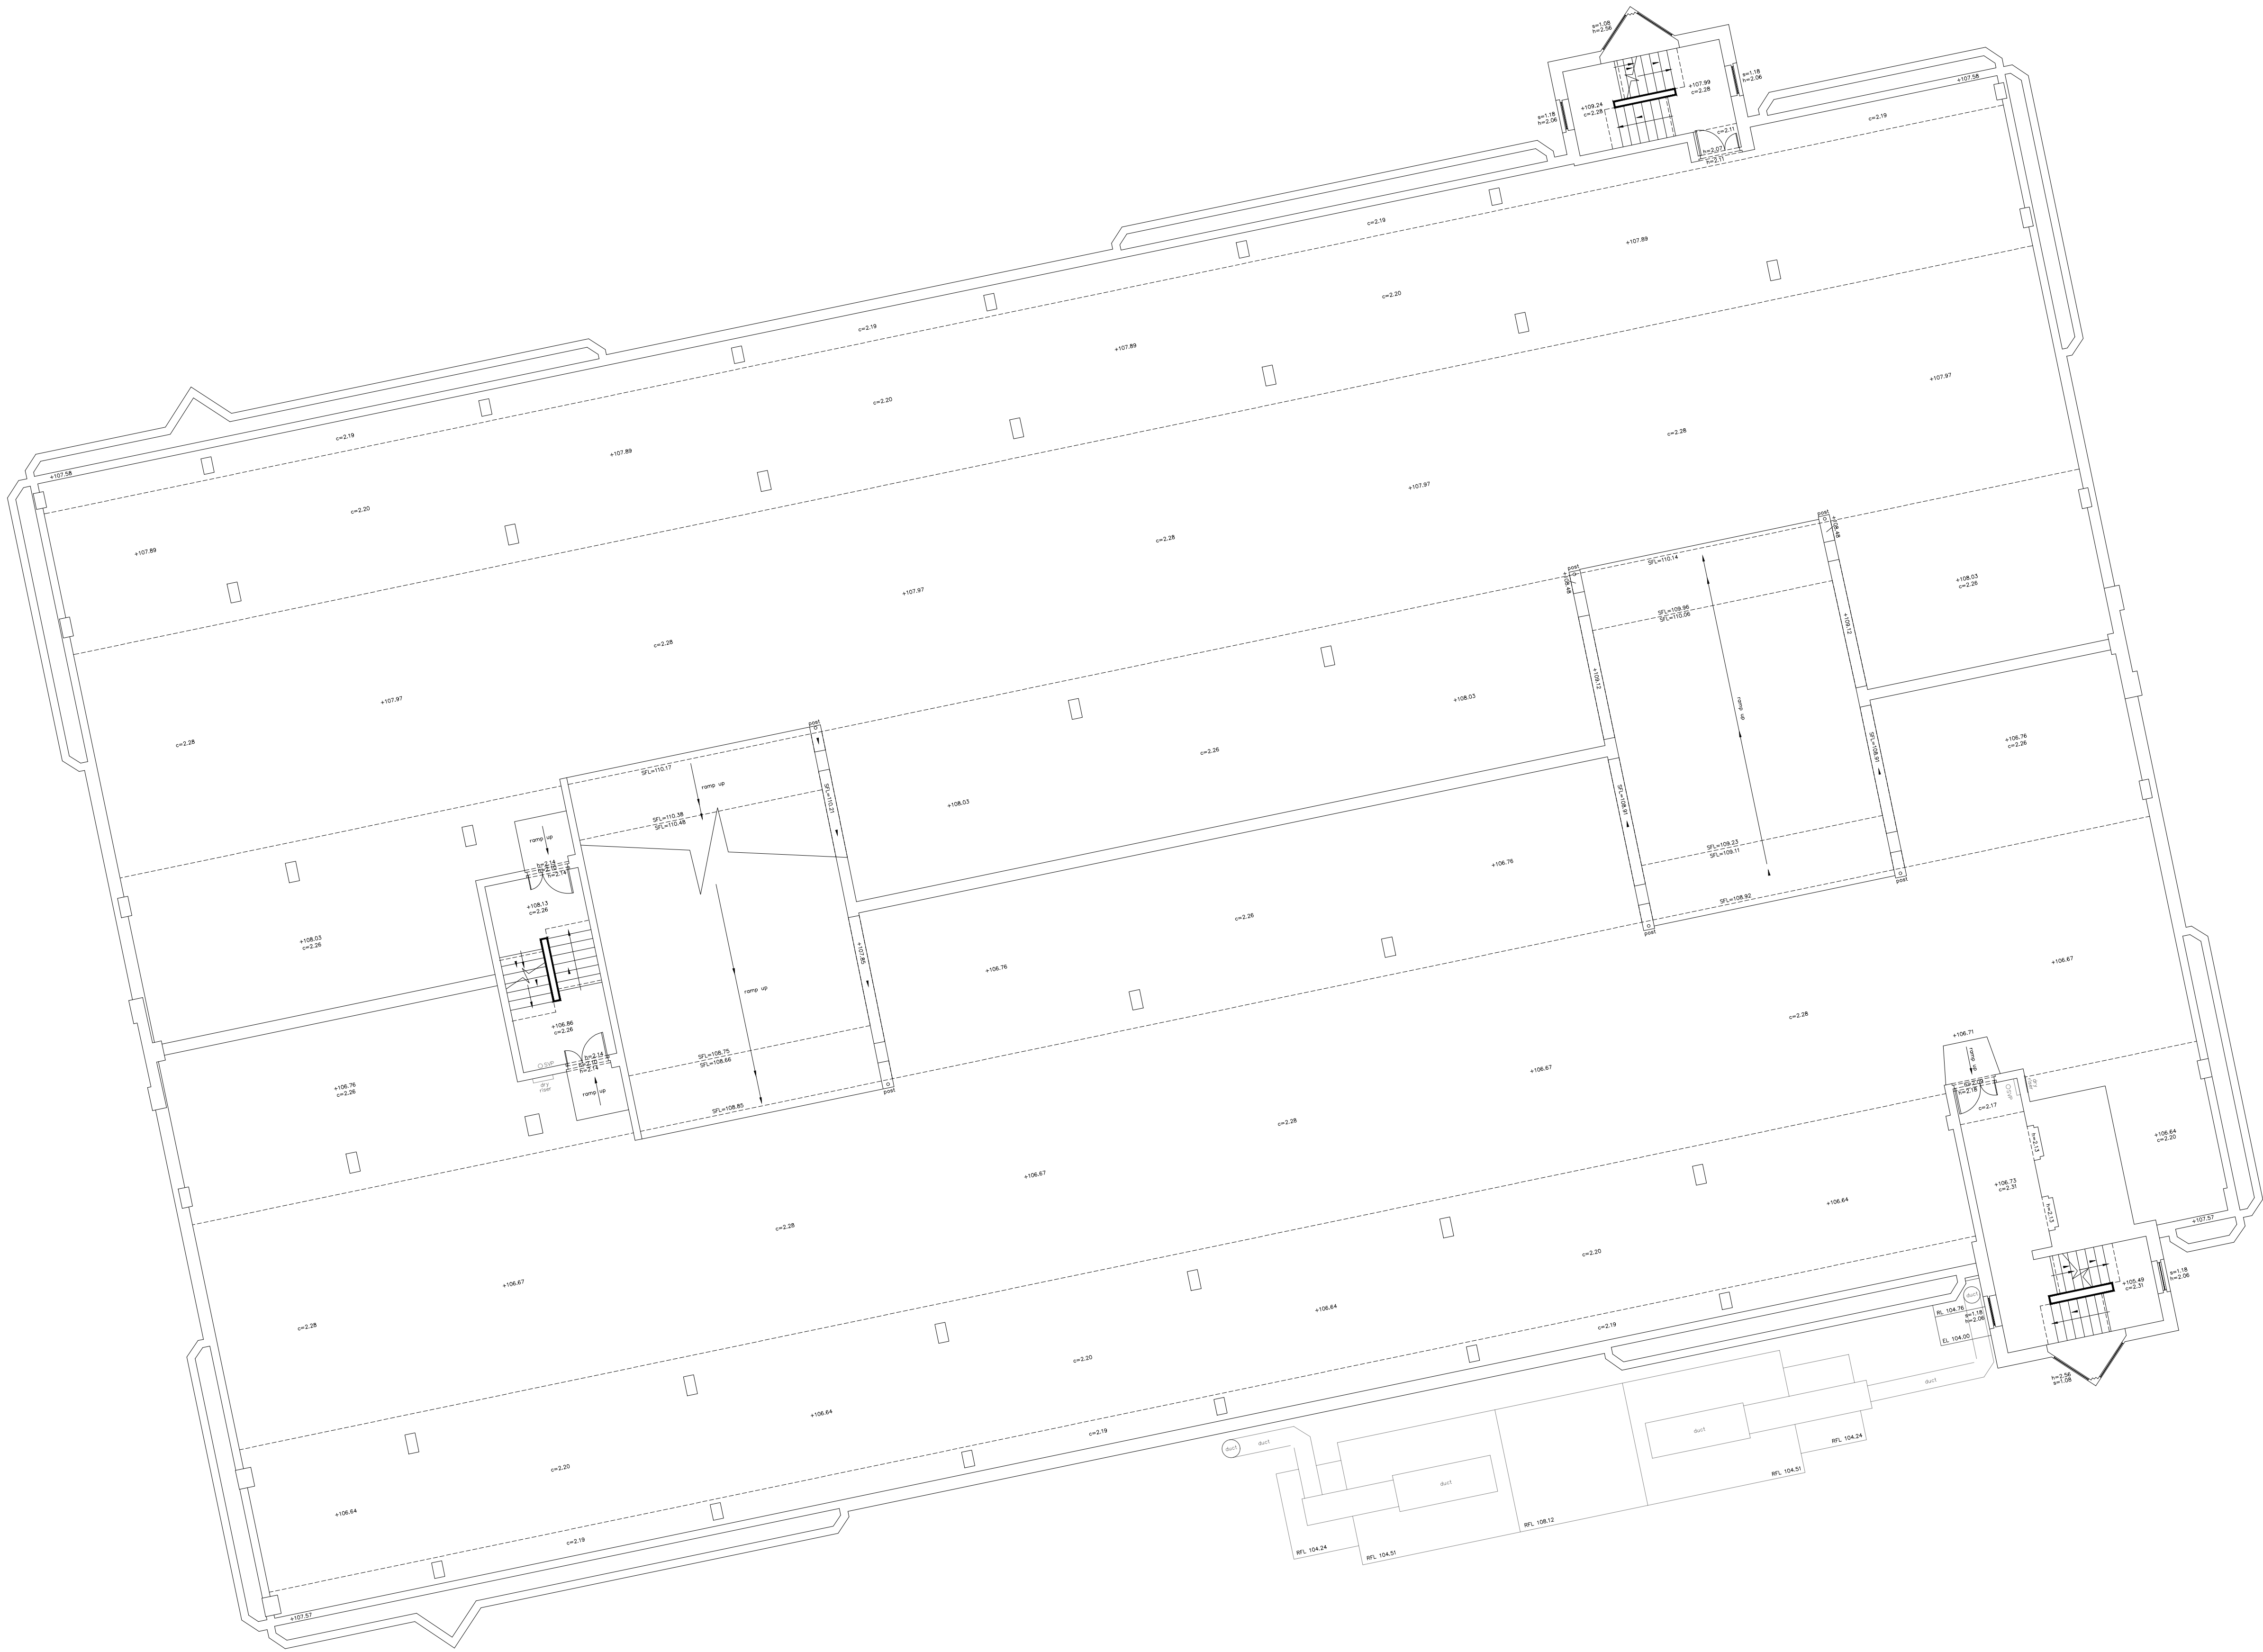

SECOND FLOOR

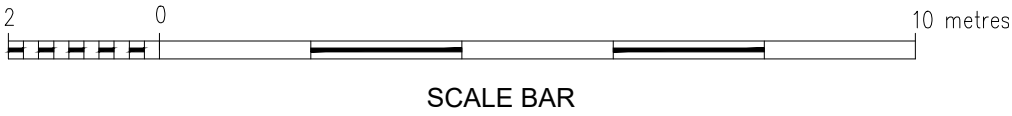

KEY

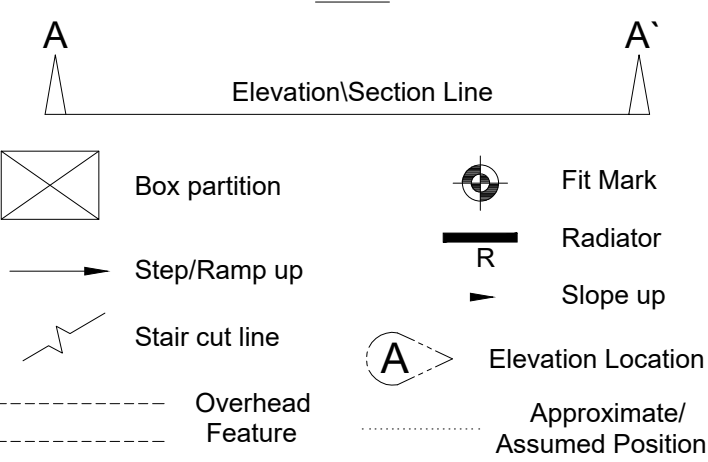

ABBREVIATIONS

p = Plinth Height
s = Sill Height
h = Head Height
c = Ceiling Height
b = Beam Height
sp = Spring Point Height
fc = False Ceiling Height
sc = Structural Ceiling Height
sf = Soffit Height
RL = Ridge Level
EL = Eaves Level
RFL = Roof Level
SFL = Soffit Level
THL = Threshold Level
FFL = Finished Floor Level
PWL = Parapet Wall Level
+35.20 = Levels
52.76 = Elevation level
AB = Air Brick
AHU = Air Handling Unit
AV = Air Vent
CB = Cupboard
JB = Junction Box
RSJ = Rolled Steel Joist
WT = Worktop

Client
PEGASUS PLANNING GROUP

Project
**ELSTREE TOWER, ELSTREE WAY,
BOREHAMWOOD, WD6 1SD**

Title
FLOOR PLAN

Drawing Number
TS22-292-CP-4

Revision	Description	Rev. By	Date

Scale 1:100@A1 Sheet 4 of 7

Drawn by AB Checked by LC Date of Survey JUNE 2022




**TERRAIN
SURVEYS**


Tel: 01438 841300
www.terrain-surveys.co.uk
enquiries@terrain-surveys.co.uk

Accreditations:




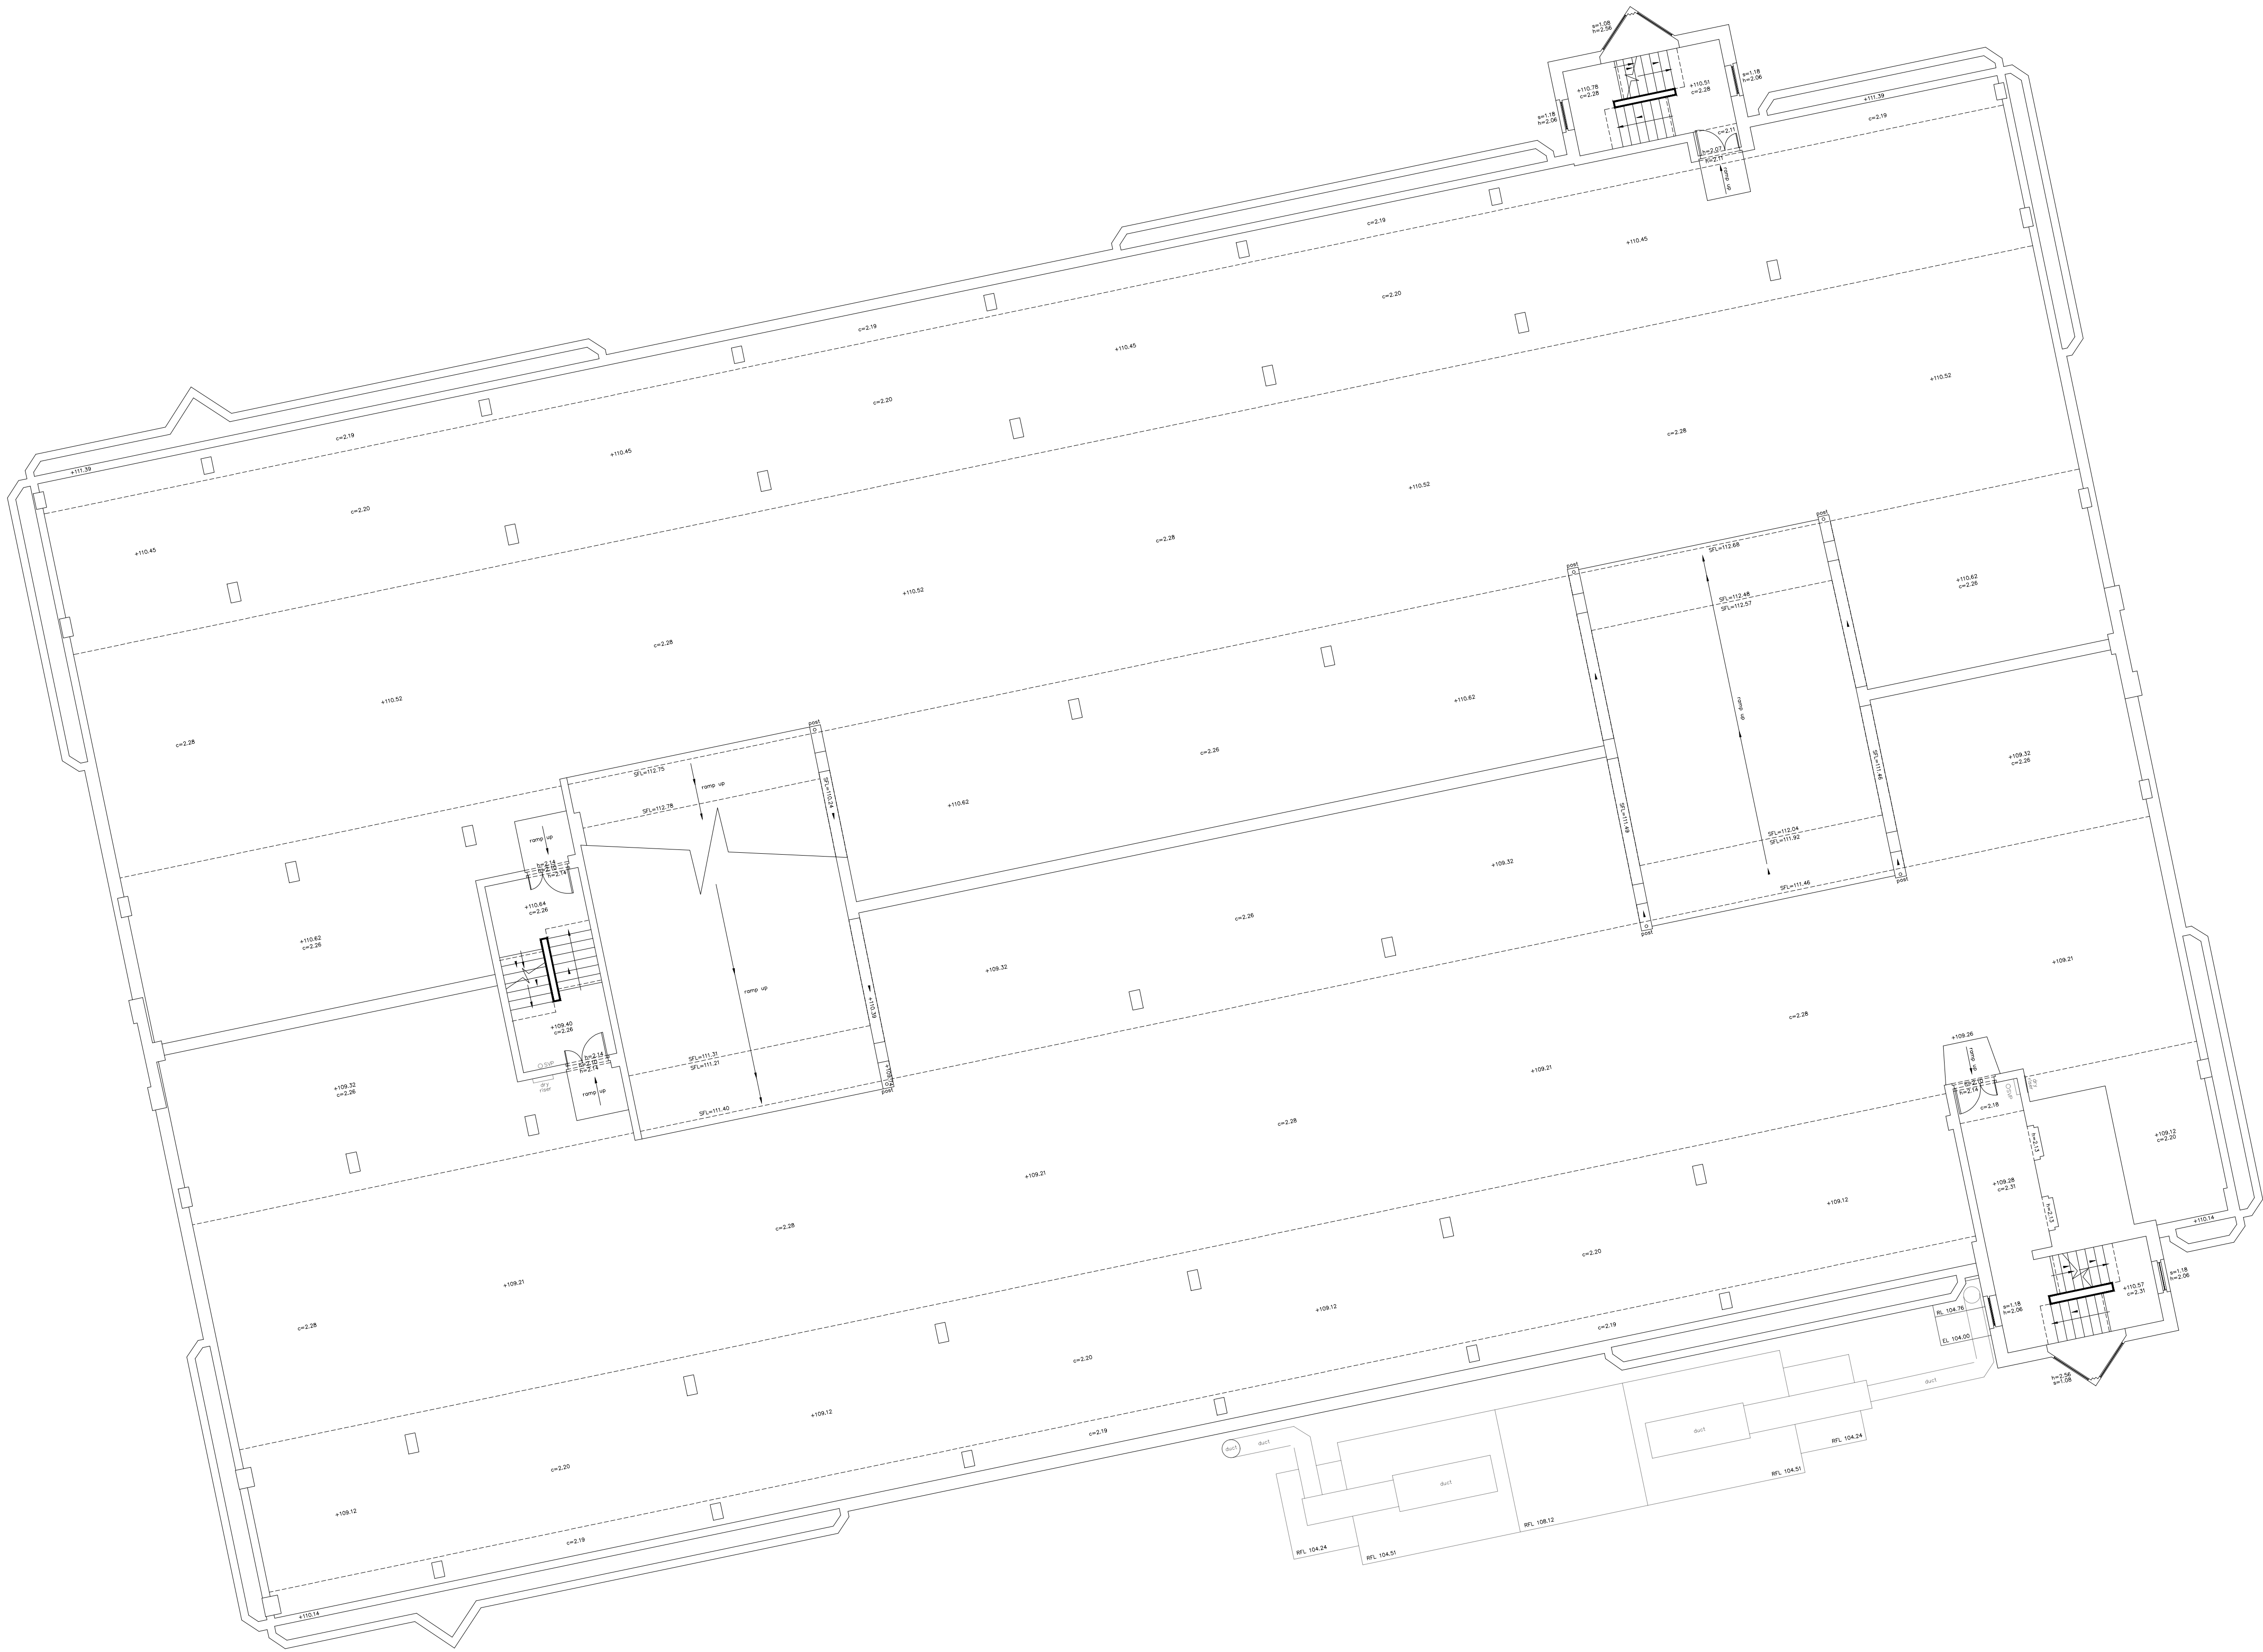

THIRD FLOOR

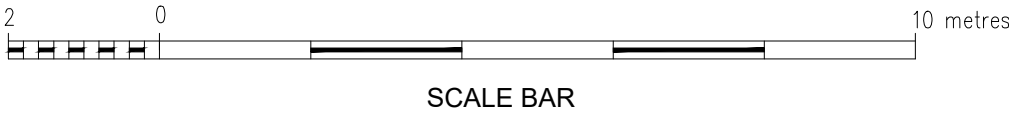

KEY

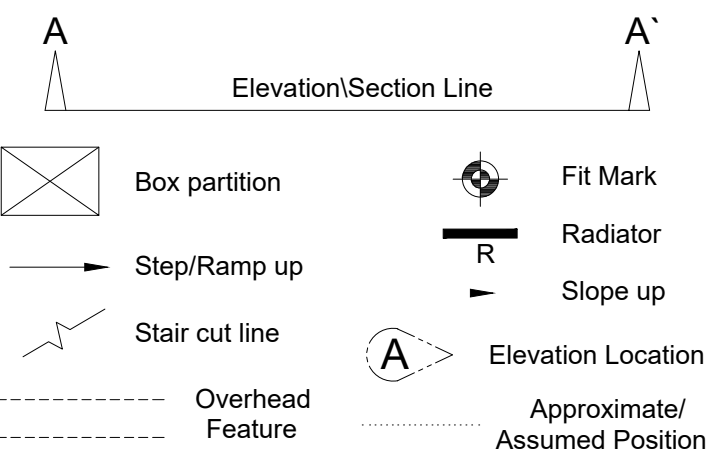

ABBREVIATIONS

p = Plinth Height
s = Sill Height
h = Head Height
c = Ceiling Height
b = Beam Height
sp = Spring Point Height
fc = False Ceiling Height
sc = Structural Ceiling Height
sf = Soffit Height
RL = Ridge Level
EL = Eaves Level
RFL = Roof Level
SFL = Soffit Level
THL = Threshold Level
FFL = Finished Floor Level
PWL = Parapet Wall Level
+35.20 = Levels
52.76 = Elevation level
AB = Air Brick
AHU = Air Handling Unit
AV = Air Vent
CB = Cupboard
JB = Junction Box
RSJ = Rolled Steel Joist
WT = Worktop

Client
PEGASUS PLANNING GROUP

Project
**ELSTREE TOWER, ELSTREE WAY,
BOREHAMWOOD, WD6 1SD**

Title
FLOOR PLAN

Drawing Number
TS22-292-CP-5

Revision	Description	Rev. By	Date

Scale 1:100@A1 Sheet 5 of 7

Drawn by AB	Checked by LC	Date of Survey JUNE 2022
----------------	------------------	-----------------------------




**TERRAIN
SURVEYS**


Tel: 01438 841300
www.terrain-surveys.co.uk
enquiries@terrain-surveys.co.uk

Accreditations:



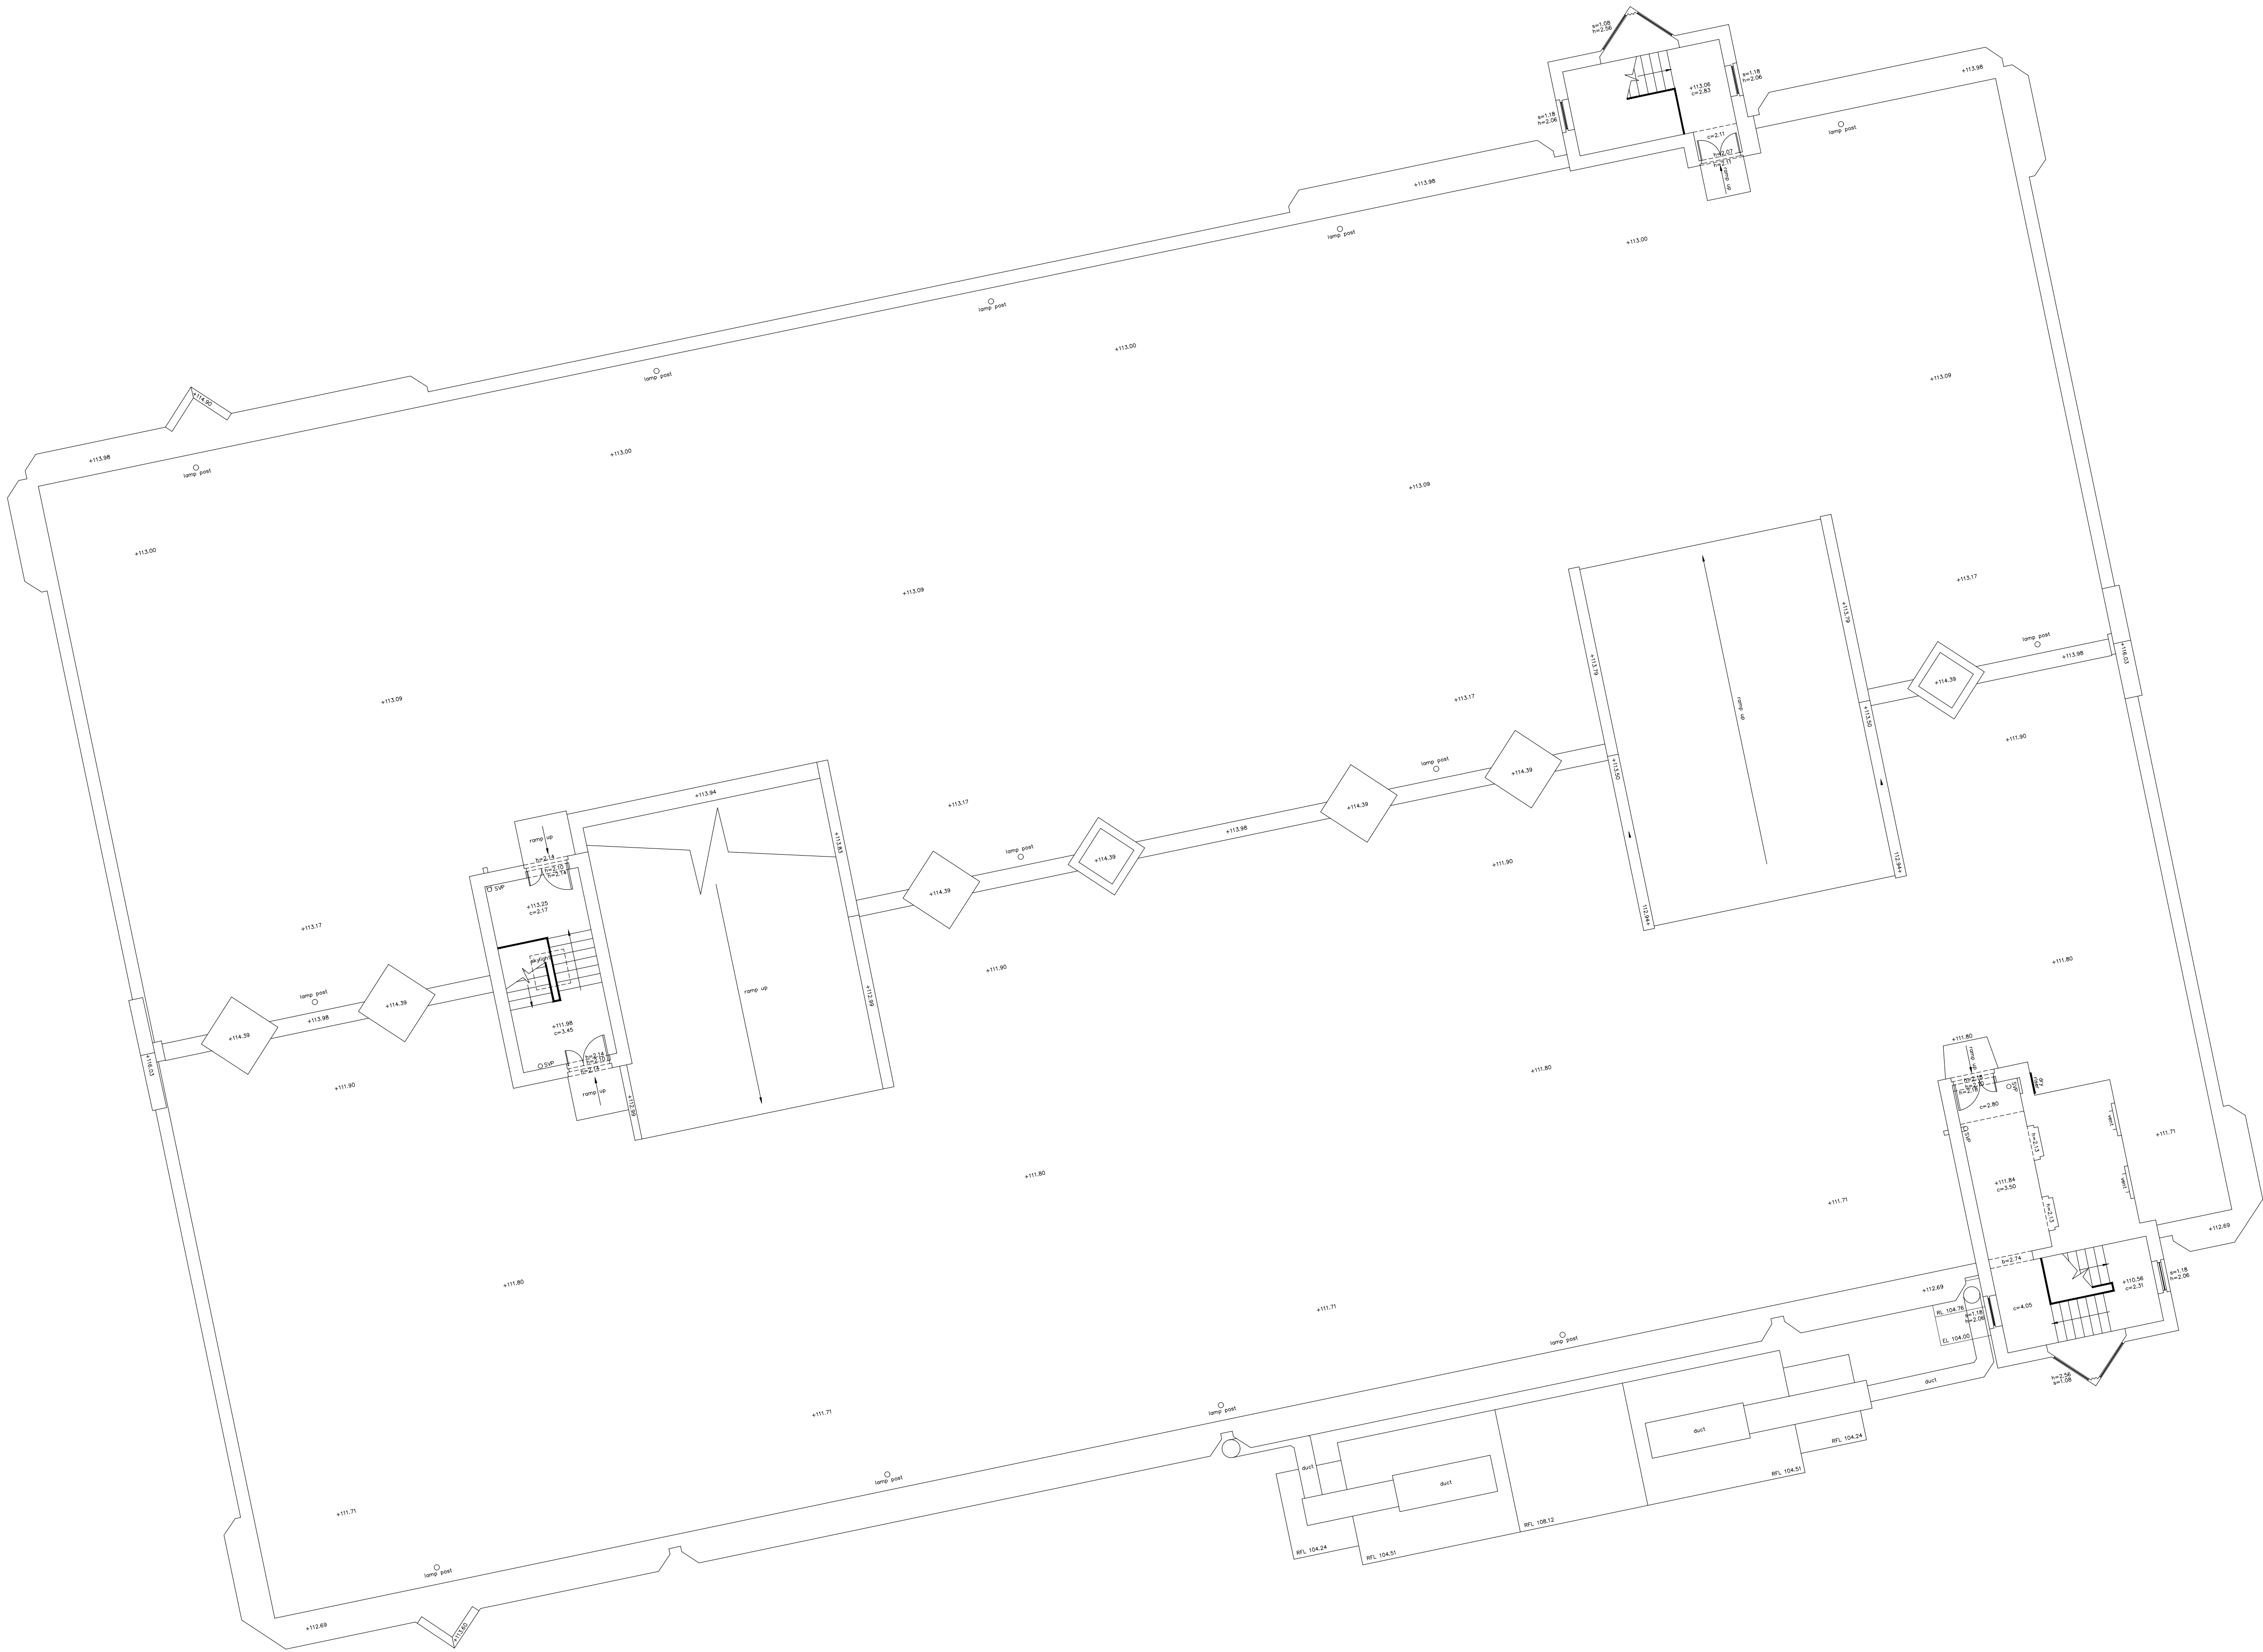

FOURTH FLOOR

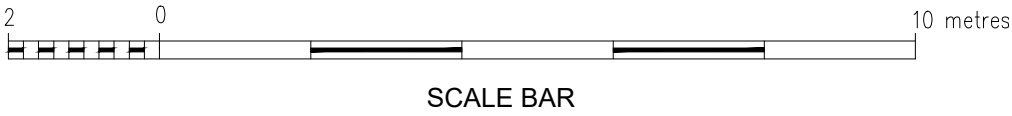

KEY

Elevation/Section Line

Box partition

Step/Ramp up

Stair cut line

Overhead Feature

Fit Mark

Radiator

Slope up

Elevation Location

Approximate/ Assumed Position

ABBREVIATIONS

p = Plinth Height
s = Sill Height
h = Head Height
c = Ceiling Height
b = Beam Height
sp = Spring Point Height
fc = False Ceiling Height
sc = Structural Ceiling Height
sf = Soffit Height

RL = Ridge Level
EL = Eaves Level
RFL = Roof Level
SFL = Soffit Level
THL = Threshold Level
FFL = Finished Floor Level
PWL = Parapet Wall Level
+35.20 = Levels
52.76 = Elevation level

AB = Air Brick
AHU = Air Handling Unit
AV = Air Vent
CB = Cupboard

JB = Junction Box
RSJ = Rolled Steel Joist
WT = Worktop

Client
PEGASUS PLANNING GROUP

Project
**ELSTREE TOWER, ELSTREE WAY,
BOREHAMWOOD, WD6 1SD**

Title
FLOOR PLAN

Drawing Number
TS22-292-CP-6

Revision	Description	Rev. By	Date

Scale 1:100@A1 Sheet 6 of 7

Drawn by AB Checked by LC Date of Survey JUNE 2022

TERRAIN SURVEYS

Tel: 01438 841300
www.terrain-surveys.co.uk
enquiries@terrain-surveys.co.uk

Accreditations:

Chartered ices

THE SURVEY ASSOCIATION


ISOQAR

UKAS


CHAS

Constructionline Gold Member


Accredited Contractor CHAS.co.uk

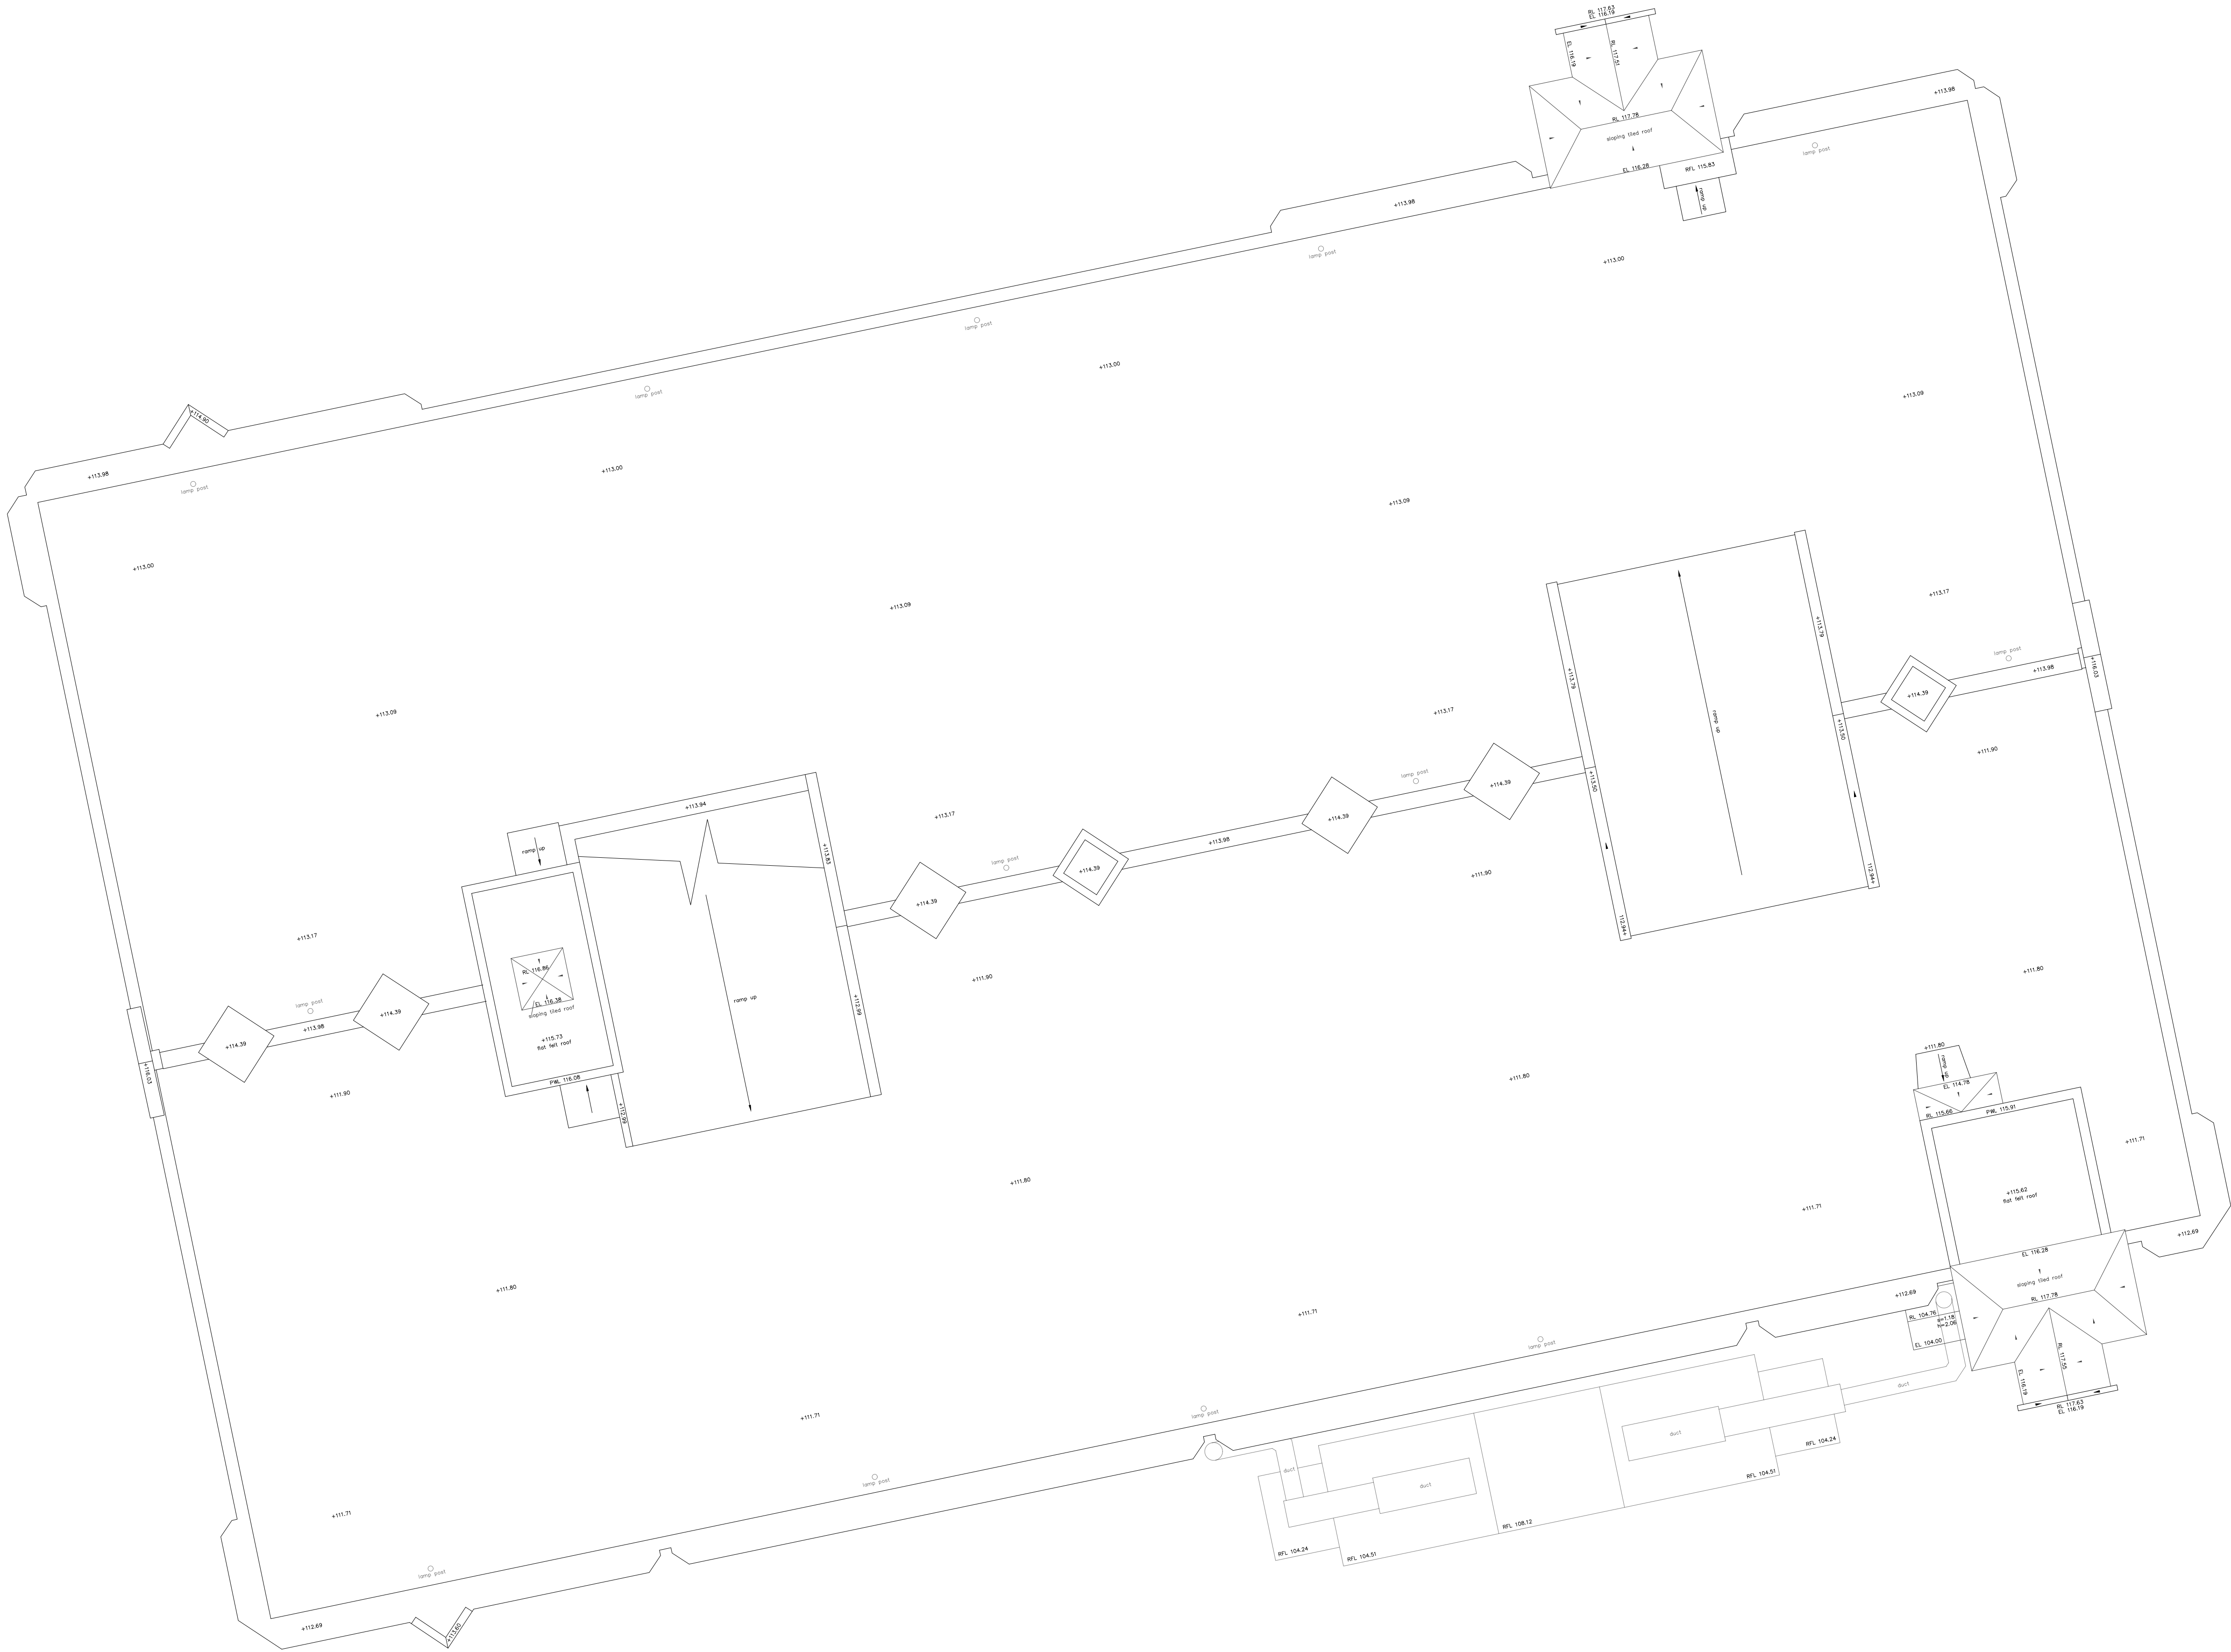

ROOF PLAN

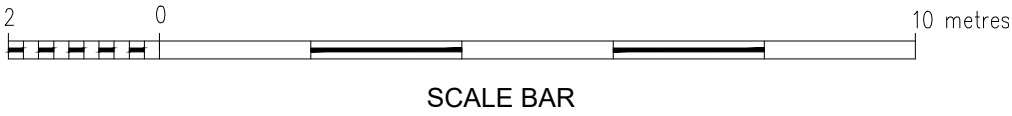

KEY

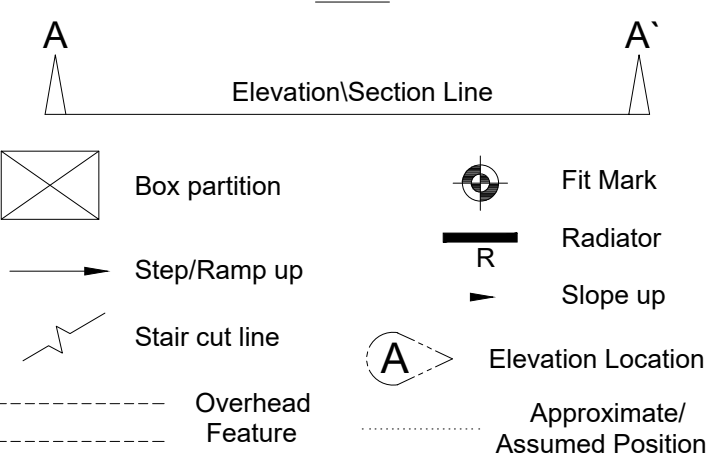

ABBREVIATIONS

p = Plinth Height
s = Sill Height
h = Head Height
c = Ceiling Height
b = Beam Height
sp = Spring Point Height
fc = False Ceiling Height
sc = Structural Ceiling Height
sf = Soffit Height
RL = Ridge Level
EL = Eaves Level
RFL = Roof Level
SFL = Soffit Level
THL = Threshold Level
FFL = Finished Floor Level
PWL = Parapet Wall Level
+35.20 = Levels
+52.76 = Elevation level
JB = Junction Box
RSJ = Rolled Steel Joist
WT = Worktop

Client
PEGASUS PLANNING GROUP

Project
**ELSTREE TOWER, ELSTREE WAY,
BOREHAMWOOD, WD6 1SD**

Title
FLOOR PLAN

Drawing Number
TS22-292-CP-7

Revision	Description	Rev. By	Date

Scale	1:100@A1	Sheet	7 of 7
Drawn by	AB	Checked by	LC
		Date of Survey	JUNE 2022




**TERRAIN
SURVEYS**

Tel: 01438 841300
www.terrain-surveys.co.uk
enquiries@terrain-surveys.co.uk


Accreditations:



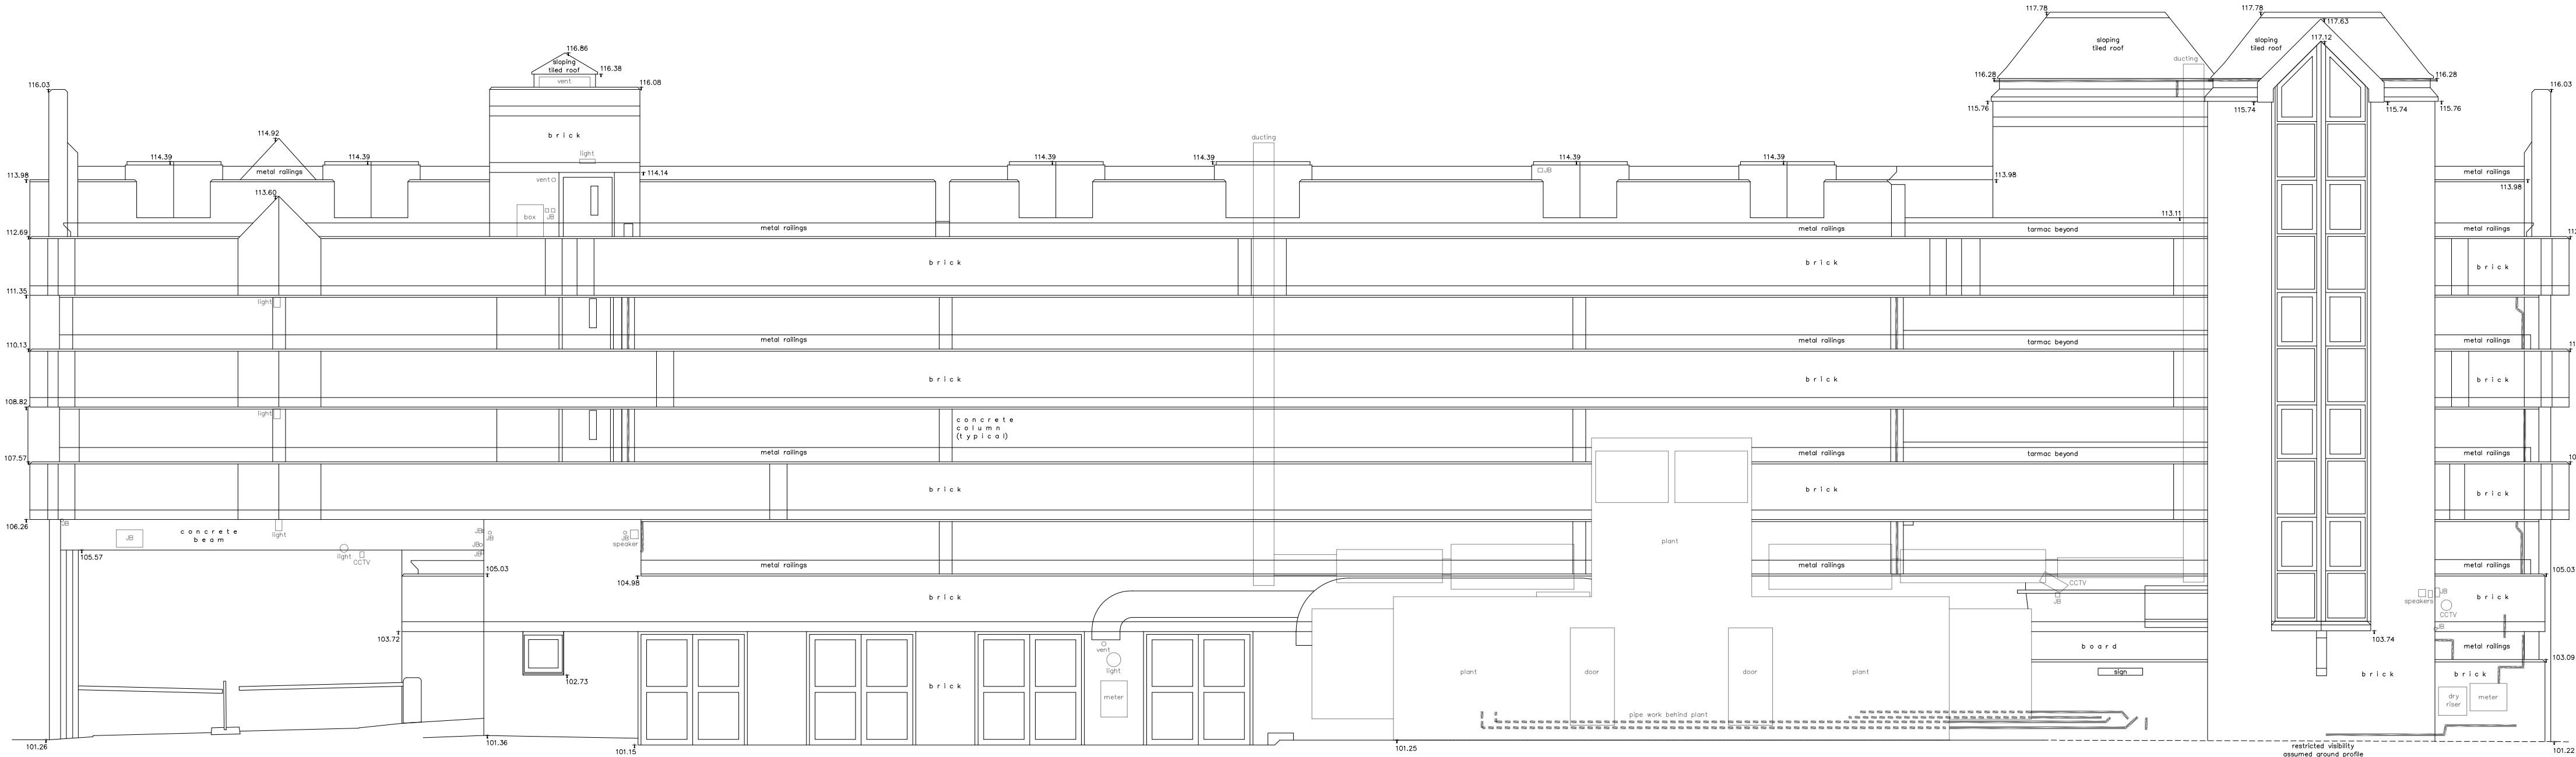

ELEVATION A


Datum 95.00m

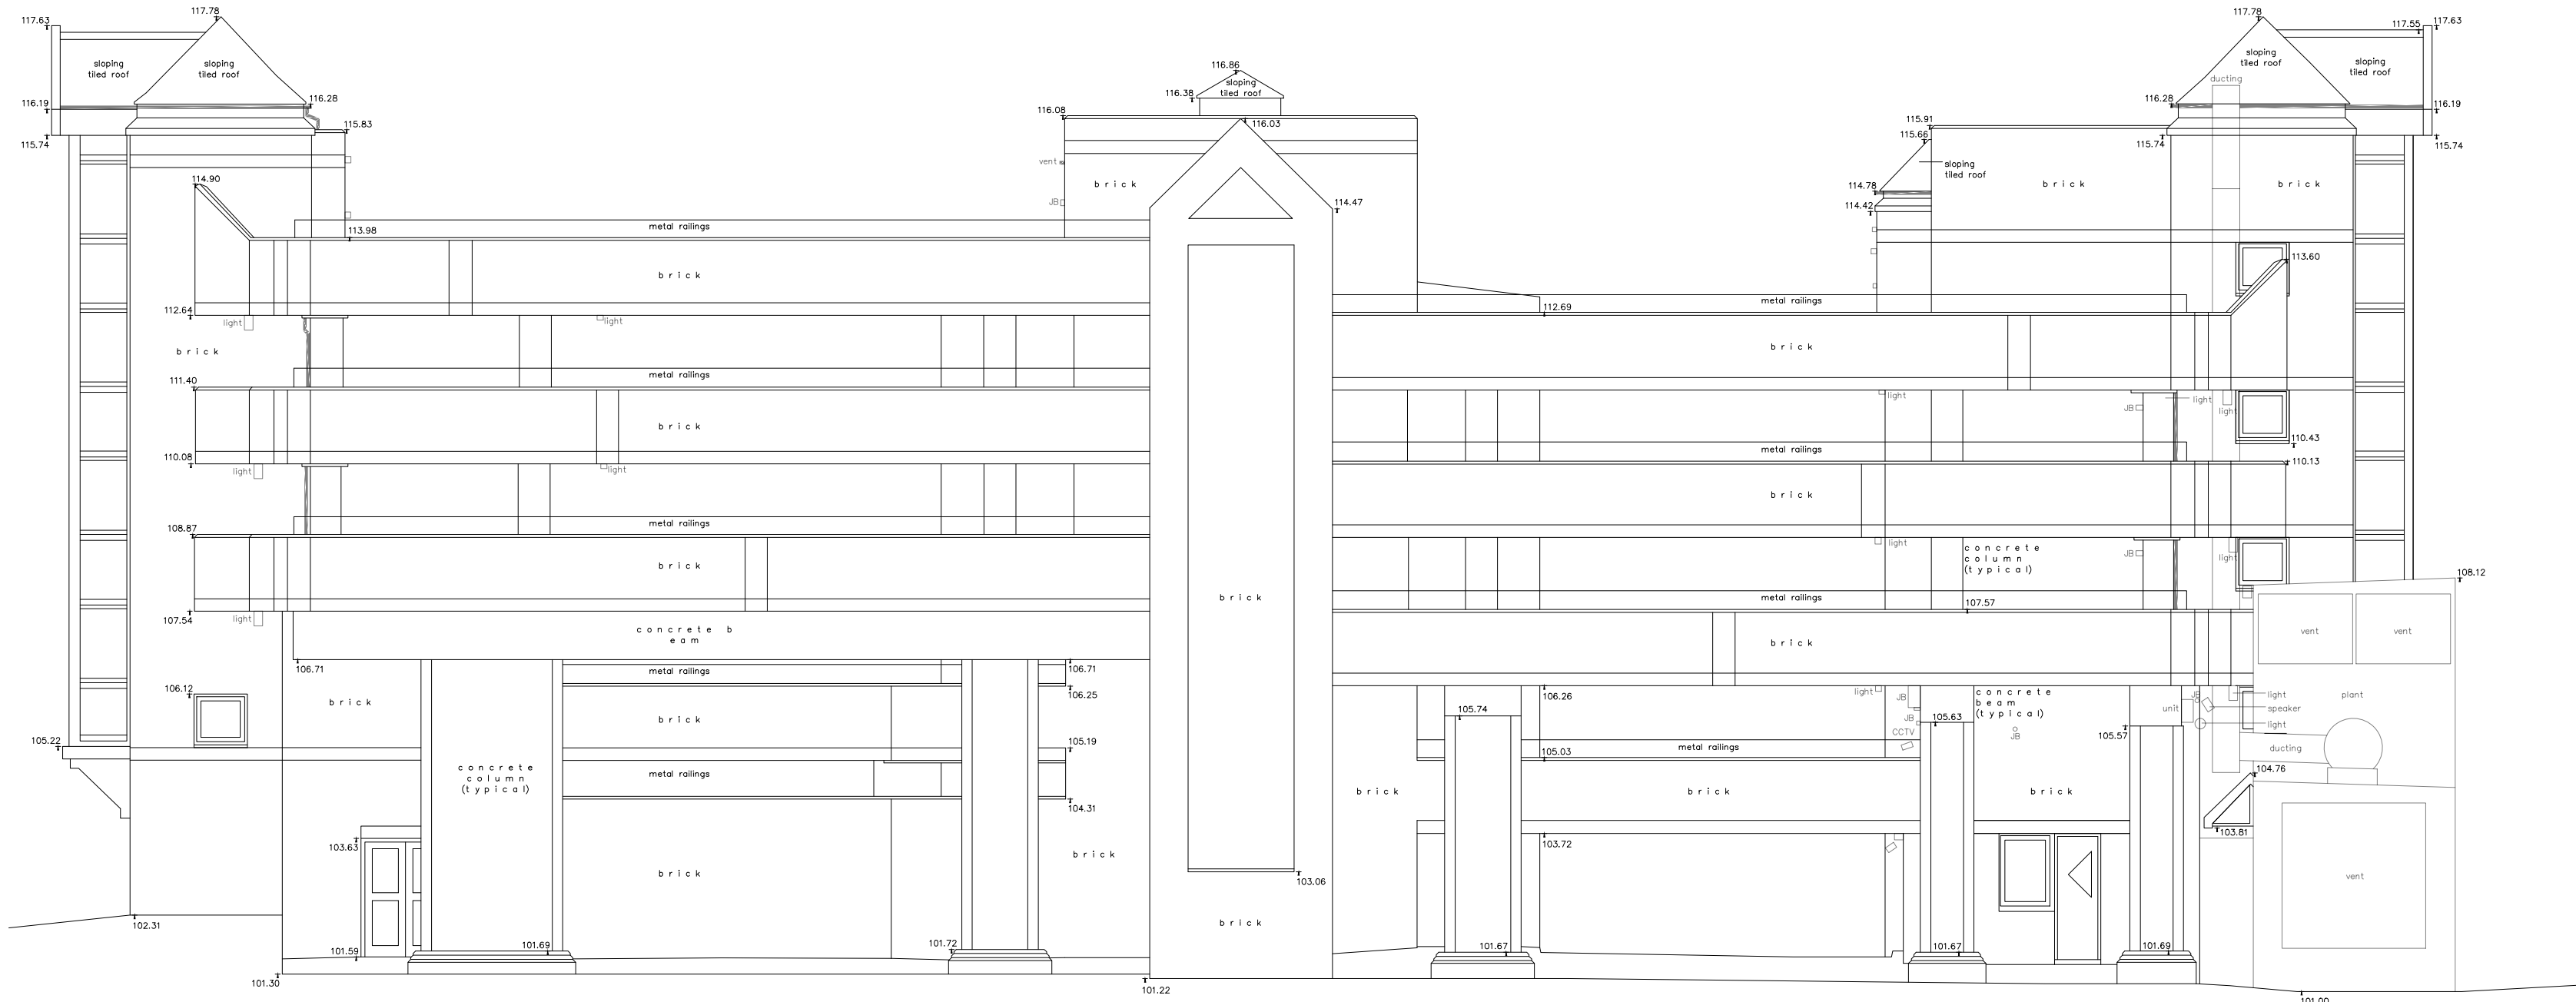


ELEVATION B

Datum 95.00m

LOCATION PLAN
NOT TO SCALE

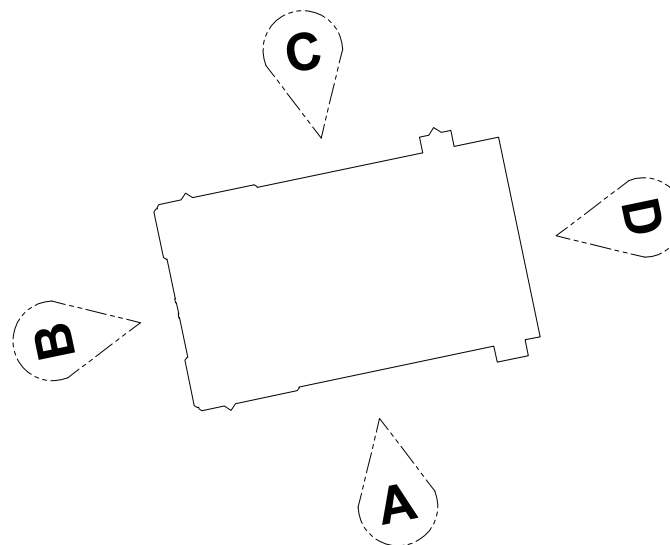

KEY

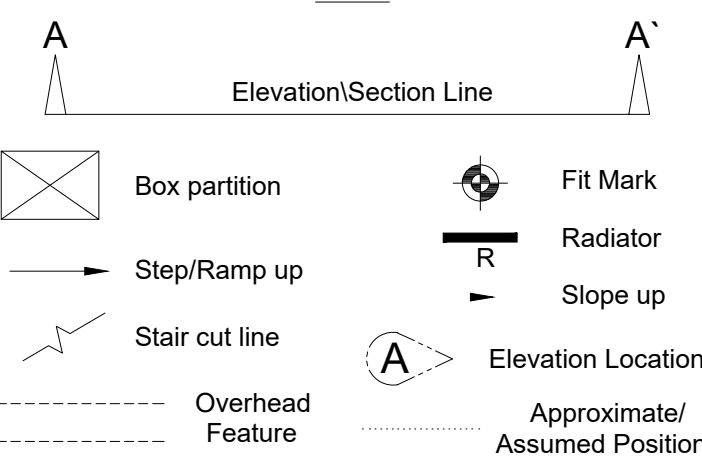

ABBREVIATIONS

p = Plinth Height
s = Sill Height
h = Head Height
c = Ceiling Height
b = Beam Height
sp = Spring Point Height
fc = False Ceiling Height
sc = Structural Ceiling Height
sf = Soffit Height
RL = Ridge Level
EL = Eaves Level
RFL = Roof Level
SFL = Soffit Level
THL = Threshold Level
FFL = Finished Floor Level
PWL = Parapet Wall Level
+35.20 = Levels
52.76 = Elevation level
AB = Air Brick
AHU = Air Handling Unit
AV = Air Vent
CB = Cupboard
JB = Junction Box
RSJ = Rolled Steel Joist
WT = Worktop

Client
PEGASUS PLANNING GROUP

Project
**ELSTREE TOWER, ELSTREE WAY,
BOREHAMWOOD, WD6 1SD**

Title
ELEVATIONS

Drawing Number
TS22-292-CP-8

Revision	Description	Rev. By	Date

Scale 1:100@A1 Sheet 1 of 2


Drawn by JE Checked by LC Date of Survey JULY 2022




**TERRAIN
SURVEYS**

Tel: 01438 841300
www.terrain-surveys.co.uk
enquiries@terrain-surveys.co.uk


Accreditations:

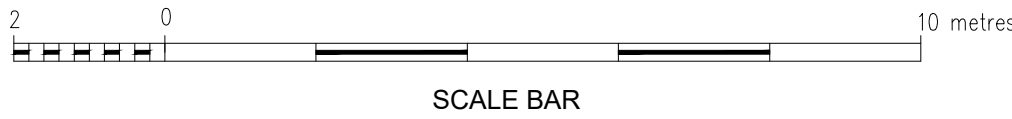

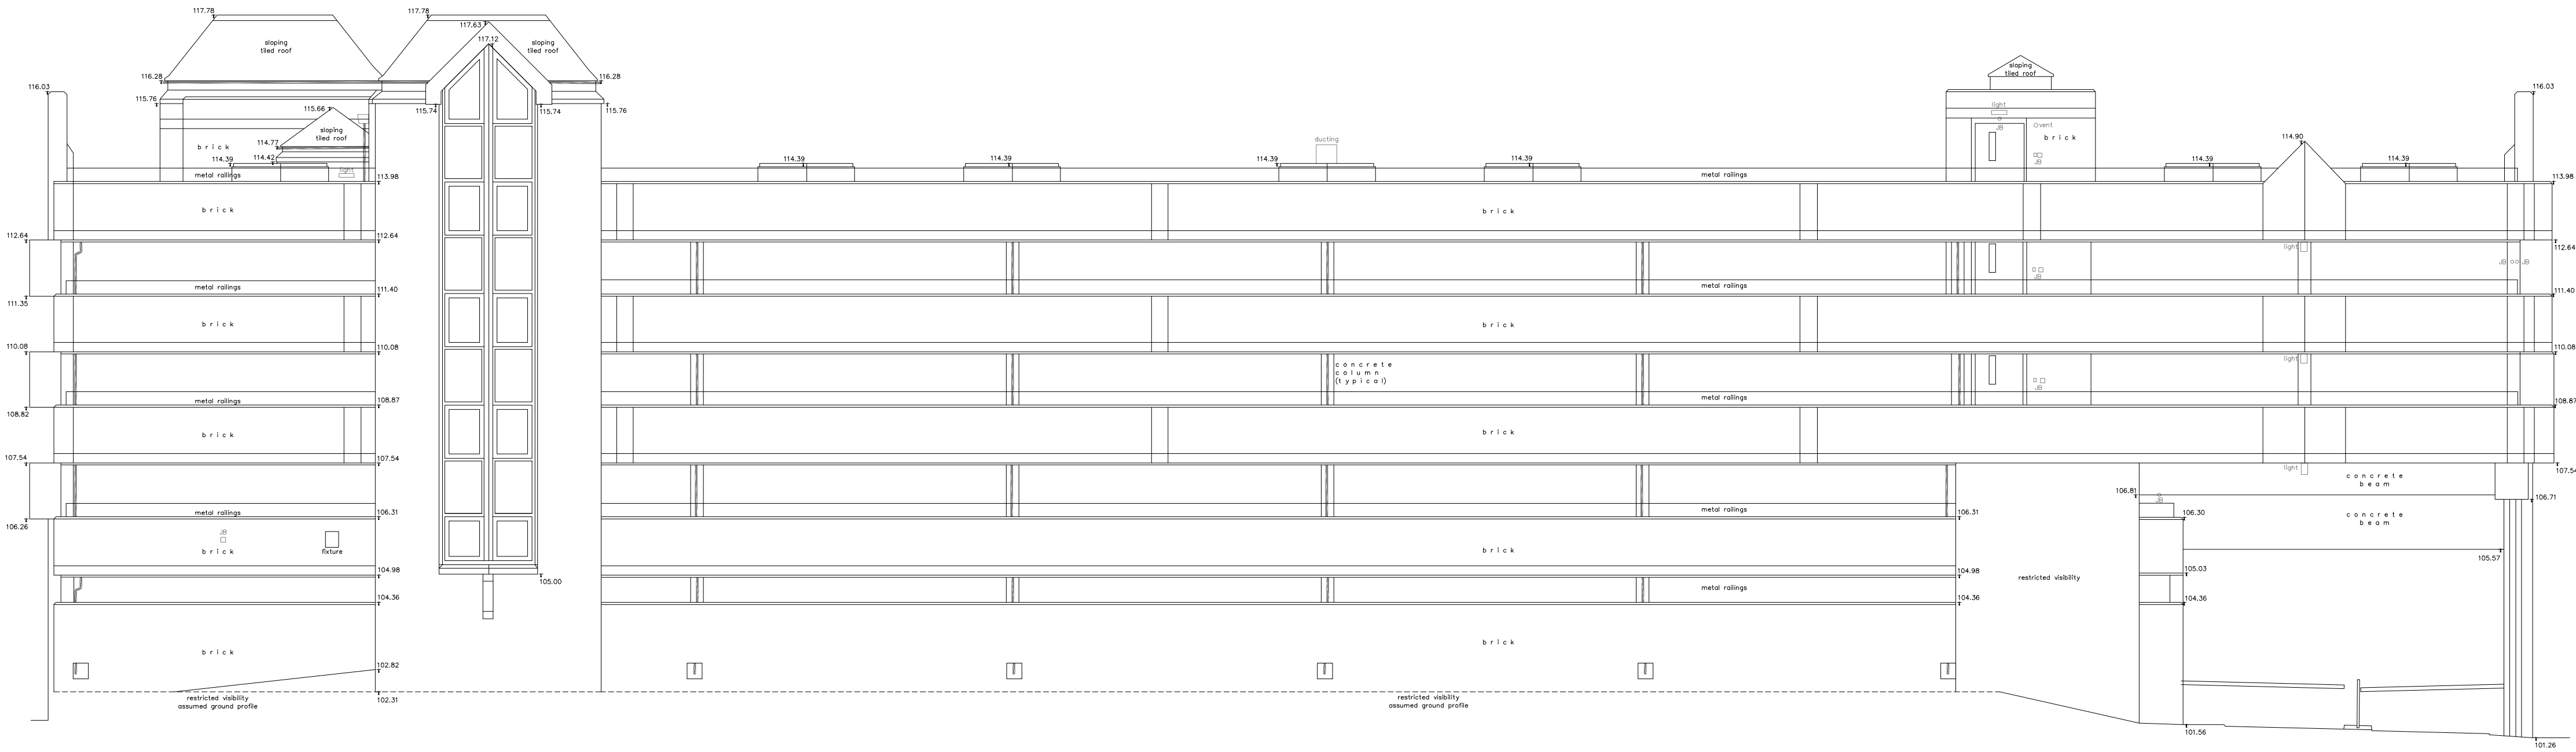


ELEVATION C

Datum 95.00m

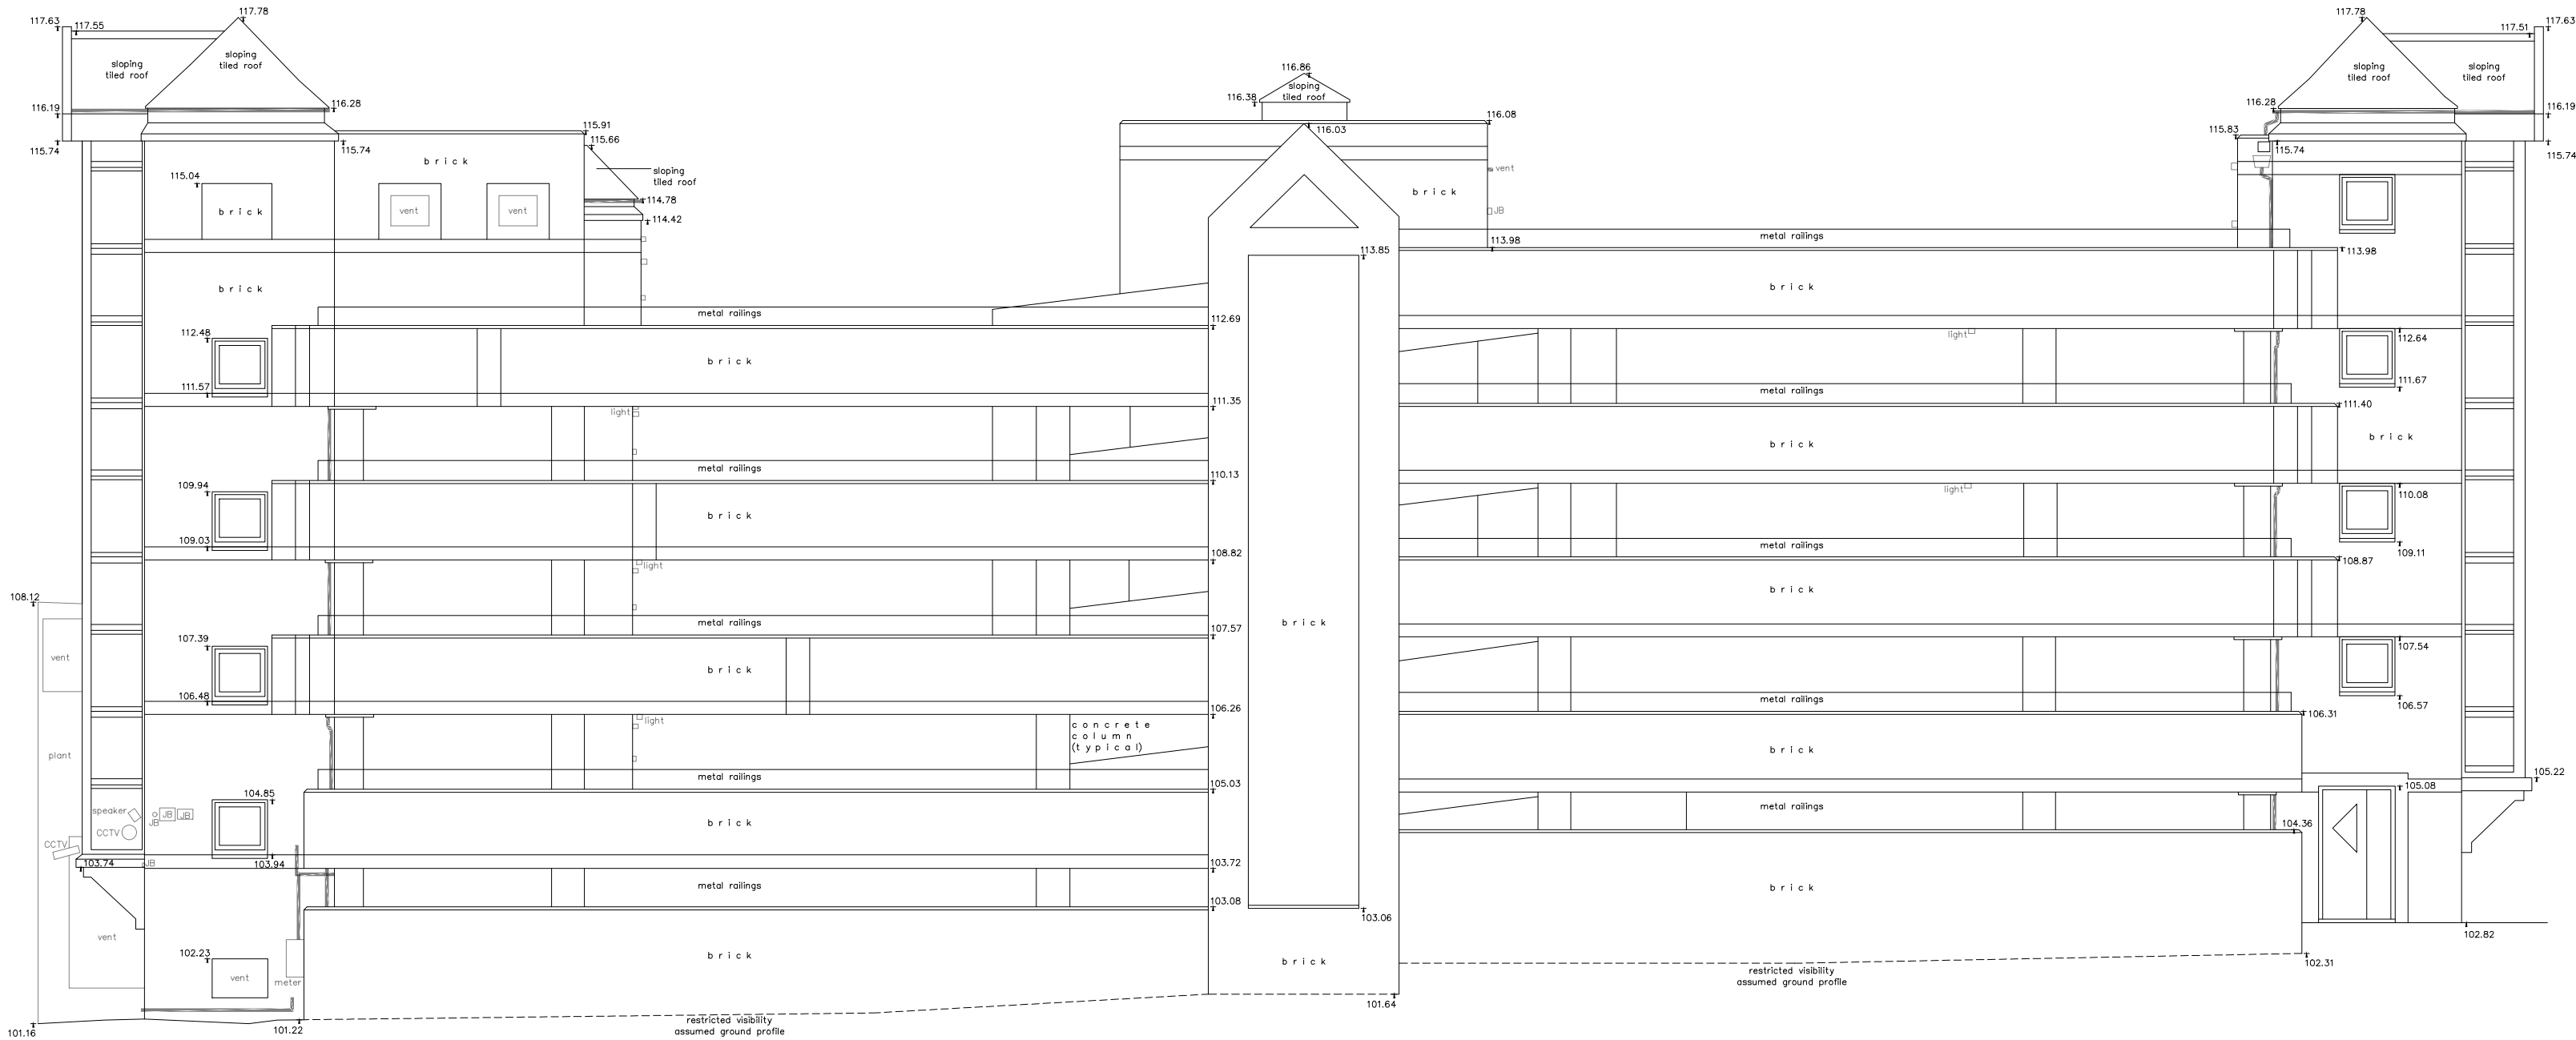


ELEVATION D

Datum 95.00m

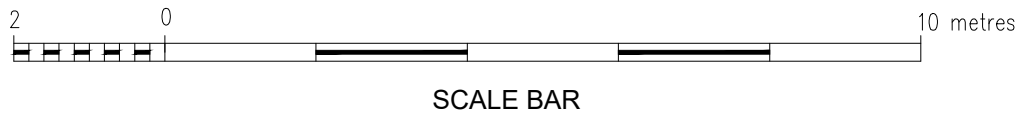


All levels related to Ordnance Survey active GPS network, at survey station S3.

LOCATION PLAN
NOT TO SCALE

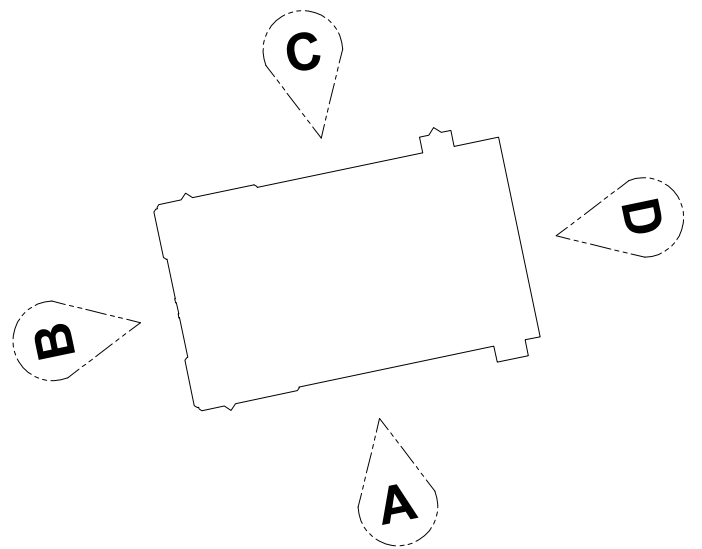

KEY

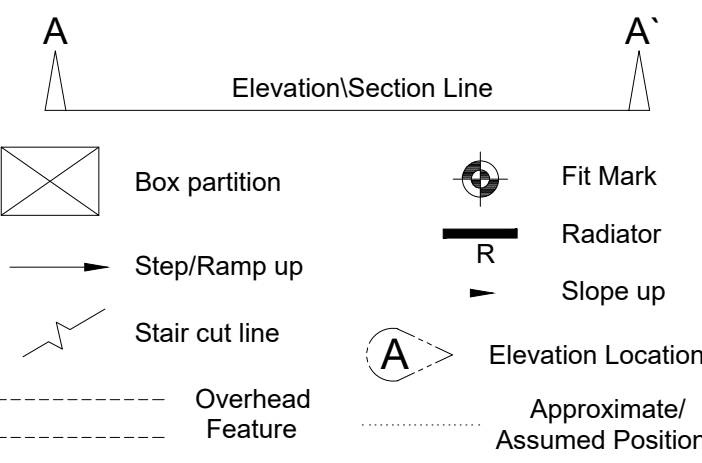

ABBREVIATIONS

p = Plinth Height
s = Sill Height
h = Head Height
c = Ceiling Height
b = Beam Height
sp = Spring Point Height
fc = False Ceiling Height
sc = Structural Ceiling Height
sf = Soffit Height
RL = Ridge Level
EL = Eaves Level
RFL = Roof Level
SFL = Soffit Level
THL = Threshold Level
FFL = Finished Floor Level
PWL = Parapet Wall Level
+35.20 = Levels
52.76 = Elevation level
AB = Air Brick
AHU = Air Handling Unit
AV = Air Vent
CB = Cupboard
JB = Junction Box
RSJ = Rolled Steel Joist
WT = Worktop

Client
PEGASUS PLANNING GROUP

Project
**ELSTREE TOWER, ELSTREE WAY,
BOREHAMWOOD, WD6 1SD**

Title
ELEVATIONS

Drawing Number
TS22-292-CP-9

Revision	Description	Rev. By	Date

Scale 1:100@A1 Sheet 2 of 2

Drawn by JE Checked by LC Date of Survey JULY 2022



**TERRAIN
SURVEYS**

Tel: 01438 841300
www.terrainsurveys.co.uk
enquiries@terrainsurveys.co.uk

