


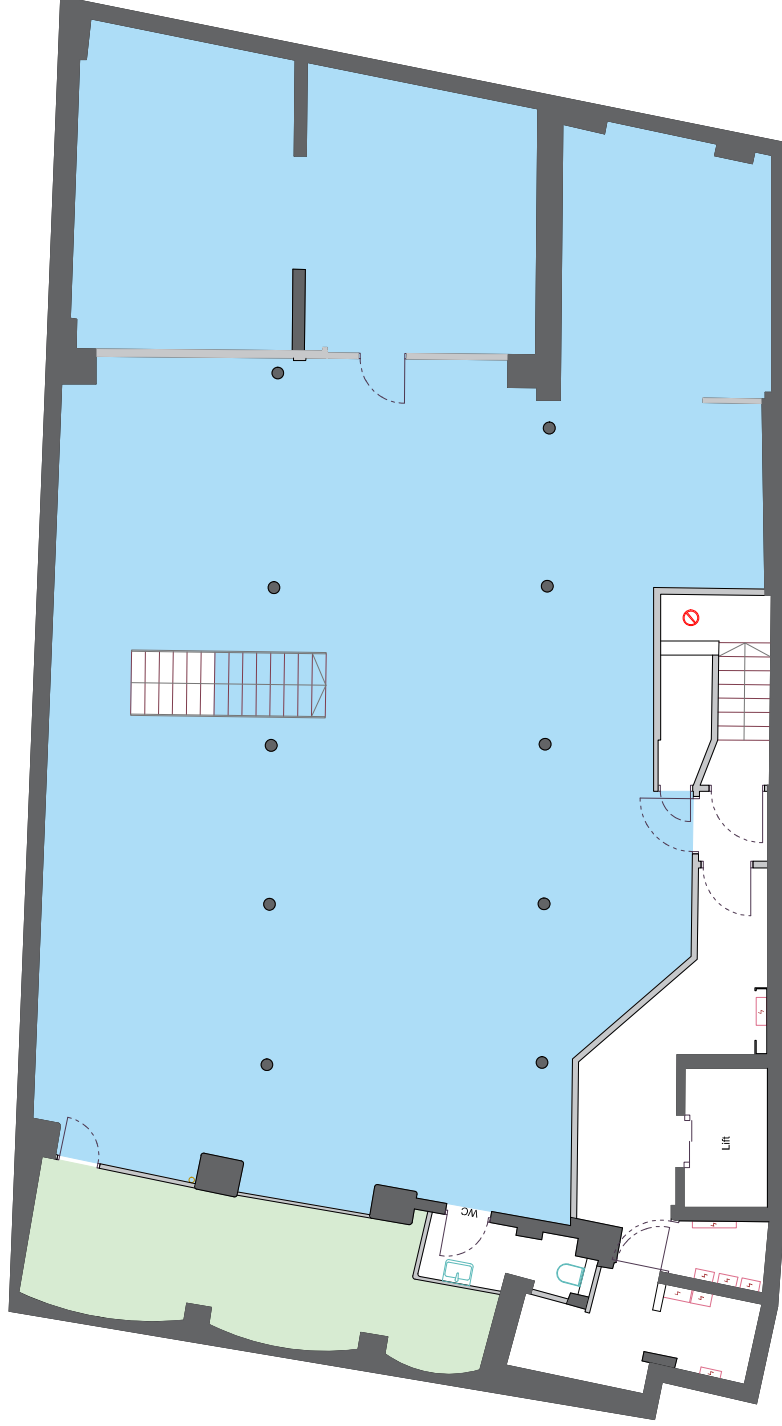

Lower Ground



0m 5m
Scale 1:100

Curtain Road
135 Curtain Road
London
EC2A 3BX

Date	Revision	Project Number	Description	Rev
14/08/2025	00	25.07.3379	Property Survey	0/0

Drawing Name
Lower Ground Floor Plan

REFERENCES	
	Net Internal Area
	Vaults

sterlingtemple
0203 4639225
www.sterlingtemple.com