


DO NOT SCALE THIS DRAWING

Contractors are to check all dimensions prior to commencement on site and notify the architect of any errors, omissions, or discrepancies.

TateHindle Limited retain copyright of this drawing. It may not be copied, altered or reproduced in any way without their written authority.

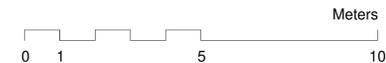

**1 POST SOFT STRIP FIRST FLOOR PLAN**  
1 : 100

01	As Built	05/07/24	JS	SB
Rev	Description	Date	Drawn	Checked

Status  
**As Built**

Client  
DEKA IMMOBILIEN INVESTMENT GMBH

Project  
THE CURSOR BUILDING

Drawing  
POST SOFT STRIP FIRST FLOOR PLAN

Scale at A1	Date	Drn	Project no.	Suitability
1 : 100		VS	15683	

Drn	Revision
15683 - THA - BA - 01 - DM - A - S03201	01

TateHindle  
168 Shoreditch High Street  
London E1 6HU

T 020 7332 4850  
mail@tatehindle.co.uk  
www.tatehindle.co.uk