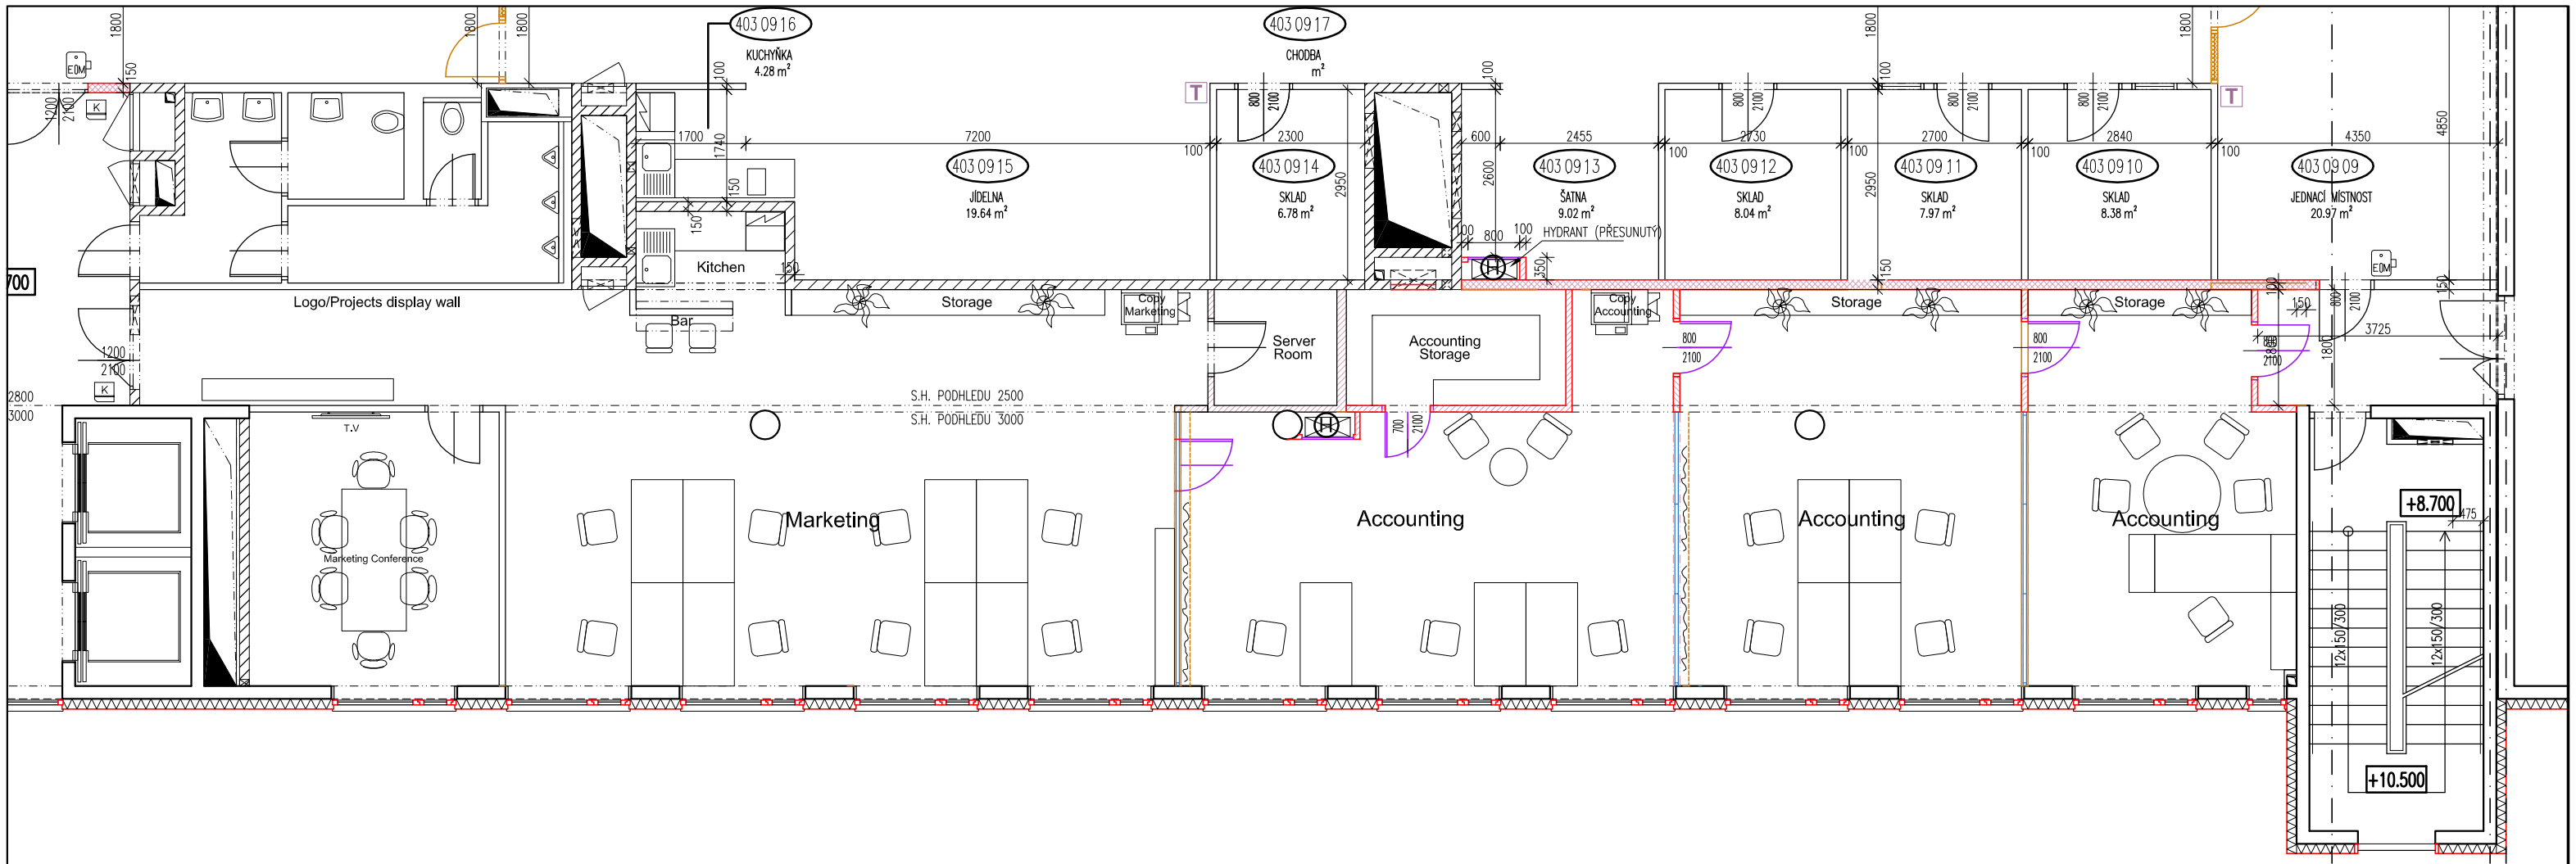


28.3.2022 Daramis new office: General plan