

Stn S2
4.290

Stn S1
4.216

5/298

[illegible]

SURVEY CAVEATS

The survey is commensurate with band D accuracy, as specified in the RICS survey detail accuracy bonding table.
All levels are above OS Newlyn Datum and the survey grid shown on the drawing is only referenced to OS National Grid at the following point: 532591.133E, 177517.050N, obtained multiple network RTK GPS observations.
Drawing units are metres.
All quoted dimensions and levels are in metres.

[illegible]

NBS SYMBOLS

 51.80	Ceiling Level	 1.80	Ceiling Height
 F52.30	F52.30 Ceiling Level	 F29.90	F29.90 Ceiling Height
BSL 60.00	Beam Soffit Level	BH 2.30	Beam Soffit Height
S 50.80	Stair Level	S 0.80	Stair Height
H 52.40	Head Level	H 1.60	Head Height
Min 56.50	Ceiling Sloping Level	Min 1.50	Ceiling Sloping Height
Max 57.00		Max 2.00	
ASL 52.30	Arch Levels	ASH 2.30	Arch Heights
DL 52.30	Door Level	DH 2.30	Door Height
50.00	Spot Level	h 0.90	Feature Height
21.37	Spot Level Elevation		Roof Arrows
	Stair/Step Arrows		Point Down
	Point Up		Stair Outline
	Sloping Ceiling Arrows		Assumed Position
	Ceiling Point Up		



 www.redlaser scanning.co.uk

enquiry@redlaserscanning.co.uk

London Head Office

23 Sussex Street
SW1V 4RR

0207 477 2175

Project 47-49 Dorset Road
London
SW8 1EX

Description	Ground Floor Plan
-------------	-------------------

Survey Date 14/07/2025	Drawing Date 05/08/2025
---------------------------	----------------------------


Sheet	A0	Scale	1:
-------	----	-------	----

Drawing No. 3753-FP-00-M2-0

Checked	Revision
PS	F

Survey Stations			
Name	Easting	Northing	Height
S1	530575.570	177310.902	4.216
S2	530578.815	177336.824	4.290
S3	530611.726	177321.554	4.542
S4	530598.420	177298.919	4.298

Scale 1:50

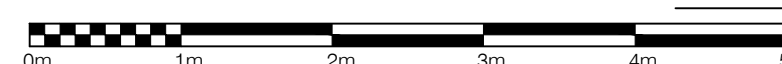

530620 E