

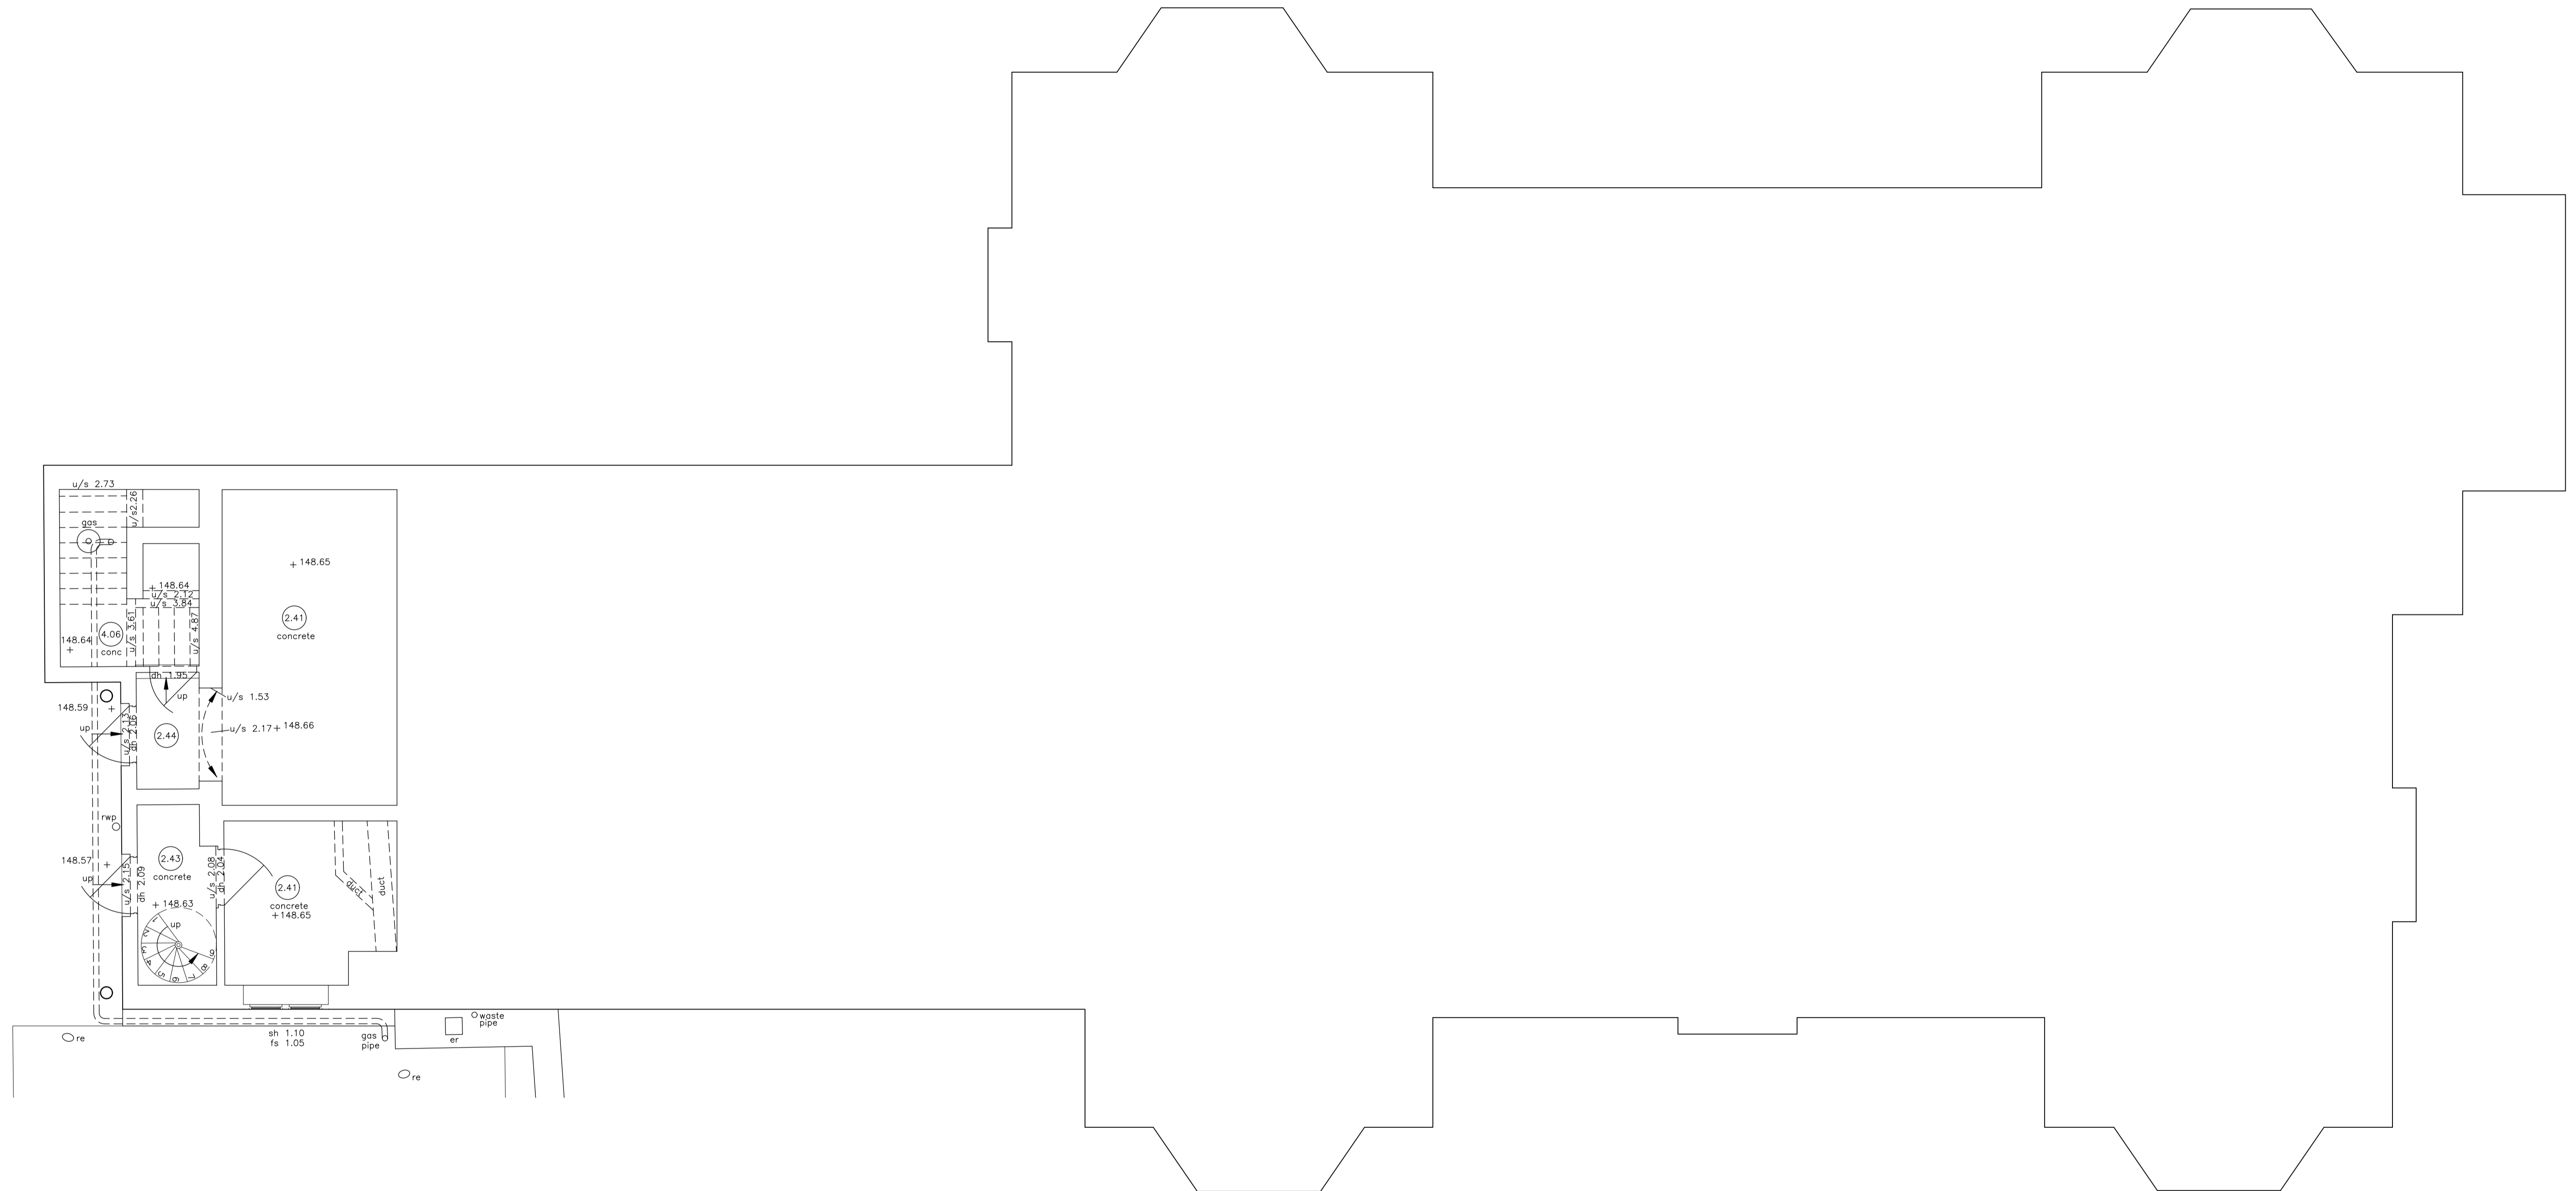
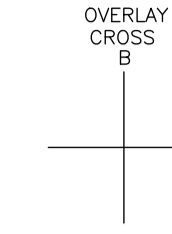
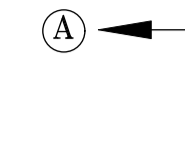
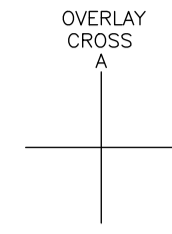
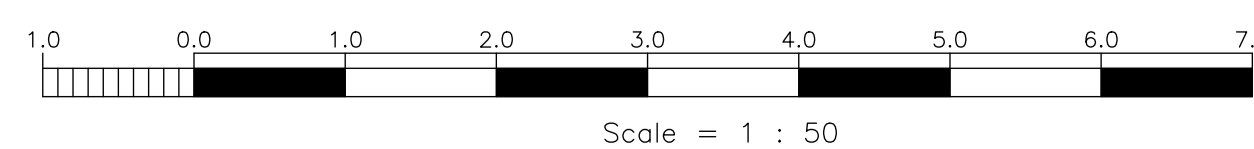
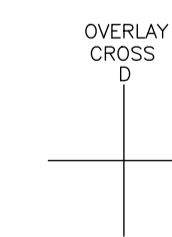


Notes

ALL LEVELS ARE IN METRES DERIVED FROM GPS TRANSFORMATION OSGM15
 THE CO-ORDINATES ARE DERIVED FROM THE ORDNANCE SURVEY ACTIVE STATION NETWORK OSTN15 (BASE STATION ST02)

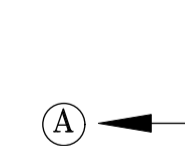

B A S E M E N T

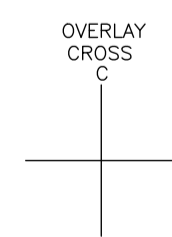

AS/HL/RW © ON CENTRE SURVEYS LTD. 2026	
job BEVAN HOUSE & RAVENSURBY HOUSE 9 WESTBOURNE ROAD BIRMINGHAM WEST MIDLANDS B15 3TR	
client CALTHORPE ESTATES	
title BASEMENT RAVENSURBY HOUSE	dwg no. 29785A/2
scale 1/50	date 9th March 2026

ON CENTRE SURVEYS LTD.
 LAND & BUILDING SURVEYORS
 GEODETIC ENGINEERS
 2 CHARLES COURT, BUDBROOKE ROAD, WARWICK CV34 5LZ
 TEL: 01926 494294
 E-MAIL: info@oncentre.co.uk
 A member of The Survey Association