


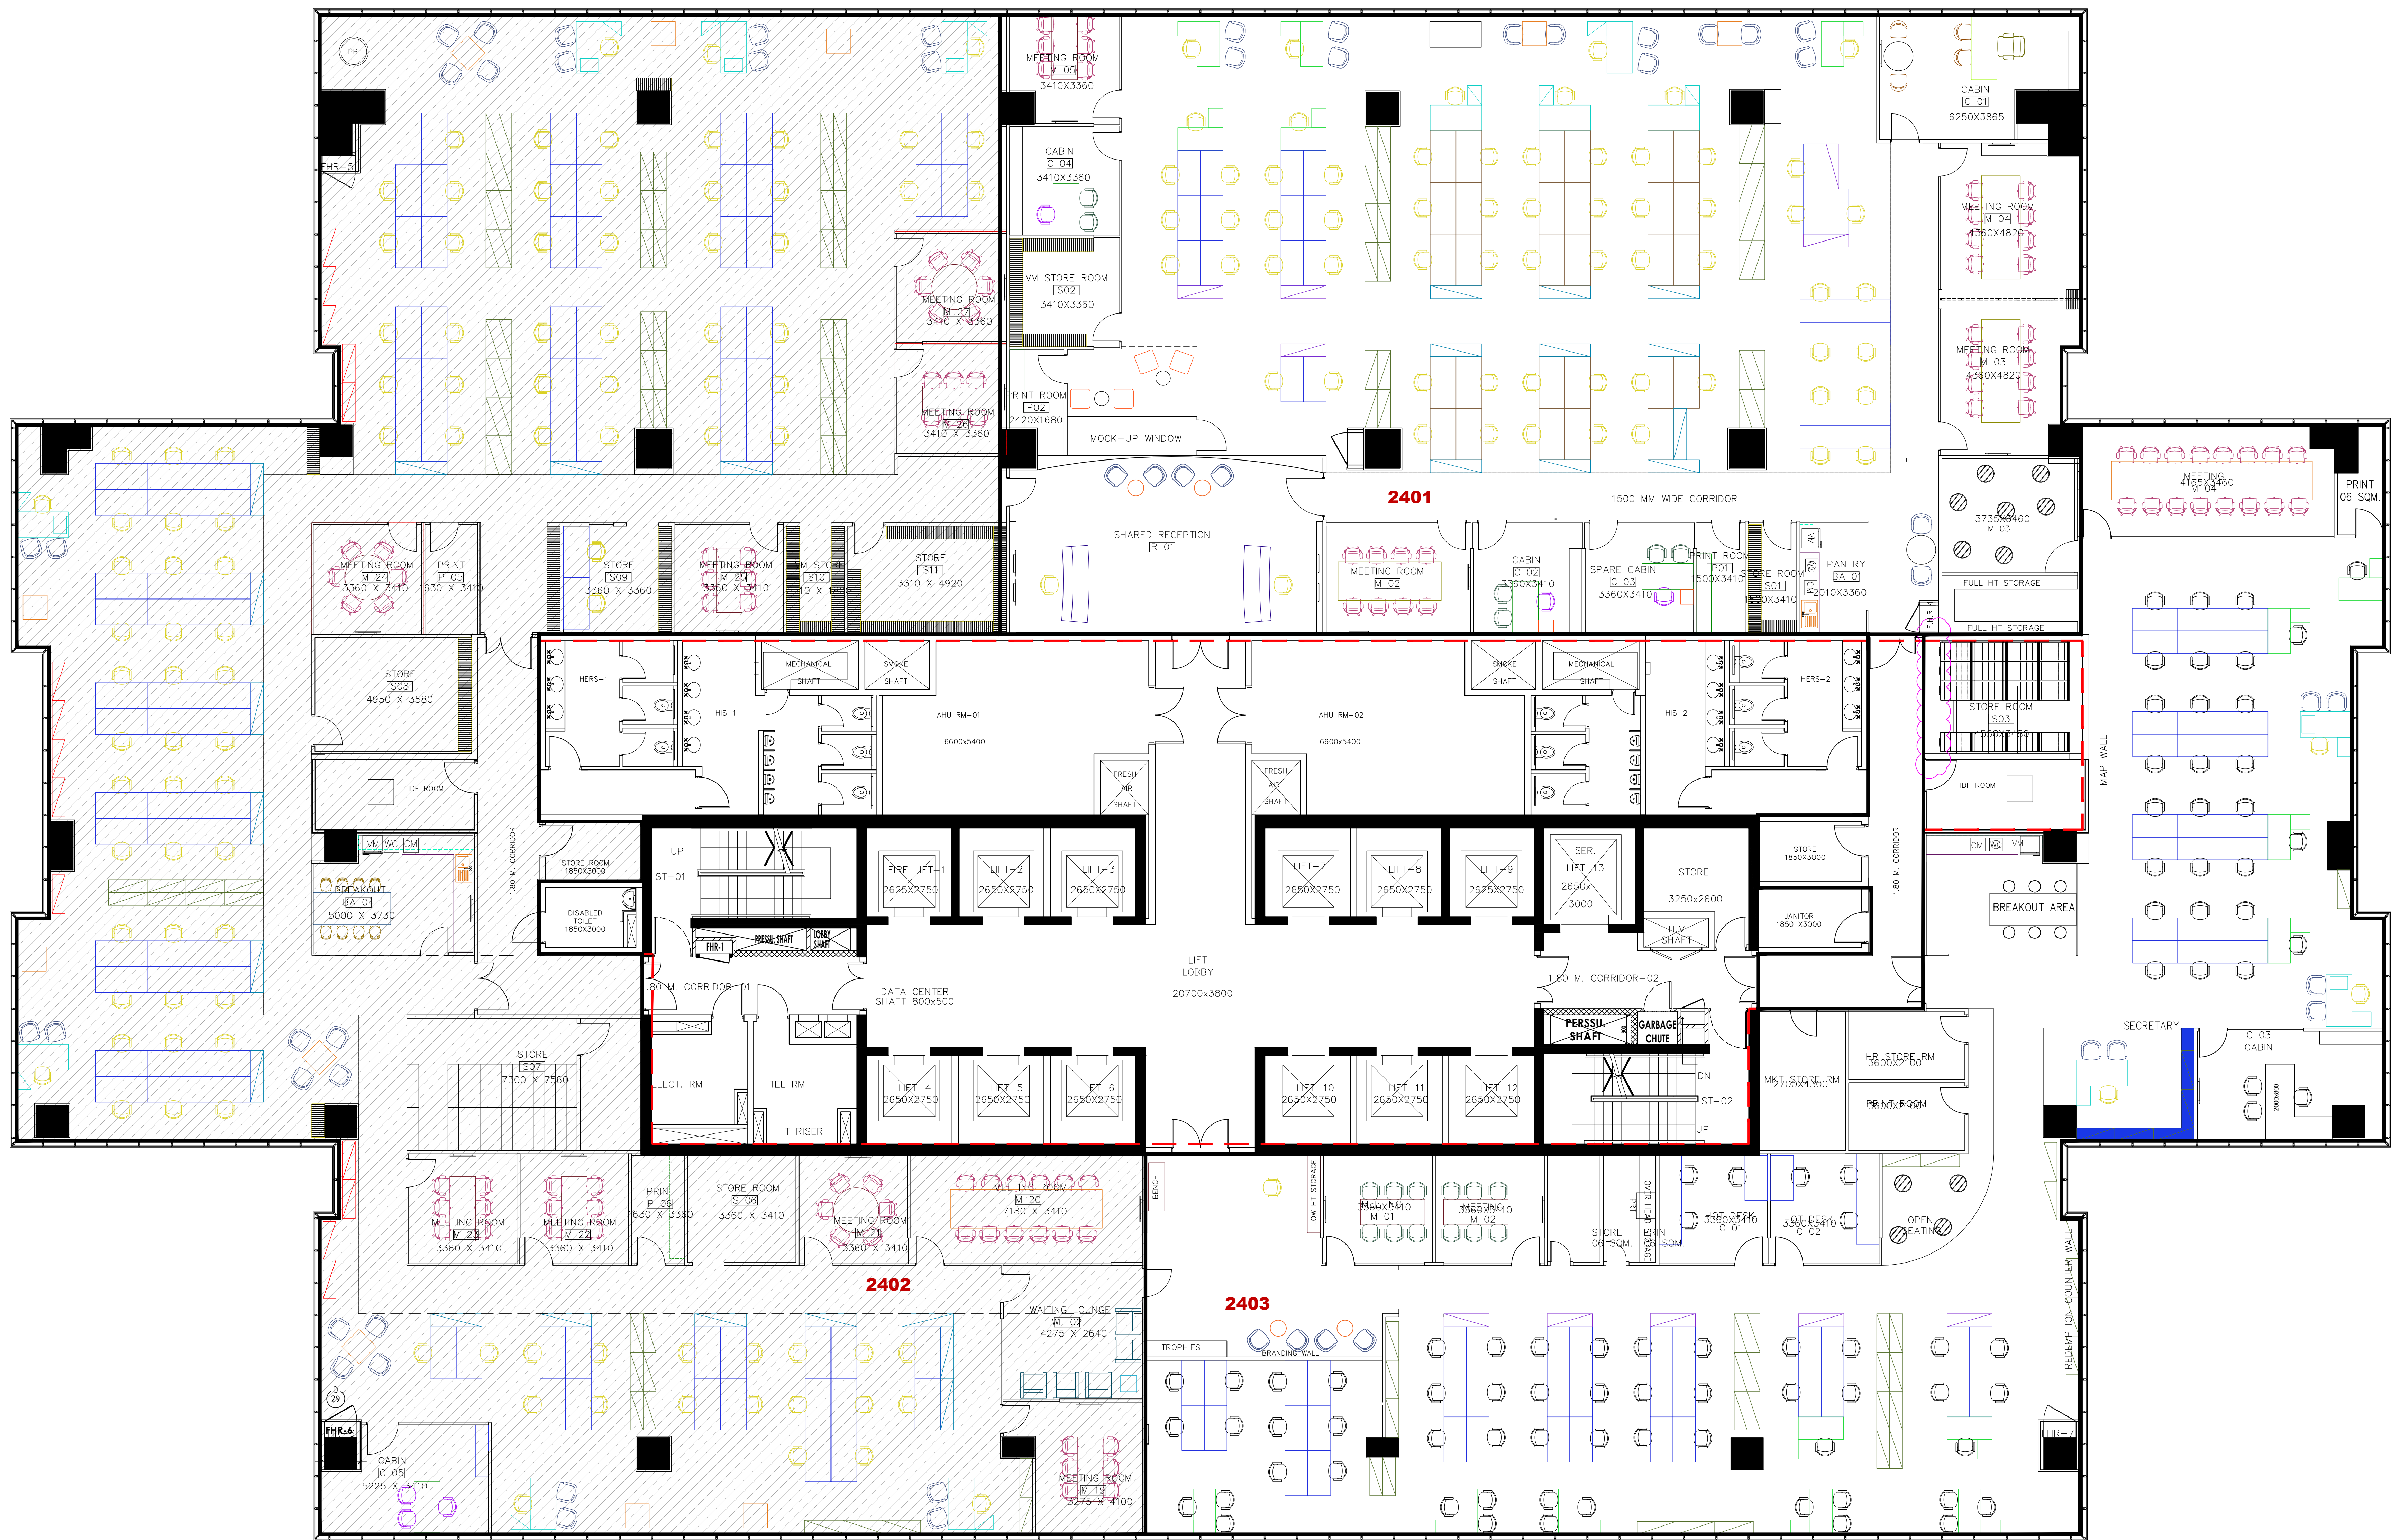

FLOOR AREA DETAILS

	DESCRIPTION	AREA IN M2	AREA IN SQFT.
1.	TOTAL FLOOR AREA	2,932.62	31,555.0
2.	COMMON AREA	613.38	6,600.0
3.	LEASE AREA-2401	616.91	6,638.0
4.	LEASE AREA-2402	104.17	11,203.0
4.	LEASE AREA-2403	661.15	7,114.0

NOTES
ALL DIMENSIONS ARE IN MILLIMETERS UNLESS NOTED OTHERWISE.
ALL LEVELS ARE IN METERS UNLESS NOTED OTHERWISE.
ANY DISCREPANCY TO BE BROUGHT TO THE NOTICE OF CONSULTANT
PRIOR TO COMMENCEMENT OF WORK
ALL STORE & IDF ROOM WALL SHOULD BE 1 Hr FIRE RATED

REVISION AS MARKED	10	2/8/24	
PURPOSE OF ISSUE	REV.	DATE	APPROVED
CLIENT			
LANDMARK ASSET HOLDING LIMITED LANDMARK GROUP P.O. BOX 28500, DUBAI - U.A.E. TEL: 04-8844000, FAX: 04-8844321			
PROJECT NAME:			
3B + GR + 7P + 19 STOREY OFFICE BUILDING ON PLOT D-001-004 @ TECOM DUBAI			
DRAWING TITLE:			
24th LEVEL (BABYSHOP, CP & VACANT) FURNITURE LAYOUT			
SCALE:	DRAWN:	CHECKED:	APPROVED:
N.T.S	Srt	MONSTE/ASHOK	ALOK
DATE: 13-Dec-15	DATE: 13-Dec-15	DATE: 13-Dec-15	
PROJECT NO. 101	CAD FILE REF.	24th LVL_EGS.dwg	
DRAWING NO.	A-115a		
			10